
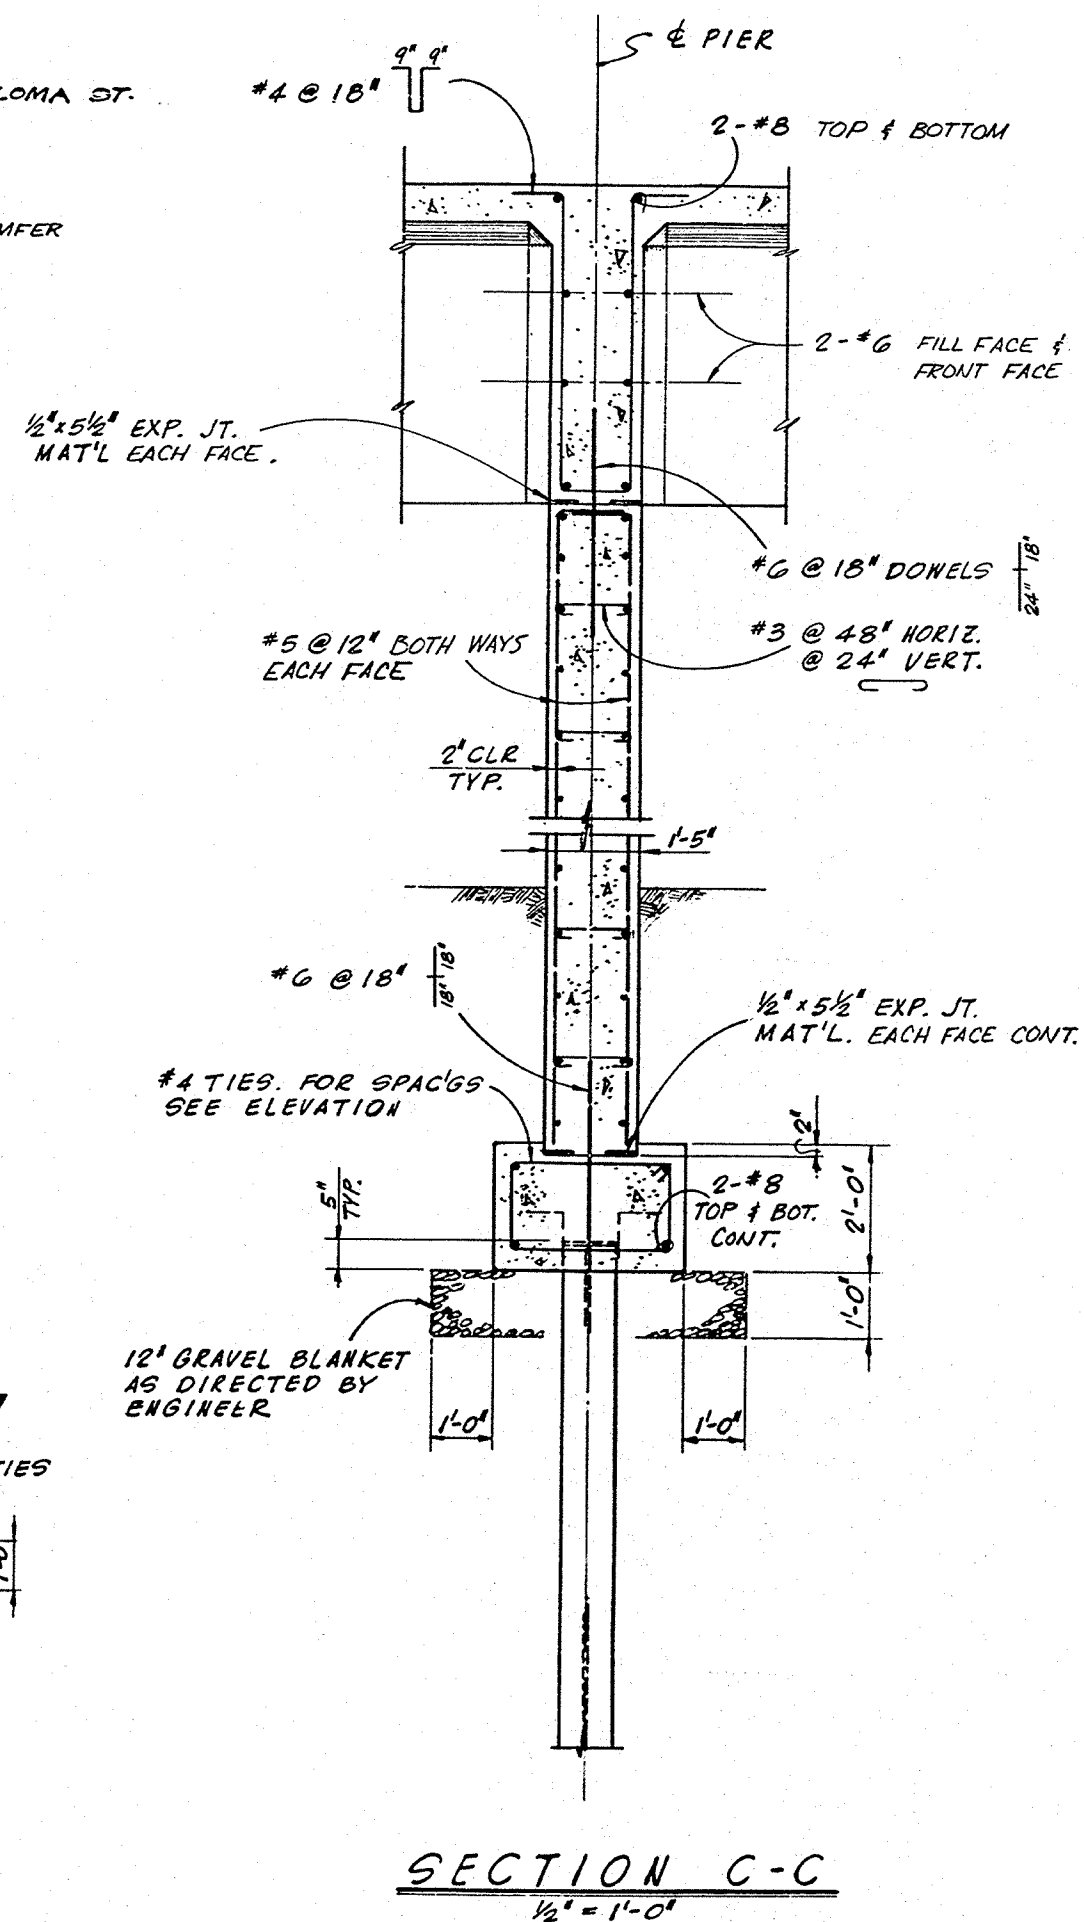
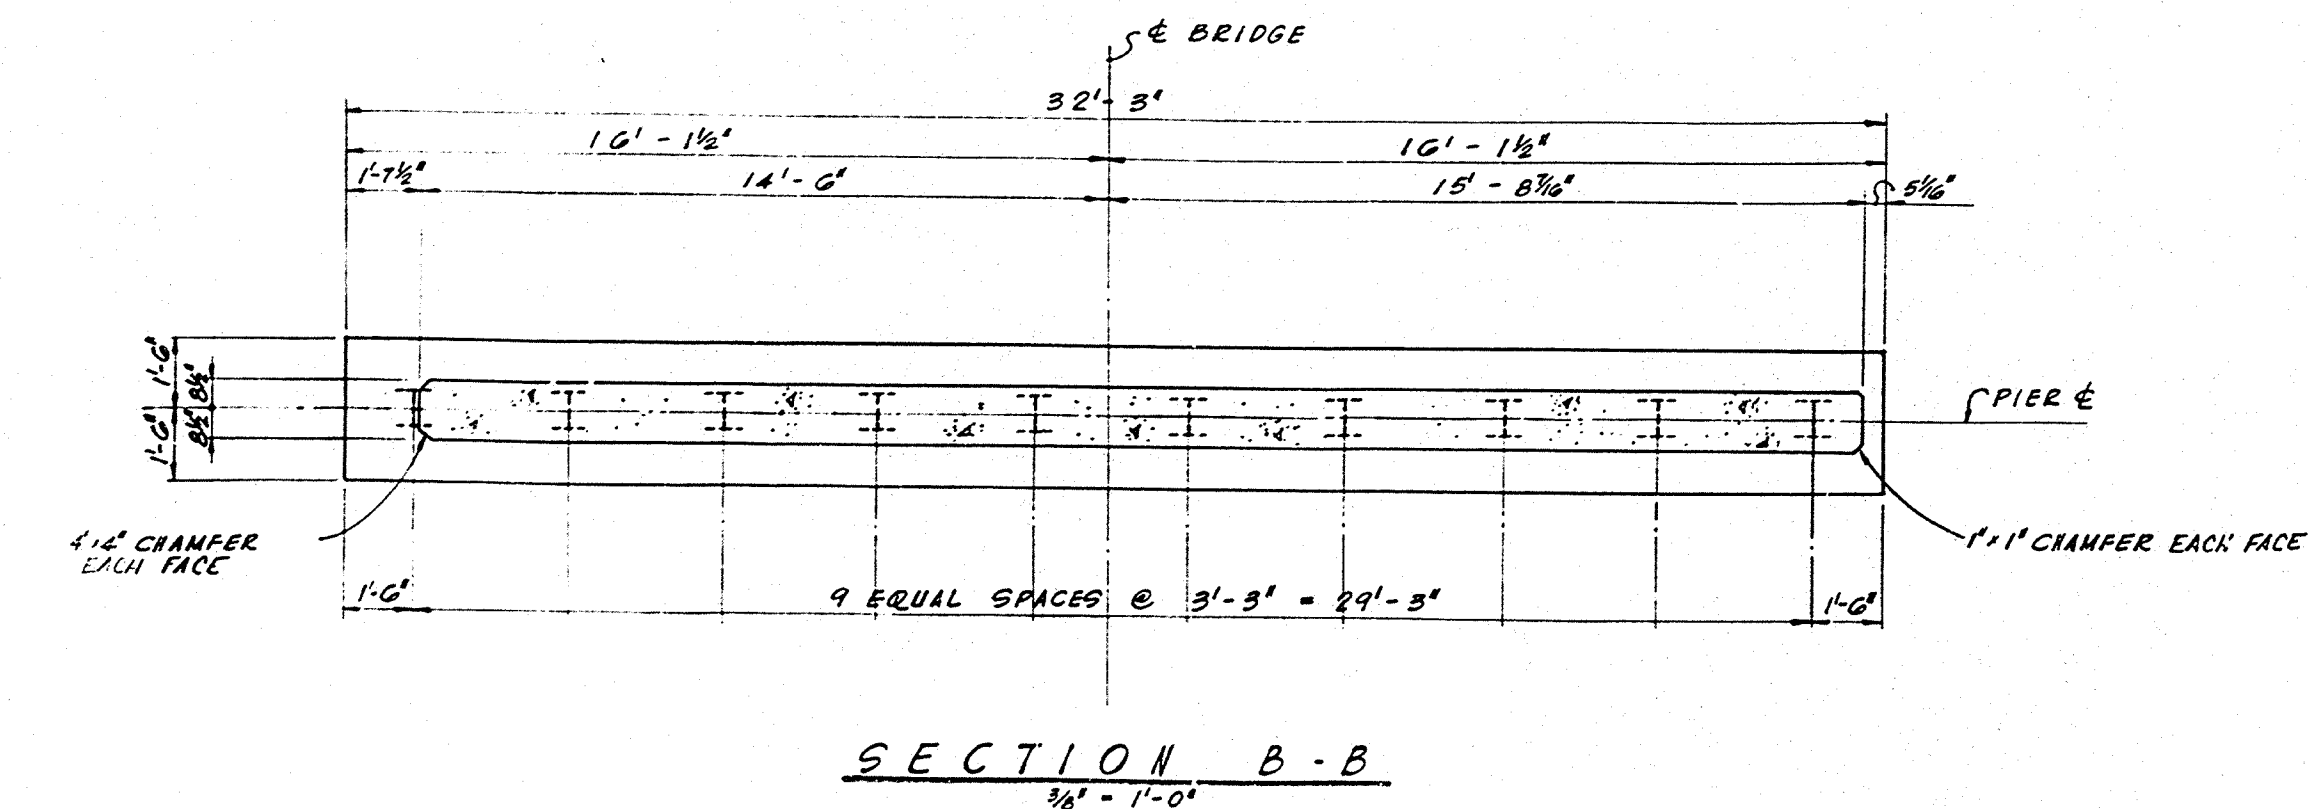
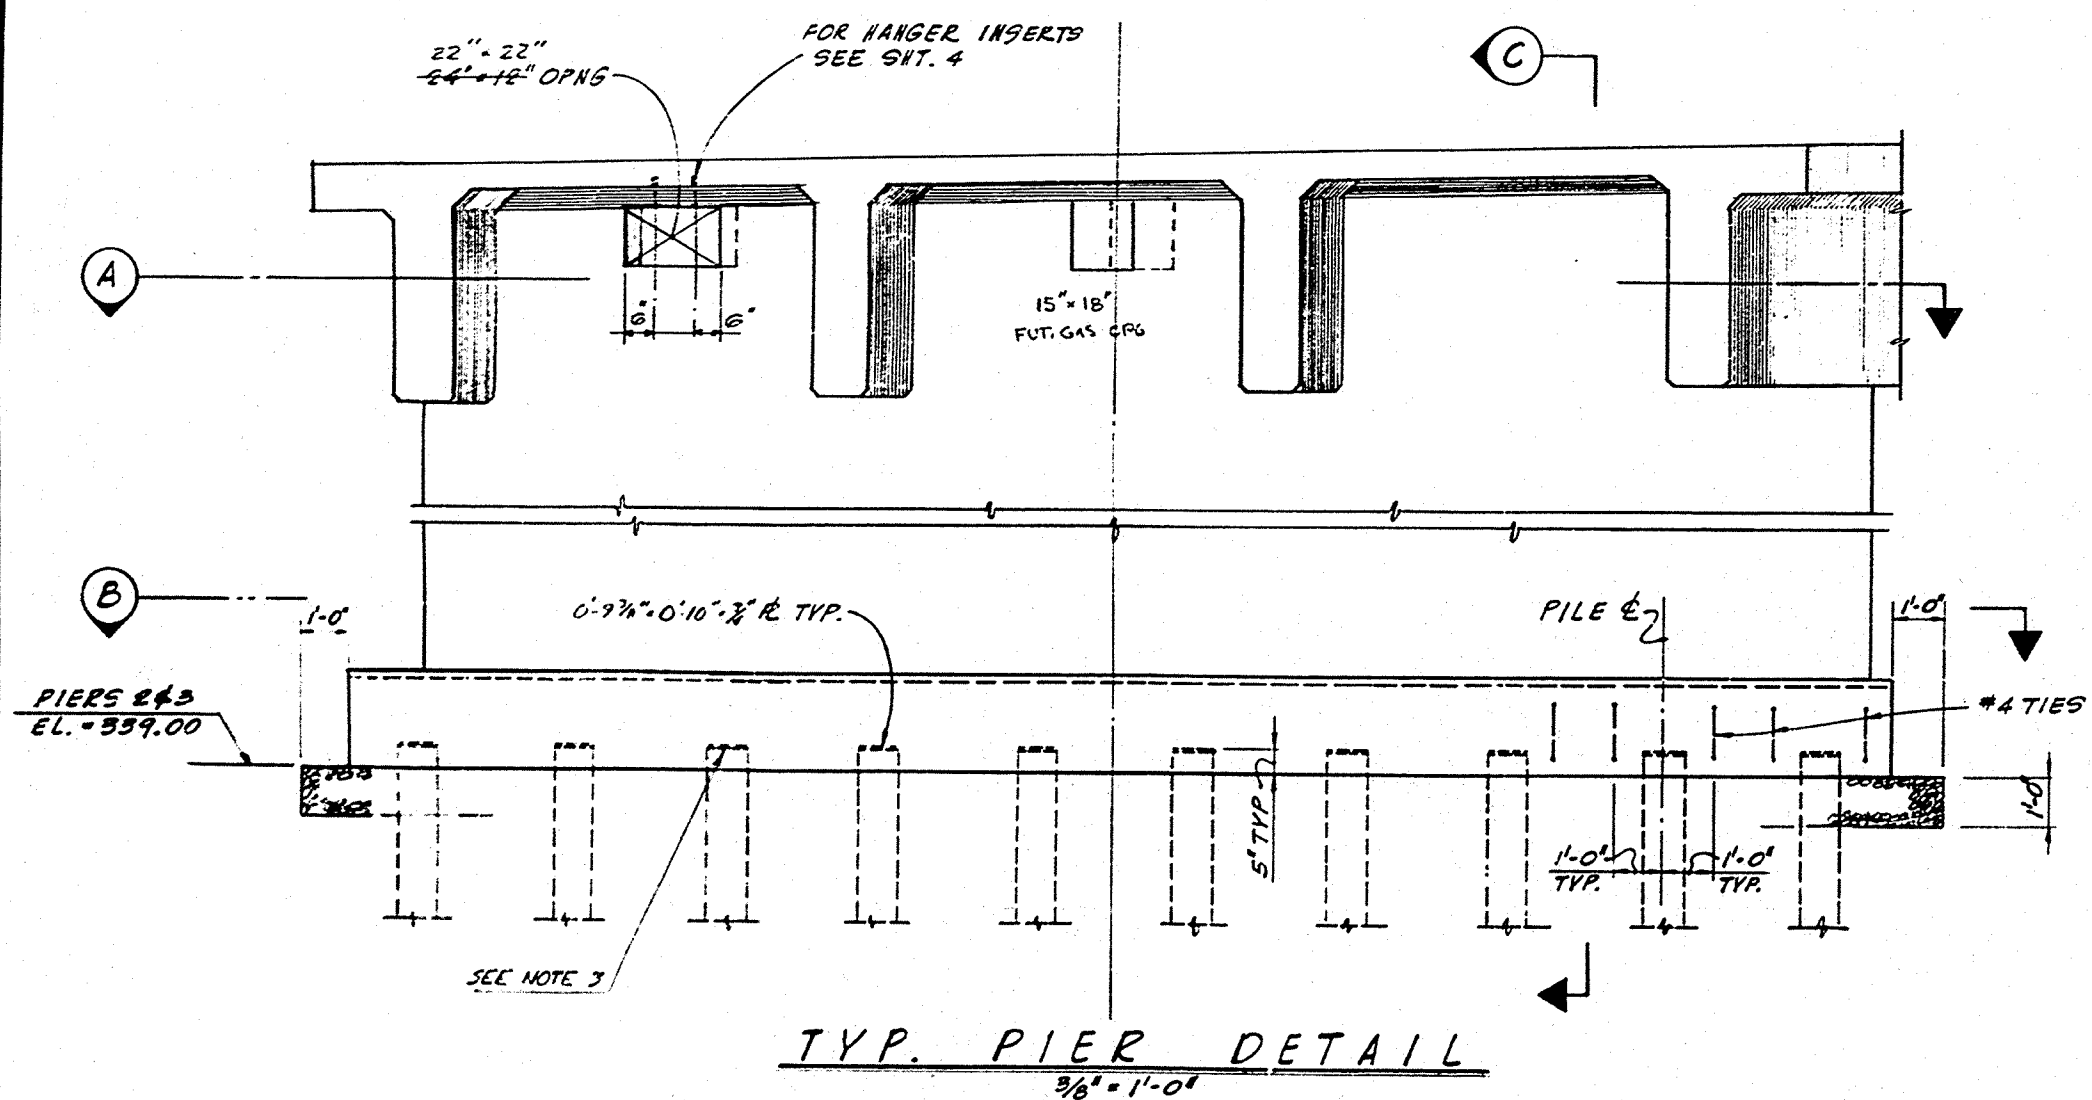


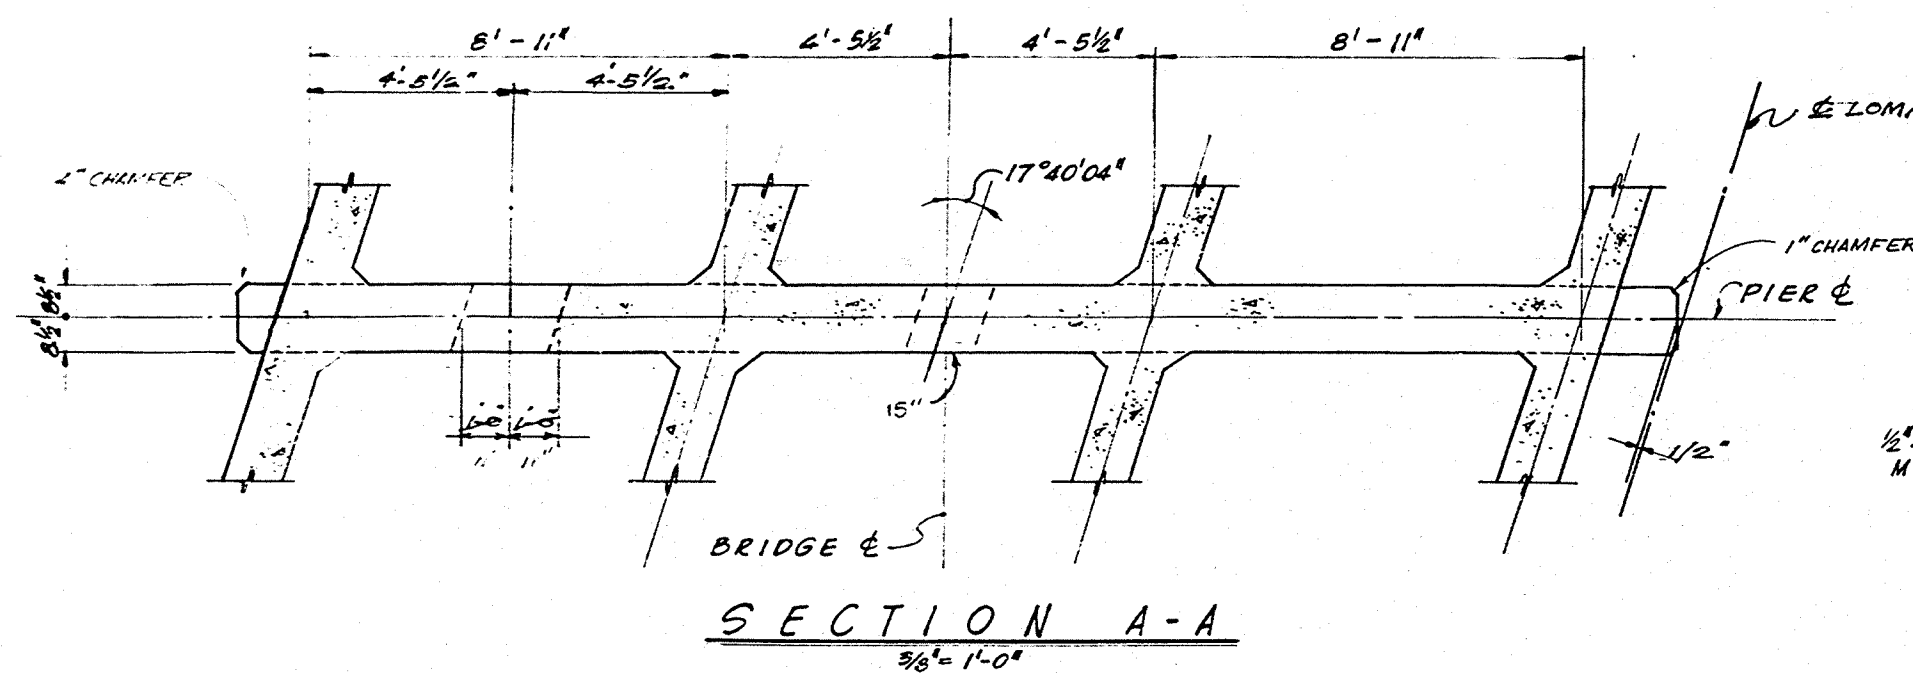

- NOTES
1. PIERS SHALL BE SECURELY BRACED AGAINST LATERAL LOADS DURING CONSTRUCTION.
 2. FOR PILE TIP ELEVATIONS, SEE SHT. 3
 3. FOR H-PILE DETAILS SEE SHT. 3

AS BUILT

ORANGE COUNTY ROAD DEPARTMENT	
LOMA ST. BRIDGE	
SC-11	
OVER	
SANTIAGO CREEK	
PIER DETAILS	
SCALE <i>As Shown</i>	SHEET 5 OF 6

DR 11 (12475)