

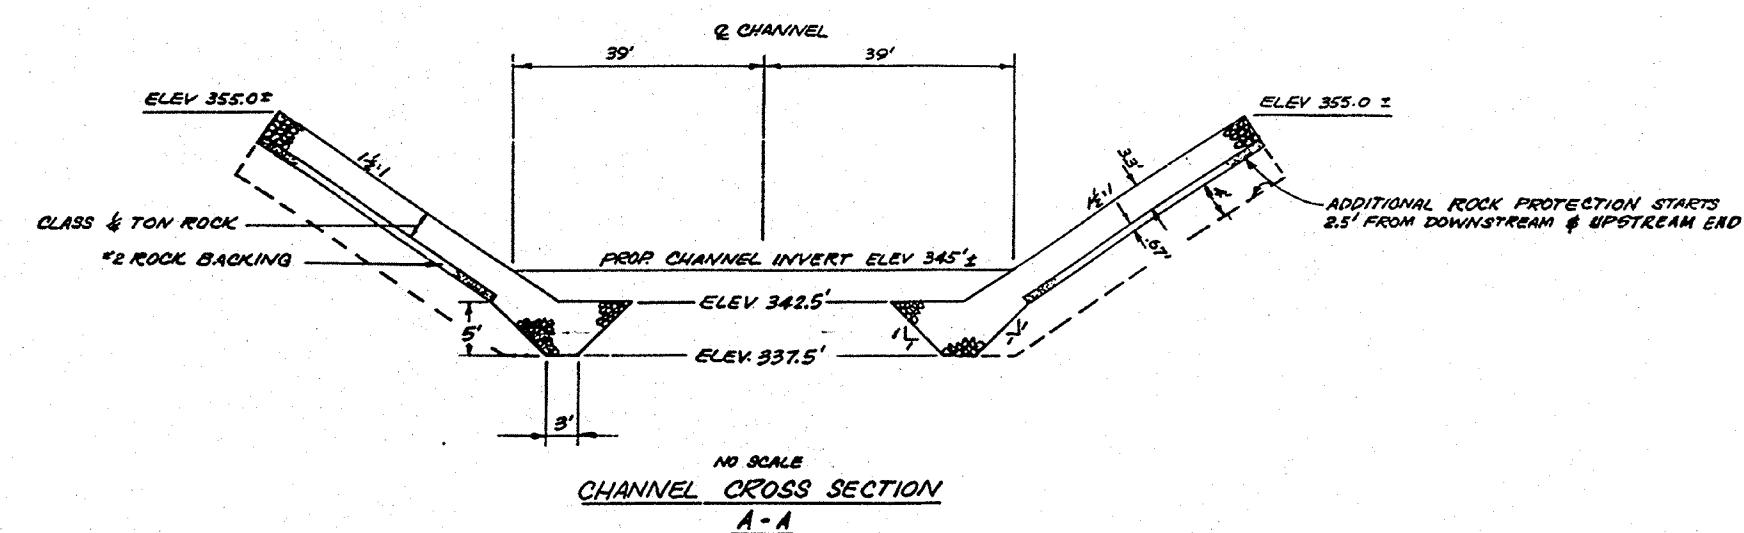
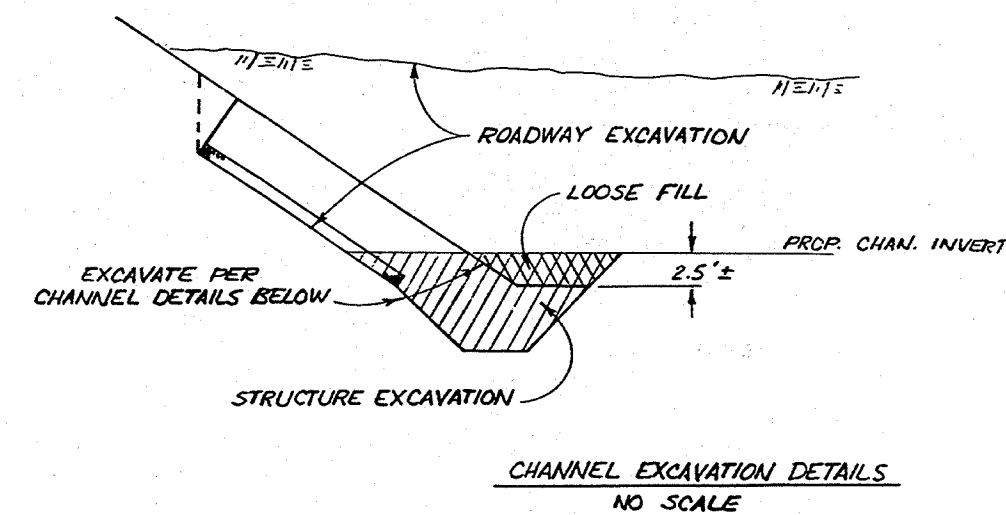


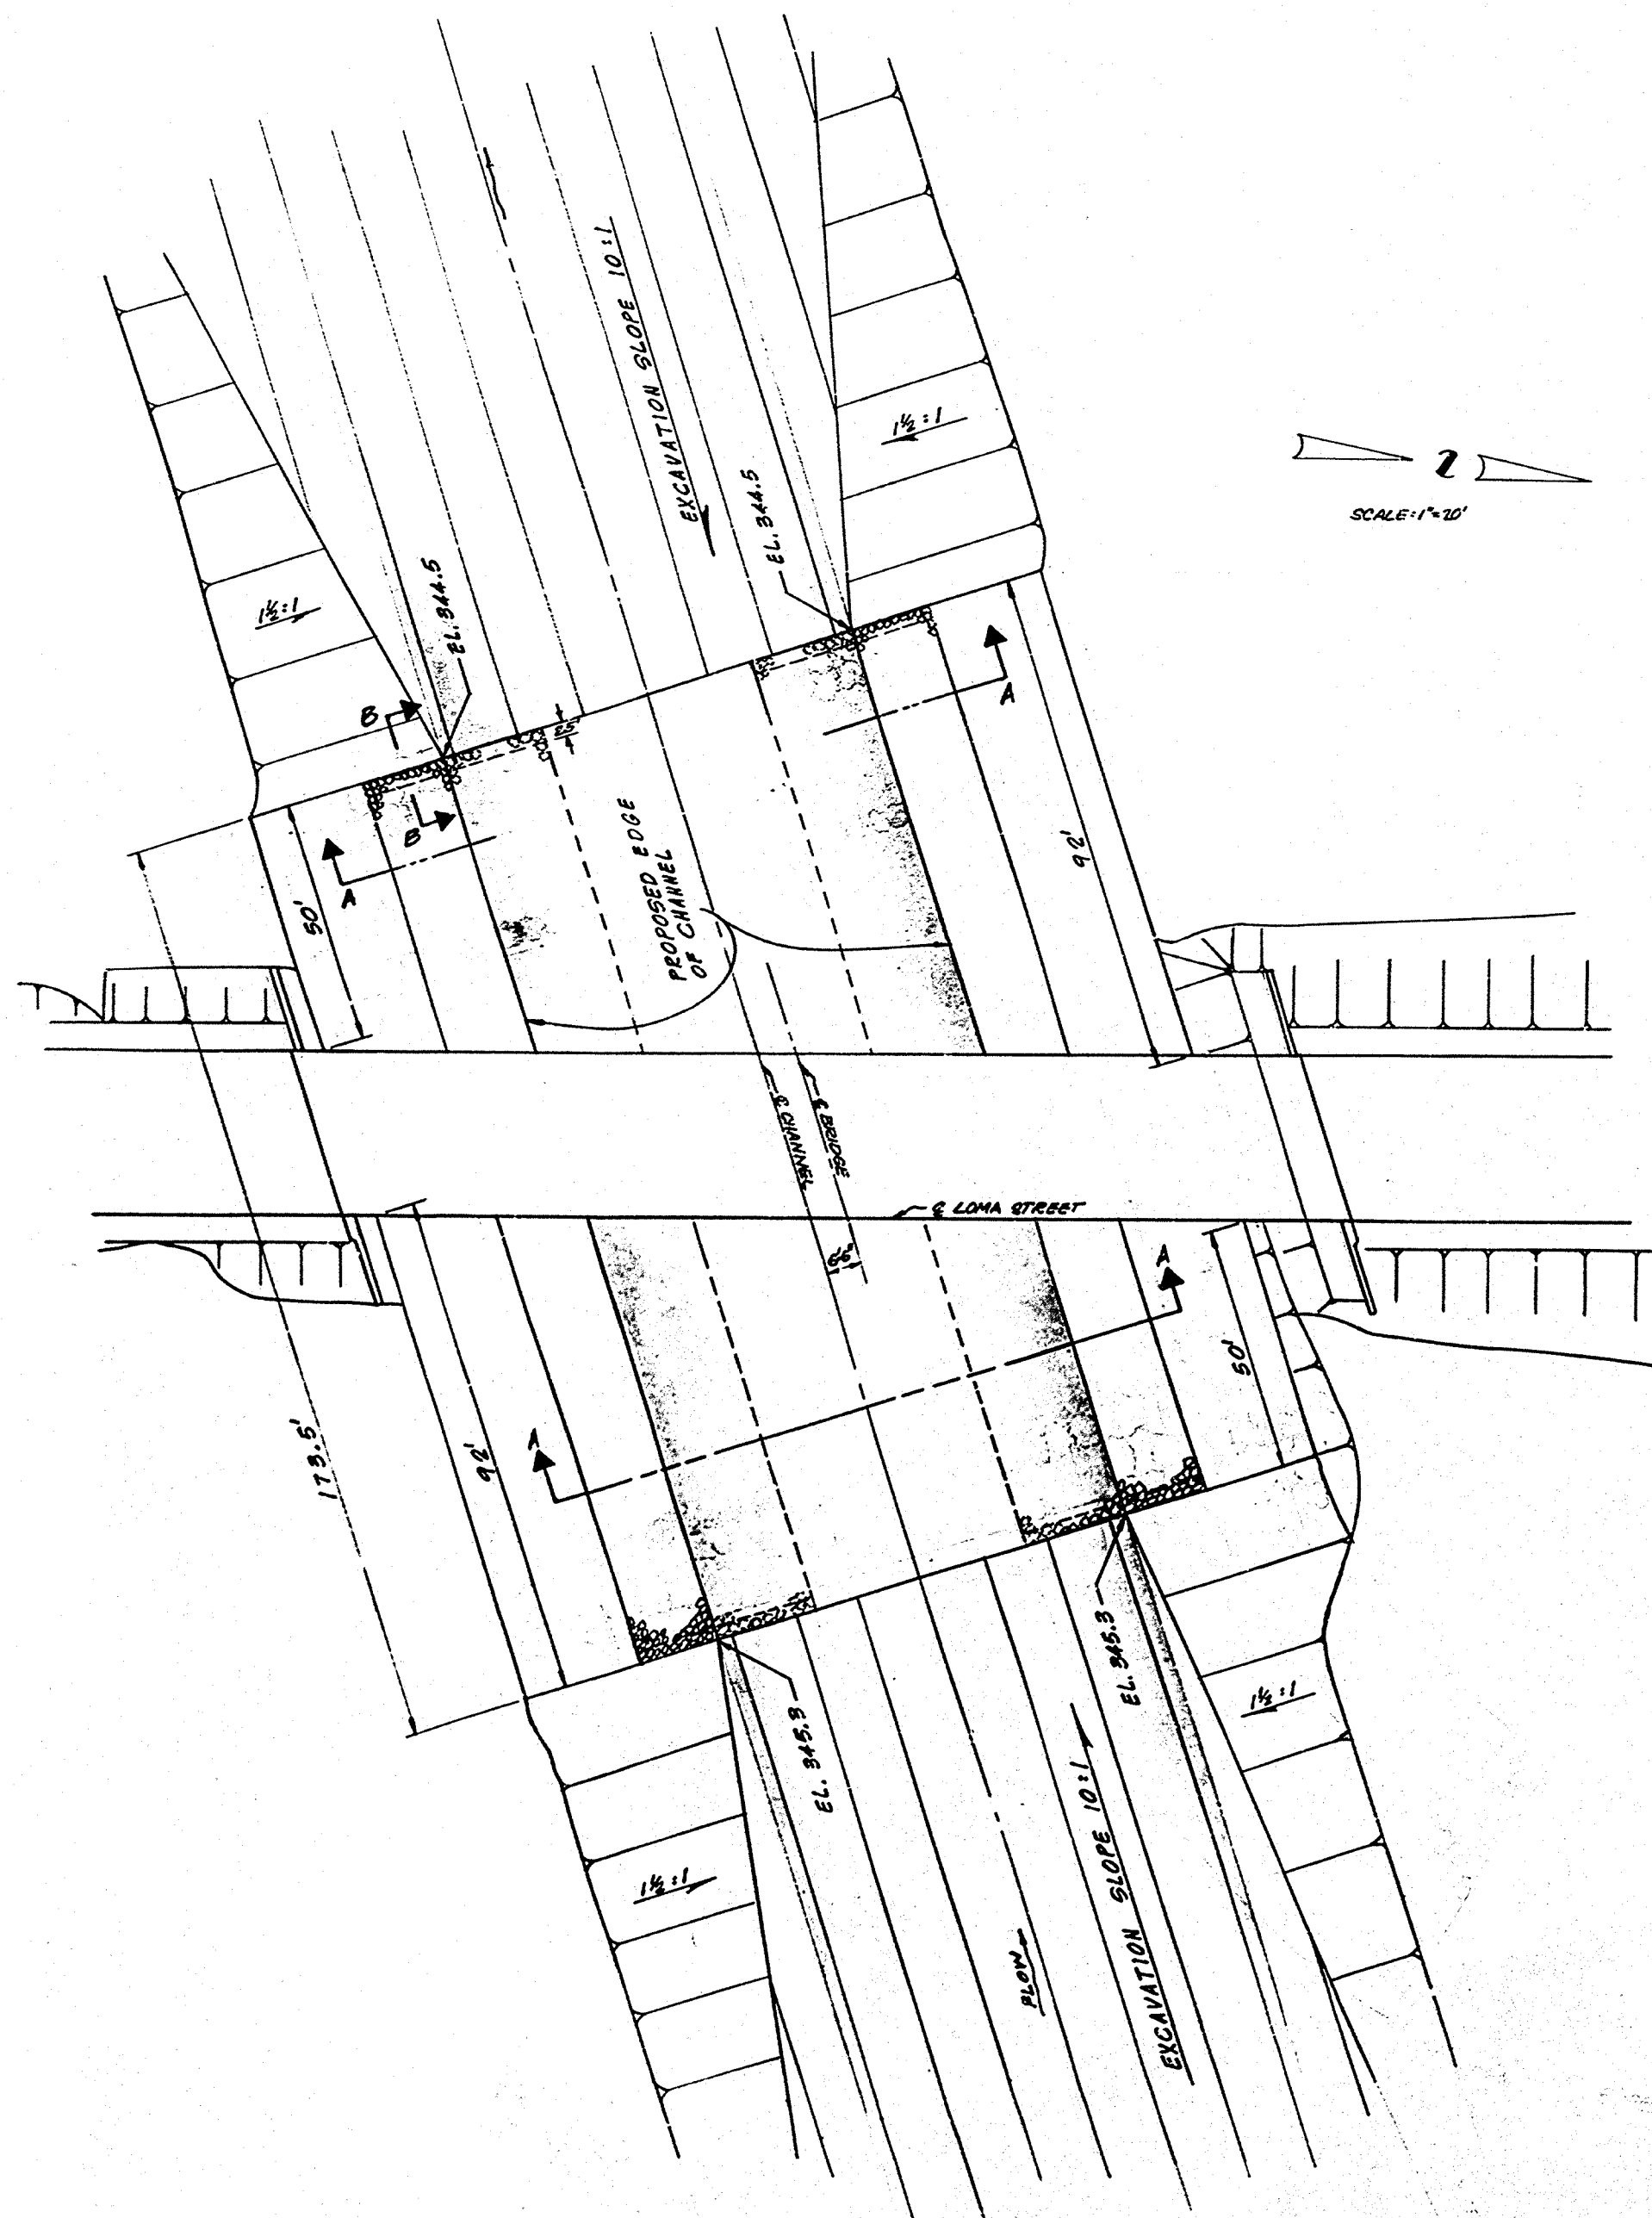

NOTES

FACING STONE 1/2 TON
BACKING STONE NO. 2
PLACEMENT: METHOD "B"

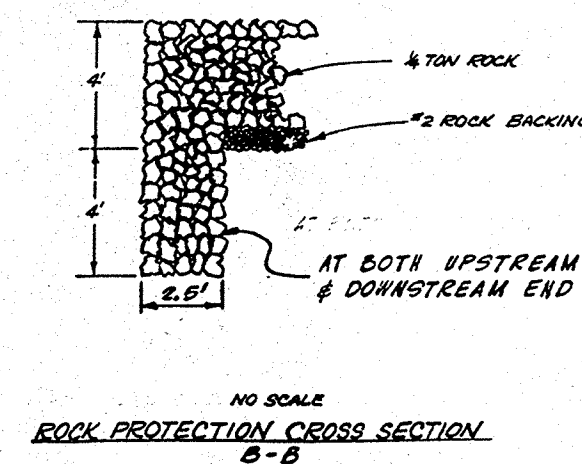

CONSTRUCTION PLANS
Loma Street Bridge
Sheet 10 of 11
Red. 22.5:1 Scale: as shown
Vellus

MICROFILMED
APR 1971

AS BUILT

ORANGE COUNTY ROAD DEPARTMENT	
LOMA ST. BRIDGE SC-11 OVER SANTIAGO CREEK CHANNEL PROTECTION PLAN	
SCALE: As shown	SHEET 10 OF 11

DR 11 (10475)