

CONSTRUCTION PLANS

FOR THE YEAR 1969

ARTERIAL HIGHWAY FINANCING PROGRAM

CENTRAL AVENUE

500 FEET WEST OF DE JUR STREET TO BREA BOULEVARD

LENGTH 1.54 MILES

CITY OF BREA - AHFP NO. 377 • ORANGE COUNTY - AHFP NO. 377


SEE SHEET 8 FOR ITEMS

PHASE A, STREET IMPROVEMENT, (ITEMS 1-64, SHEETS 1-14)

PHASE B, BRIDGE CONSTRUCTION, (ITEM 67-69, SHEETS 1, 7, 8, 10, 11, 14)

PHASE C, WATER SYSTEM, (ITEMS 70-78, SHEETS 1, 3-8)

PHASE D, STREET LIGHTING, (ITEMS 80-84, SHEETS 1, 5-9)

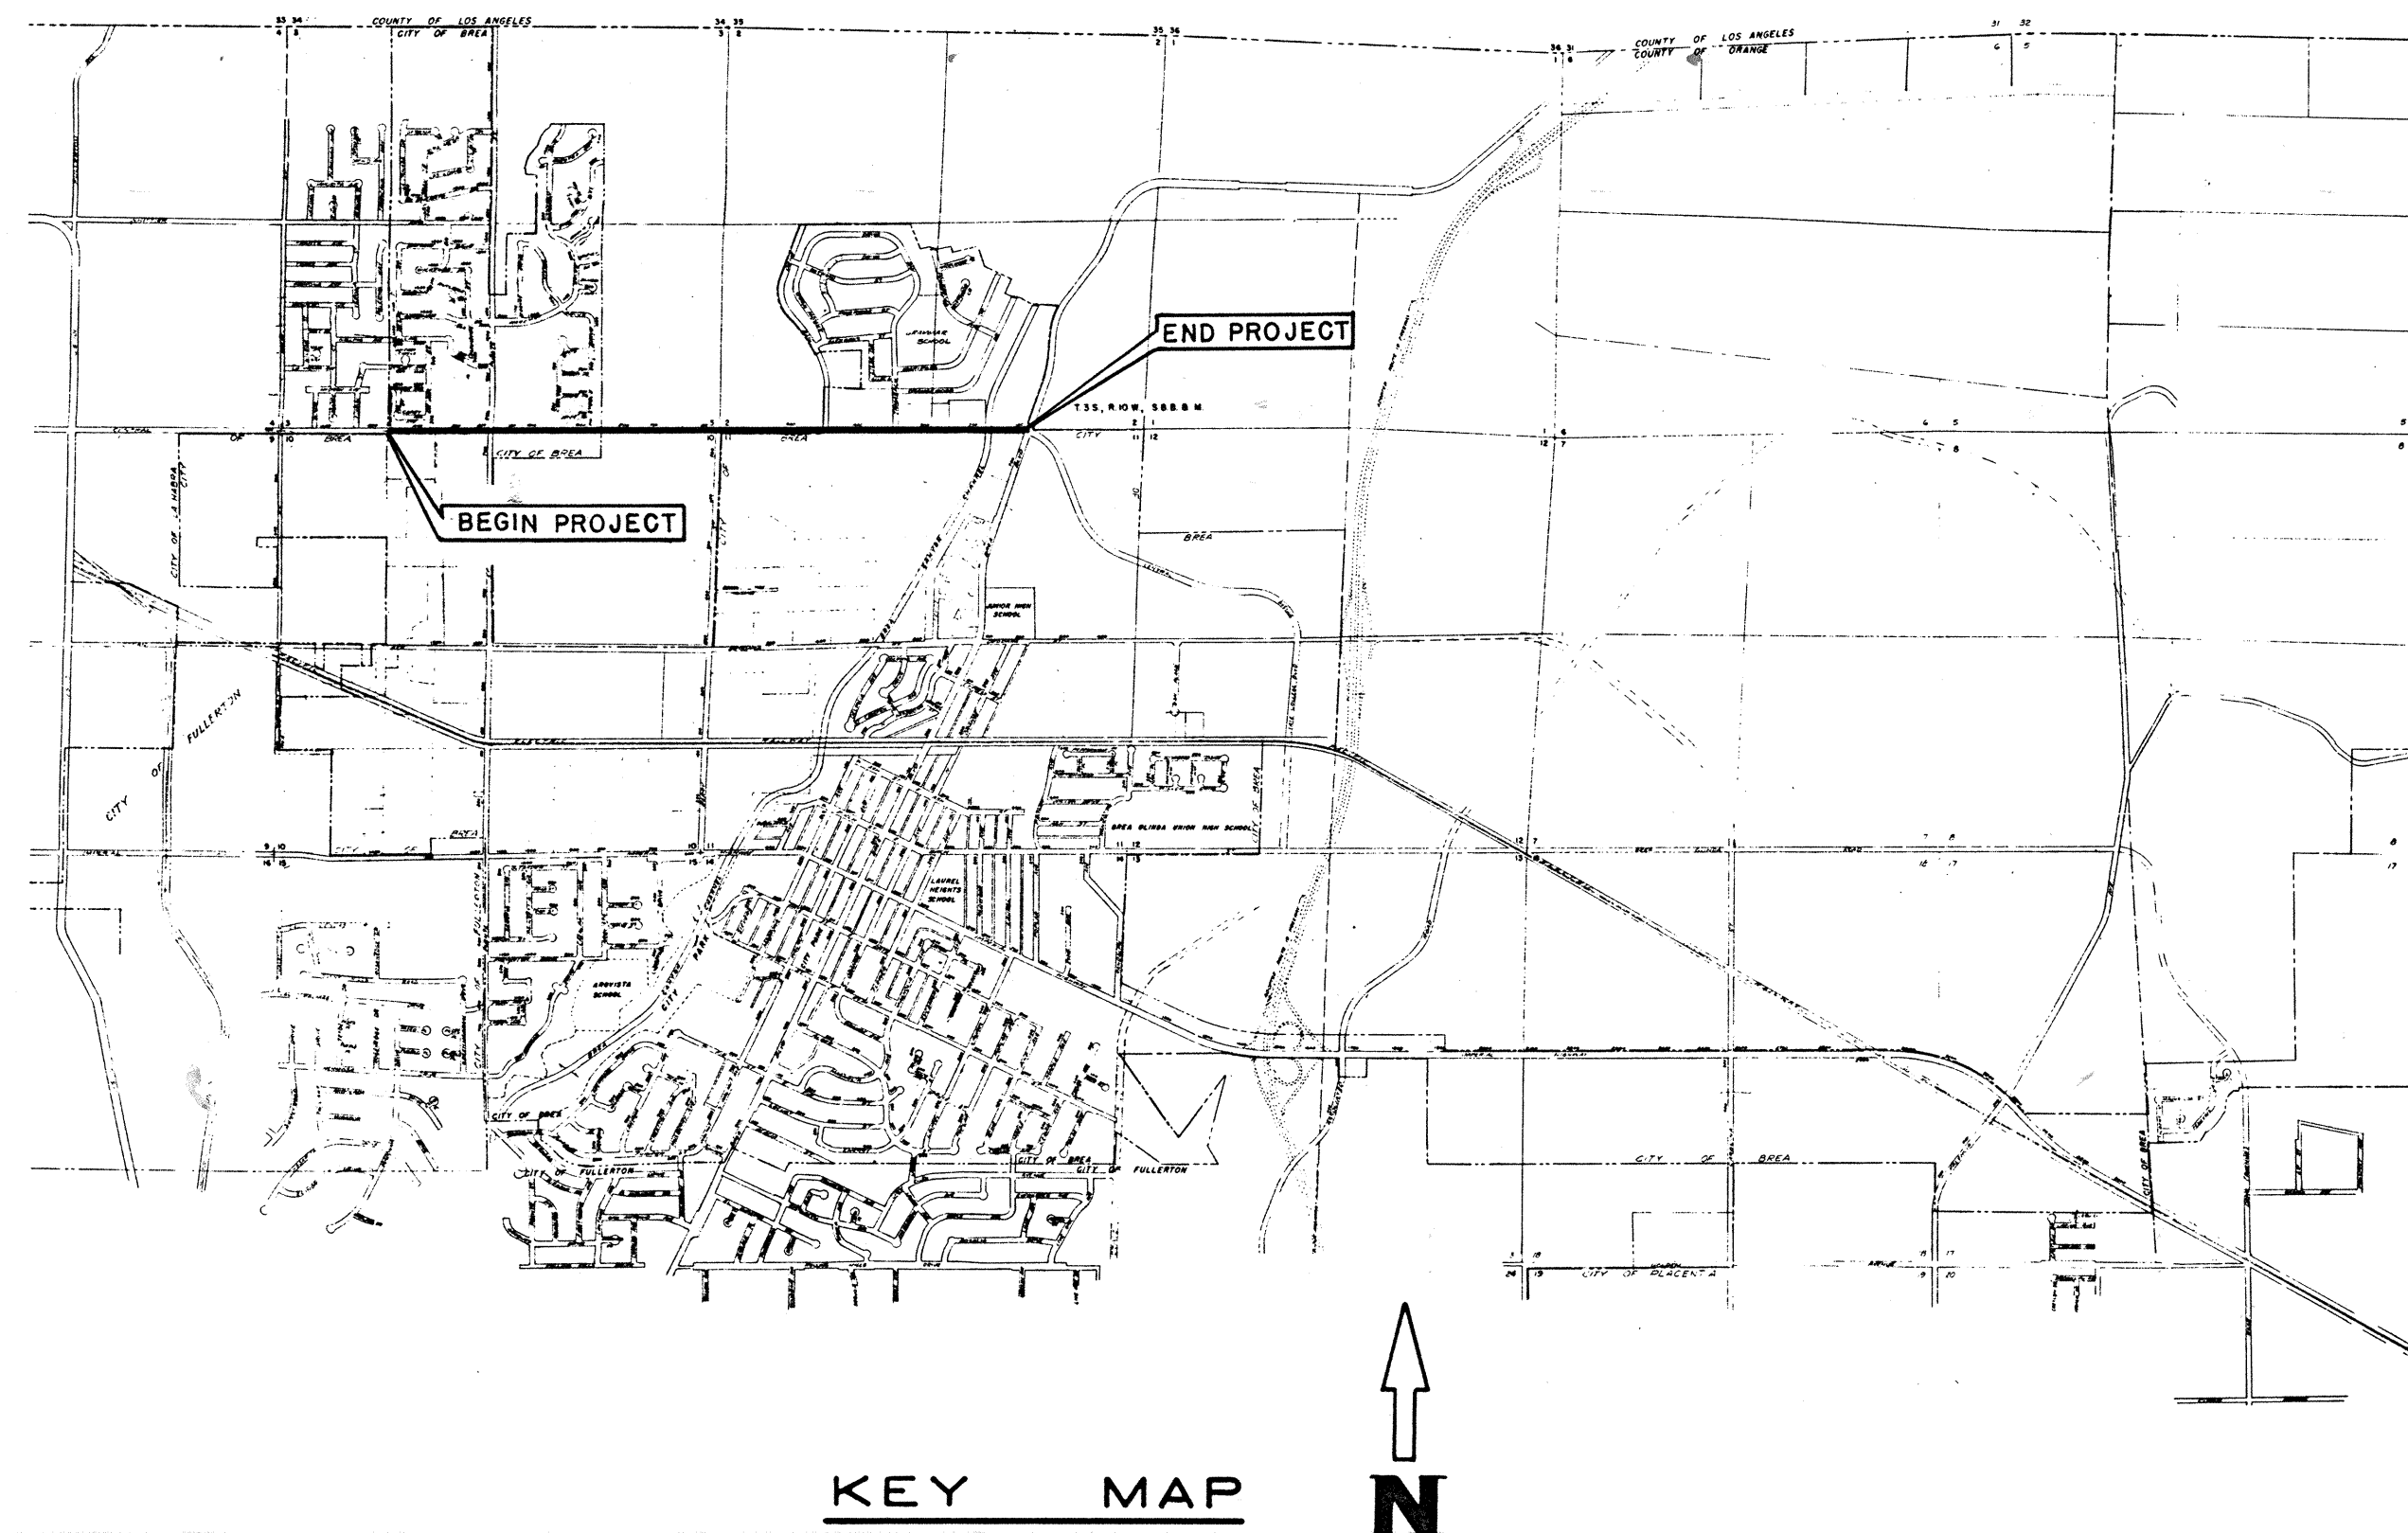

KEY MAP

CITY COUNCILMEN

WILLIAM D. HAMILTON, MAYOR

ROBERT A. CLARK

THOMAS O. SPEER


SAM L. MAGNUS

JOHN P. HADDOX

CITY MANAGER - WAYNE D. WEDIN

APPROVED *Harold A. Wilson*
BREA CITY ENGINEER
HAROLD A. WILSON, R.C.E. NO. 8646

APPROVED *Allen S. Koch*
ALLEN S. KOCH
ORANGE COUNTY - ROAD COMMISSIONER
AND COUNTY SURVEYOR

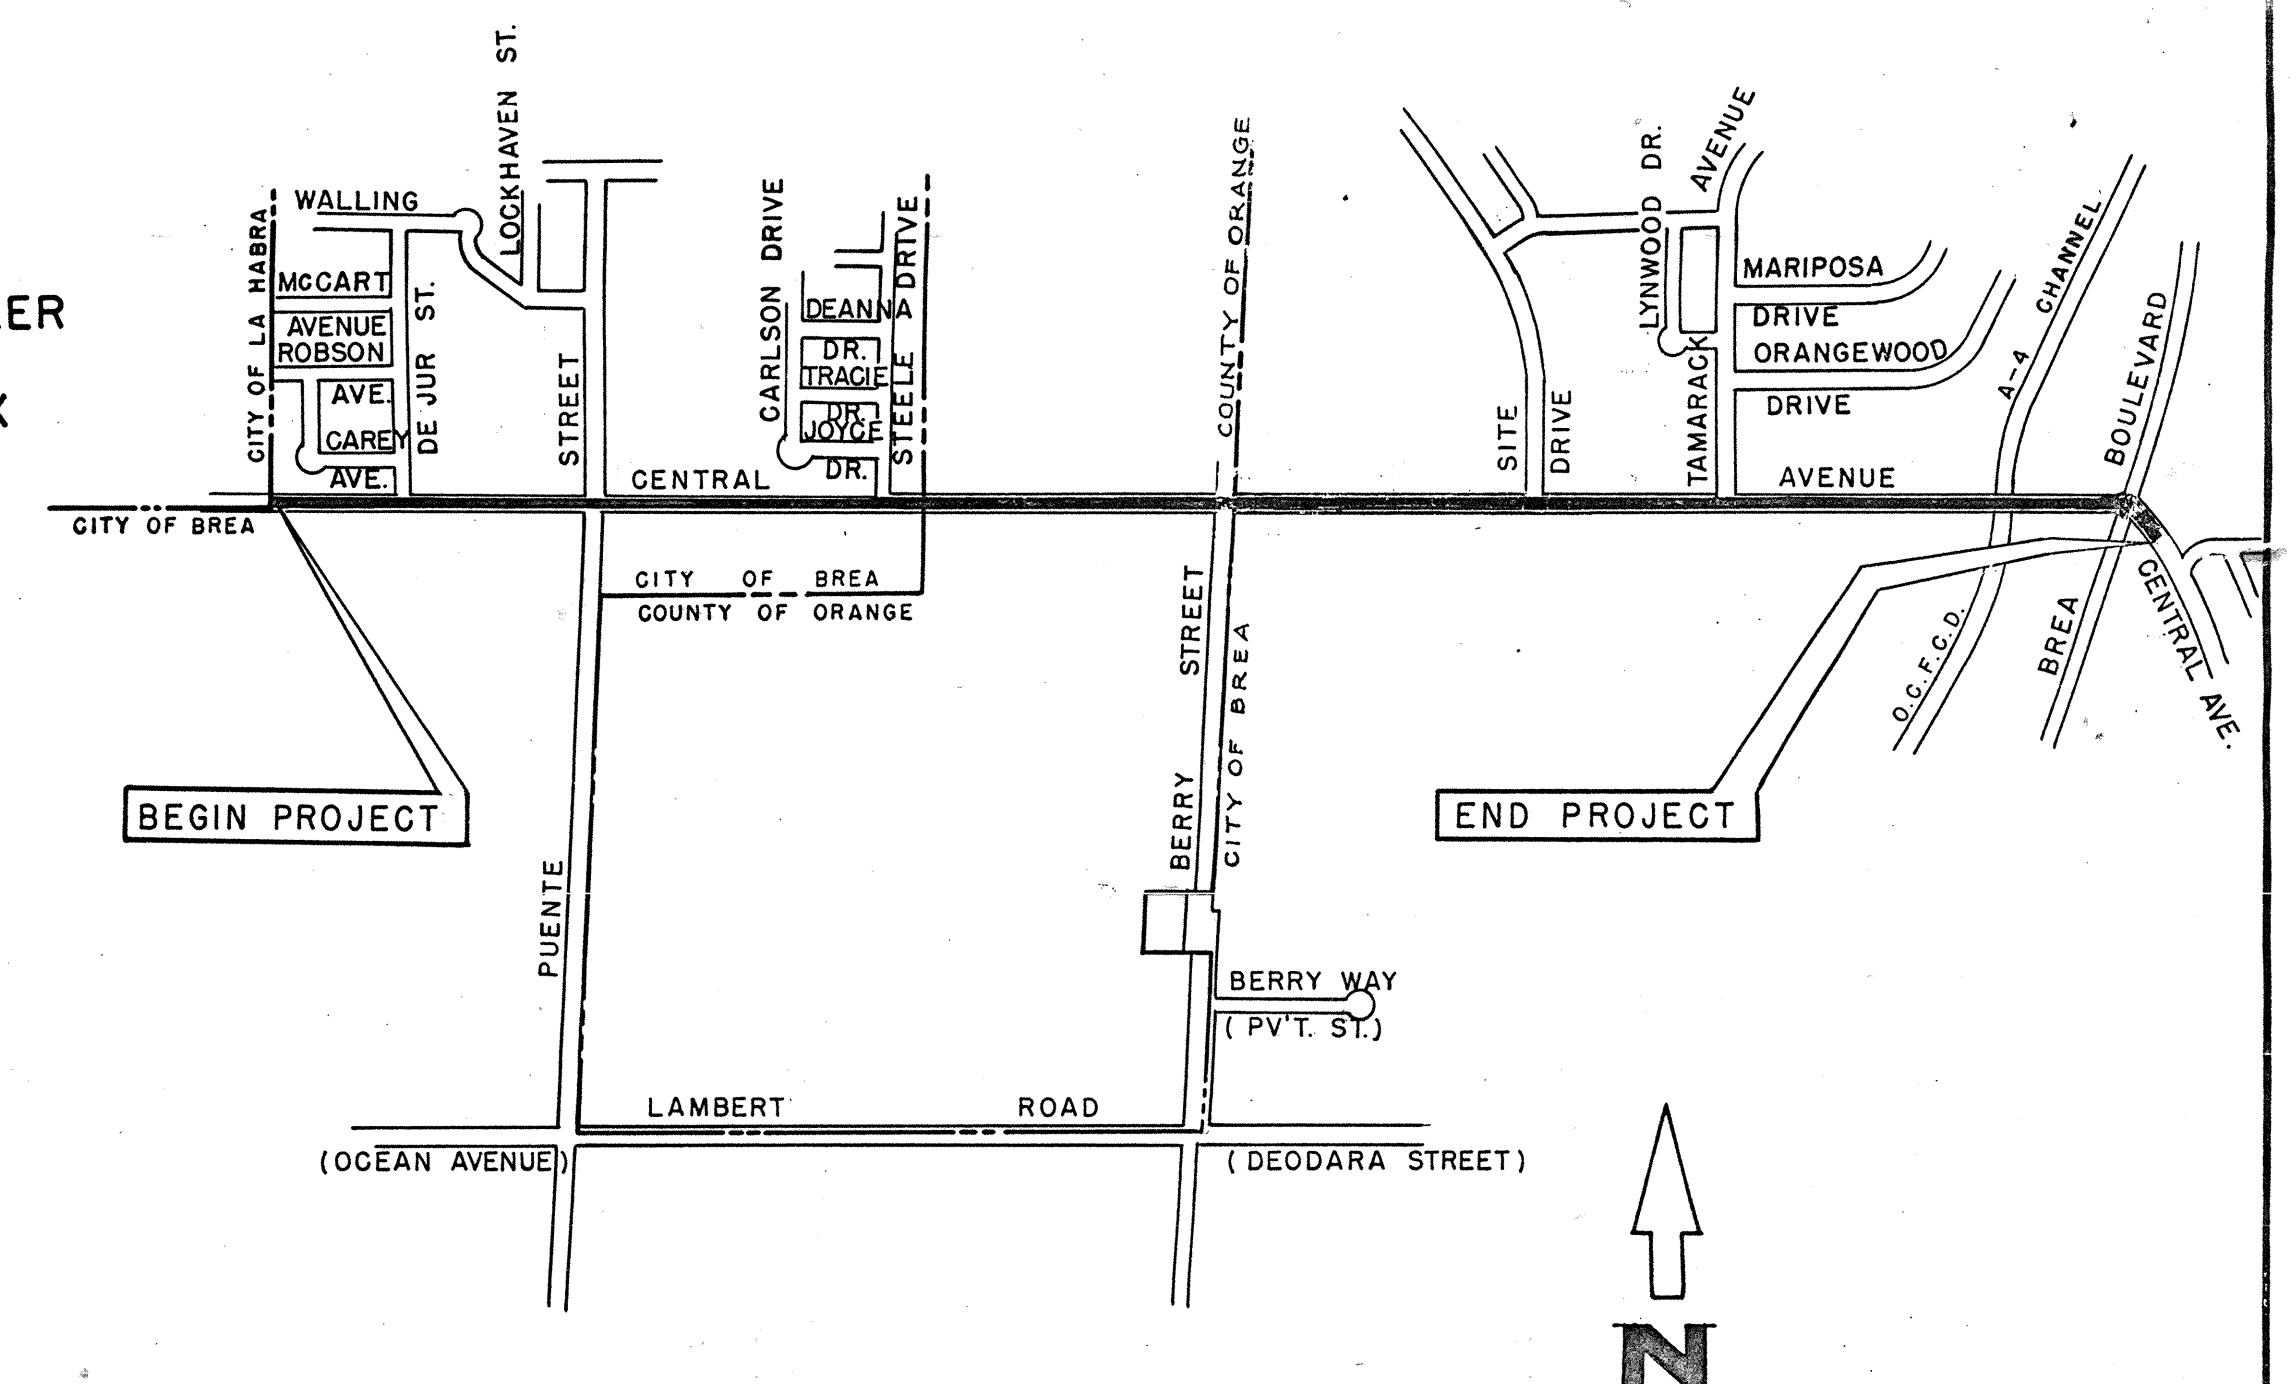

"AS BUILT"
VICINITY AND SHEET INDEX
MAP
SEE SHEET 8 FOR QUANTITY ESTIMATES

REVISIONS

DATE	INITIAL	DESCRIPTION	APP'D	DATE	INITIAL	DESCRIPTION	APP'D	DATE	INITIAL	DESCRIPTION	APP'D

PREPARED BY:
KEITH AND ASSOCIATES
CIVIL ENGINEERS
1525 SOUTH GRAND AVENUE
SANTA ANA, CALIFORNIA 92705
Milo K. Keith 16 May 1969
MILO K. KEITH, R.C.E. NO. 9851

CITY OF BREA
CENTRAL AVENUE

500 FEET WEST OF DE JUR STREET TO BREA BOULEVARD
ARTERIAL HIGHWAY FINANCING PROGRAM NO. 377

DEPARTMENT OF PUBLIC WORKS

KEY NO.

SHEET NO.

1 OF 14