



DIST.	COUNTY	ROUTE	POST MILES-TOTAL PROJECT	SHEET NO.	TOTAL SHEETS
07	Ora.	57	10.7/12.5	166	293


DESIGN SECTION SUPERVISOR
 DATE APPROVED
 April 16, 1973

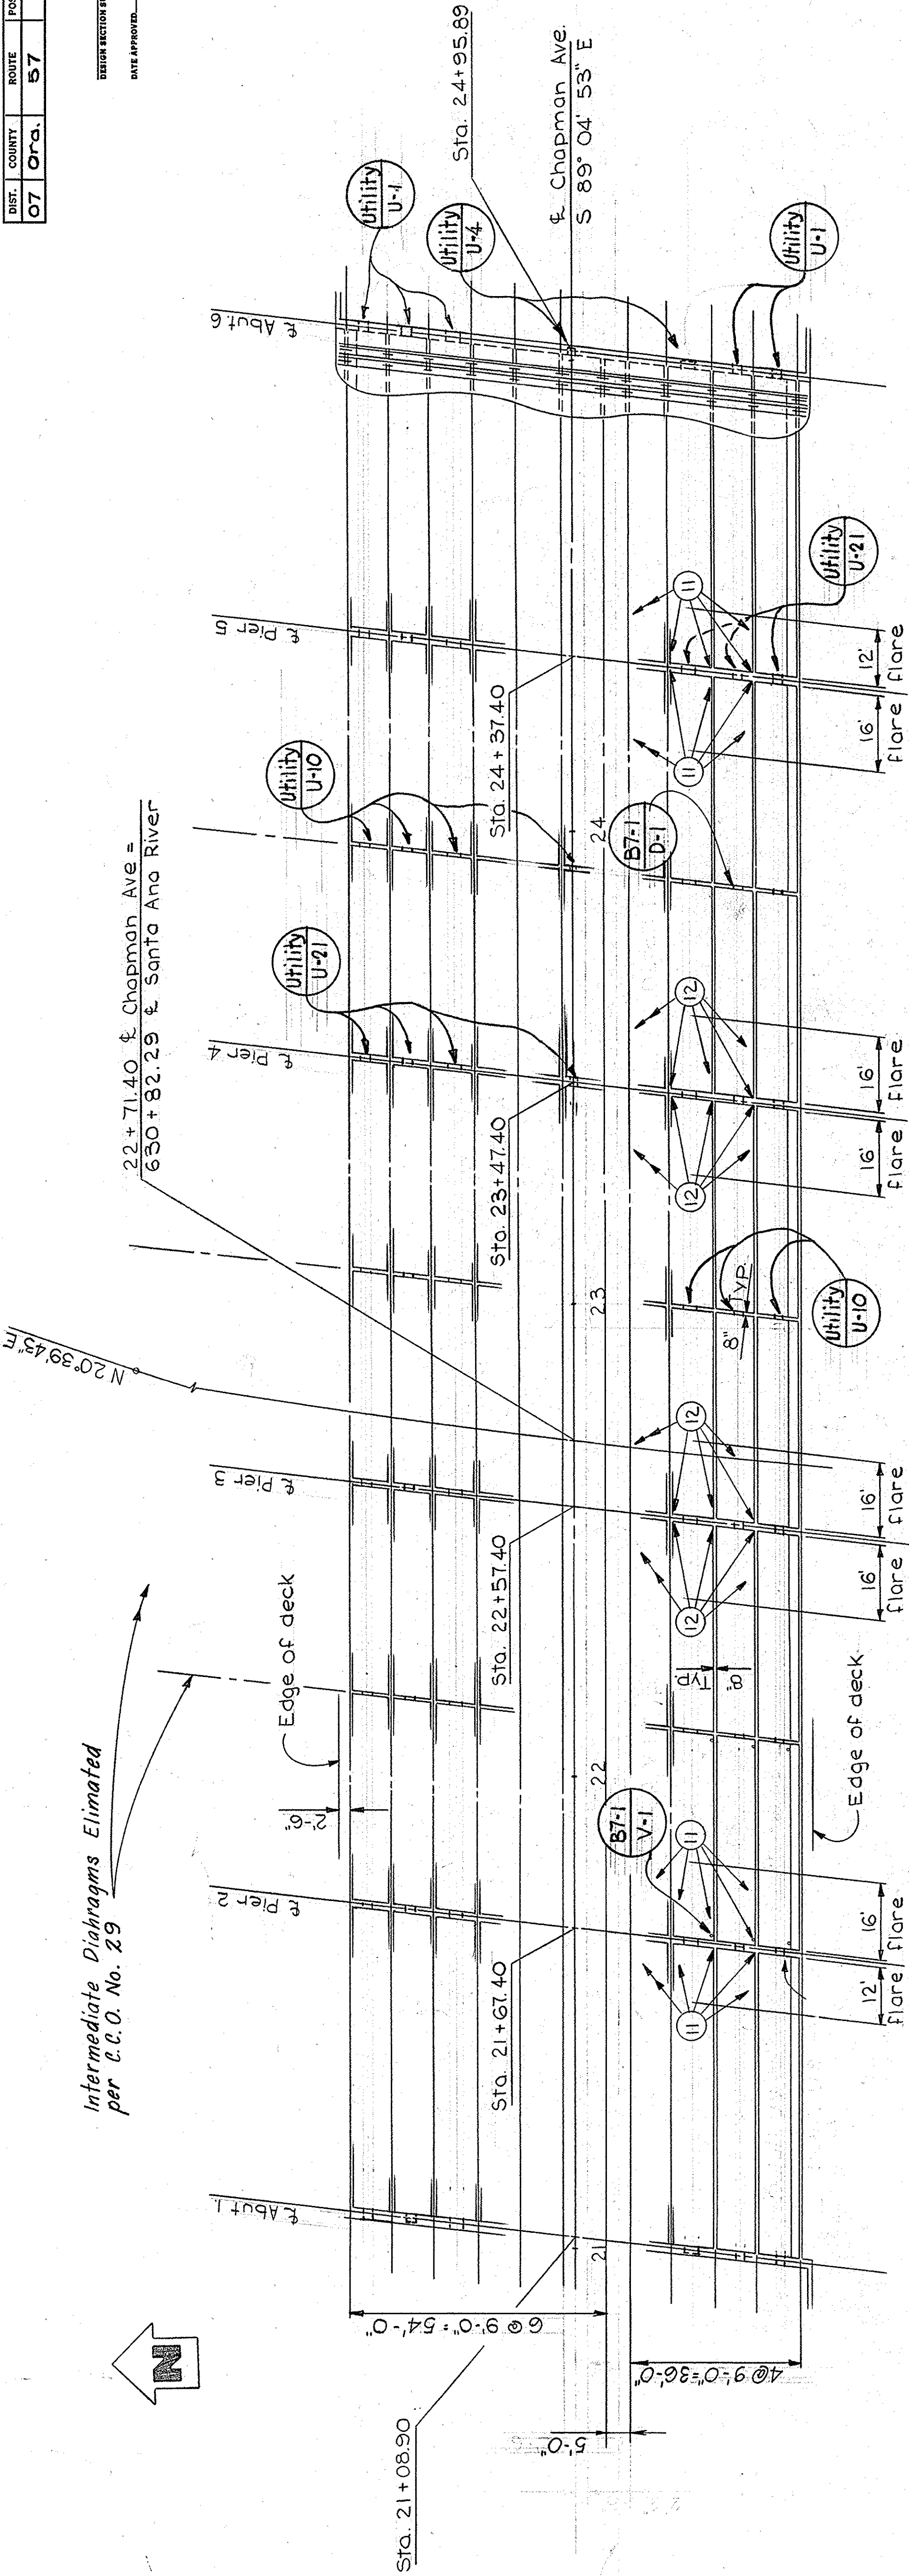

GIRDER LAYOUT
 Scale: 1" = 20'-0"

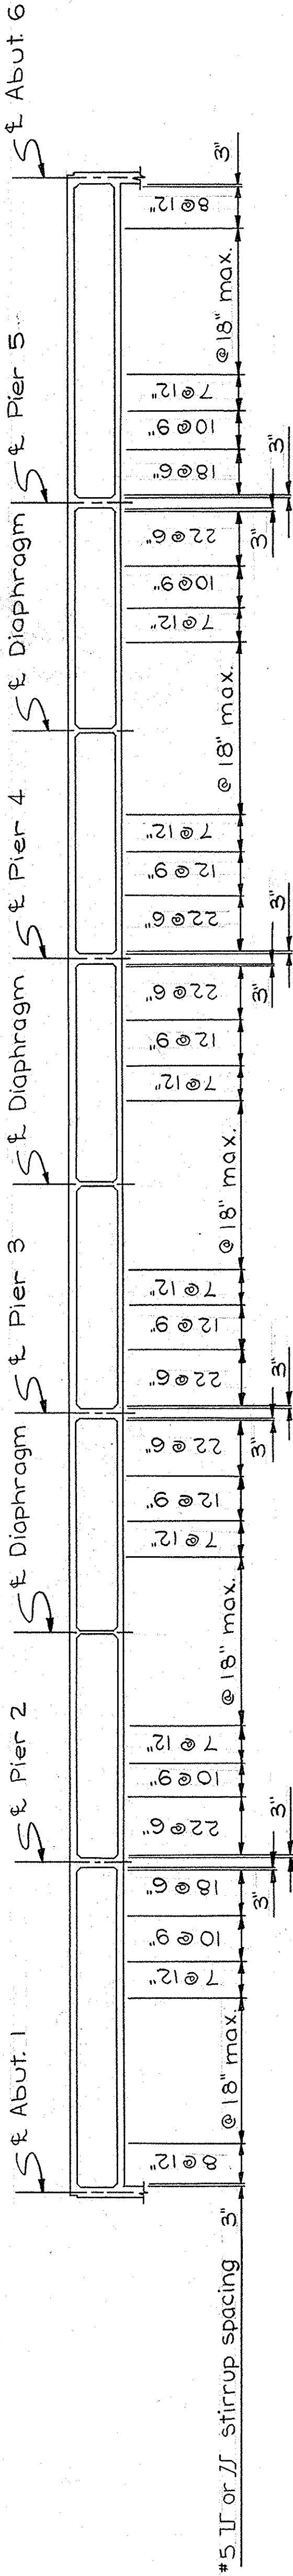

LONGITUDINAL SECTION
 No. Scale

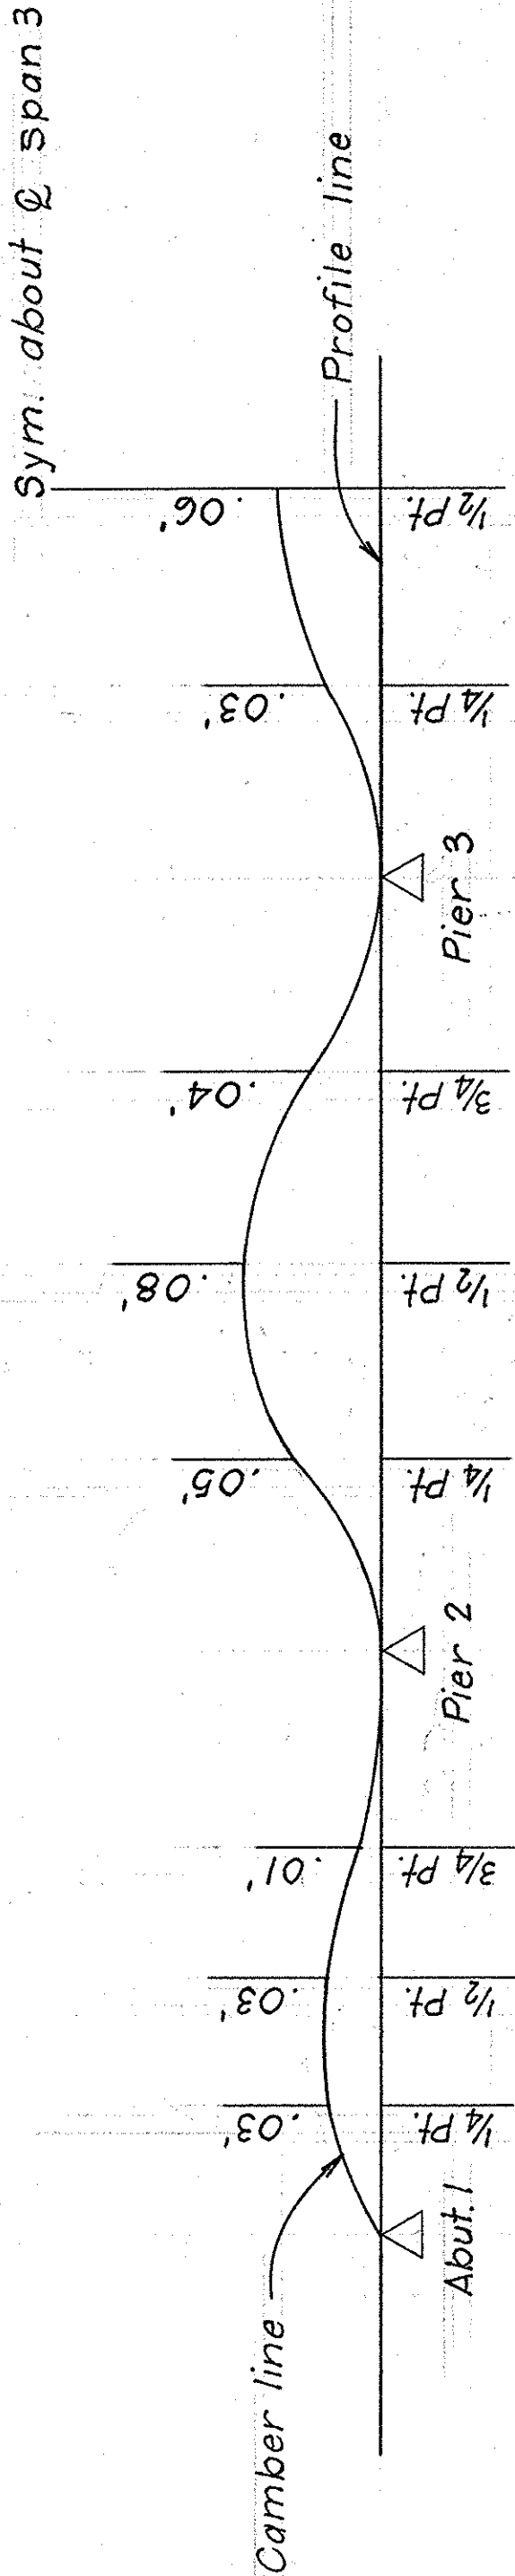

CAMBER DIAGRAM
 No. Scale

MICROFILMED
 JUL 22 1976

AS BUILT
 CORRECTIONS BY W. Hansen
 CONTRACT NO. 07-032014
 DATE 4-13-76

BRIDGE DEPARTMENT		STATE OF CALIFORNIA	
DESIGN SECTION 9		DEPARTMENT OF TRANSPORTATION	
Project Engineer: <i>P. M. Wilson</i>		SANTA ANA RIVER BRIDGE	
DESIGN: <i>West Bros.</i>		REMOVE & REPLACE	
DETAILS: <i>Don Schroeder</i>		GIRDER LAYOUT	
QUANTITIES: <i>P. Wilson</i>		BRIDGE NO. 55C-54	
		POST MILE 11.1	
		DRAWING NO. 55C-54-7	
		SHEET 7 OF 12	
		(PRELIMINARY STATE ONLY)	

Disregard print bearing earlier revision dates

WO
 CU

168