



DESIGN SECTION SUPERVISOR O. E. Borden
DATE APPROVED April 16, 1973

*These piles detected per CCO #36

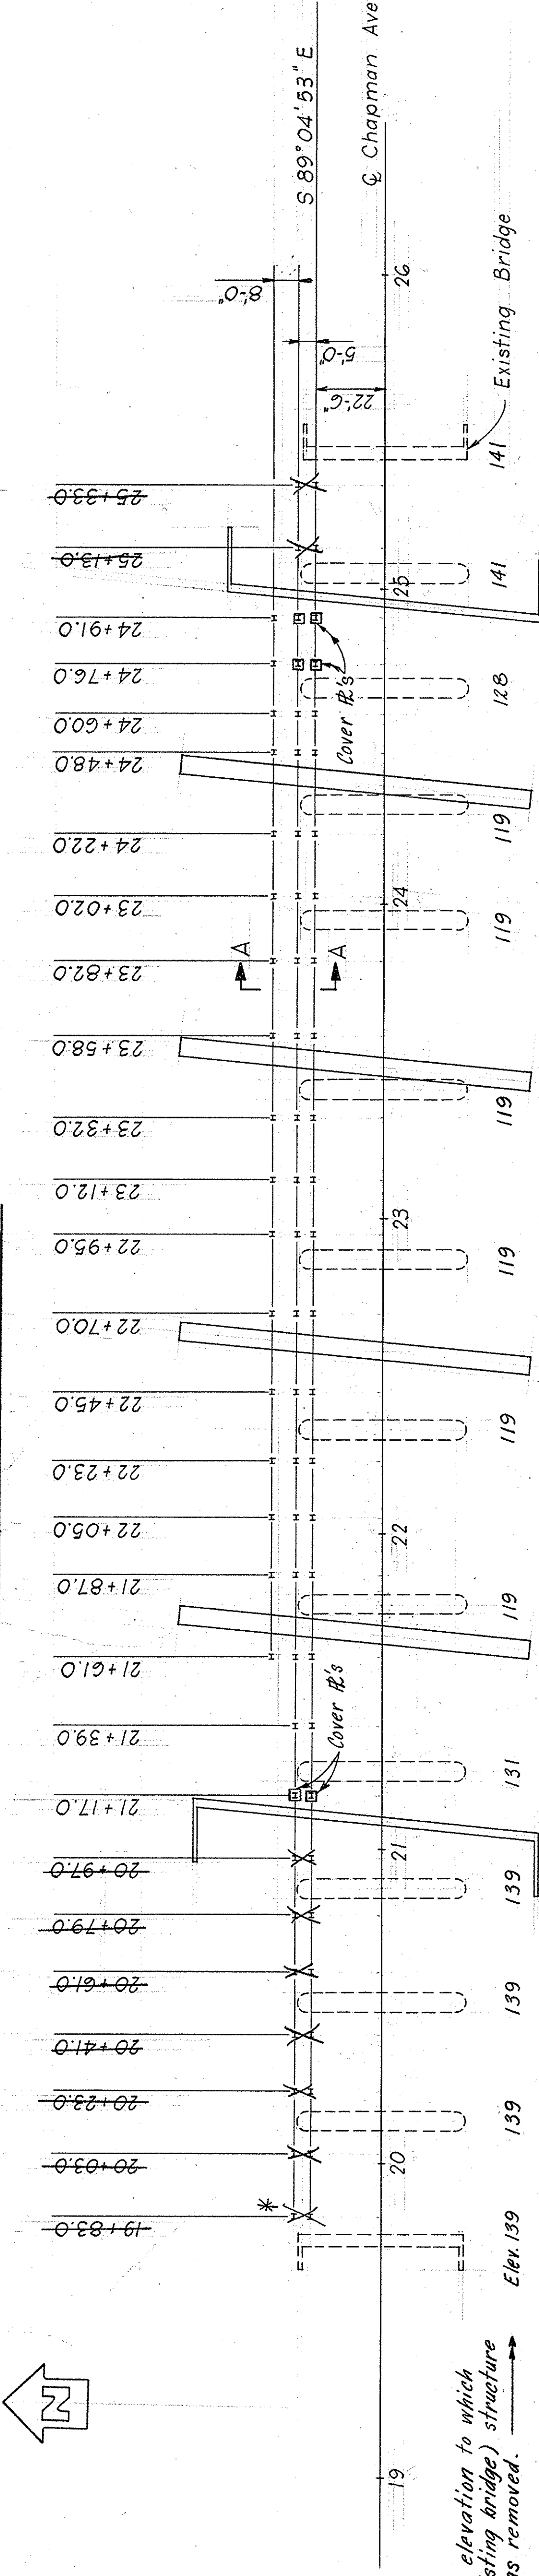

PLAN
Scale: 1" = 30'

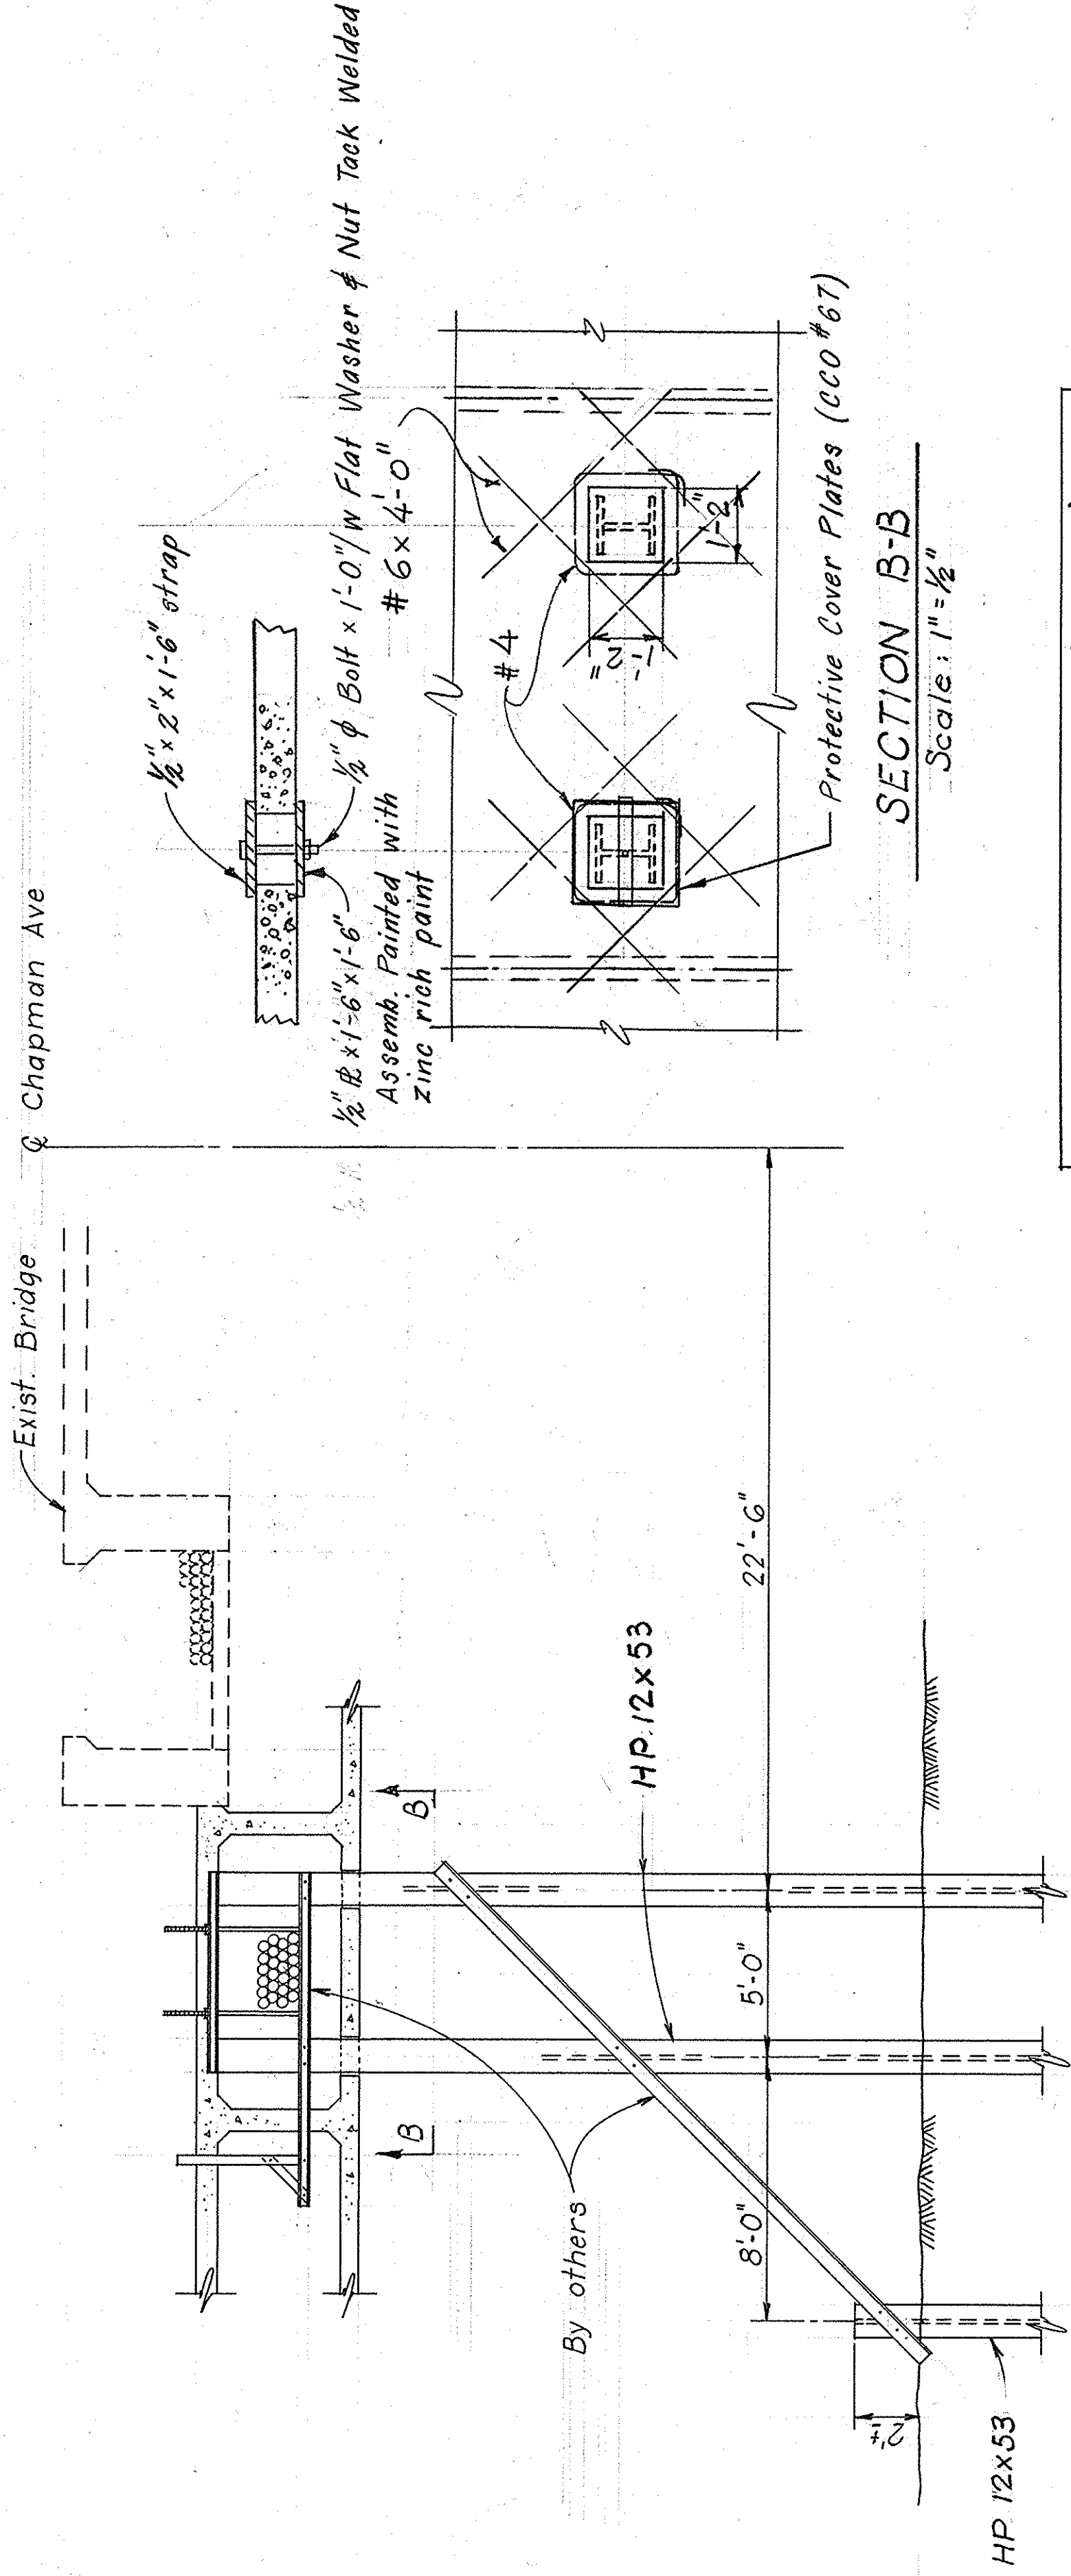

SECTION B-B
Scale: 1" = 1/2"

PILE DATA (HP 12x53)	
LOCATION	SPECIFIED TIP ELEV
Sta. 19+83 to 21+25	115.0
" 21+25 to 21+50	110.0
" 21+50 to 21+65	105.0
" 21+65 to 24+50	95.0
" 24+50 to 25+33	112.0

SECTION A-A
Scale: 1/4" = 1'-0"

AS BUILT
CORRECTIONS BY W. Hansen
CONTRACT NO. 07-032018
DATE 4-15-78

BRIDGE DEPARTMENT
DESIGN SECTION **9**

Project Engineer	By <u>W. Hansen</u>
DESIGN	Checked <u>W. Hansen</u>
DETAILS	By <u>J. Ikami</u>
QUANTITIES	By <u>P. Nelson</u>
	Checked <u>C. Long</u>

STATE OF CALIFORNIA
DEPARTMENT OF TRANSPORTATION

SANTA ANA RIVER BRIDGE
REMOVE & REPLACE

UTILITY SUPPORT PILES

BRIDGE NO.	55C-54	POST MILE	11.1	DRAWING NO.	55C54-	SHEET OF	10 12
------------	--------	-----------	------	-------------	--------	----------	-------

REVISION DATES		PRELIMINARY STAGE ONLY	
1	4-15-78	2	

Discard print bearing earlier revision dates

WO
CU

MICROFILMED
JUL 22 1976