


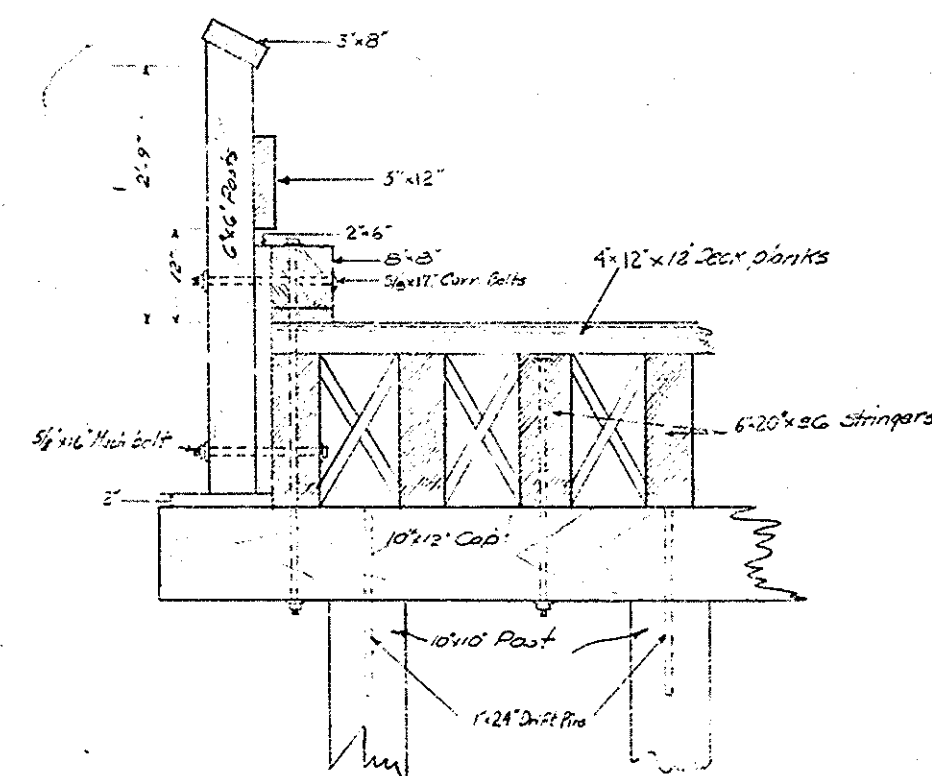

MICROFILMED
JUL 13 1960

Bridge M-68
Cherry St Bridge
.20 mi s/o 2nd St (El Foro)
Sheet 1 of 2
L.C. 22.5' Scale-As Shown
Vellux-Pencil Sketch

CHERRY STREET EL TORO
0.20 Miles South of Second St.
Scales as shown May 1945

245

#14527 - M 177
1945
CHERRY ST.
~~AVE.~~ BRIDGE
OVER MUNGER CREEK
0.15 Mi NE/O FRONT ST.
M-68
55C-171
Thomas: 891-J5

NOTES

Details of construction shall conform to the
Construction notes shown on plans of Stand-
ard Wooden Culverts, Orange County Road Dept.
Deadman rods shall be $\frac{1}{2}$ " galvanized
steel 10' in length.