

CONSTRUCTION NOTES

- 19 CONSTRUCT 200mm P.C./150mm A.B. PAVEMENT WITH TRANSVERSE COARSE HEAVY BROOM FINISH PER P.F.R.D. STD. PLAN 1803.
- 21 INSTALL 4.2m MIN. WIDE DOUBLE SWING GATES OPENING INWARD PER P.F.R.D. STD. PLAN 600-1-0C.
- 34 CONSTRUCT 100mm A.C./150mm A.B. PAVEMENT PER P.F.R.D. STD. PLAN 1805.

PROTECT IN PLACE EXISTING STREAM BANK  
DENOTES: SLOPE PAVING TO BE INSTALLED ON SLOPES STEEPER THAN 1V:2H, BY BRIDGE AND ROADWAY CONTRACTOR FROM SEPARATE PLANS.


TEMPORARY CONSTRUCTION EASEMENT

REMOVE POWER POLE ABANDONED BY OTHERS


CROWN VALLEY PARKWAY

NOTICE TO CONTRACTOR:  
ACCESS TO EMBANKMENT SHALL BE ACCOMPLISHED IN THIS AREA ONLY, BY CONSTRUCTING TEMPORARY EARTHEN FILL RAMPS AGAINST EXISTING STREAM BANKS. RAMPS SHALL BE REMOVED PRIOR TO COMPLETION OF GRADING. DAMAGE TO NATURAL STREAM BANKS SHALL BE AVOIDED.


SEE SHEET 8

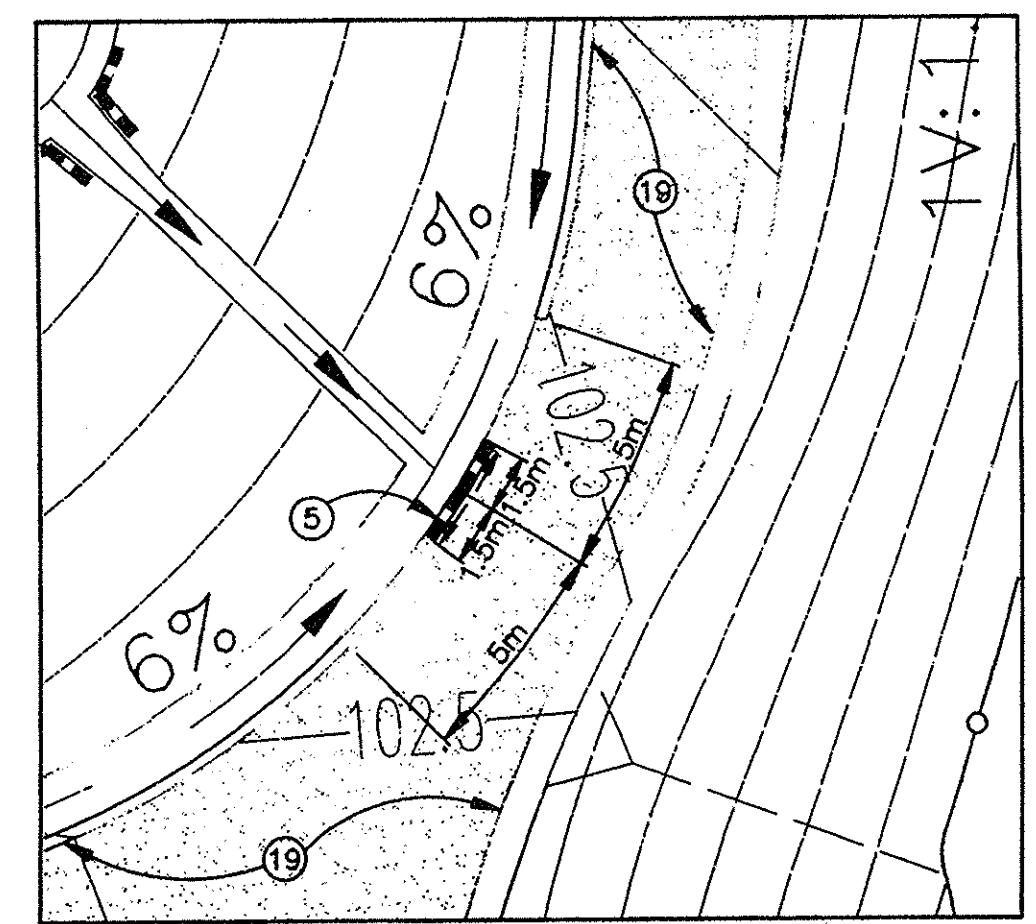


INSERT 'A'  
SCALE 1:200

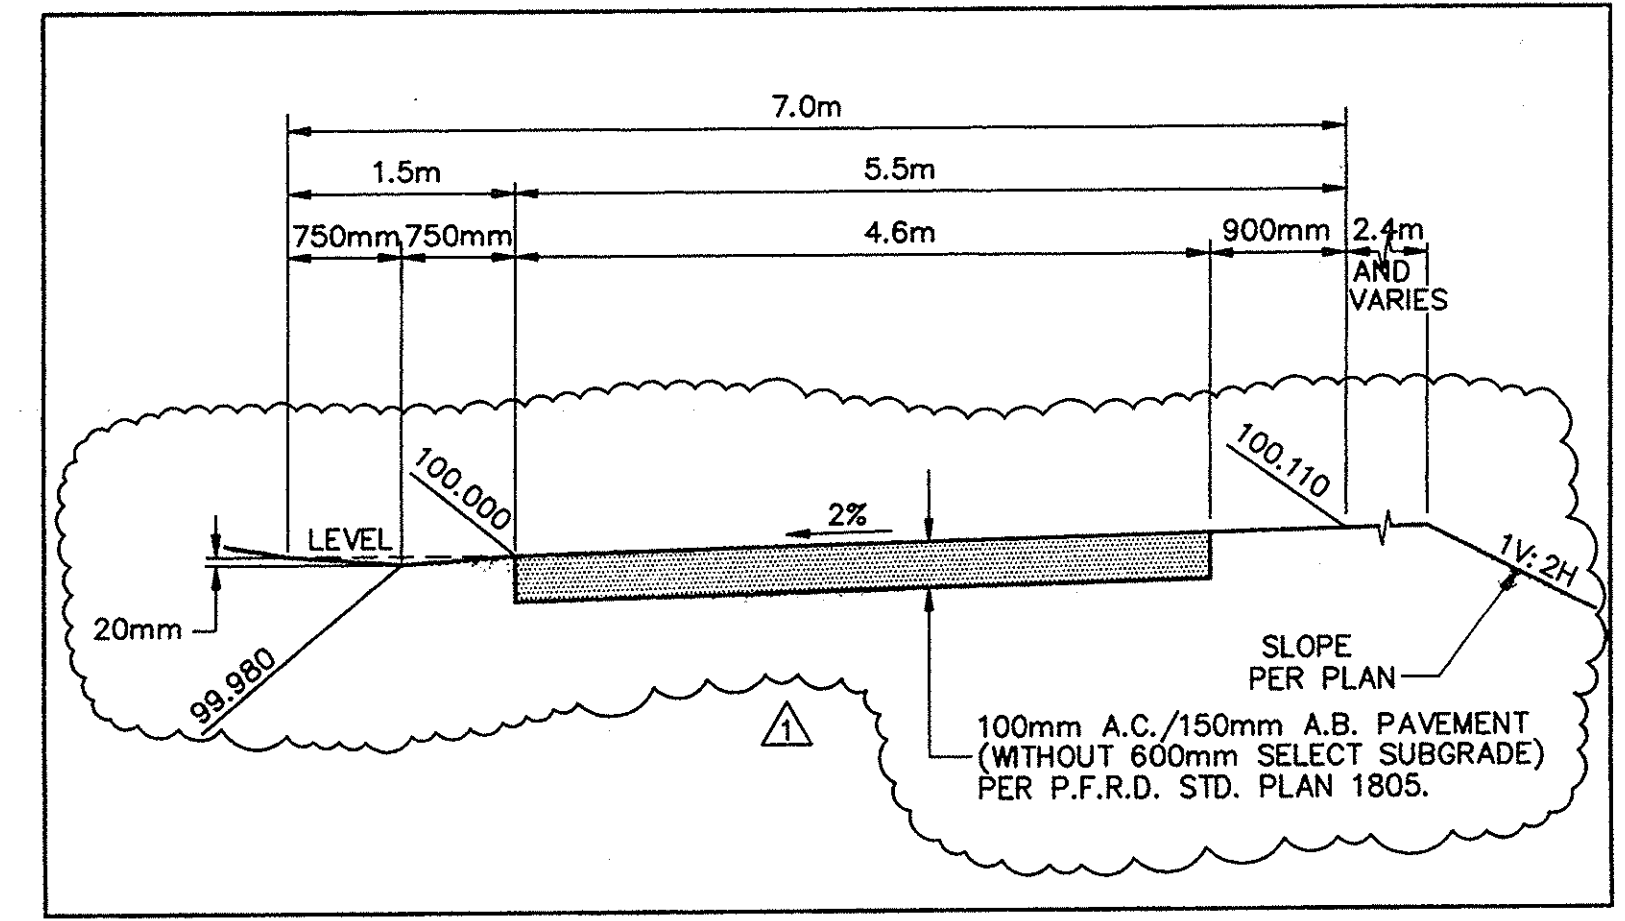

INSERT 'C'  
SCALE 1:50

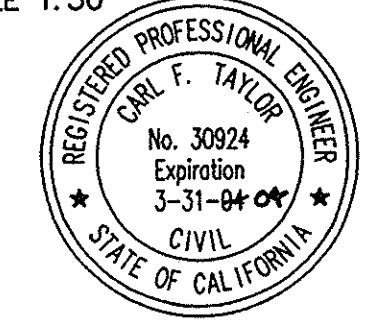

SEE SHEET No. 9  
FOR STORM DRAIN  
IMPROVEMENTS

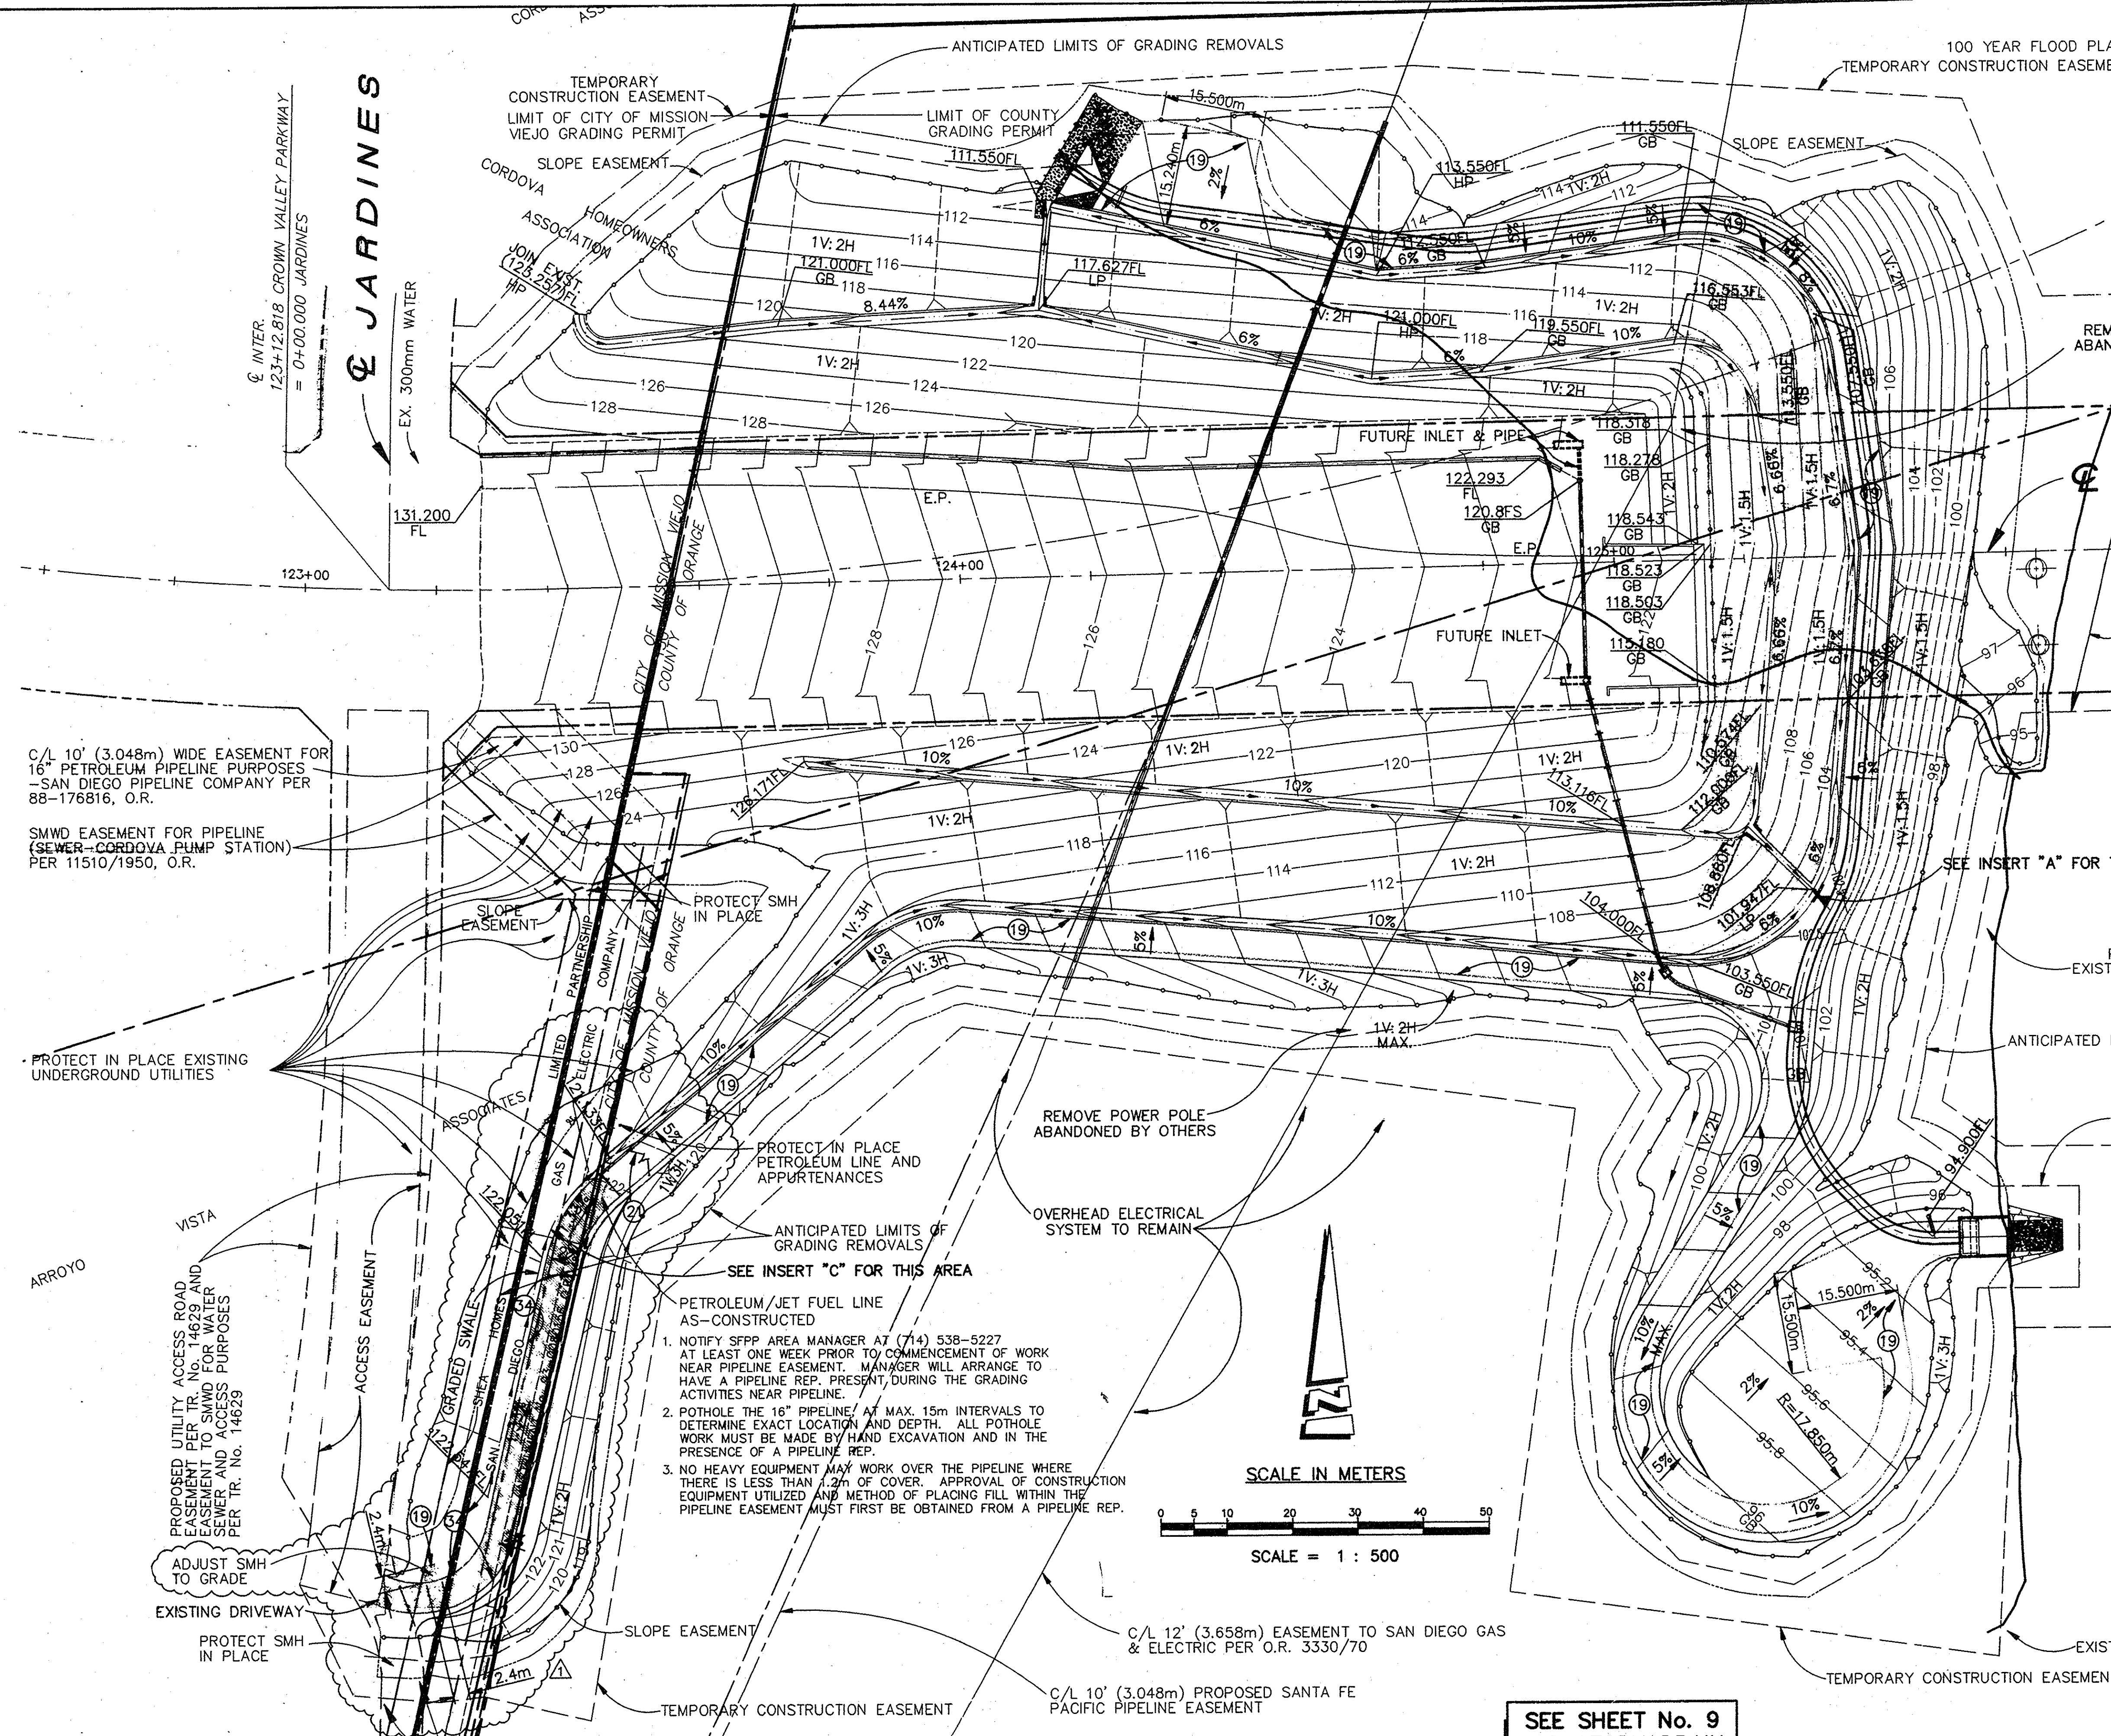

SCALE IN METERS  
SCALE = 1 : 500

SANTA MARGARITA WATER DISTRICT APPROVAL:  
39535  
R.C.E.  
DATE

1. MAINTAIN 24 HOUR ACCESS TO S.M.W.D. CORDOVA LIFT STATION SITE AT ALL TIMES.
2. POTHOLE THE SEWER LINES, AT MAX. 15m INTERVALS TO DETERMINE EXACT LOCATION AND DEPTH. ALL POTHOLE WORK MUST BE MADE BY HAND EXCAVATION AND IN THE PRESENCE OF A S.M.W.D. REP.
3. NO HEAVY EQUIPMENT MAY WORK OVER THE SEWER LINES WHERE THERE IS LESS THAN 1.2m OF COVER. APPROVAL OF CONSTRUCTION EQUIPMENT UTILIZED AND METHOD OF PLACING FILL WITHIN THE SEWER LINE EASEMENT MUST FIRST BE OBTAINED FROM A S.M.W.D. REP.

| NO.      | DATE | REVISIONS                                                 | APPROVED |
|----------|------|-----------------------------------------------------------|----------|
| 11-23-99 |      | REVISE ACCESS ROAD GRADES. ADJ. S.M.W.D. MANHOLE TO GRADE |          |

HUITT-ZOLIARS  
HUITT-ZOLIARS, Inc.  
15101 Red Hill Avenue, Tustin, CA 92780 (714) 259-7900  
30924 R.C.E. 3-31-2004 12/11/00

DESIGNED BY R/V  
DRAWN BY R/V  
CHECKED BY CFT  
FIELD BOOK  
STORM DRAIN PLANS FOR  
CROWN VALLEY PARKWAY BRIDGE EMBANKMENTS  
PAVING PLAN - WEST EMBANKMENT  
JARDINES TO LADERA PC  
SHEET 7 of 13  
SHEETS  
JOB NO. 10-0367-03

DR 18 (16355)