


Tue Dec 04 11:18:43 2001


12/4/2001

M:\2000\DESIGN\misc\del_ab.dgn

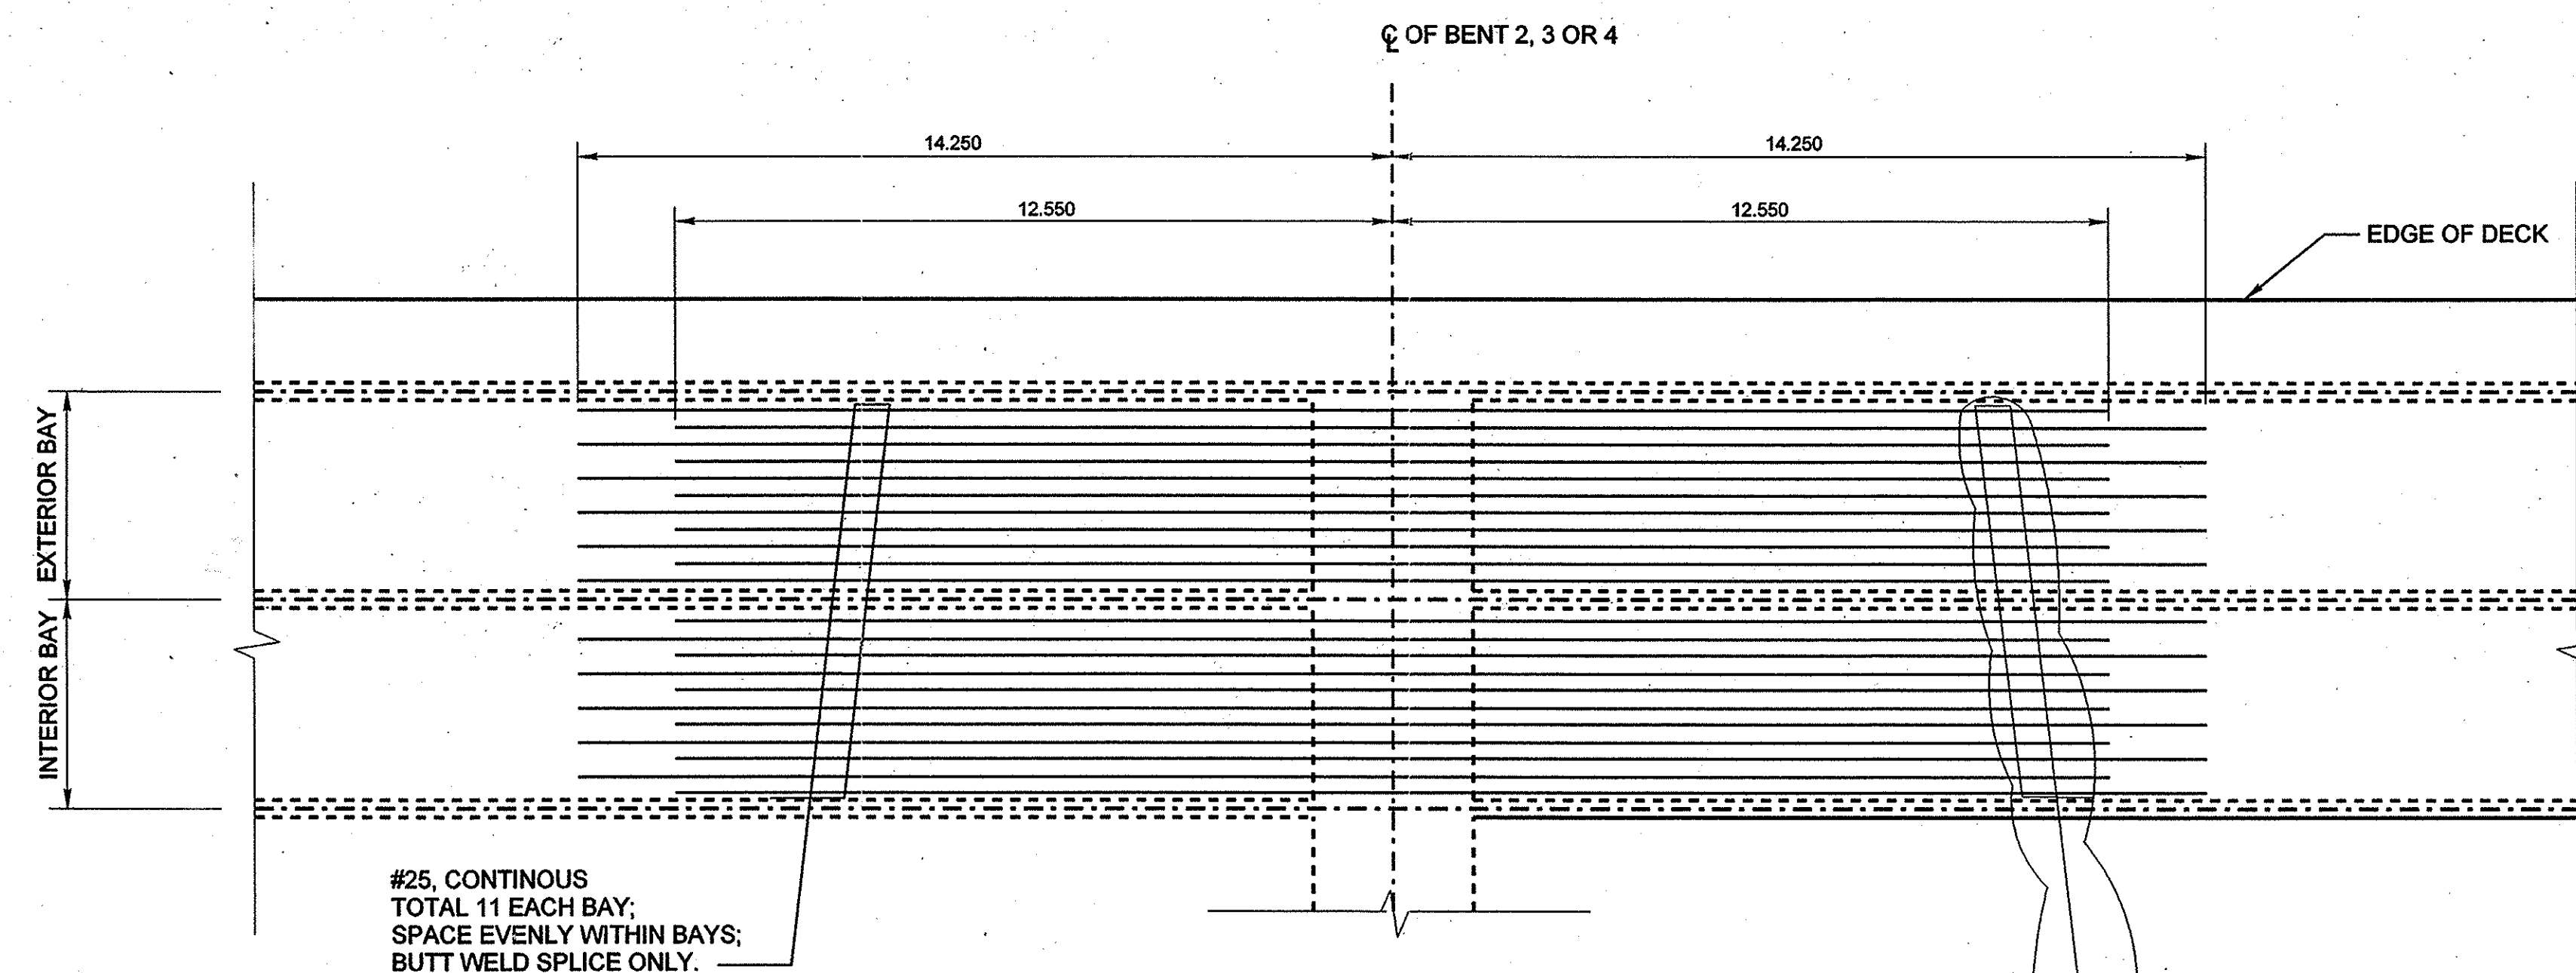

ADDITIONAL TOP MILD REINFORCEMENT


1:100

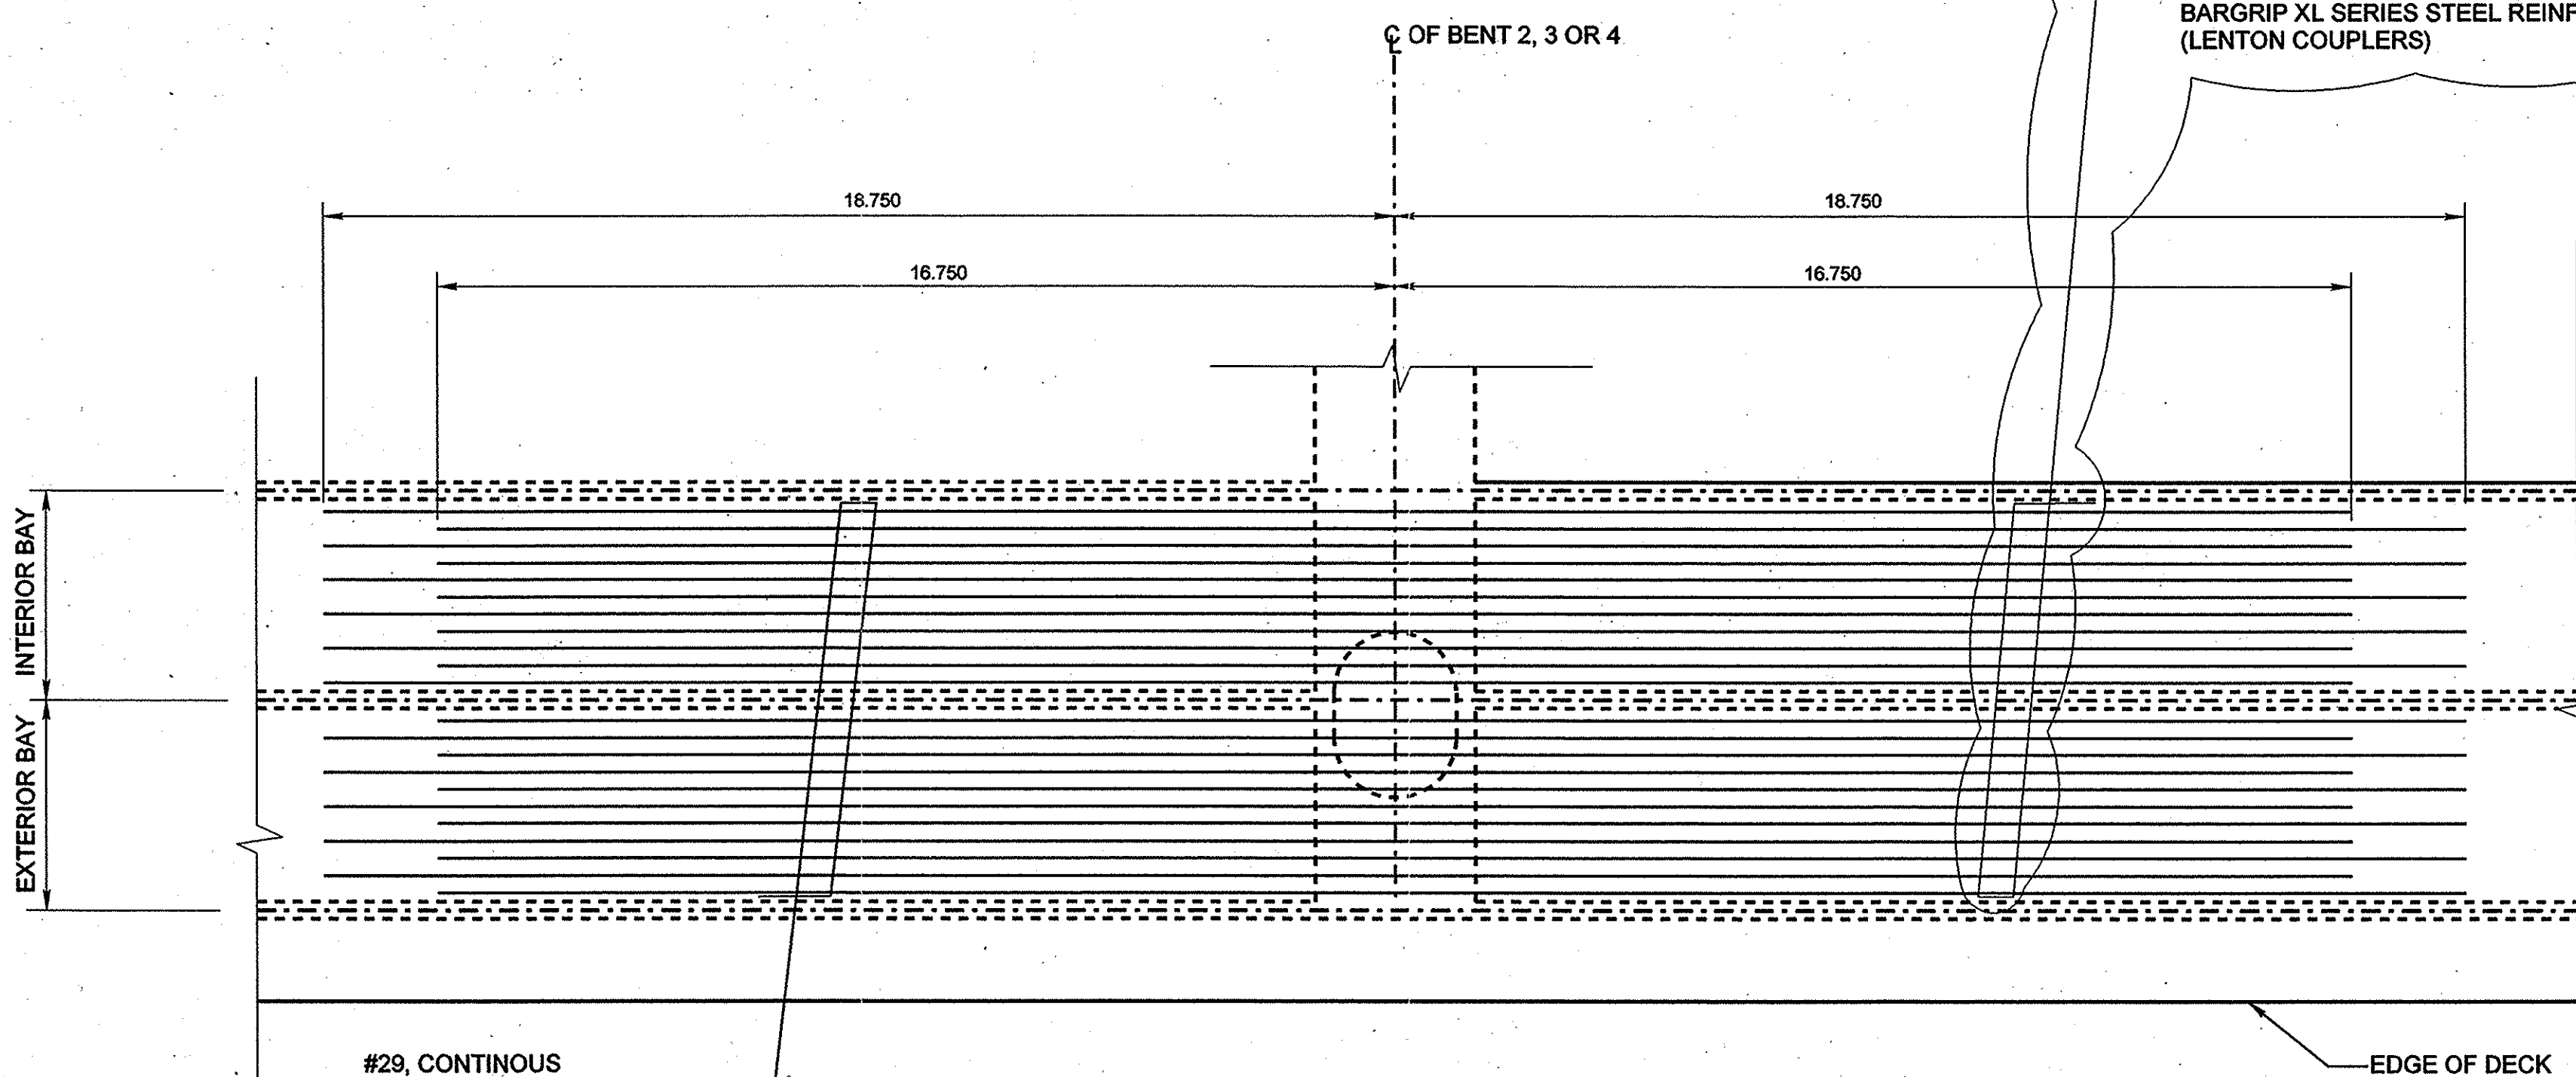

ADDITIONAL BOTTOM MILD REINFORCEMENT

1:100

MECHANICAL SPLICES USED ON ALL OF THESE BARS
BARGRIP XL SERIES STEEL REINFORCING COUPLERS
(LENTON COUPLERS)

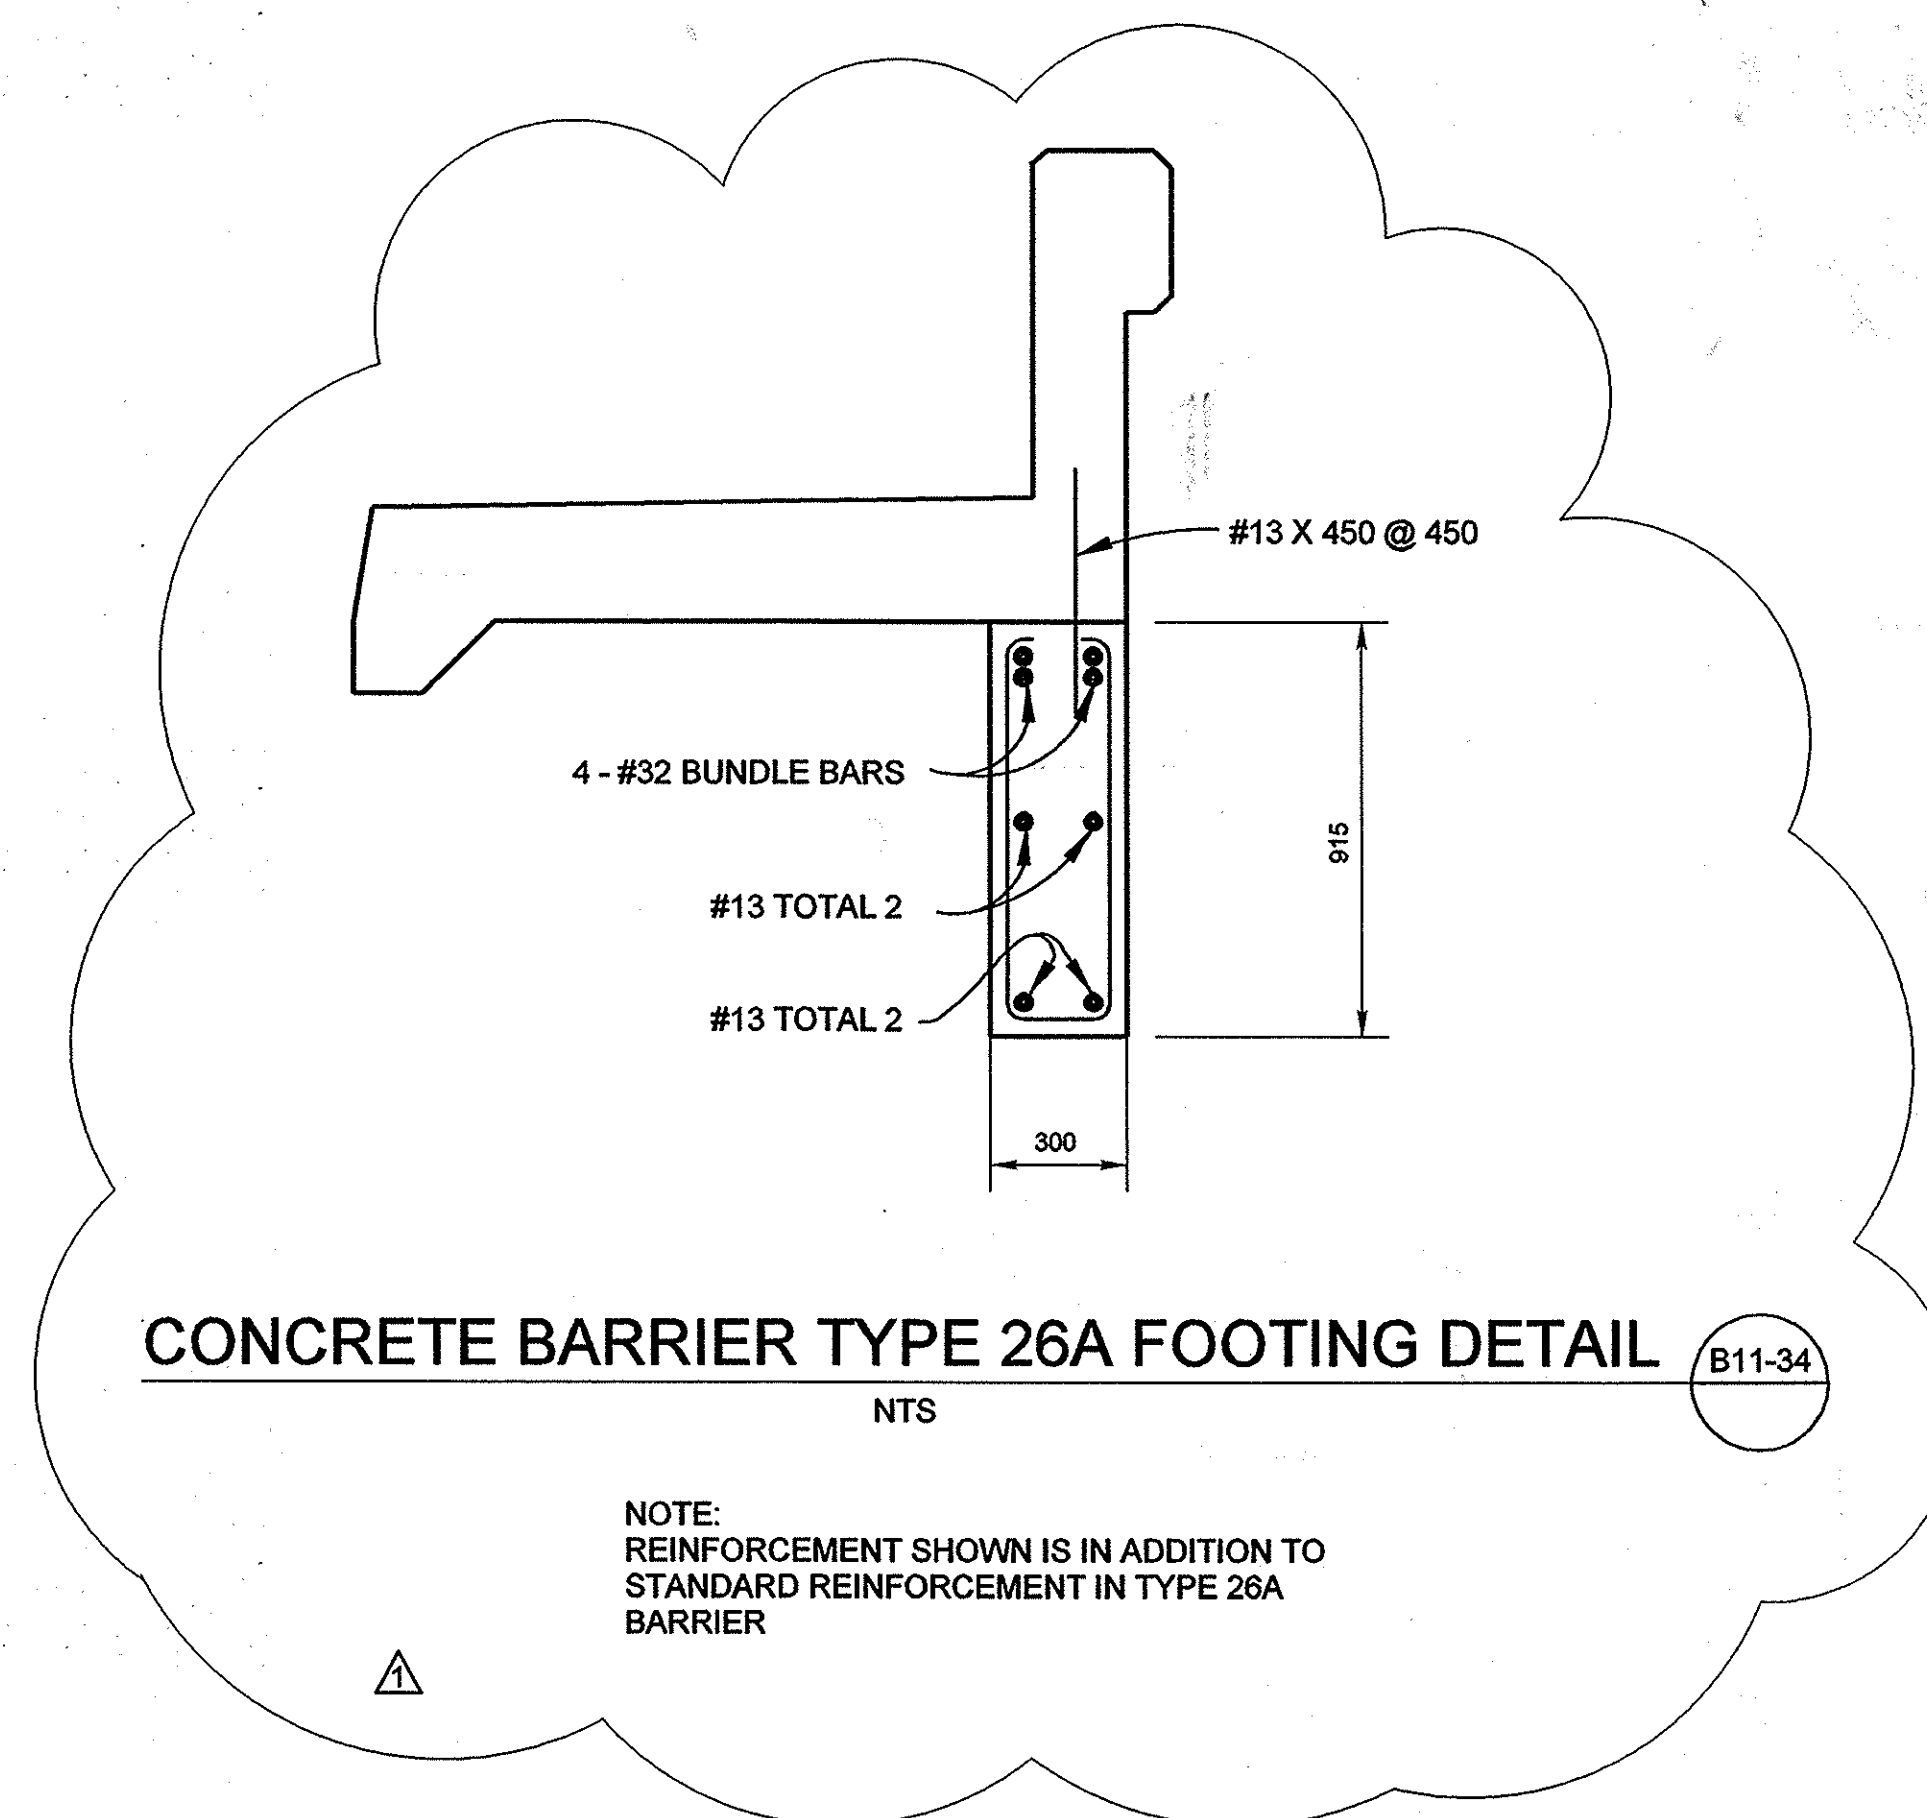

CONCRETE BARRIER TYPE 26A FOOTING DETAIL

NTS

B11-34

NOTE:
REINFORCEMENT SHOWN IS IN ADDITION TO
STANDARD REINFORCEMENT IN TYPE 26A
BARRIER

ALL DIMENSIONS ARE IN METERS UNLESS NOTED OTHERWISE.

ORANGE COUNTY PUBLIC FACILITIES AND RESOURCES DEPARTMENT	
CROWN VALLEY PARKWAY BRIDGE WIDENING OVER ARROYO TRABUCO MISCELLANEOUS DETAILS NO. 1	
DESIGNED: HILTON L. YEE	SHEET 32 OF 47
DRAWN: P. MURPHY, ET AL	CHECKED: XIAN WU
SCALE: AS SHOWN	DATE: JUNE 16, 1999
DRAWING NO.	

MARK	DATE	DESCRIPTION
11-01-01	AS-BUILTS	
12-13-00	ADDED CONC BARRIER DETAIL	

REVISIONS

PREPARED UNDER RESPONSIBLE CHARGE OF:

MELAD HANNA
CE 42215 EXP. 03-31-00

6/18/99

MK CENTENNIAL 17300 REDHILL AVENUE
SUITE 150
IRVINE, CA 92614

FOR REDUCED PLANS ORIGINAL
SCALE IS IN MILLIMETERS

0 20 40 60 80

File Name: \$DGN-FILE-NAMES
Date Plotted: dd-mmm-yyyy hh:mm