


M:\26144\shs\Traffic Handling6.dgn 7/23/2003 15:09:30

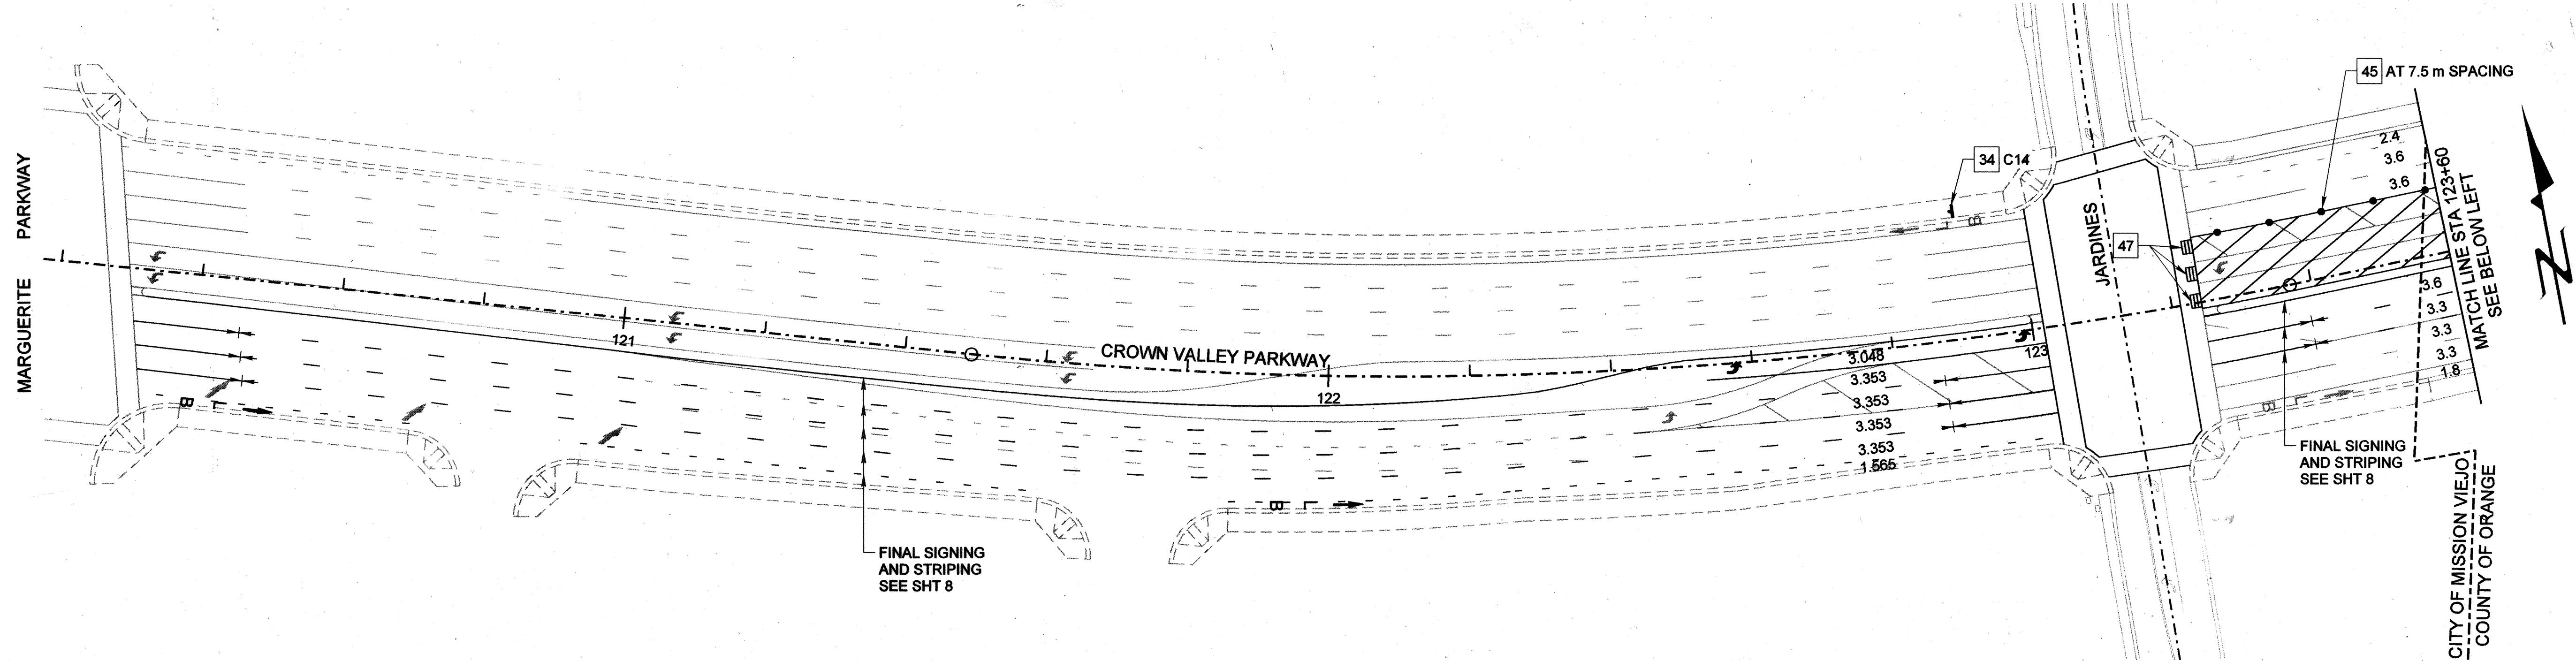

SEE ABOVE RIGHT
MATCH LINE STA 123+60
CITY OF MISSION VIEJO
COUNTY OF ORANGE

CROWN VALLEY PARKWAY

45 AT 7.5 m SPACING

MATCH LINE STA 127+40
SEE SHEET 9


CONSTRUCTION NOTES

- 34 INSTALL SIGN/POST OR AS SHOWN
- 45 INSTALL CHANNELIZERS
- 47 INSTALL BARRICADE (TYPE III)

NOTE: REMOVE CONFLICTING STRIPING BY SANDBLASTING

PLAN

1m : 500m

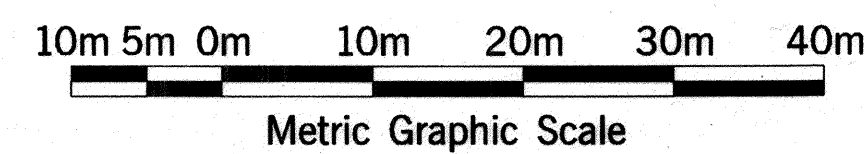

ALL DIMENSIONS ARE IN METERS UNLESS NOTED OTHERWISE.

ORANGE COUNTY PUBLIC FACILITIES AND RESOURCES DEPARTMENT		
CROWN VALLEY PARKWAY STA 120+30 TO STA 127+40 TRAFFIC CONTROL PLAN STAGE 3		
MARK	DATE	DESCRIPTION
REVISIONS		
PREPARED UNDER RESPONSIBLE CHARGE OF:		
DESIGNED	K. NGUYEN	CHECKED
DRAWN	K. NGUYEN	G. R. PEÑA
SCALE	DATE	DRAWING NO.
AS SHOWN	MAY 01, 2003	
SHEET		15
OF 55		

File Name: M:\26144\shs\Traffic Handling6.dgn
Date Plotted: 7/23/2003 15:09:30

Last modified 30-Apr-1998