


CONSTRUCTION NOTES

- 21 PAINT 100 mm WHITE LANE LINE / DET. 9
- 25 PAINT 200 mm WHITE LANE DROP / DET. 37B
- 26 PAINT 200 mm WHITE CHANNELIZING LINE / DET. 38
- 31 INSTALL TYPE IV ARROW MARKING
- 32 PAINT 15 m SOLID 100 mm WHITE /
INSTALL TYPE G RPMs AT END POINTS
- 34 INSTALL SIGN/POST OR AS SHOWN
- 43 PAINT 300 mm WHITE AT 45° AND 7.5 m SPACING
- 45 INSTALL CHANNELIZERS
- 47 INSTALL BARRICADE (TYPE III)

NOTE: REMOVE CONFLICTING STRIPING BY SANDBLASTING

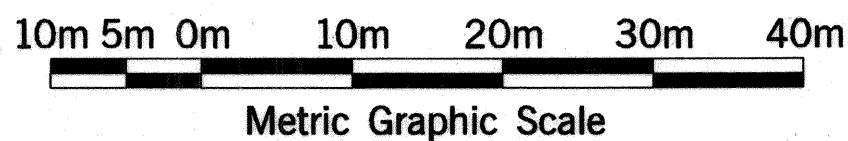

ALL DIMENSIONS ARE IN METERS UNLESS NOTED OTHERWISE.

MARK		DATE	DESCRIPTION
REVISIONS			
PREPARED UNDER RESPONSIBLE CHARGE OF:			
DESIGNED: K. NGUYEN			
DRAWN: K. NGUYEN			
CHECKED: G. R. PEÑA			
DATE: 8/4/13			
SCALE: AS SHOWN			
MAY 01, 2003			
DRAWING NO.			
SHEET 18 OF 55			