



ELEVATION
1:1000

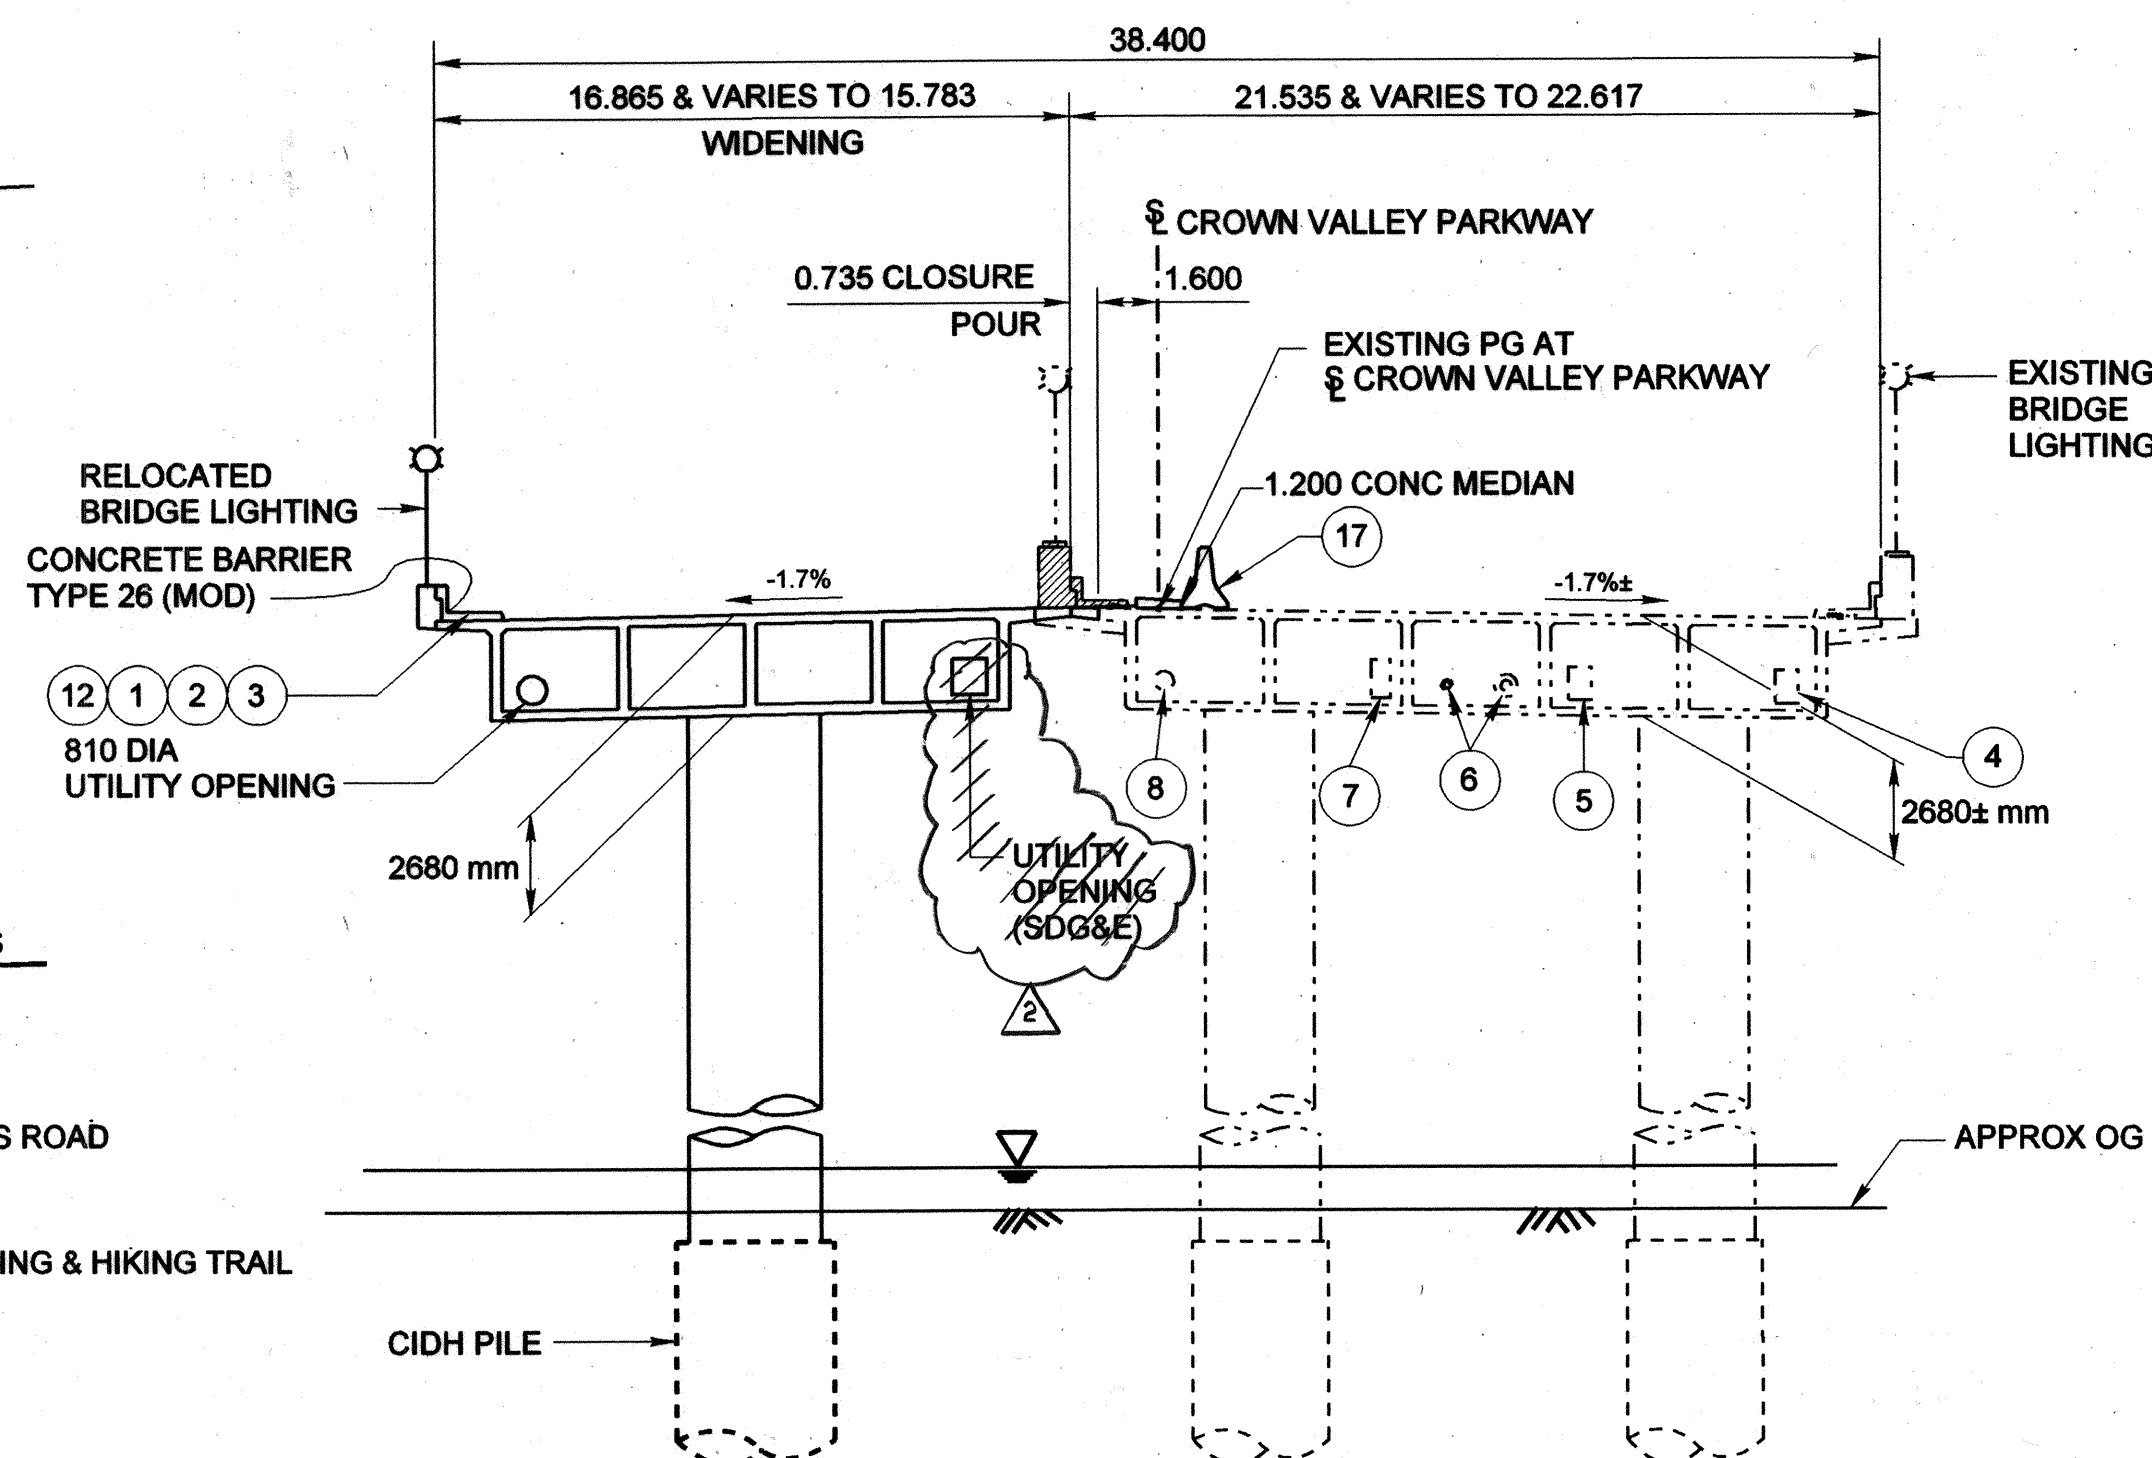

TYPICAL SECTION
1:200

NOTE:
FOR CLARITY, ONLY LIGHT PEDESTALS SHOWN.

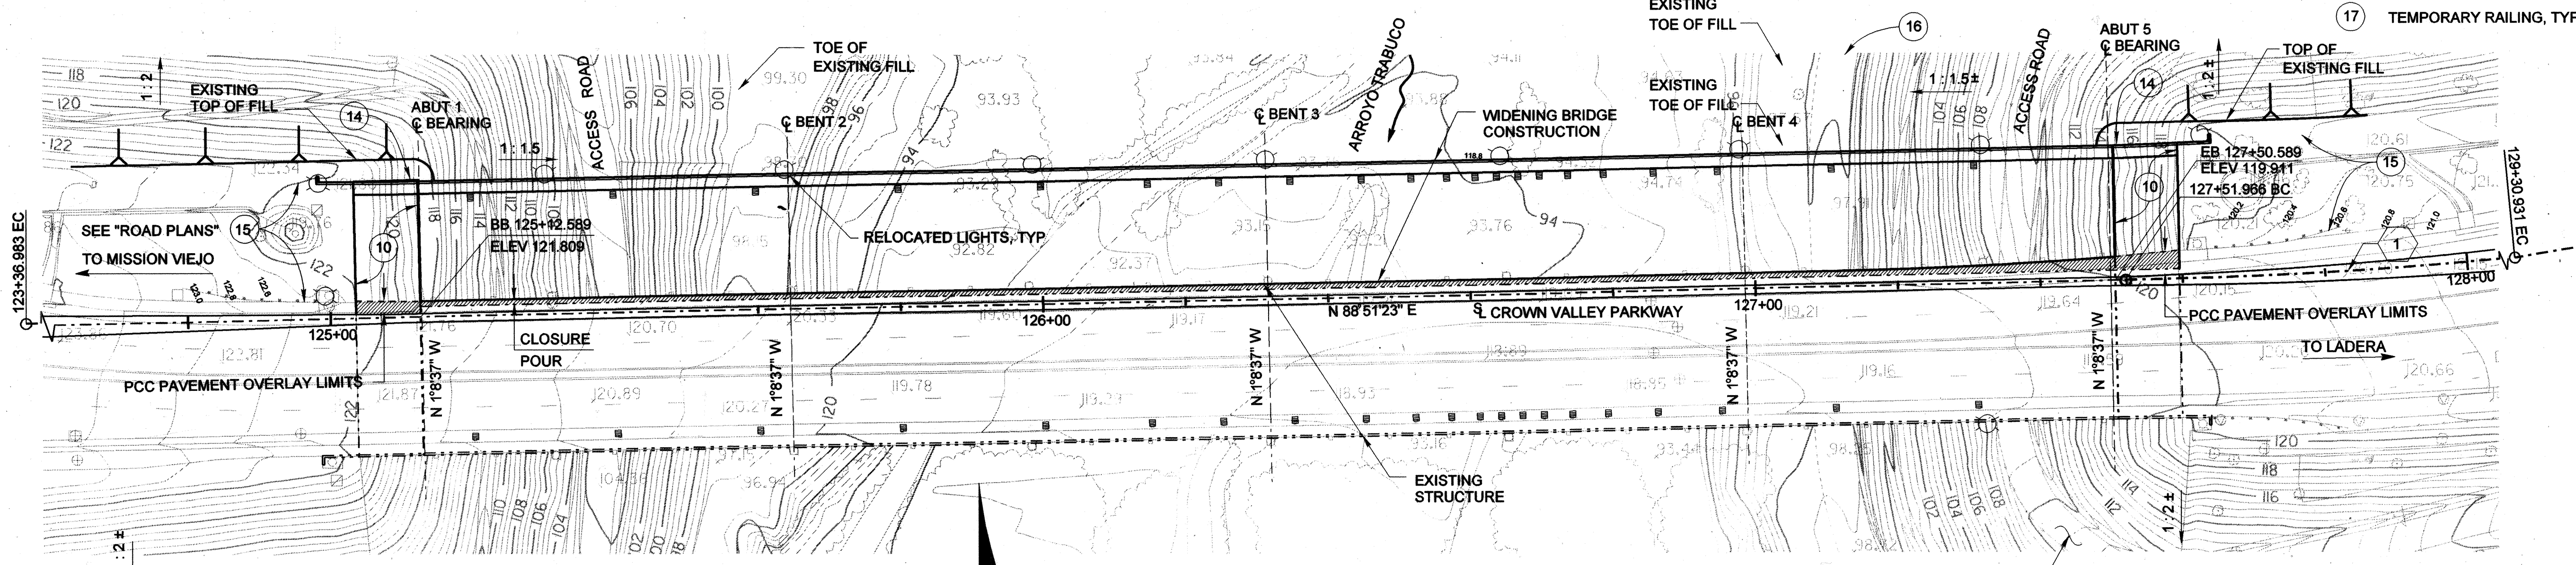

PLAN
1:500

CURVE DATA
1 Δ = 14°18'56"
R = 716.281
L = 178.965
T = 89.951

- NOTES:**
1. FOR GENERAL NOTES, CALTRANS STANDARD PLANS LIST, AND INDEX TO PLANS, SEE "INDEX TO PLANS" SHEET.
 2. FOR PILE DATA, SEE "FOUNDATION PLANS NO. 1" SHEET.
 3. FOR DECK DRAIN LOCATIONS, SEE "DECK DRAIN DETAILS" SHEET.
 4. FOR PLANS, SLOPE INDICATED IS VERTICAL:HORIZONTAL.
 5. FOR HYDROLOGIC DATA, SEE "FOUNDATION PLAN NO. 1" SHEET.
 6. THE CONTRACTOR SHALL VERIFY ALL CONTROLLING FIELD DIMENSIONS, BEFORE ORDERING OR FABRICATING ANY MATERIALS.

CALTRANS STANDARD PLAN SHEET NO.
DETAIL NO.

FOR REDUCED PLANS ORIGINAL SCALE IS IN MILLIMETERS

- LEGEND**
- INDICATES NEW STRUCTURE
 - INDICATES EXISTING STRUCTURE
 - INDICATES BRIDGE REMOVAL
 - INDICATES RELOCATE LIGHT POLE
 - INDICATES DECK DRAINAGE INLET, SEE NOTE 3
 - INDICATES HIGH WATER LINE, Q500
 - 1 2-100 mm Dia CONDUITS NORTH BARRIER (FUTURE UTILITIES)
 - 2 LIGHTING CONDUIT
 - 3 50 mm Dia TRAFFIC SIGNAL INTERCONNECT CONDUIT
 - 4 EXISTING UTILITY OPENING (SDG&E) DISTRIBUTION CONDUITS
 - 5 EXISTING UTILITY OPENING (SDG&E) TRANSMISSION CONDUITS
 - 6 EXISTING UTILITY OPENING (SCGCO)
 - 7 EXISTING UTILITY OPENING (PAC BELL)
 - 8 EXISTING UTILITY OPENING (SMWD)
 - 9 SLOPE PAVING
 - 10 APPROACH SLAB, TYPE N (9S)
 - 11 BRIDGE LIGHTING, SEE ALSO "ROAD PLANS" (ES-7D)
 - 12 PULL BOX IN BARRIER WALKWAY (TOT 5)
 - 13 PAINT BENT NO.
 - 14 PAINT "CROWN VALLEY PKWY BRIDGE" "BRIDGE NO. 55C-0637", AND YEAR COMPLETED
 - 15 RELOCATE MGBR, SEE "ROAD PLANS"
 - 16 MAINTENANCE ACCESS ROAD / REGIONAL RIDING & HIKING TRAIL
 - 17 TEMPORARY RAILING, TYPE K

ALL DIMENSIONS ARE IN METERS UNLESS NOTED OTHERWISE.

ORANGE COUNTY PUBLIC FACILITIES AND RESOURCES DEPARTMENT	
CROWN VALLEY PARKWAY BRIDGE (WIDENING) OVER ARROYO TRABUCO GENERAL PLAN	
DESIGNED: H. YEE	SHEET
DRAWN: R. DANLEY	22
CHECKED: J. SARAH	OF 55
SCALE: MAY 01, 2003	DRAWING NO.
DATE	

Washington
Washington Infrastructure Services, Inc.
17300 Redhill Avenue, Suite 150
Irvine, CA 92614

File Name: M126144StructApp_w.dgn
Date Plotted: 7/23/2003 10:49:34