




NORTHWEST RETAINING WALL @ ABUTMENT 1 ELEVATION
1:50

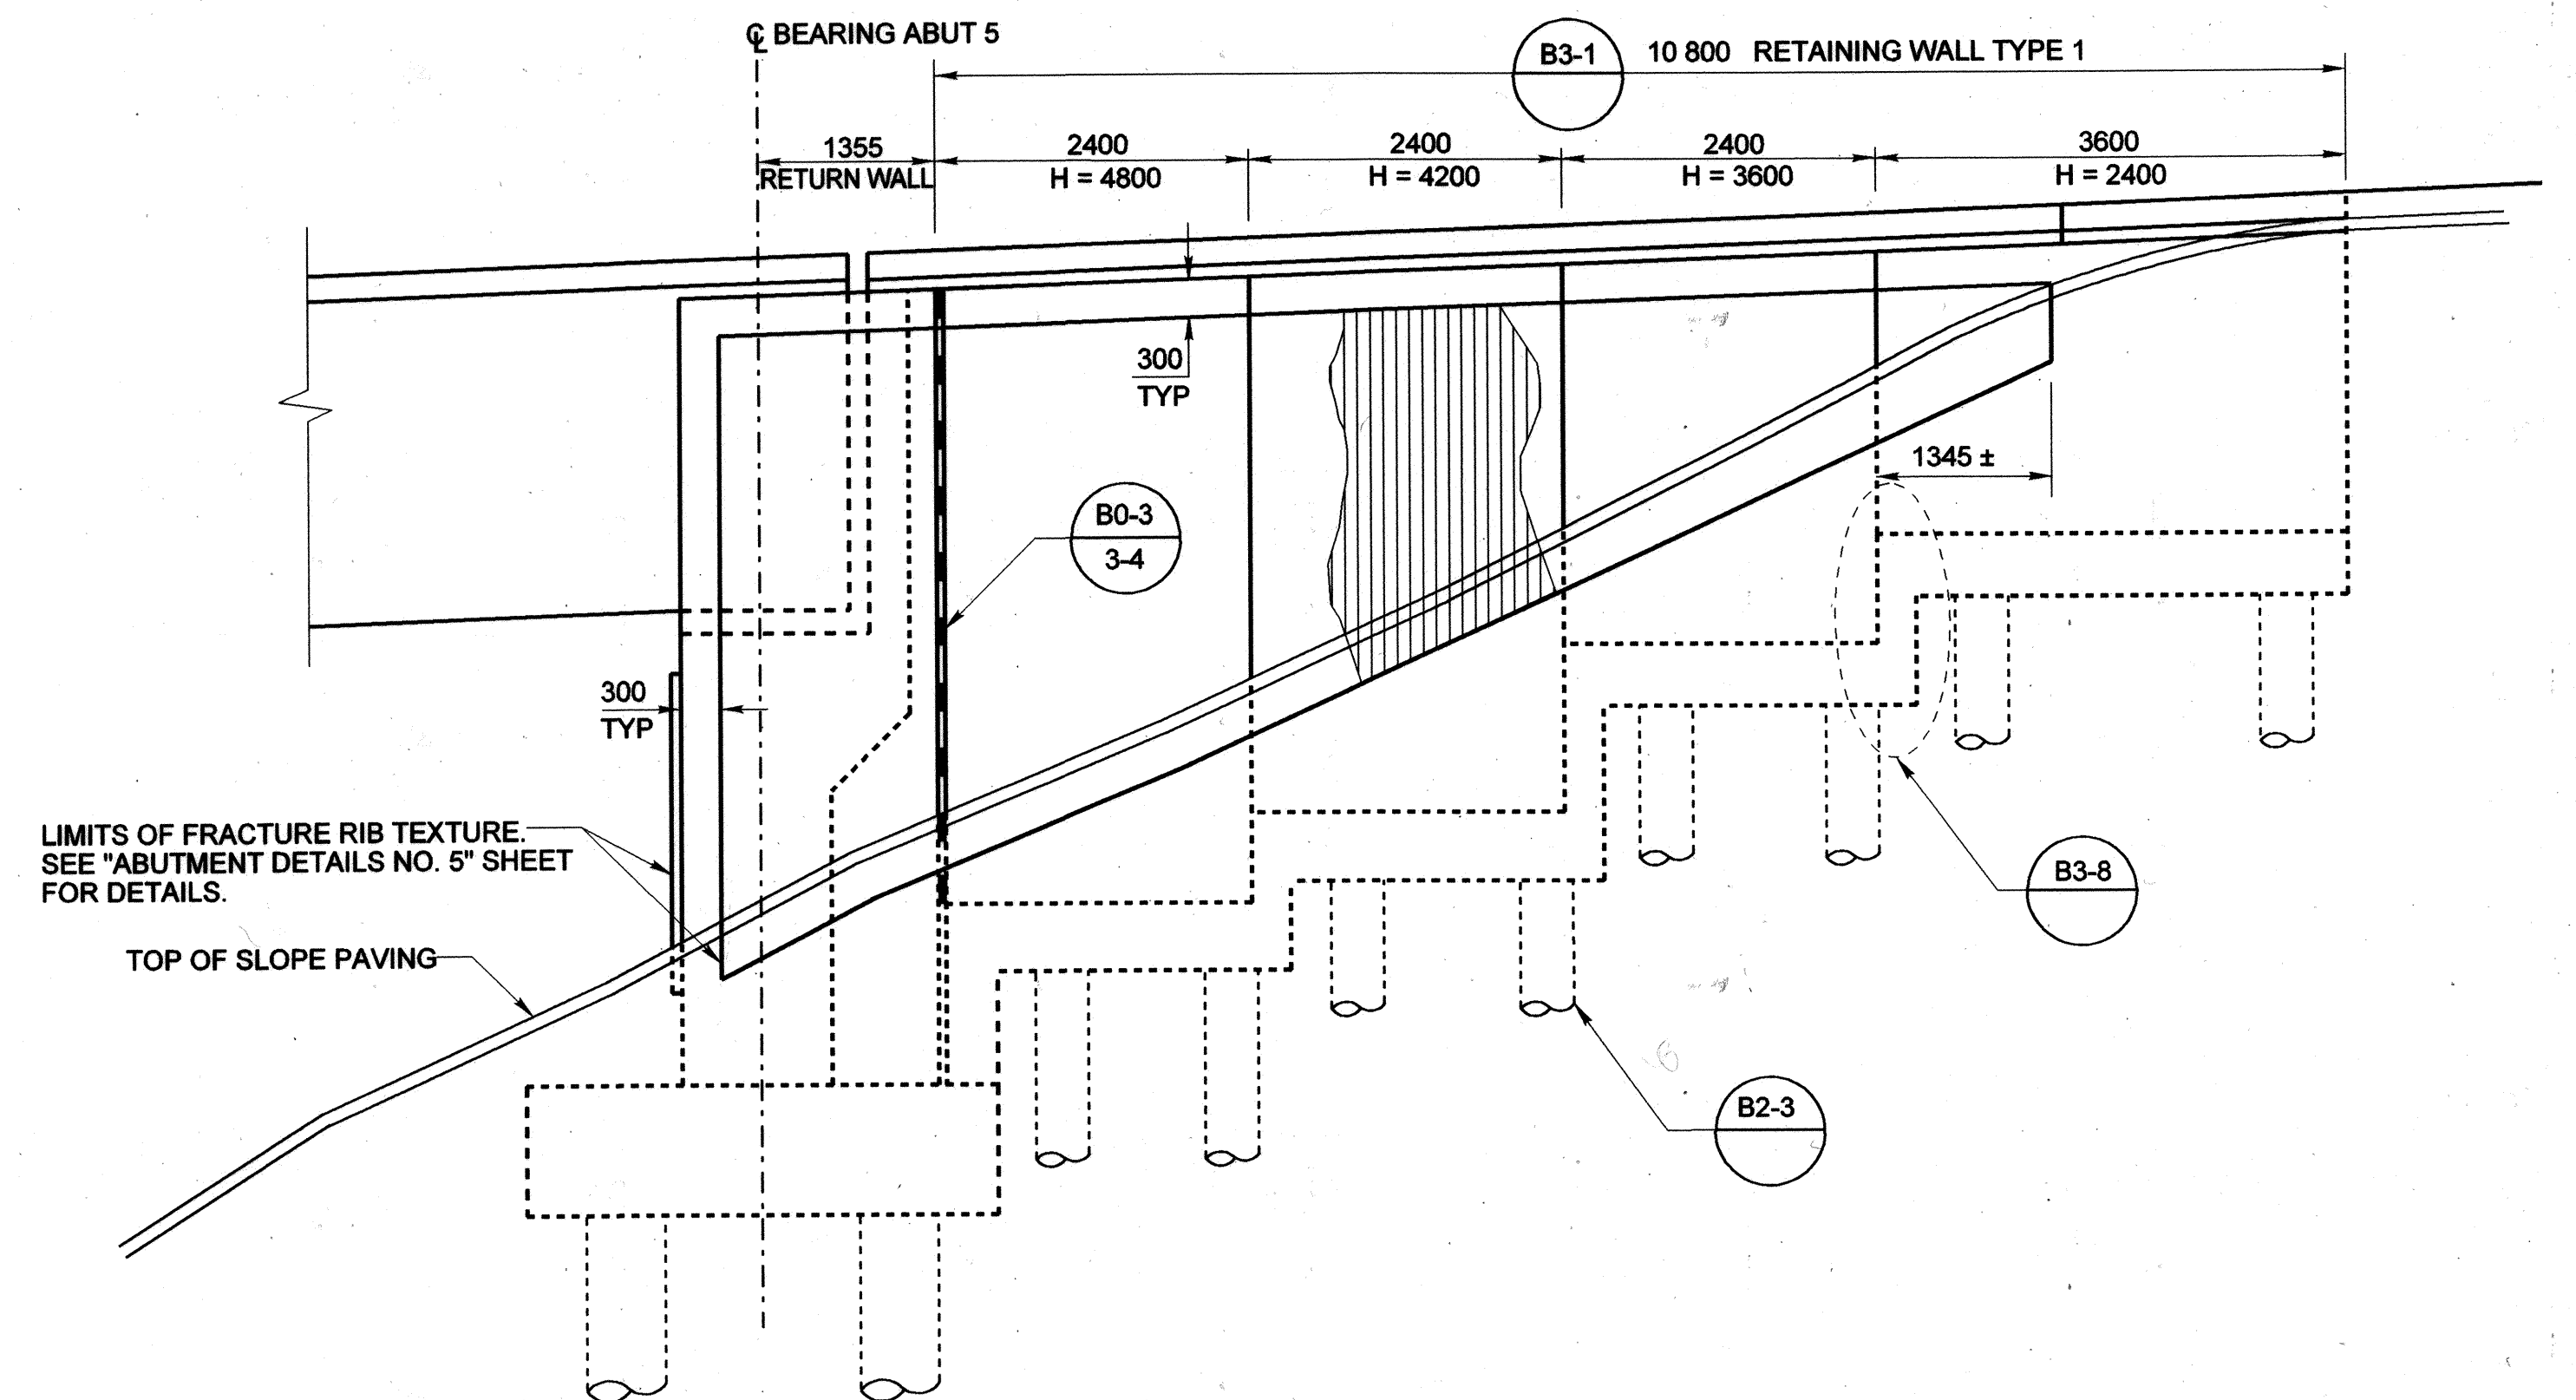

NORTHEAST RETAINING WALL @ ABUTMENT 5 ELEVATION
1:50

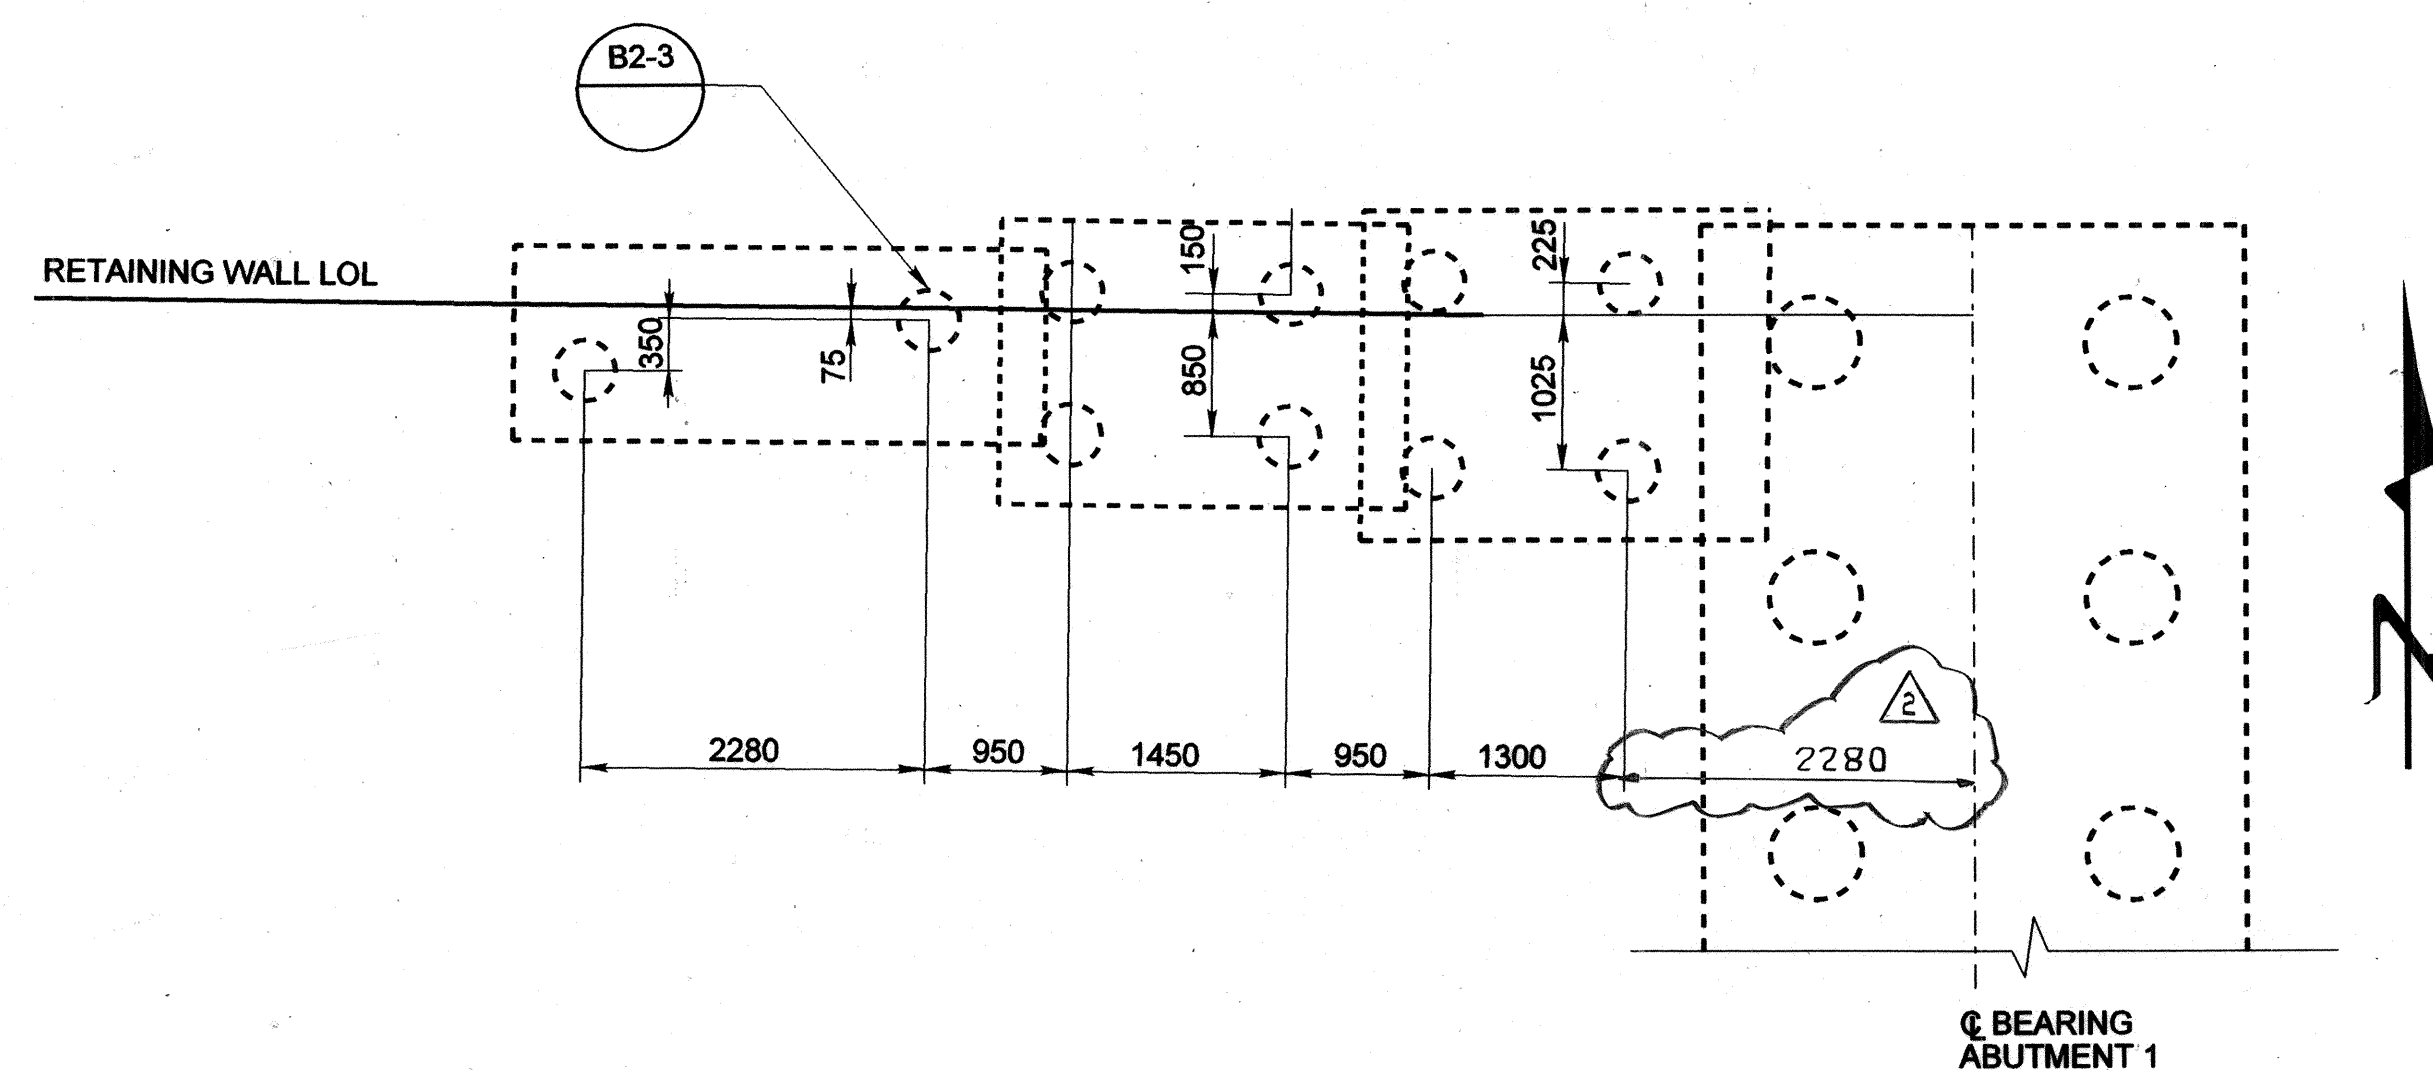

PILE LAYOUT AT ABUTMENT 1
1:50

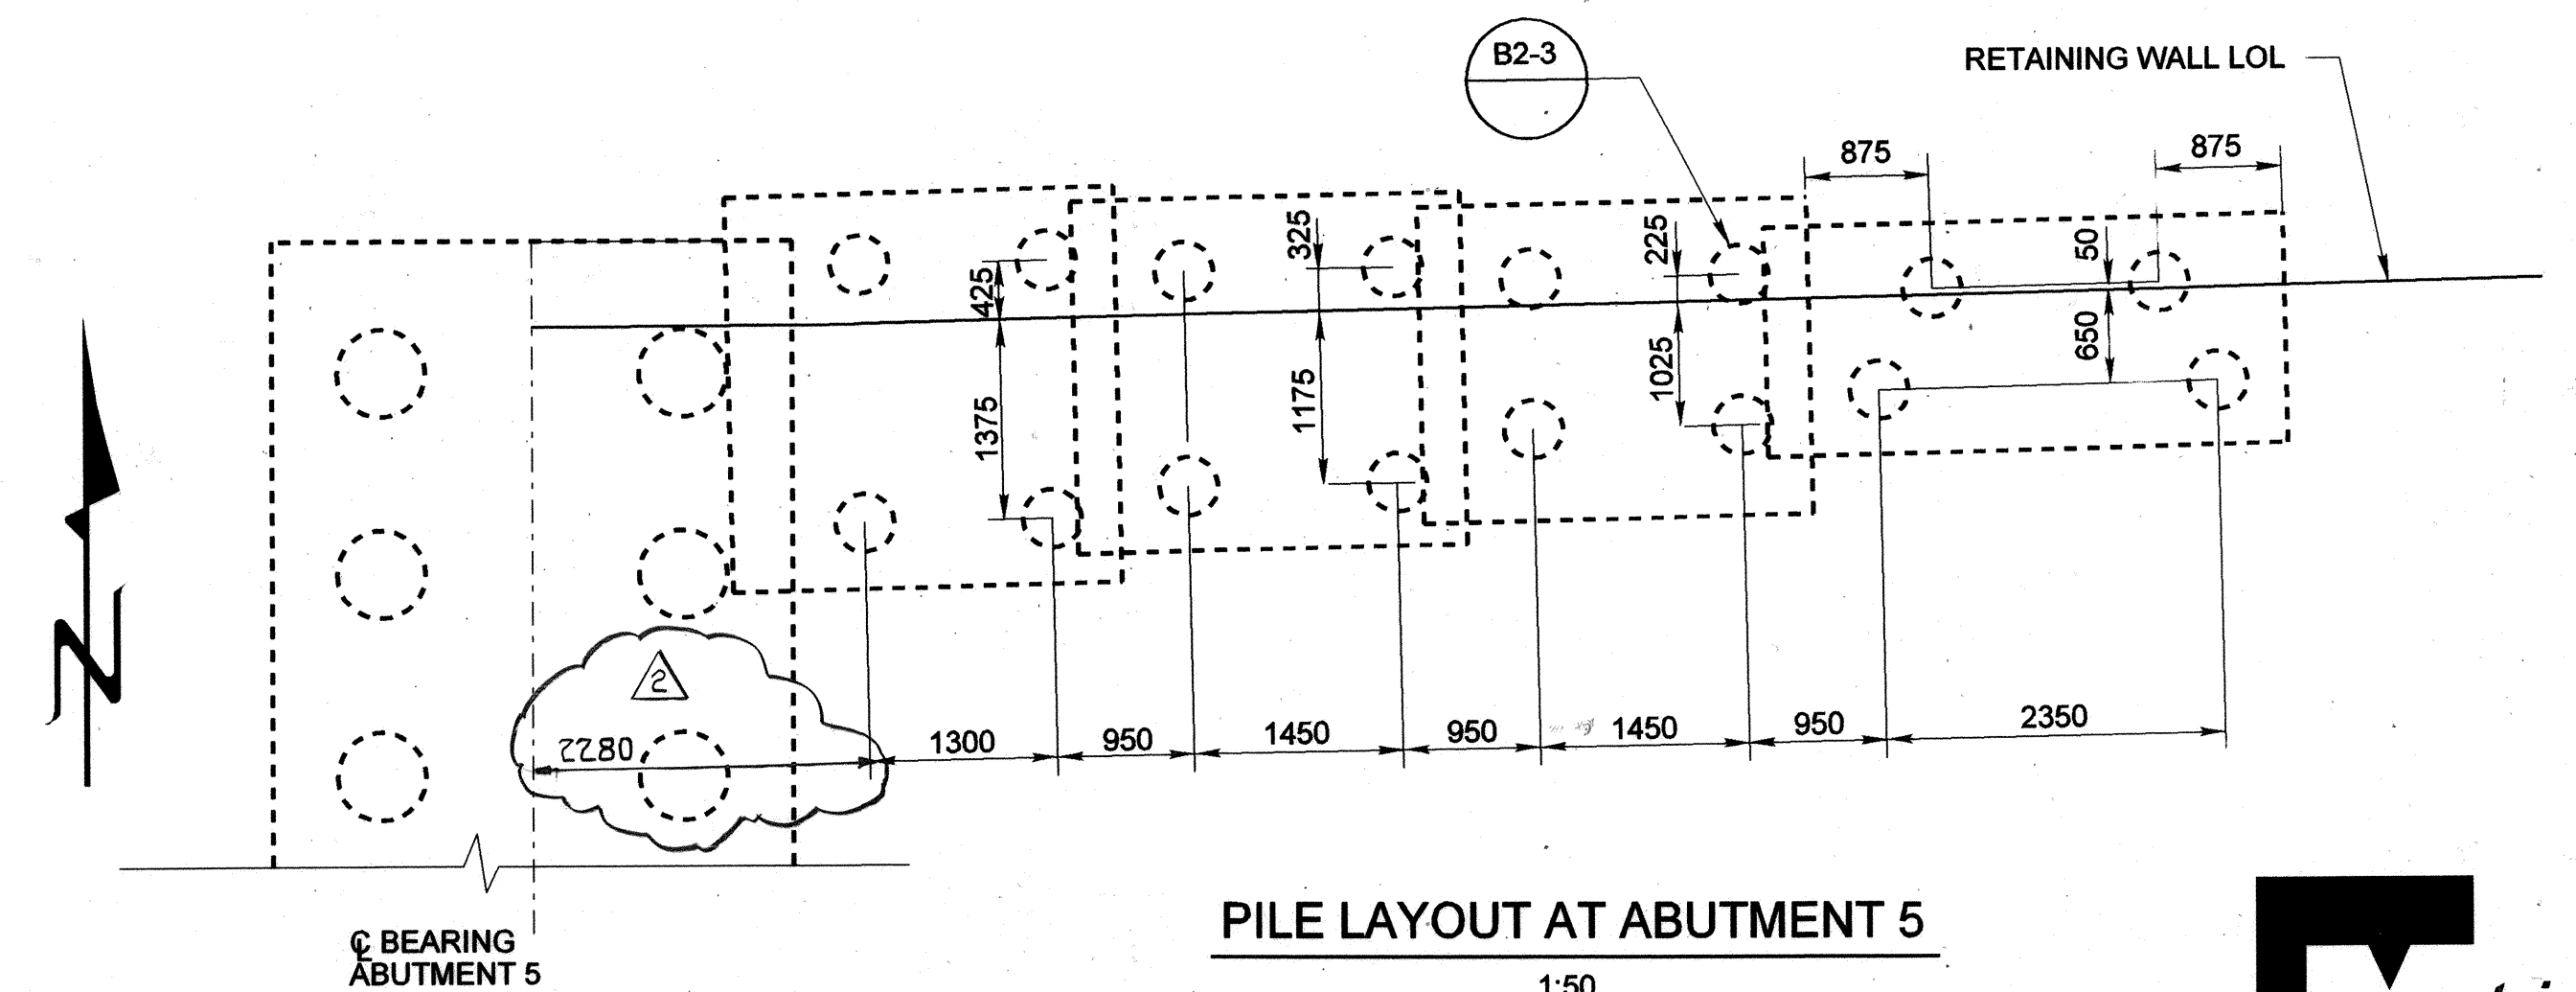

PILE LAYOUT AT ABUTMENT 5
1:50

ALL DIMENSIONS ARE IN MILLIMETERS UNLESS NOTED OTHERWISE.


ORANGE COUNTY PUBLIC FACILITIES AND RESOURCES DEPARTMENT	
CROWN VALLEY PARKWAY BRIDGE (WIDENING) OVER ARROYO TRABUCO ABUTMENT DETAILS NO. 4	
DESIGNED: S. MICHALSKI	SHEET 30 OF 55
DRAWN: R. DANLEY	CHECKED: J. SARAH
SCALE: AS SHOWN	DATE: MAY 01, 2003
DRAWING NO.	

2	2-7-06	AS BUILT
MARK	DATE	DESCRIPTION
REVISIONS		
PREPARED UNDER RESPONSIBLE CHARGE OF:		

H. YEE
54757
12/31/03
REGISTERED PROFESSIONAL ENGINEER
CALIFORNIA

Washington
Washington Infrastructure Services, Inc.
17300 Redhill Avenue, Suite 150
Irvine, CA 92614

FOR REDUCED PLANS ORIGINAL
SCALE IS IN MILLIMETERS

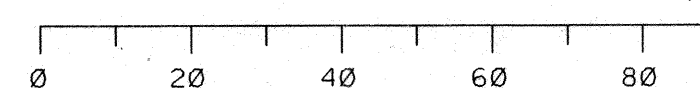

File Name: M126144-structabutdet4.w.dgn
Date Plotted: 7/23/2003 15:56:12