


ADDITIONAL TOP SLAB MILD REINFORCEMENT


1:100

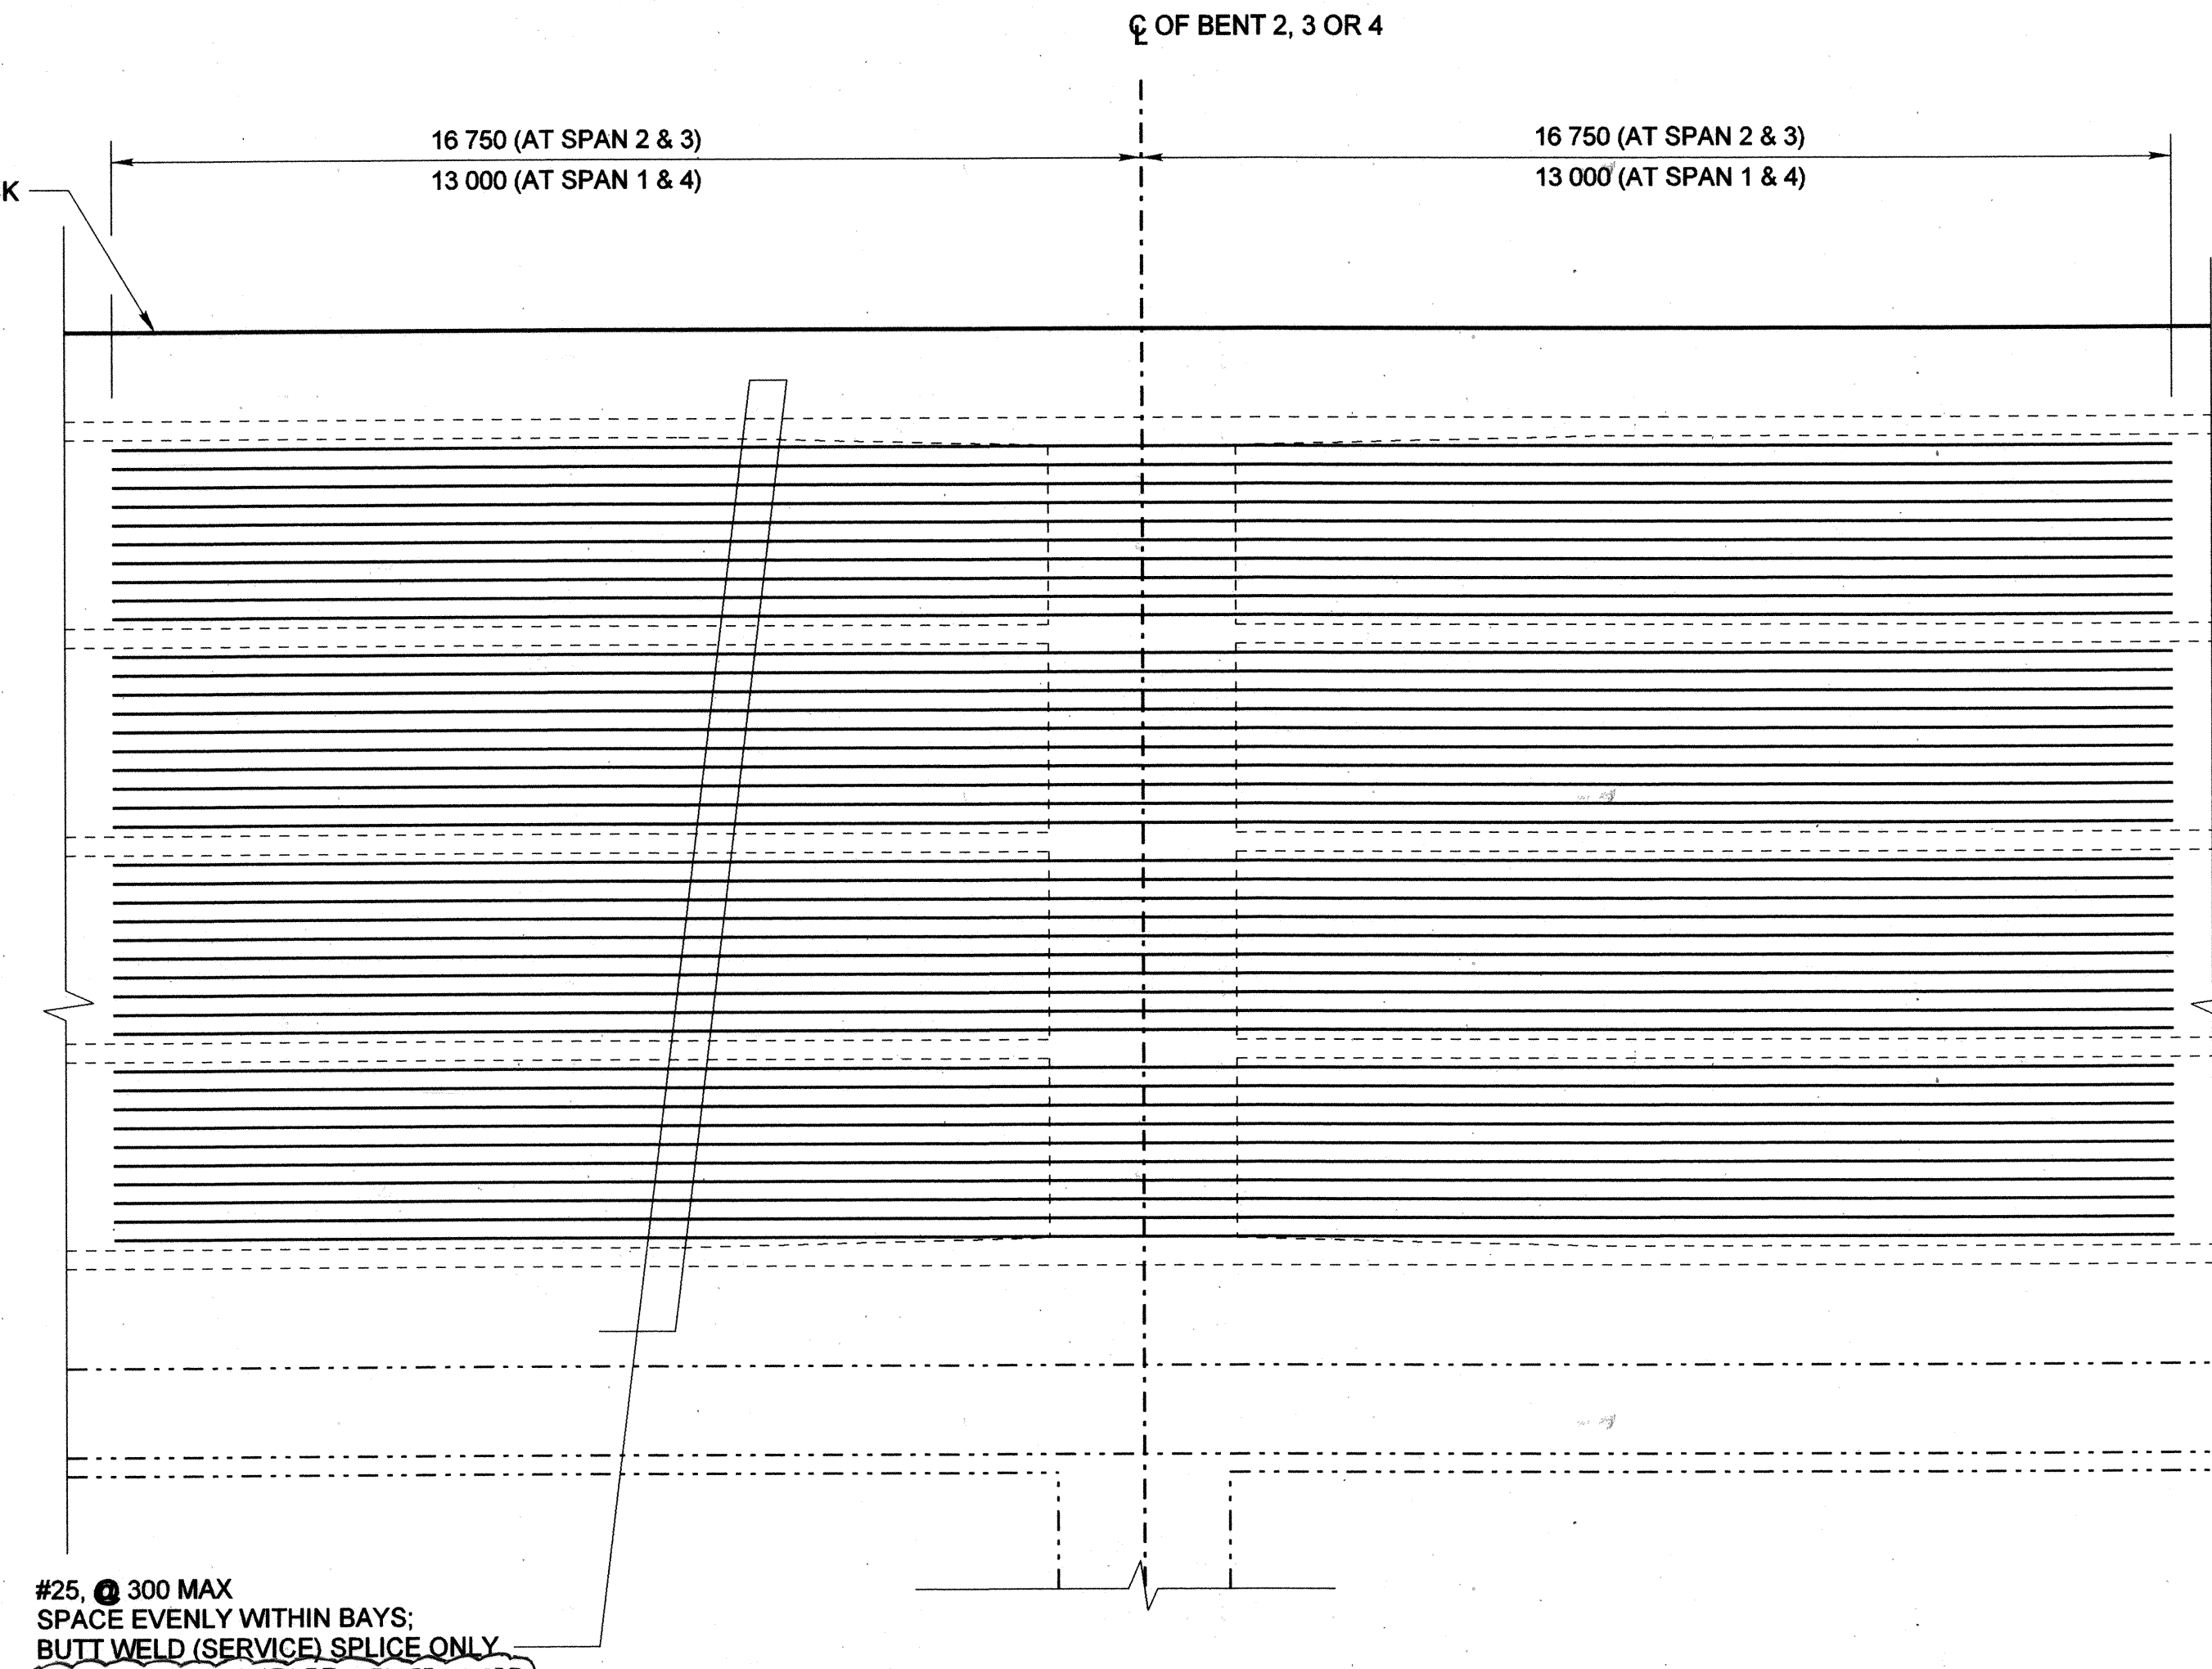

ADDITIONAL BOTTOM SLAB MILD REINFORCEMENT

1:100

FOR REDUCED PLANS ORIGINAL
SCALE IS IN MILLIMETERS

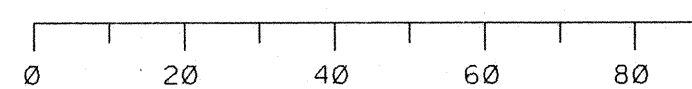

ALL DIMENSIONS ARE IN MILLIMETERS UNLESS NOTED OTHERWISE.

ORANGE COUNTY PUBLIC FACILITIES AND RESOURCES DEPARTMENT	
CROWN VALLEY PARKWAY BRIDGE (WIDENING) OVER ARROYO TRABUCO MISCELLANEOUS DETAILS NO.1	
DESIGNED: M. SARWAR	SHEET 39 OF 55
DRAWN: R. DANLEY	CHECKED: J. SARAH
SCALE: AS SHOWN	DATE: MAY 01, 2003
DRAWING NO.	

MARK	DATE	DESCRIPTION
2	2/14/06	AS BUILT

REVISIONS

PREPARED UNDER RESPONSIBLE CHARGE OF:

H. YEE
No. 54757
Exp. 12/31/03
Professional Engineer
State of California

8/6/03

Washington
Washington Infrastructure Services, Inc.
17300 Redhill Avenue, Suite 150
Irvine, CA 92614

File Name: M:\26144\Struct\miscdet1_w.dgn
Date Plotted: 8/5/2003 14:32:59

8/5/2003 14:32:59

M:\26144\Struct\miscdet1_w.dgn

Last modified 30-Apr-1998