
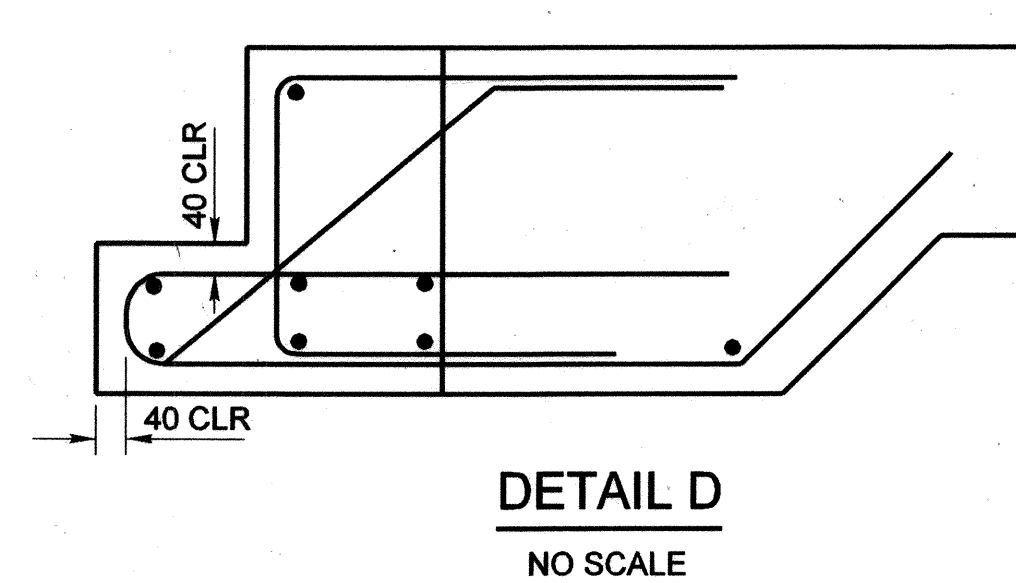
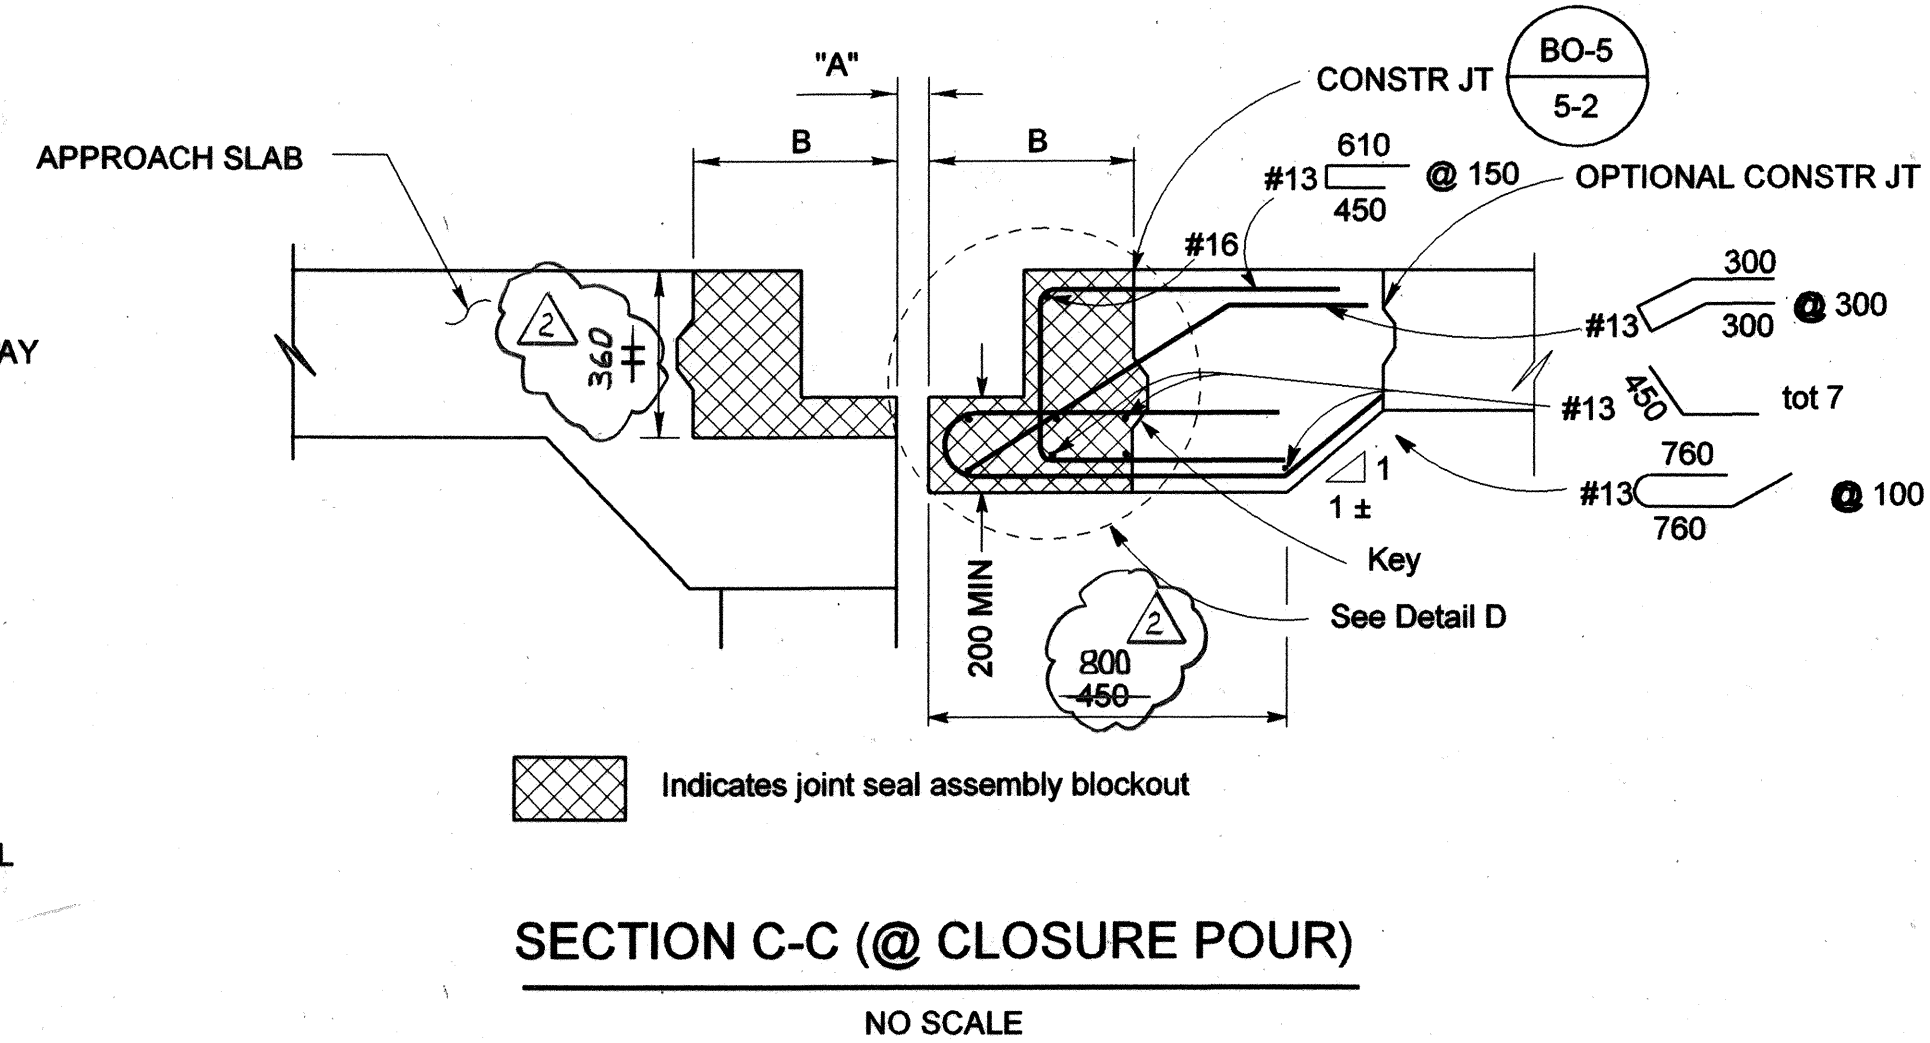
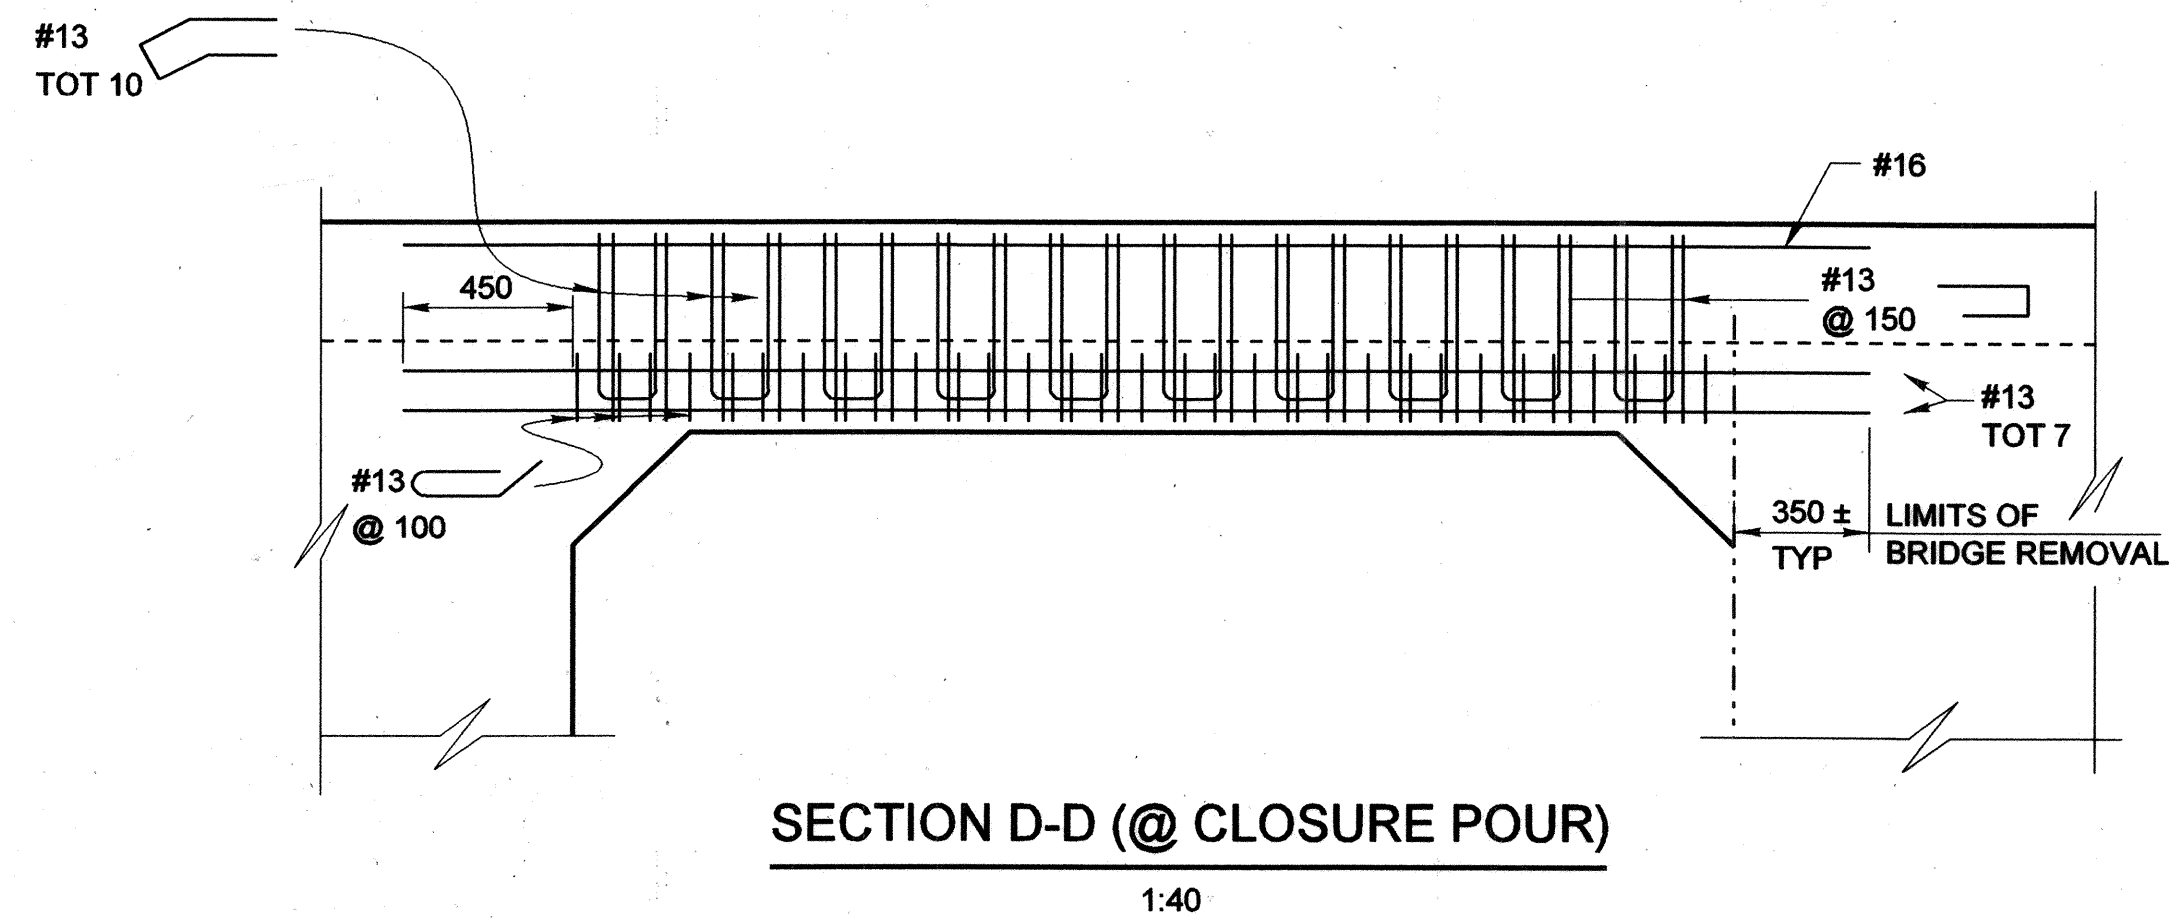
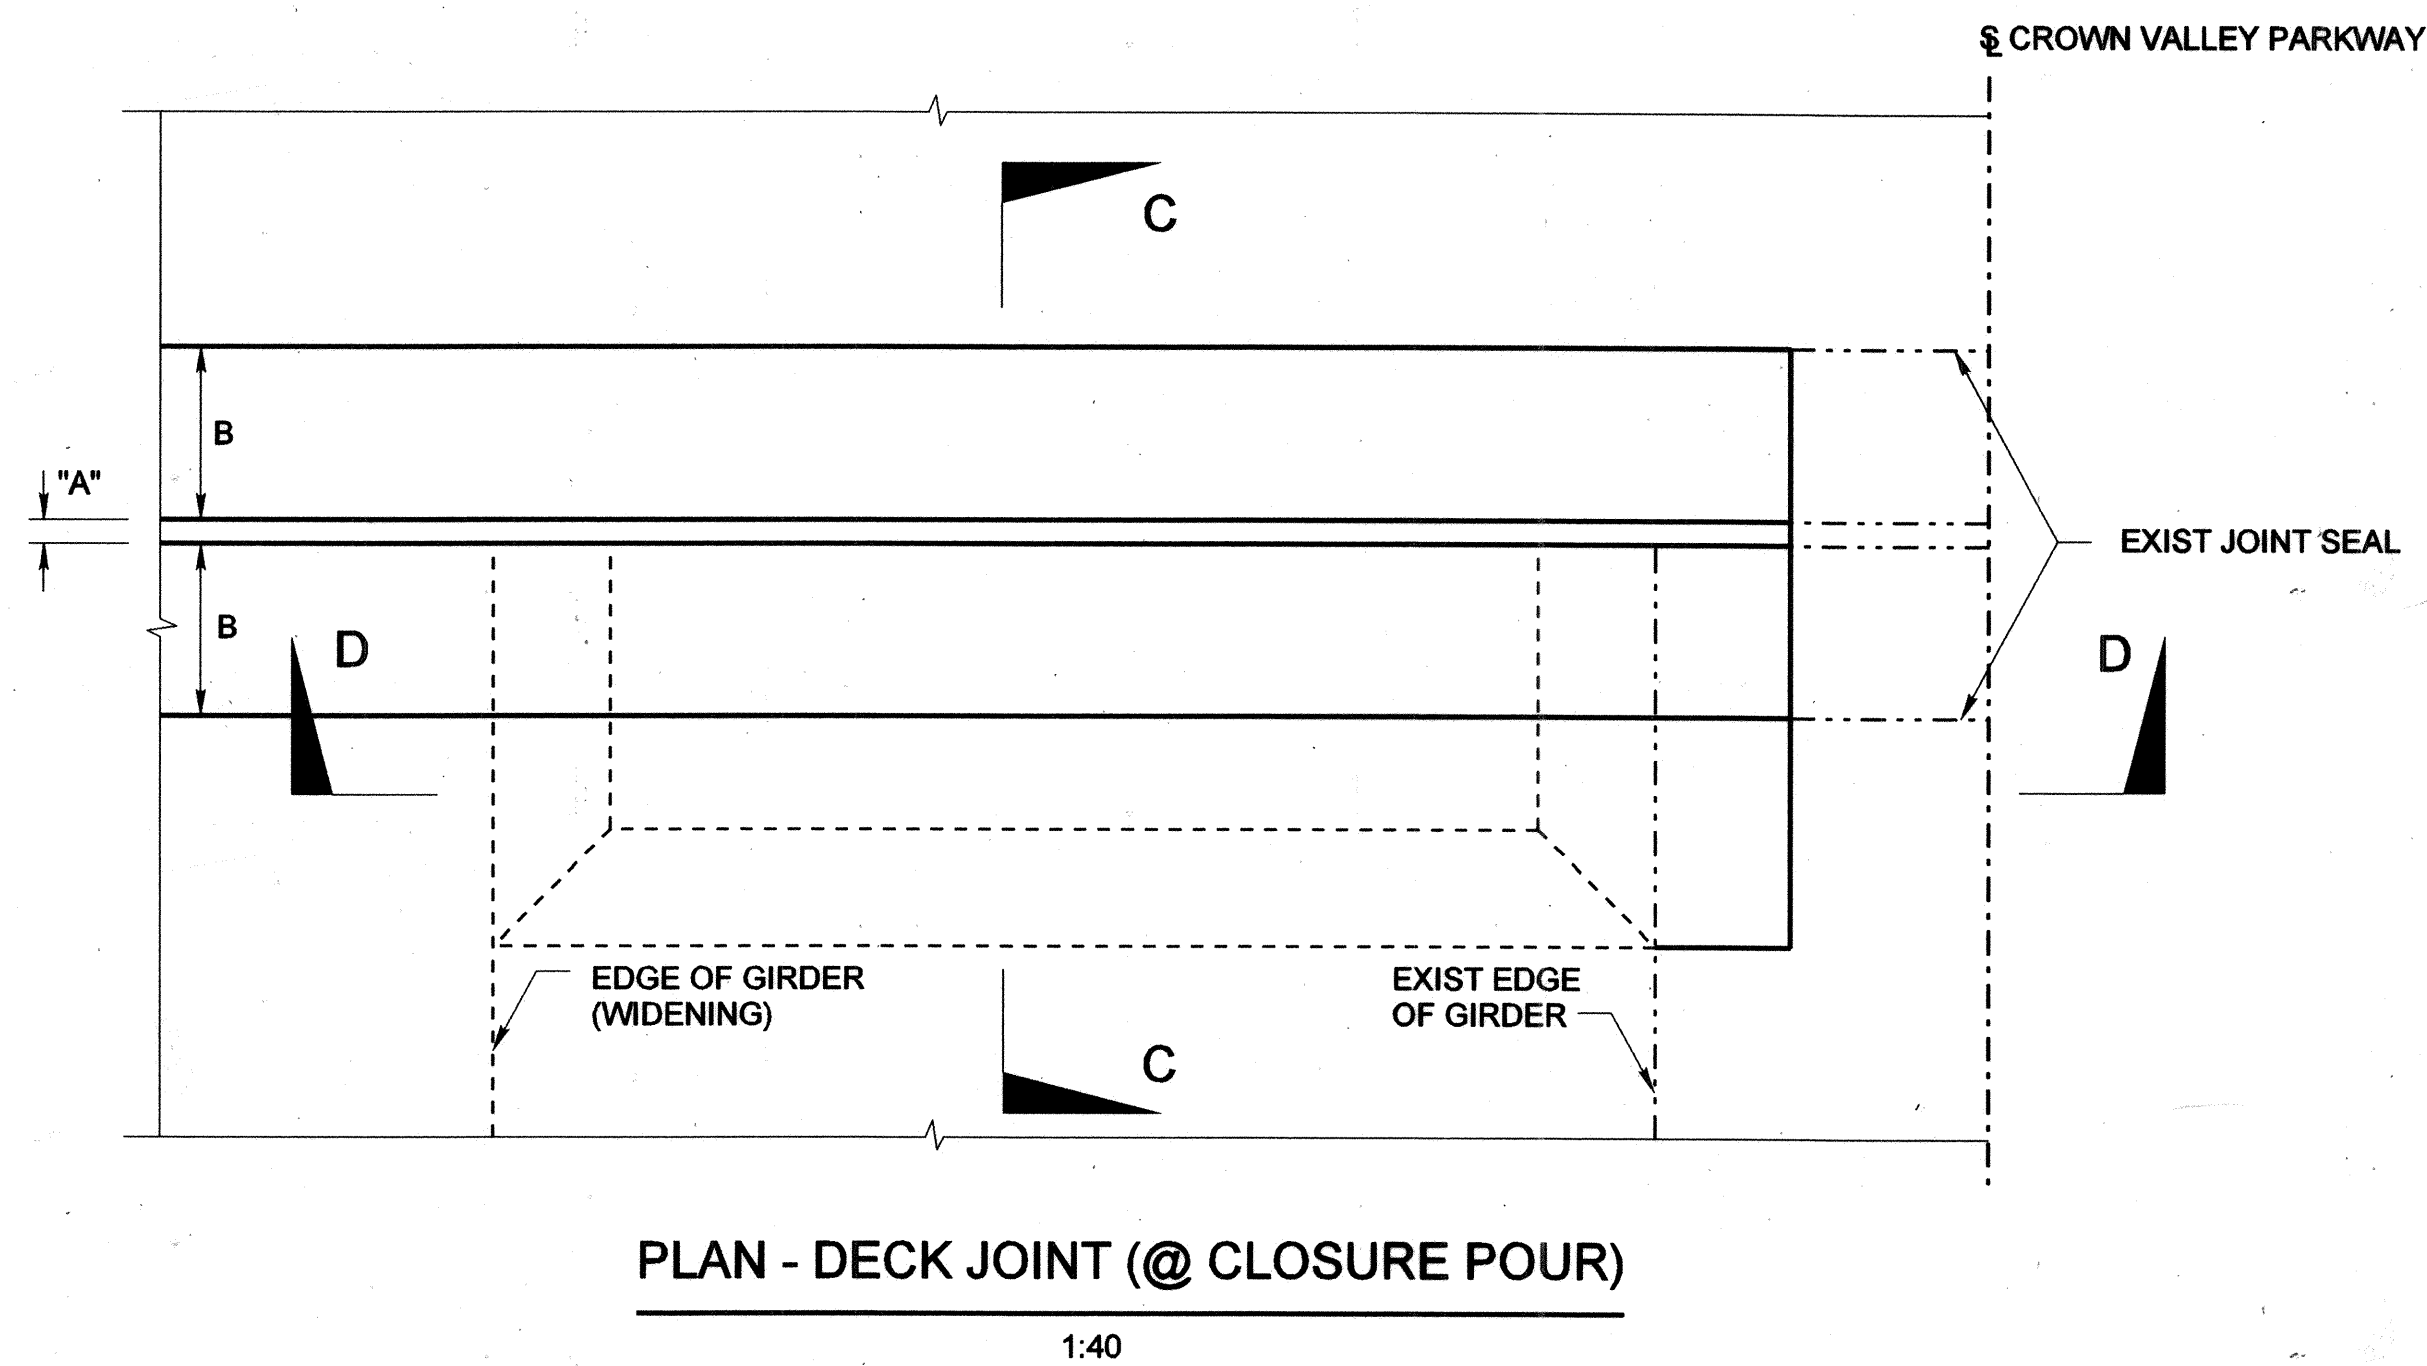


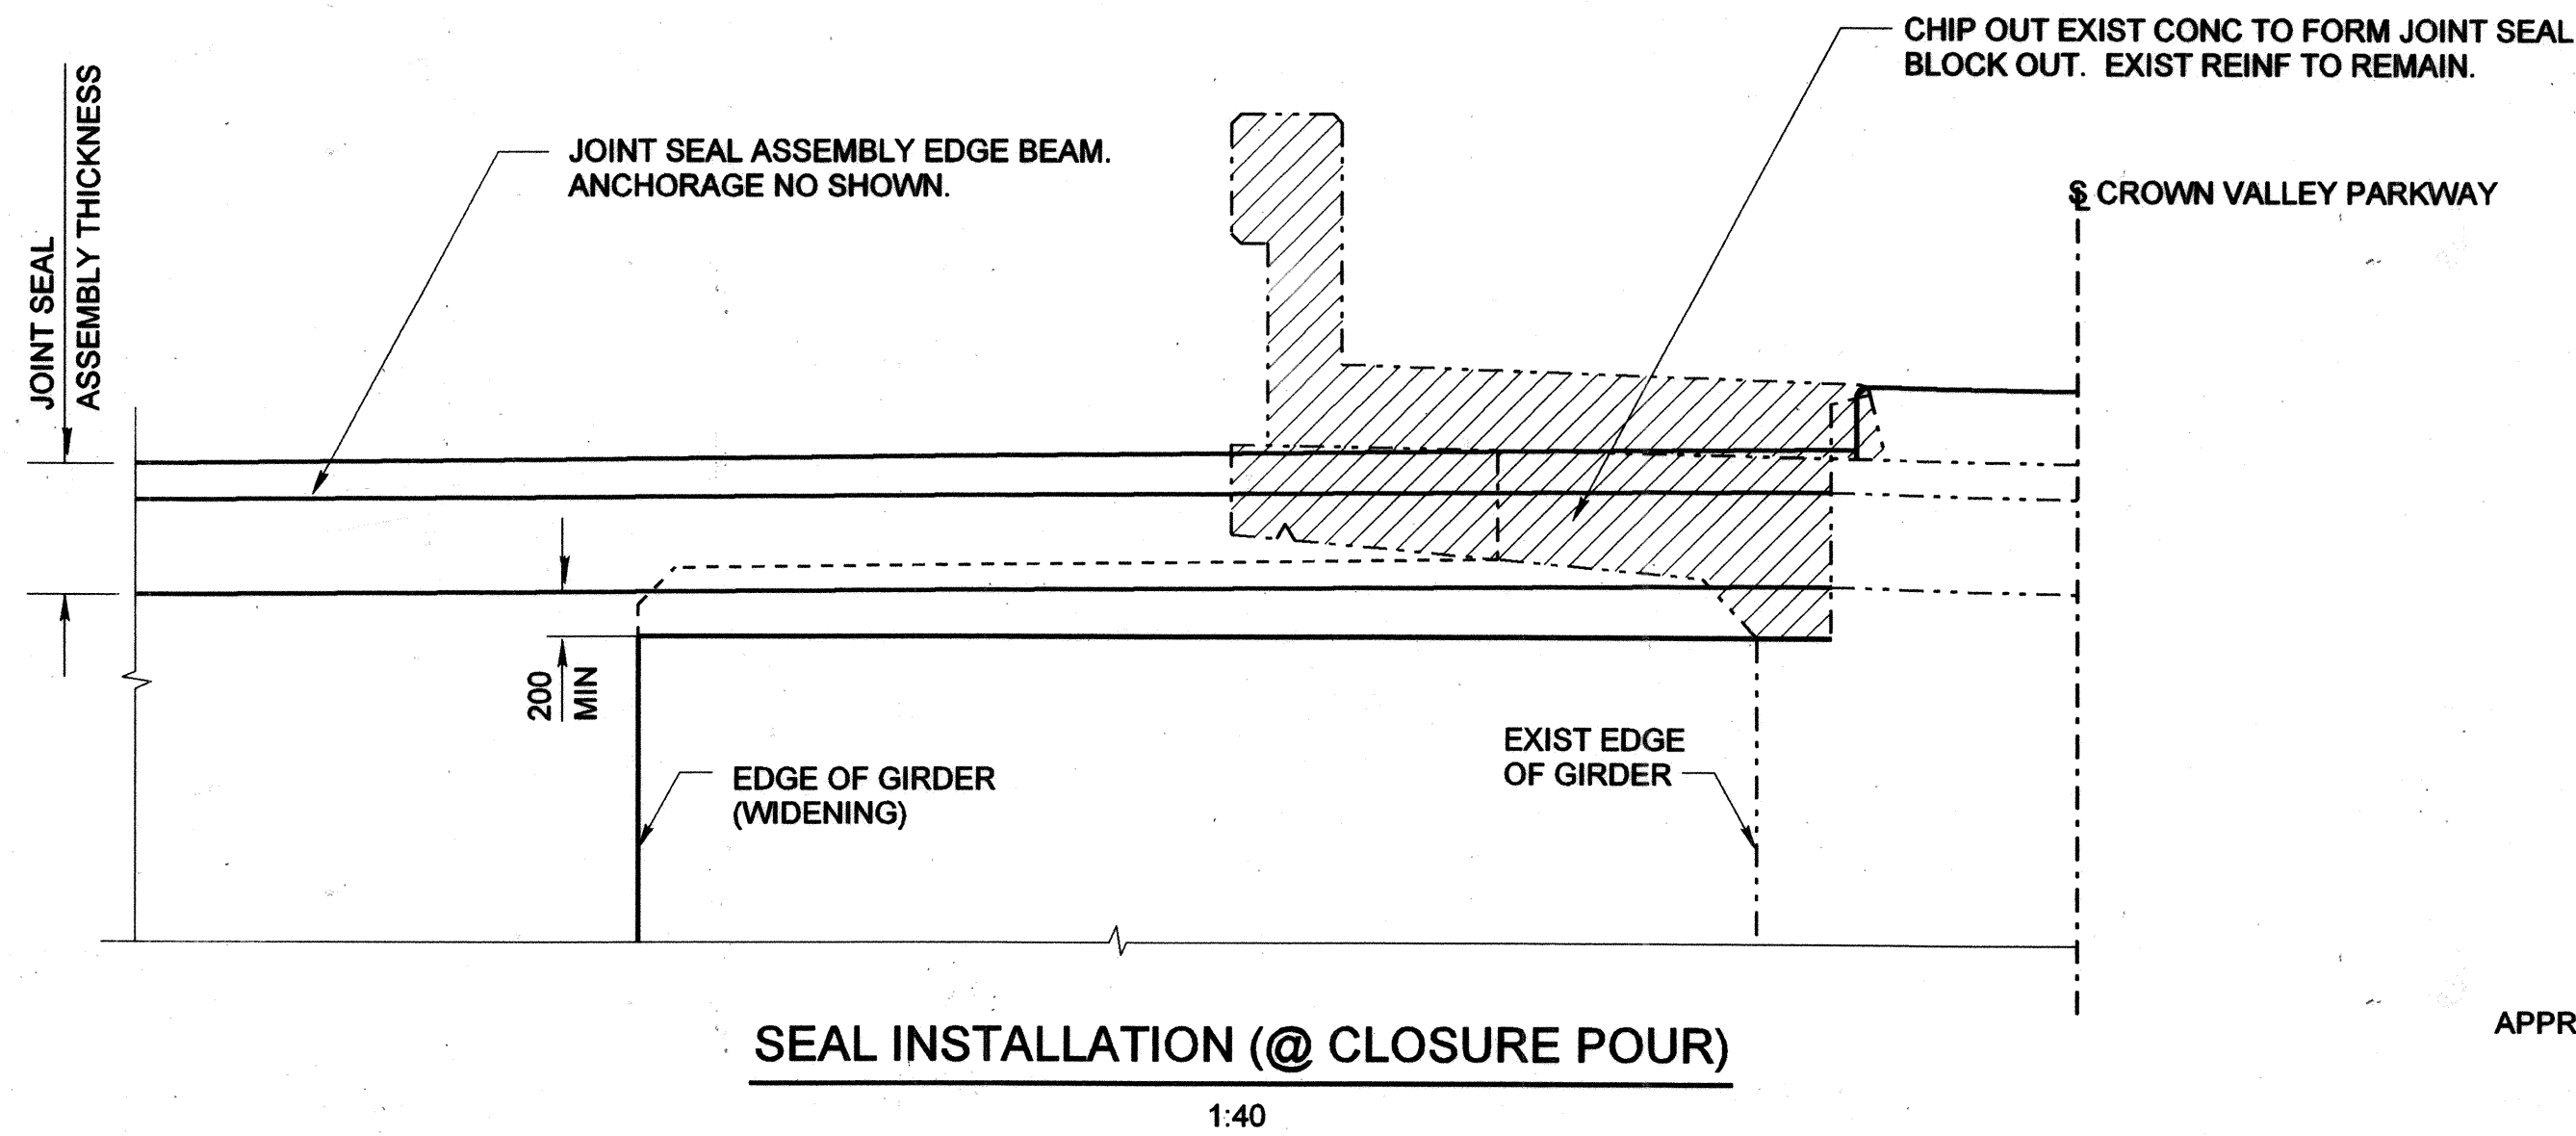

LEGEND



- INDICATES EXIST STRUCTURE
- ▨ INDICATES BRIDGE REMOVAL

NOTES:

- JOINT SEAL ASSEMBLY DETAILS INDICATED HERE ARE FOR ILLUSTRATIVE PURPOSES ONLY. DETAIL DESIGN IS THE RESPONSIBILITY OF THE CONTRACTOR.
- COORDINATE BLOCKOUT DIMENSIONS WITH JOINT SEAL MANUFACTURER.
- JOINT SEAL ASSEMBLY SHALL MATCH THE EXISTING JOINT SEAL TYPE. THE EXISTING GLAND(S) SHALL BE REMOVED AND REPLACED. NO SPLICING OF THE GLANDS SHALL BE PERMITTED.
- FOR SECTIONS AND DETAILS NOT SHOWN, SEE "JOINT SEAL ASSEMBLY DETAILS NO. 1 (MR = 140)" SHEET.

ALL DIMENSIONS ARE IN MILLIMETERS UNLESS NOTED OTHERWISE.


ORANGE COUNTY PUBLIC FACILITIES AND RESOURCES DEPARTMENT	
CROWN VALLEY PARKWAY BRIDGE (WIDENING) OVER ARROYO TRABUCO JOINT SEAL ASSEMBLY DETAILS NO. 2 (MR = 140)	
DESIGNED: M. SARWAR	SHEET 42 OF 55
DRAWN: R. DANLEY	CHECKED: J. SARAH
SCALE: AS SHOWN	DATE: MAY 01, 2003
DRAWING NO.	

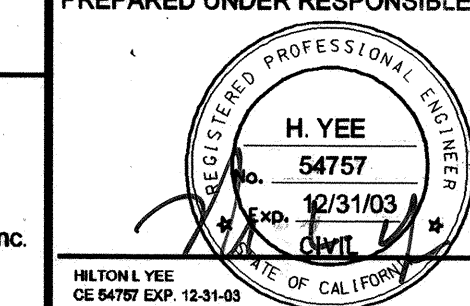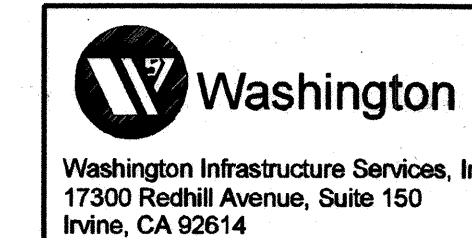

File Name: M:\26144\Struct\jointseal2_w.dgn
Date Plotted: 7/23/2003 11:07:38

M:\26144\Struct\jointseal2_w.dgn 7/23/2003 11:07:38

FOR REDUCED PLANS ORIGINAL SCALE IS IN MILLIMETERS

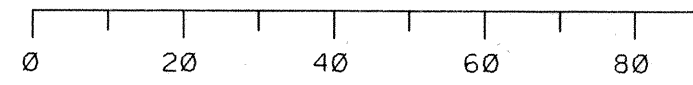

Last modified 30-Apr-1998