


DECK DRAIN NEAR BENTS 2, 3 & 4
Not To Scale

FOR REDUCED PLANS ORIGINAL SCALE IS IN MILLIMETERS

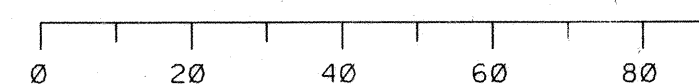

NOTES:

1. FOR DETAILS NOT SHOWN, SEE B7-6

HANGER SUPPORT DETAIL
Not To Scale

ALL DIMENSIONS ARE IN MILLIMETERS UNLESS NOTED OTHERWISE.



2	2-7-06	AS BUILT
MARK	DATE	DESCRIPTION
REVISIONS		
PREPARED UNDER RESPONSIBLE CHARGE OF:		
DESIGNED	H. YEE	
DRAWN	R. DANLEY	CHECKED J. SARAH
SCALE	DATE	DRAWING NO.
AS SHOWN	MAY 01, 2003	

ORANGE COUNTY PUBLIC FACILITIES AND RESOURCES DEPARTMENT	
CROWN VALLEY PARKWAY BRIDGE (WIDENING) OVER ARROYO TRABUCO DECK DRAIN DETAILS	
DESIGNED	H. YEE
DRAWN	R. DANLEY
CHECKED	J. SARAH
SCALE	DATE
AS SHOWN	MAY 01, 2003
DRAWING NO.	
SHEET	43
OF	55

File Name: M126144Structdrain_w.dgn
Date Plotted: 7/23/2003 11:08:52