


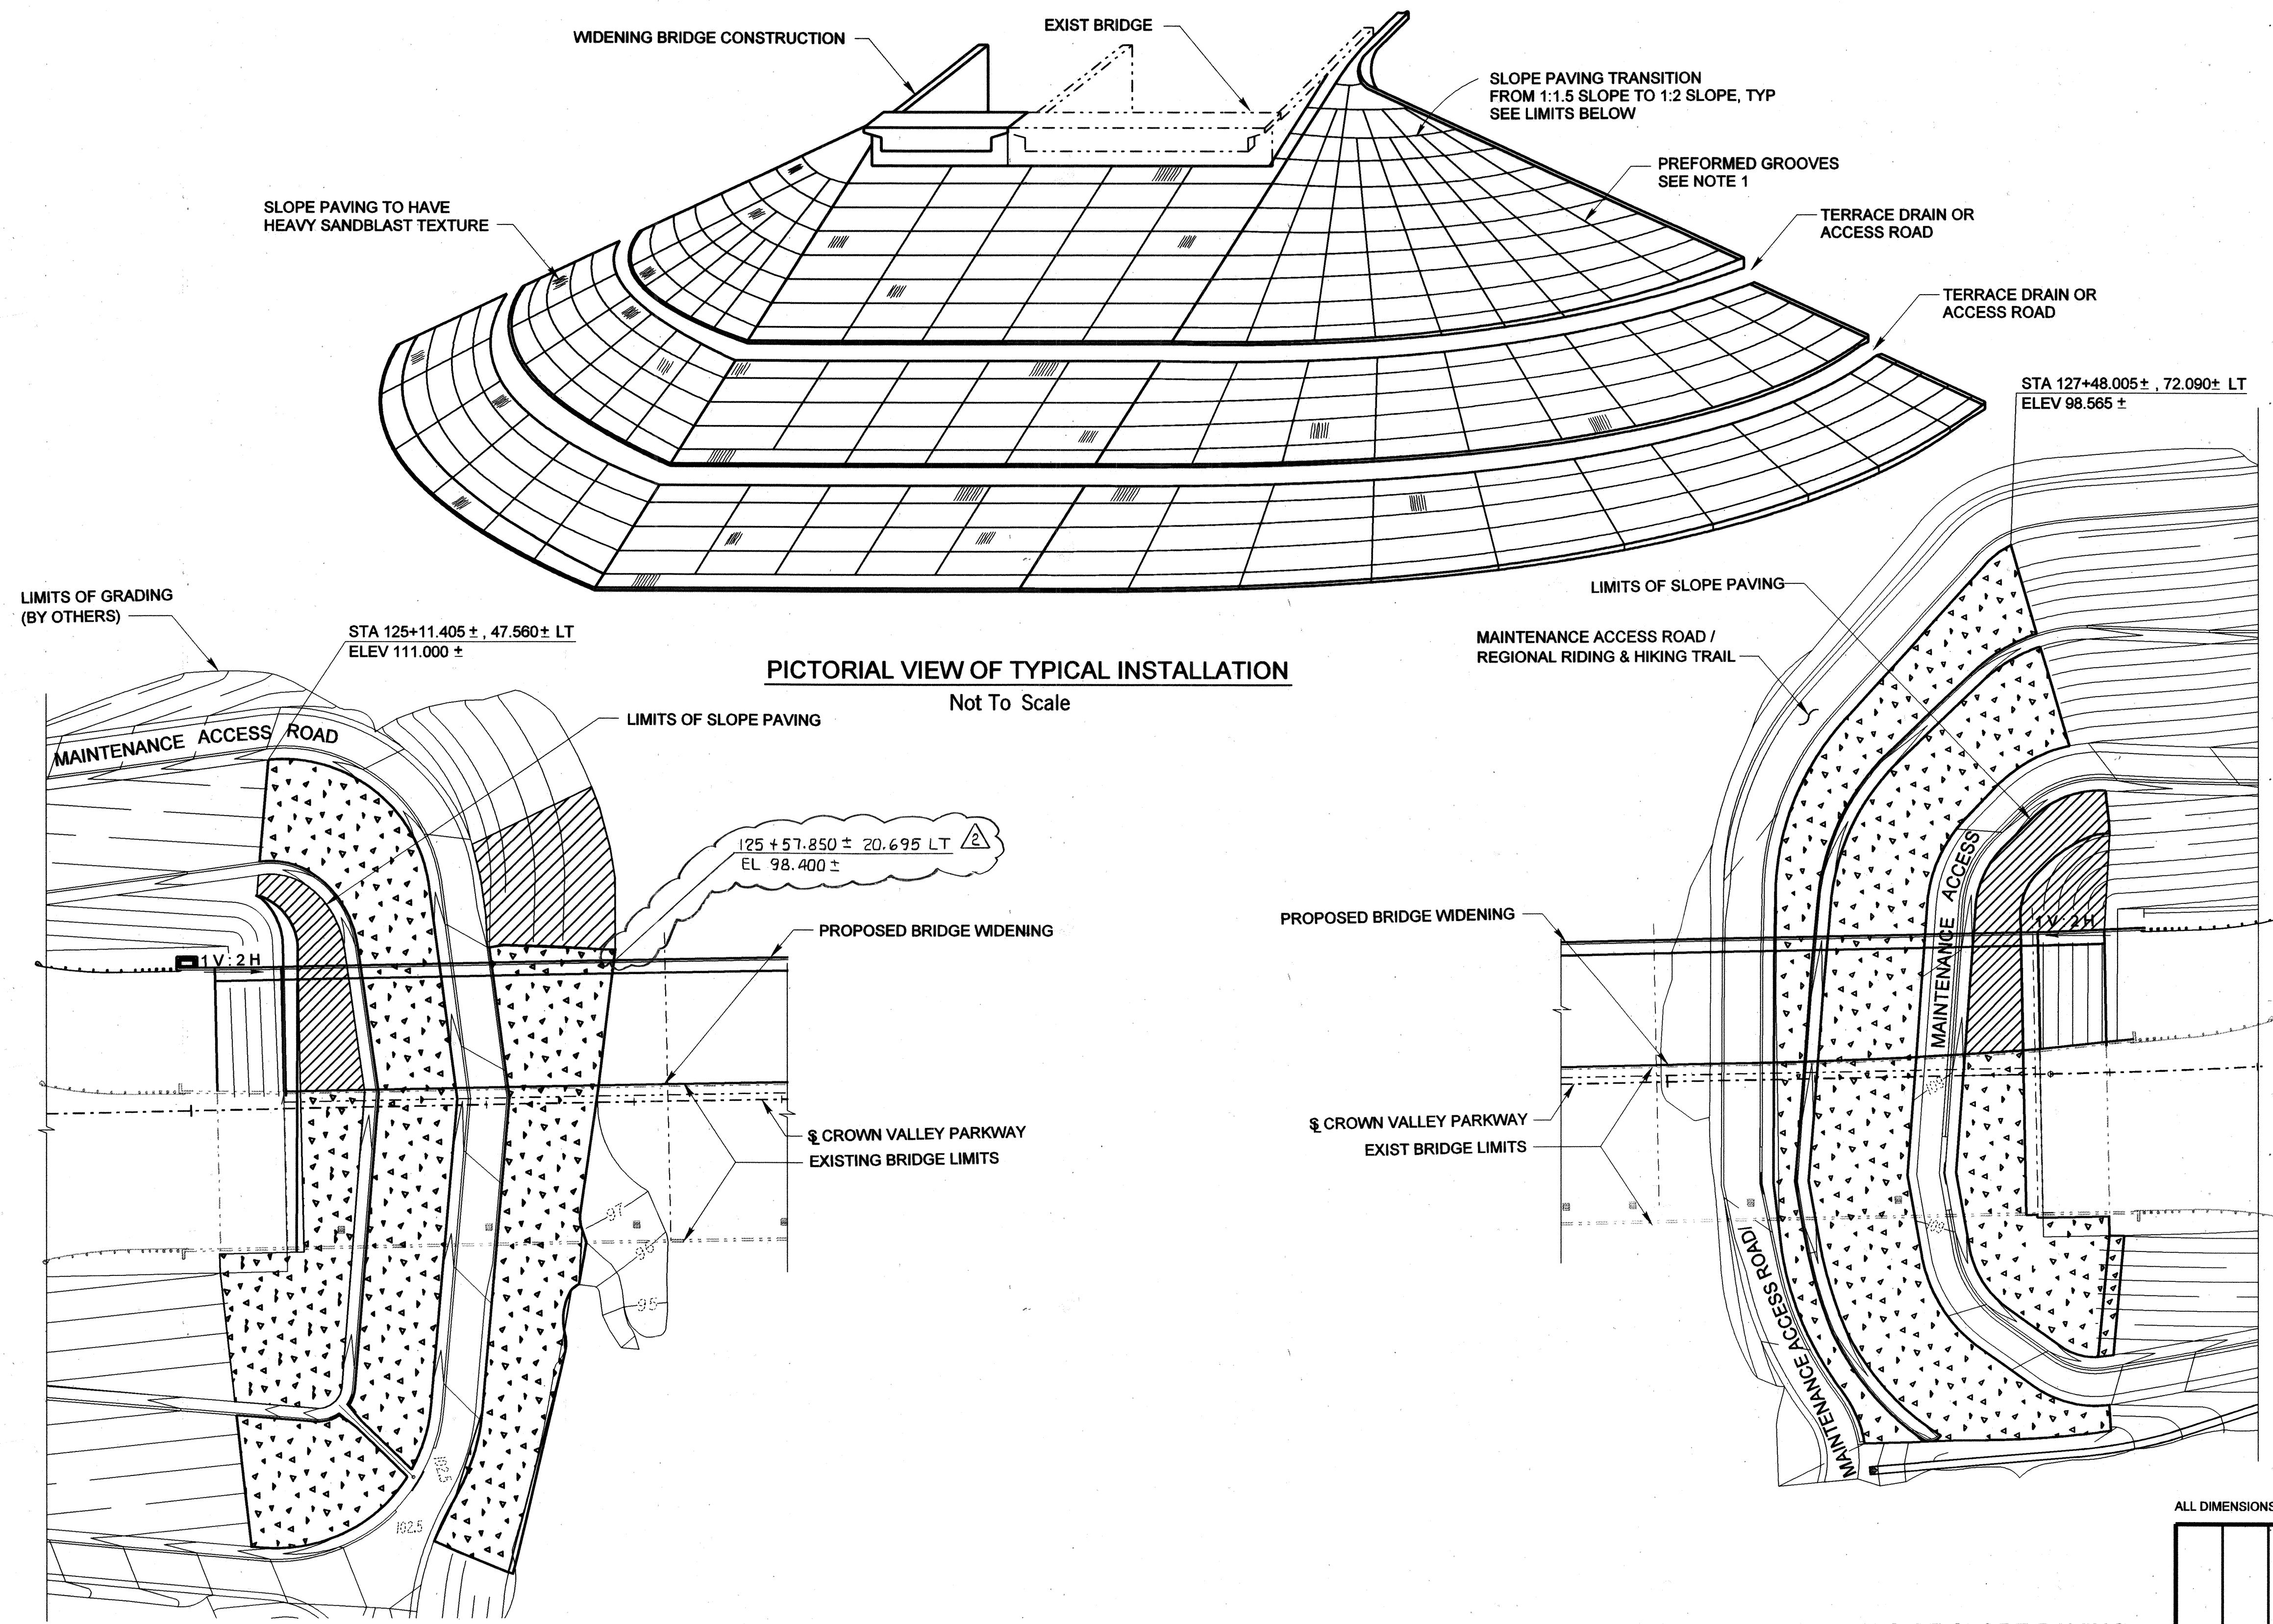

LEGEND

- EXIST CONC SLOPE PAVING
- CONCRETE SLOPE PAVING, HEAVY SANDBLAST TEXTURE

NOTES:

1. PREFORMED GROOVE IN SLOPE PAVING TO BE 4.50 m VERTICAL BY 6.00 m HORIZONTAL, OR AS DIRECTED BY THE ENGINEER TO PROVIDE UNIFORM SPACING.
2. FOR CLARITY, NOT ALL GROOVES SHOWN.
3. FOR SECTION DETAILS SEE "SLOPE PAVING DETAILS-FULL SLOPE NO. 2" SHEET.
4. SLOPE PAVING TO COVER FILL SLOPE TO LIMITS SHOWN FOR ULTIMATE BRIDGE CONFIGURATION.
5. PORTIONS OF EXISTING SLOPE PAVING DAMAGED DUE TO WIDENING BRIDGE CONSTRUCTION SHALL BE REPAIRED TO ORIGINAL STATE OR TO THE SATISFACTION OF THE ENGINEER.

PICTORIAL VIEW OF TYPICAL INSTALLATION
Not To Scale

WEST EMBANKMENT - LIMITS OF SLOPE PAVING
Not To Scale

EAST EMBANKMENT-LIMITS OF SLOPE PAVING
Not To Scale

FOR REDUCED PLANS ORIGINAL SCALE IS IN MILLIMETERS

ALL DIMENSIONS ARE IN METERS UNLESS NOTED OTHERWISE.

2	2-17-06	AS BUILT
MARK	DATE	DESCRIPTION
REVISIONS		
PREPARED UNDER RESPONSIBLE CHARGE OF:		
Washington Infrastructure Services, Inc. 17300 Redhill Avenue, Suite 150 Irvine, CA 92614		
ORANGE COUNTY PUBLIC FACILITIES AND RESOURCES DEPARTMENT CROWN VALLEY PARKWAY BRIDGE (WIDENING) OVER ARROYO TRABUCO SLOPE PAVING DETAILS FULL SLOPE NO.1		SHEET 48 OF 55
DESIGNED: H. YEE DRAWN: R. DANLEY SCALE: AS SHOWN DATE: MAY 01, 2003	CHECKED: J. SARAH DRAWING NO.: DATE:	FILE NAME: M:\26144\Struct\lppave_w.dgn DATE PLOTTED: 7/23/2003 11:20:17

M:\26144\Struct\lppave_w.dgn 7/23/2003 11:20:11

Last modified 30-Apr-1998