

EXPLANATION	
Qalc	ENGINEERED FILL
Qal	ALLUVIUM
Qt	TERRACE DEPOSITS
Tc	CAPISTRANO FORMATION
---	GEOLOGIC CONTACT
	TYPICAL BEDDING
///	TYPICAL JOINT

PLAN
Scale: 1:1000

DIST.	COUNTY	ROUTE	POST MILES TOTAL PROJECT	SHEET NO.	TOTAL SHEETS
				1	3

Andrew R. Stone
 GEOTECHNICAL PROFESSIONAL

PLANS APPROVAL DATE _____

GOFFMAN MCCORMICK & URBAN, INC.
 23241 Arroyo Vista
 Rancho Santa Margarita, CA 92688
 Project No: 97-47

REGISTERED GEOLOGIST
 ANDREW R. STONE
 No. 1648
 CERTIFIED
 ENGINEERING
 GEOLOGIST
 STATE OF CALIFORNIA

PLATE 3.1

As-Built Log of Test Borings sheet is considered an informational document only. As such, the State of California registration seal with signature, license number and registration certificate expiration date will not be required. This drawing is available and presented only for the convenience of any bidder, contractor or other interested party.

DIST	COUNTY	ROUTE	KILOMETER POST-TOTAL PROJECT	SHEET NO.	TOTAL SHEETS
	ORA			53	55


CROWN VALLEY BRIDGE (WIDENING)

LOG OF TEST BORINGS 1 OF 3

The State of California or its officers or agents shall not be responsible for the accuracy or completeness of electronic copies of this plan sheet.

TO ACCOMPANY PLANS DATED DE 04 02	CU	BRIDGE NO.
	EA	SSC - 0637

THIS STRUCTURE : _____ SHEET NO. _____

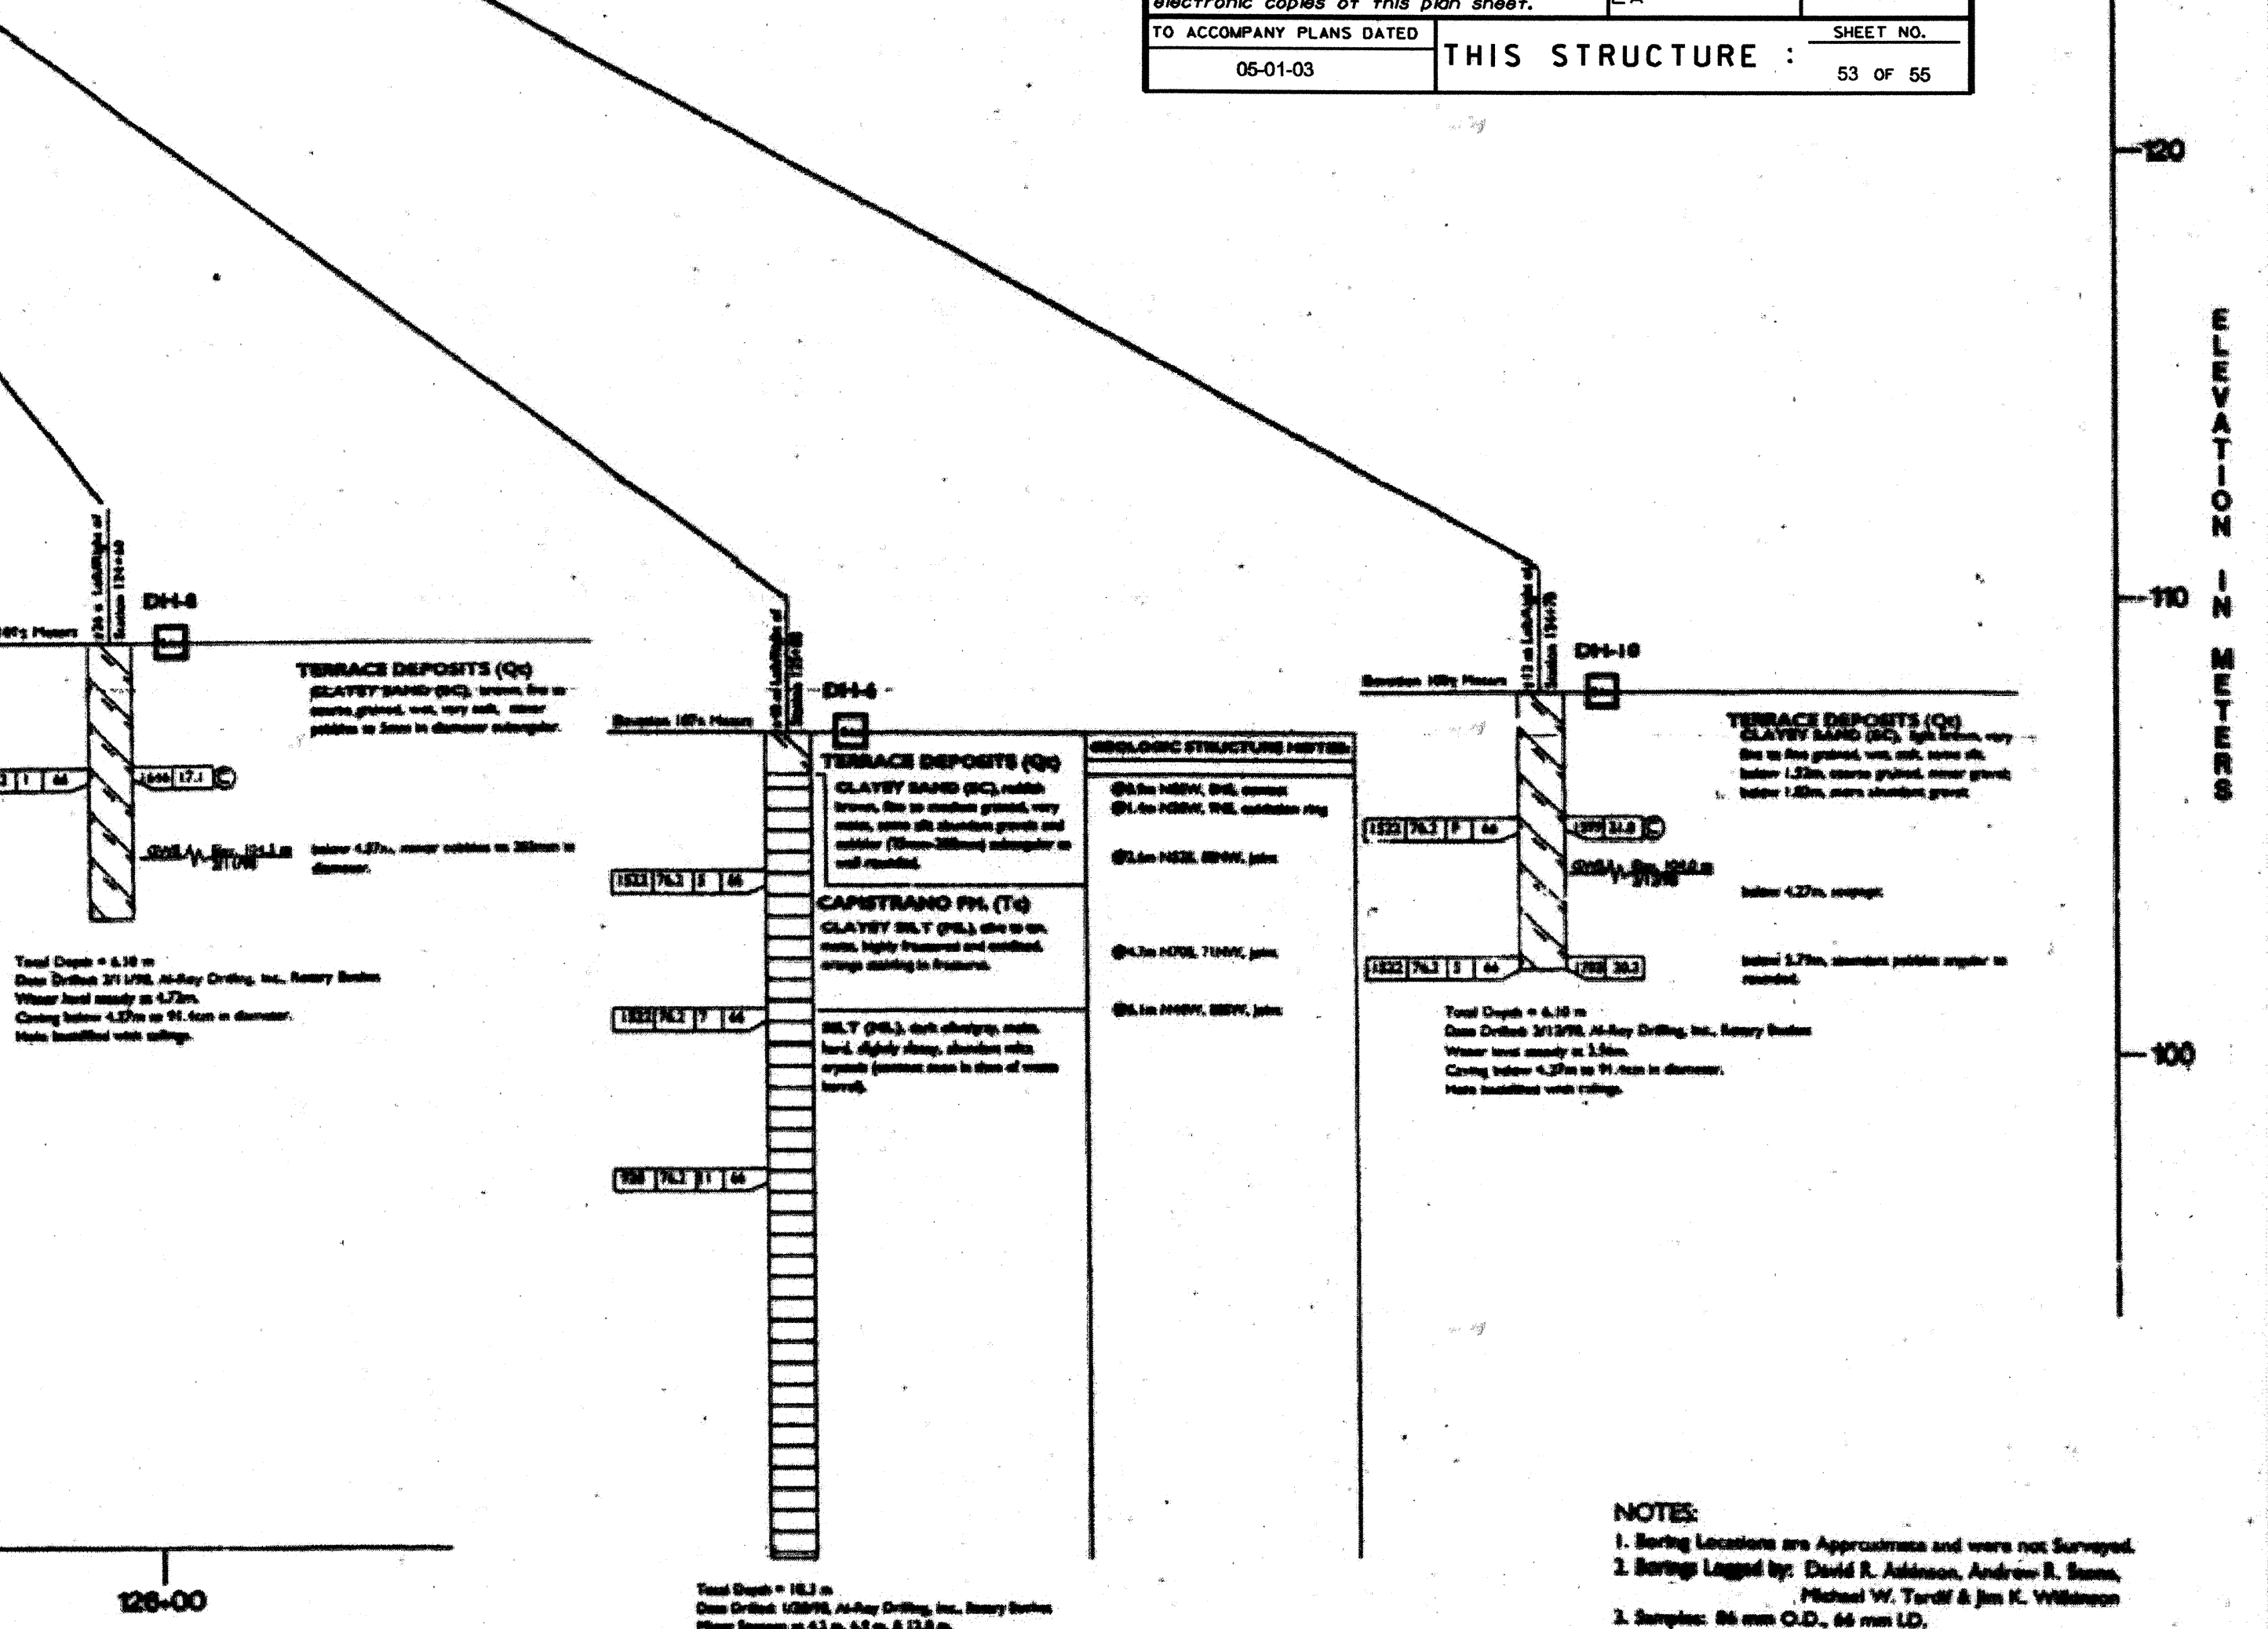

NOTES:

1. Boring Locations are Approximate and were not Surveyed.
2. Borings Logged by: David R. Adkinson, Andrew R. Sano, Michael W. Terdfi & Jim K. Wilkinson
3. Samples: 86 mm O.D., 66 mm I.D.,
51 mm O.D., 36 mm I.D.

LOG OF TEST BORINGS CROWN VALLEY PARKWAY BRIDGE

COUNTY OF ORANGE