


LEGEND OF BORING OPERATIONS

LEGEND FOR EARTH MATERIALS

CONSISTENCY CLASSIFICATION FOR SOILS

NOTE: Classification of earth material as shown on this sheet is based upon field inspection and is not to be construed to imply mechanical analysis.

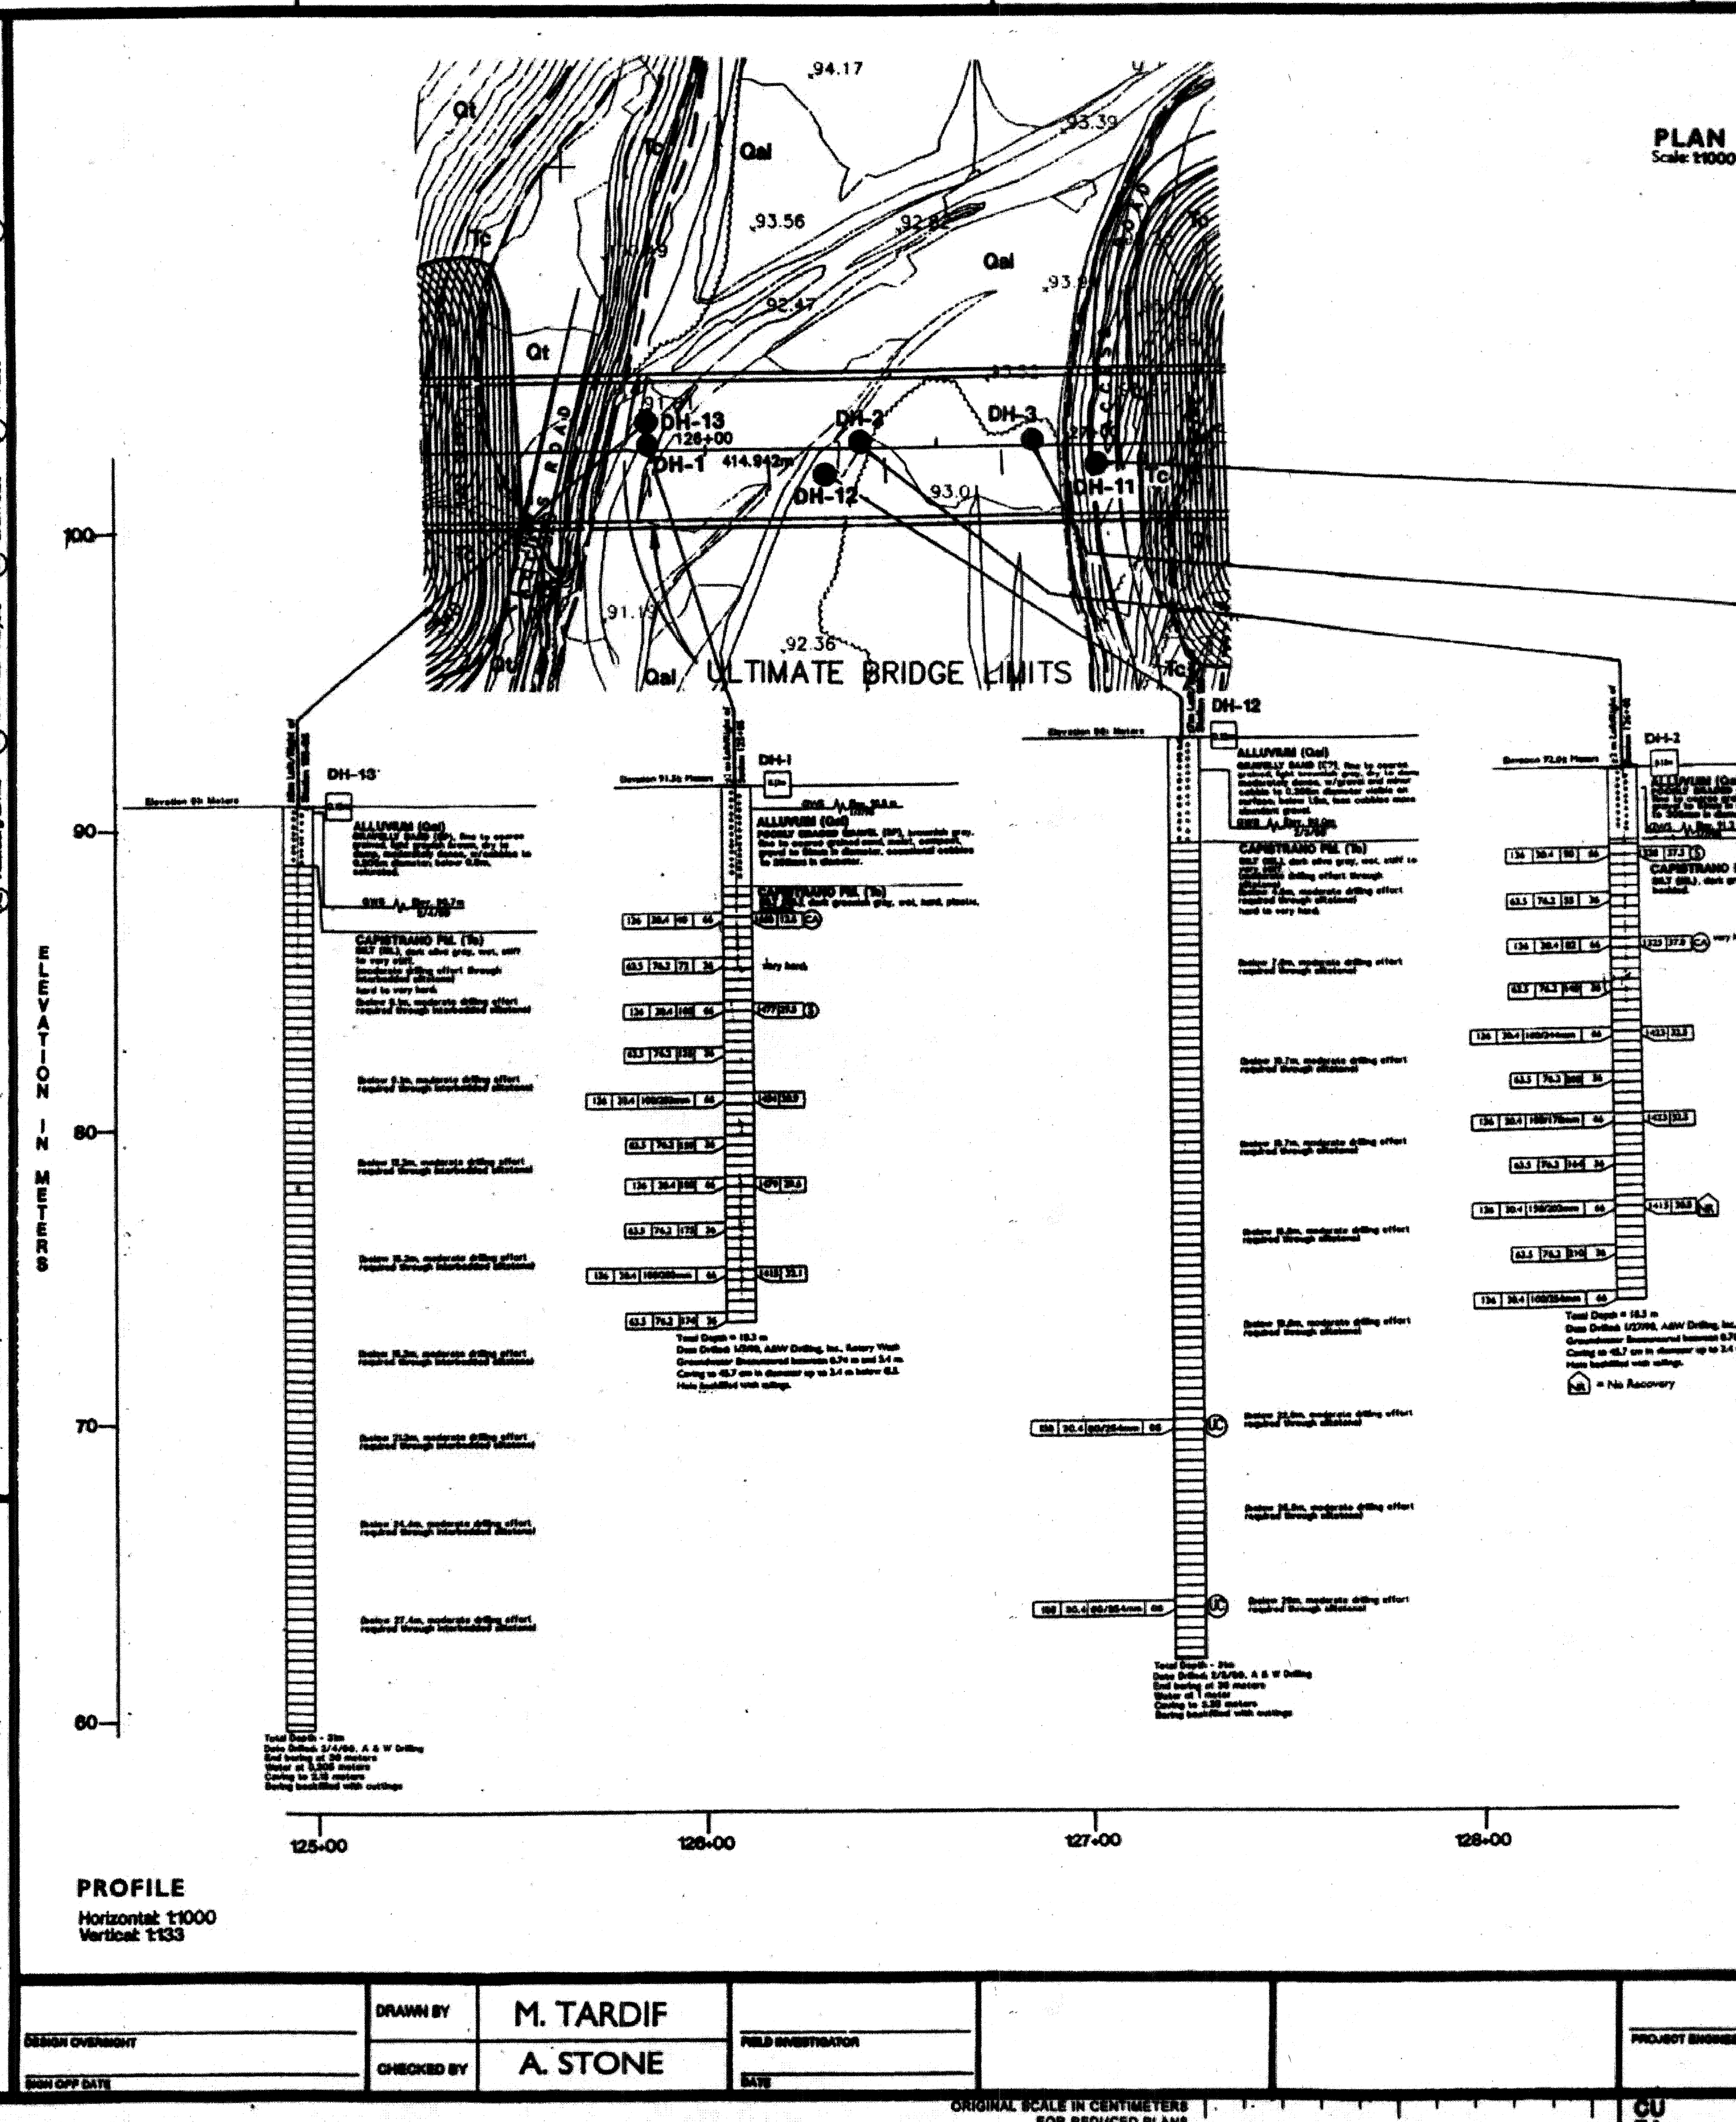

EXPLANATION

PLAN Scale: 1:1000

North

LEGEND

ALLUVIUM (Qal)

TERRACE DEPOSITS (Tc)

CAPISTRANO FORMATION (Tc)

GEOLOGIC CONTACT

TYPICAL BEDDING

REPORT DATE: 2/27/98

REPORT REVISED: JUNE 30, 1998

PLATE 3.2

LOG OF TEST BORINGS CROWN VALLEY PARKWAY BRIDGE

COUNTY OF ORANGE

BRIDGE NO. 54

LOG OF TEST BORINGS 2 OF 3

THIS STRUCTURE: 54 OF 55

NOTES:

1. Boring Locations are Approximate and were not Surveyed.

2. Boring Logs by: David R. Addison, Andrew R. Stone, Michael W. Tardif & Jim K. Wilkinson

3. Sample: 56 mm O.D., 66 mm I.D. 51 mm O.D., 36 mm I.D.