



03/08/2006 11:25:32 AM  
M:\26144\shs\Sign and Striping\c.dgn

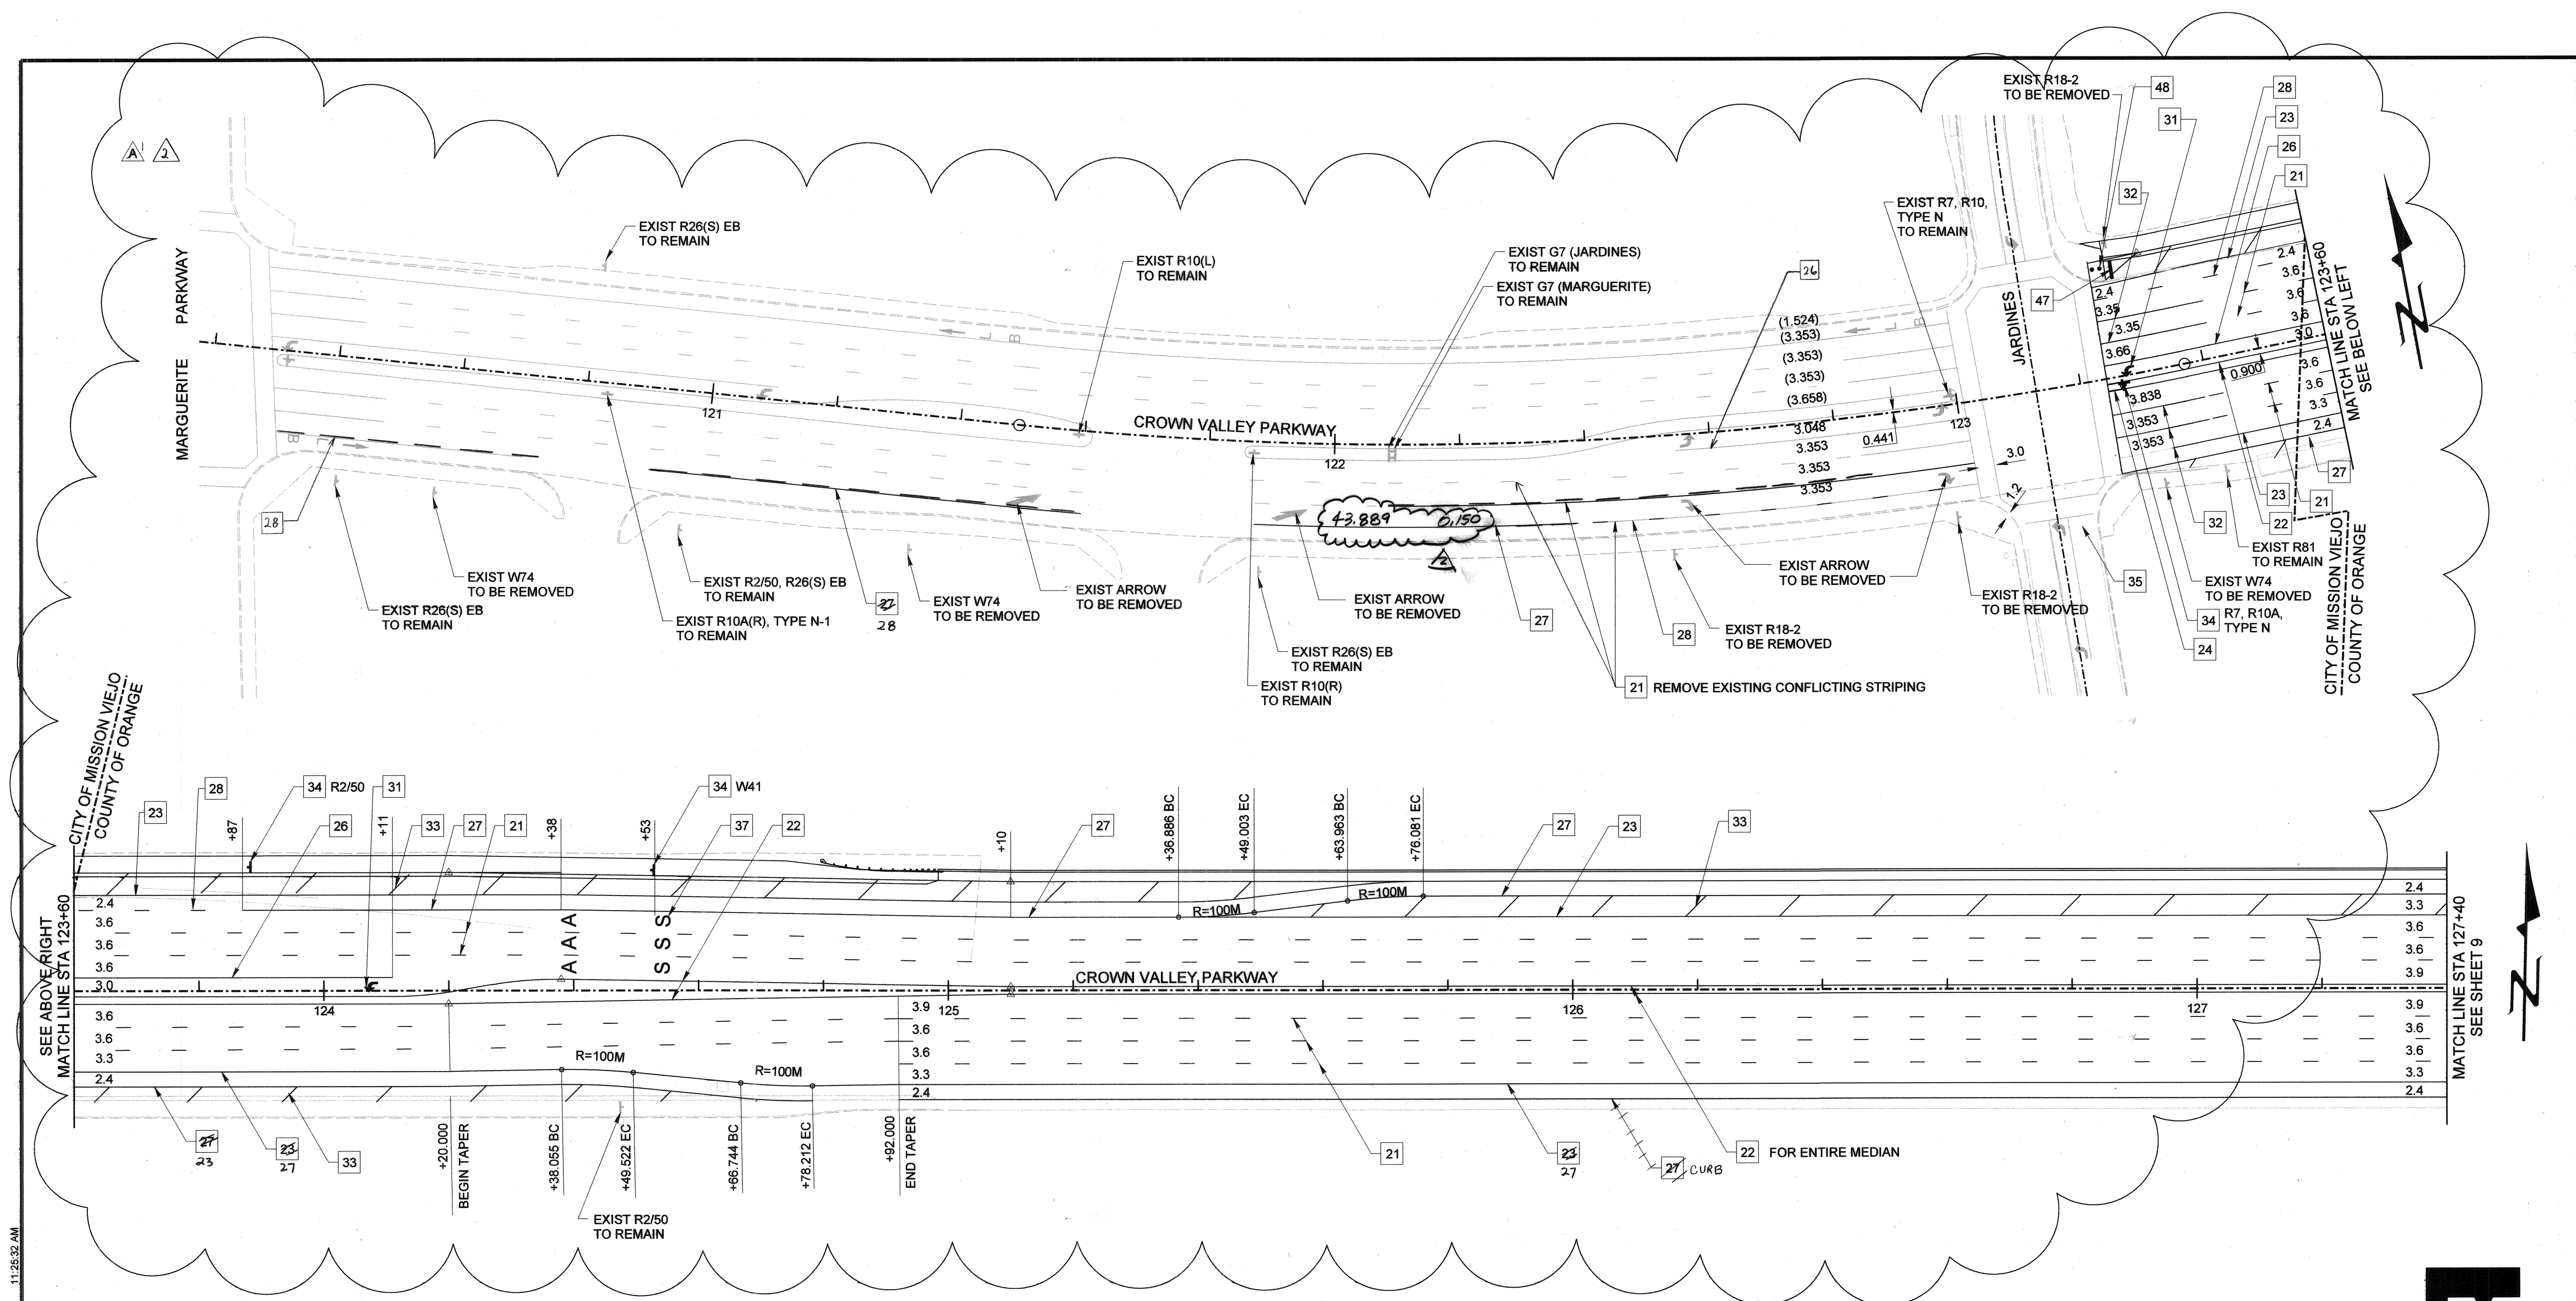

CONSTRUCTION NOTES

- |    |   |    |  |
|----|---|----|--|
| 21 | PAINT 100 mm WHITE LANE LINE / DET. 9                     | 31 | INSTALL TYPE IV ARROW MARKING  |
| 22 | INSTALL YELLOW REFLECTIVE MARKERS / DET. 26               | 32 | PAINT 15 m SOLID 100 mm WHITE /<br>INSTALL TYPE G RPMs AT END POINTS |
| 23 | PAINT 100 mm WHITE EDGE LINE / DET. 27B                   | 33 | PAINT 300 mm WHITE AT 45° AND 30 m SPACING                           |
| 24 | PAINT 100 mm DOUBLE YELLOW / DET. 29                      | 34 | INSTALL SIGN/POST OR AS SHOWN  |
| 26 | PAINT 200 mm WHITE CHANNELIZING LINE / DET. 38            | 35 | PAINT 300 mm WHITE CROSSWALK   |
| 27 | PAINT 150 mm WHITE BIKE LANE LINE / DET. 39               | 37 | INSTALL "SIGNAL AHEAD" MARKING                                       |
| 28 | PAINT 150 mm WHITE BIKE LANE INTERSECTION LINE / DET. 39A | 47 | INSTALL TYPE III BARRICADE WITH REFLECTIVE DELINEATOR                |
| 30 | INSTALL "BIKE LANE →" MARKING                             | 48 | INSTALL TYPE K-1 OBJECT MARKER (TOTAL 2)                             |

NOTE: REMOVE CONFLICTING STRIPING BY SANDBLASTING

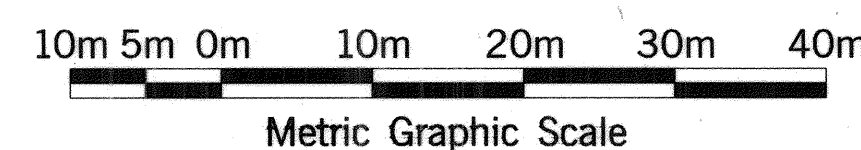

County of Orange PFRO/ROAD DIVISION-TRAFFIC ENGINEERING	
Approved By:	Date:
I.G. OCHOA, County Traffic Engineer	
THIS PLAN IS SIGNED BY PFRO/T.E. FOR CONCEPT AND ADHERENCE TO COUNTY TRAFFIC SIGNALS, SIGNING AND STRIPING STANDARDS AND REQUIREMENTS ONLY. PFRO/T.E. IS NOT RESPONSIBLE FOR DESIGN ASSUMPTIONS OR ACCURACY.	



ALL DIMENSIONS ARE IN METERS UNLESS NOTED OTHERWISE.

ORANGE COUNTY PUBLIC FACILITIES AND RESOURCES DEPARTMENT	
2	2/17/06 AS BUILT
1	8/31/05 INTERIM PHASE CHANGES
MARK	DATE DESCRIPTION
REVISIONS	
PREPARED UNDER RESPONSIBLE CHARGE OF:	
GONZALO R. PEÑA 44133 Exp. 6/30/05 CIVIL STATE OF CALIFORNIA	
SCALE	DATE
AS SHOWN	MAY 01, 2003

CROWN VALLEY PARKWAY STA 120+30 TO STA 127+40 SIGN AND STRIPING PLAN	
DESIGNED: K. NGUYEN	SHEET
DRAWN: K. NGUYEN	R 8
CHECKED: G. R. PEÑA	OF 55
DRAWING NO.	

File Name: M:\26144\shs\Sign and Striping\c.dgn  
Date Plotted: 03/08/2006 11:25:32 AM

Last modified 30-Apr-1998