
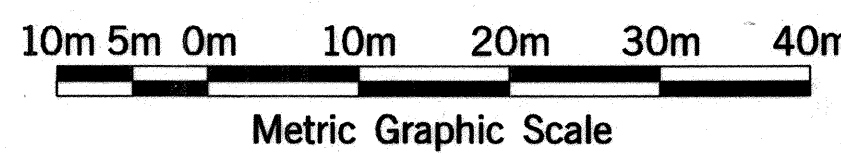


**CONSTRUCTION NOTES**

- |  |   |
|--|---|
| <p>21 PAINT 100 mm WHITE LANE LINE / DET. 9</p> <p>22 INSTALL YELLOW REFLECTIVE MARKERS / DET. 26</p> <p>23 PAINT 100 mm WHITE EDGE LINE / DET. 27B</p> <p>24 PAINT 100 mm DOUBLE YELLOW / DET. 29</p> <p>25 PAINT 200 mm WHITE LANE DROP / DET. 37B</p> <p>26 PAINT 200 mm WHITE CHANNELIZING LINE / DET. 38</p> <p>27 PAINT 150 mm WHITE BIKE LANE LINE / DET. 39</p> <p>28 PAINT 150 mm WHITE BIKE LANE INTERSECTION LINE / DET. 39A</p> <p>29 PAINT 100 mm WHITE LANE LINE EXTENSION / DET. 40</p> <p>30 INSTALL "BIKE LANE" MARKING</p> | <p>31 INSTALL TYPE IV ARROW MARKING</p> <p>32 PAINT 15 m SOLID 100 mm WHITE / INSTALL TYPE G RPMs AT END POINTS</p> <p>33 PAINT 300 mm WHITE AT 45° AND 15 m SPACING</p> <p>34 INSTALL SIGN/POST OR AS SHOWN</p> <p>35 PAINT 300 mm WHITE CROSSWALK</p> <p>36 PAINT 300 mm WHITE LIMIT LINE</p> <p>37 INSTALL "SIGNAL AHEAD" MARKING</p> <p>38 PAINT 200 mm SOLID WHITE CHANNELIZING LINE/DET 38A</p> <p>39 PAINT 200 mm WHITE CHANNELIZING LINE / DET. 38A</p> |
|--|---|

NOTE: REMOVE CONFLICTING STRIPING BY SANDBLASTING

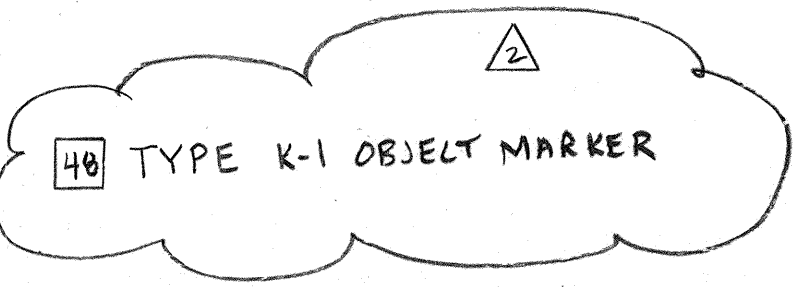

**PLAN**

1m : 500m

ALL DIMENSIONS ARE IN METERS UNLESS NOTED OTHERWISE.

ORANGE COUNTY PUBLIC FACILITIES AND RESOURCES DEPARTMENT	
<b>CROWN VALLEY PARKWAY</b>	
<b>STA 127+40 TO STA 134+20</b>	
<b>SIGN AND STRIPING PLAN</b>	
DESIGNED BY: K. NGUYEN	SHEET 9 OF 55
DRAWN BY: K. NGUYEN	CHECKED BY: G. R. PEÑA
SCALE: AS SHOWN	DATE: MAY 01, 2003
DRAWING NO. 9	

