




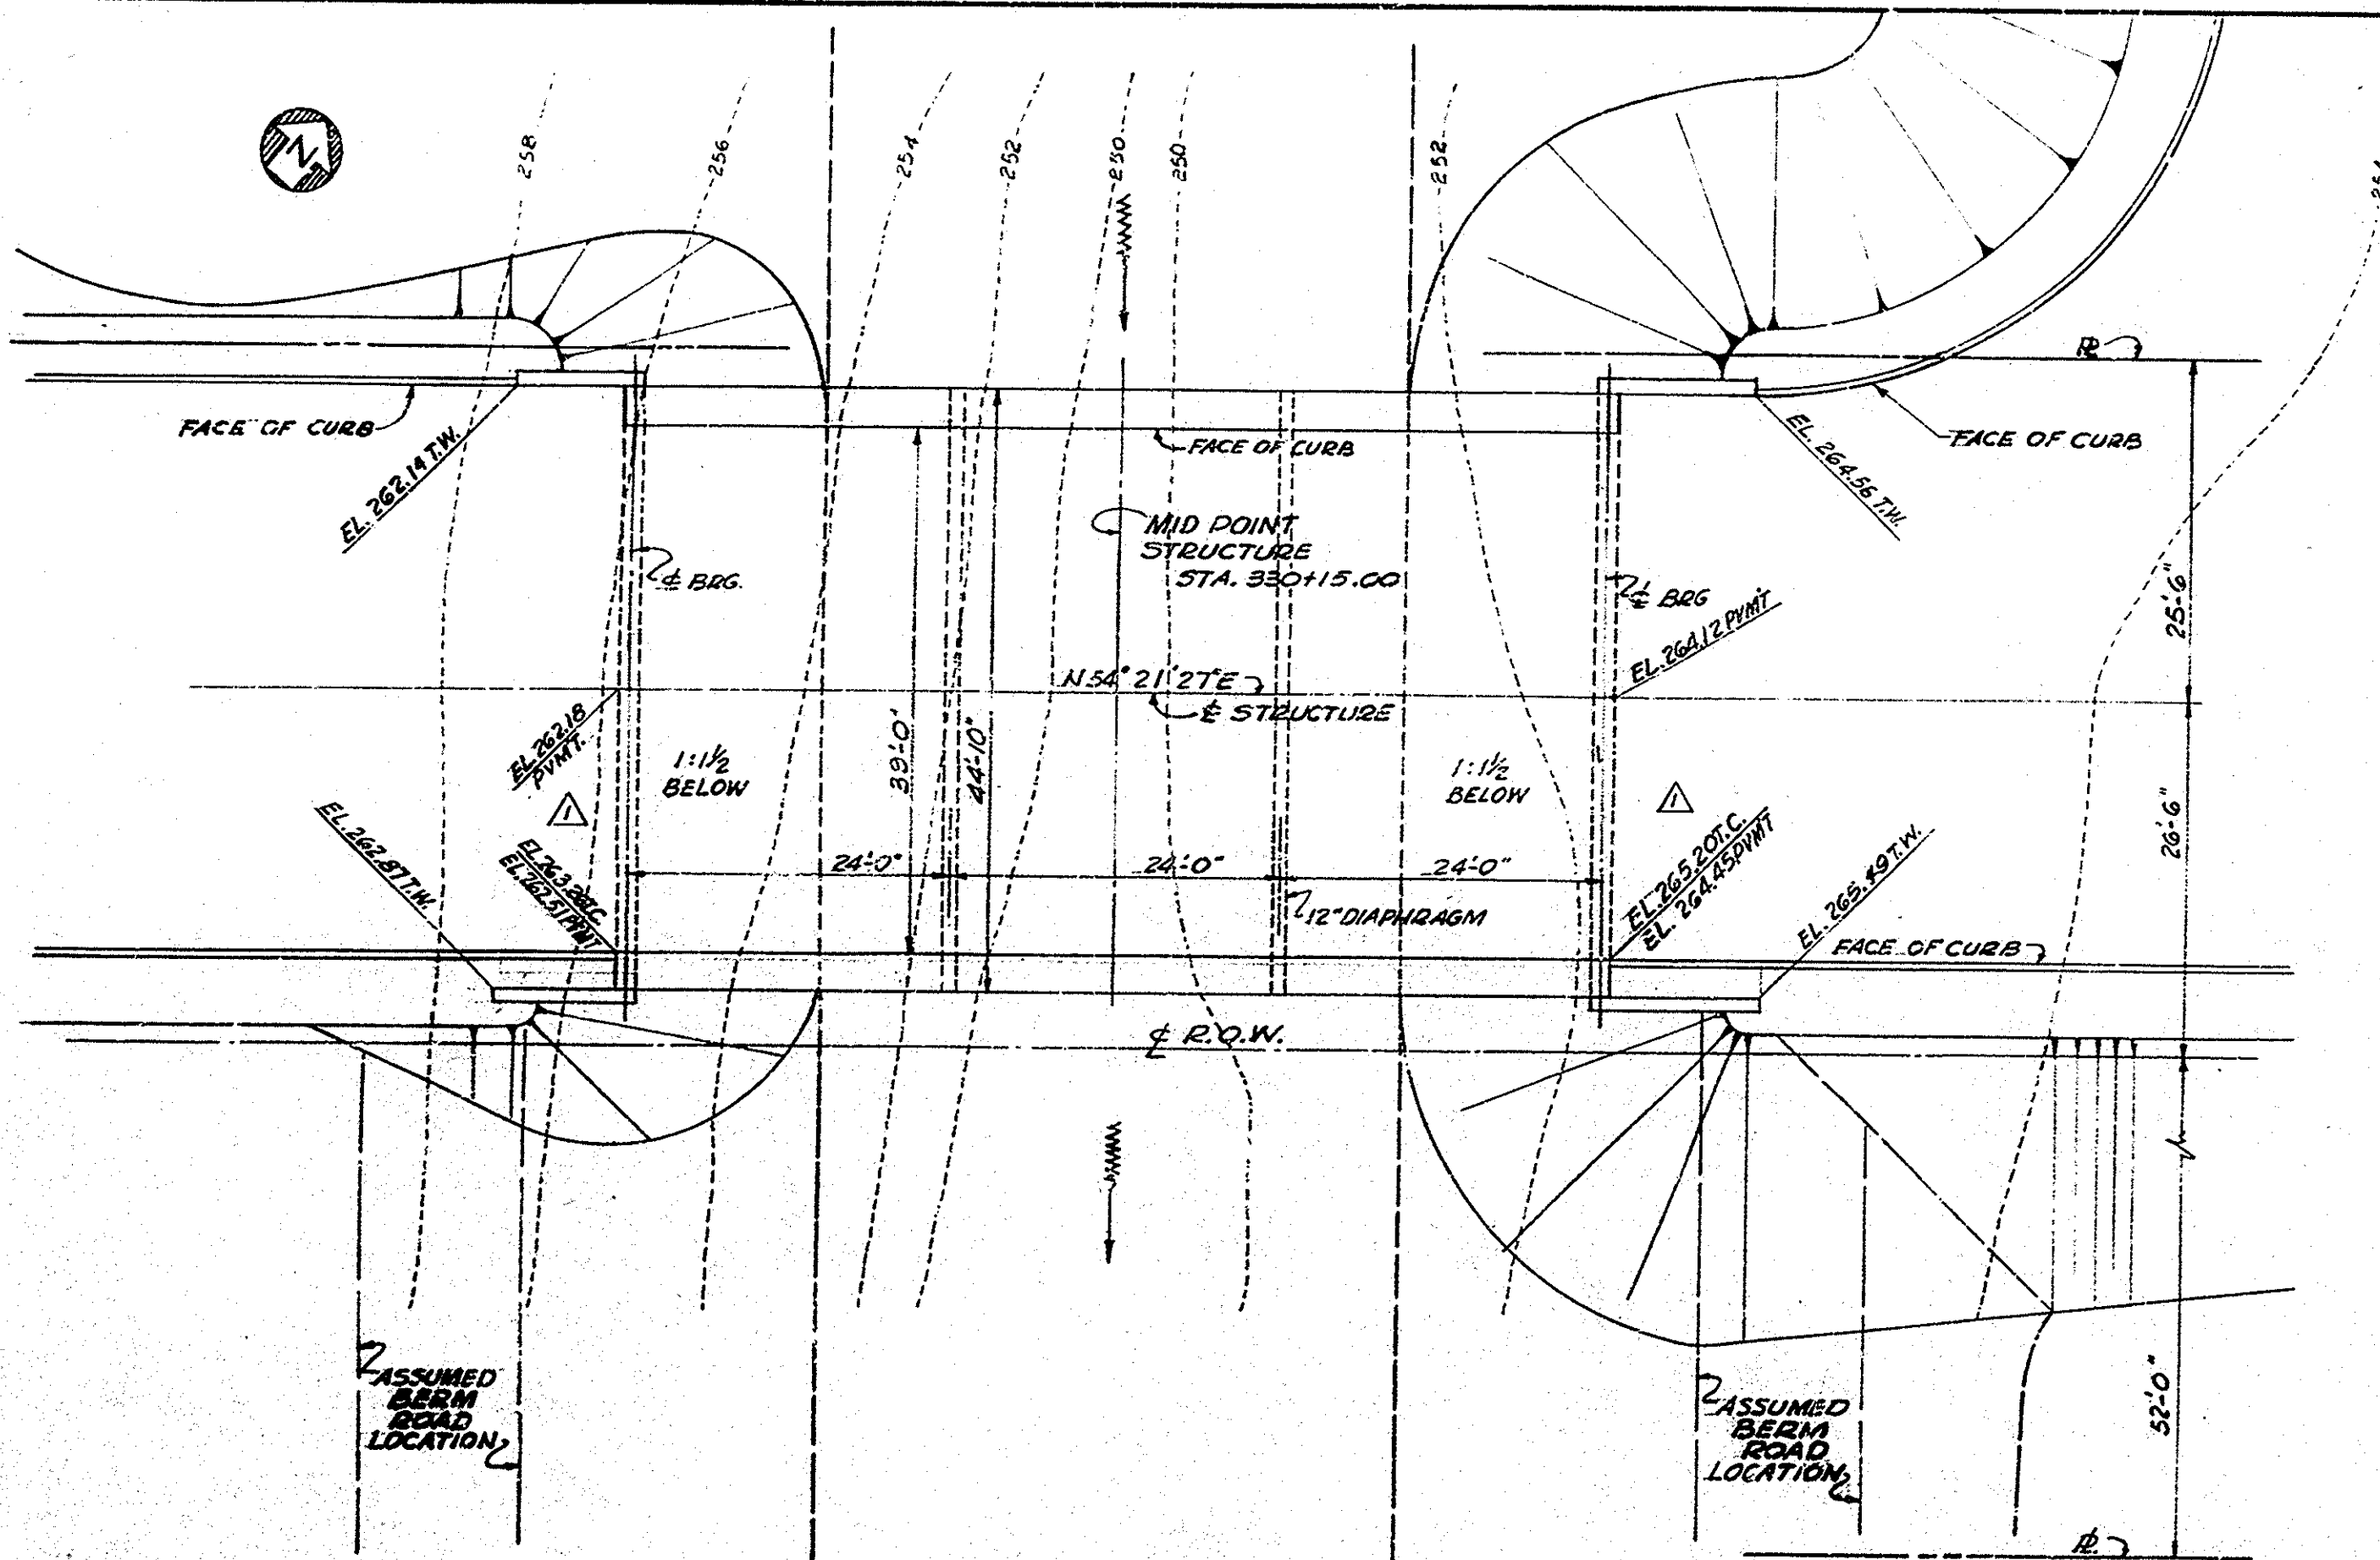


PLAN
SCALE 1/8" = 1'-0"

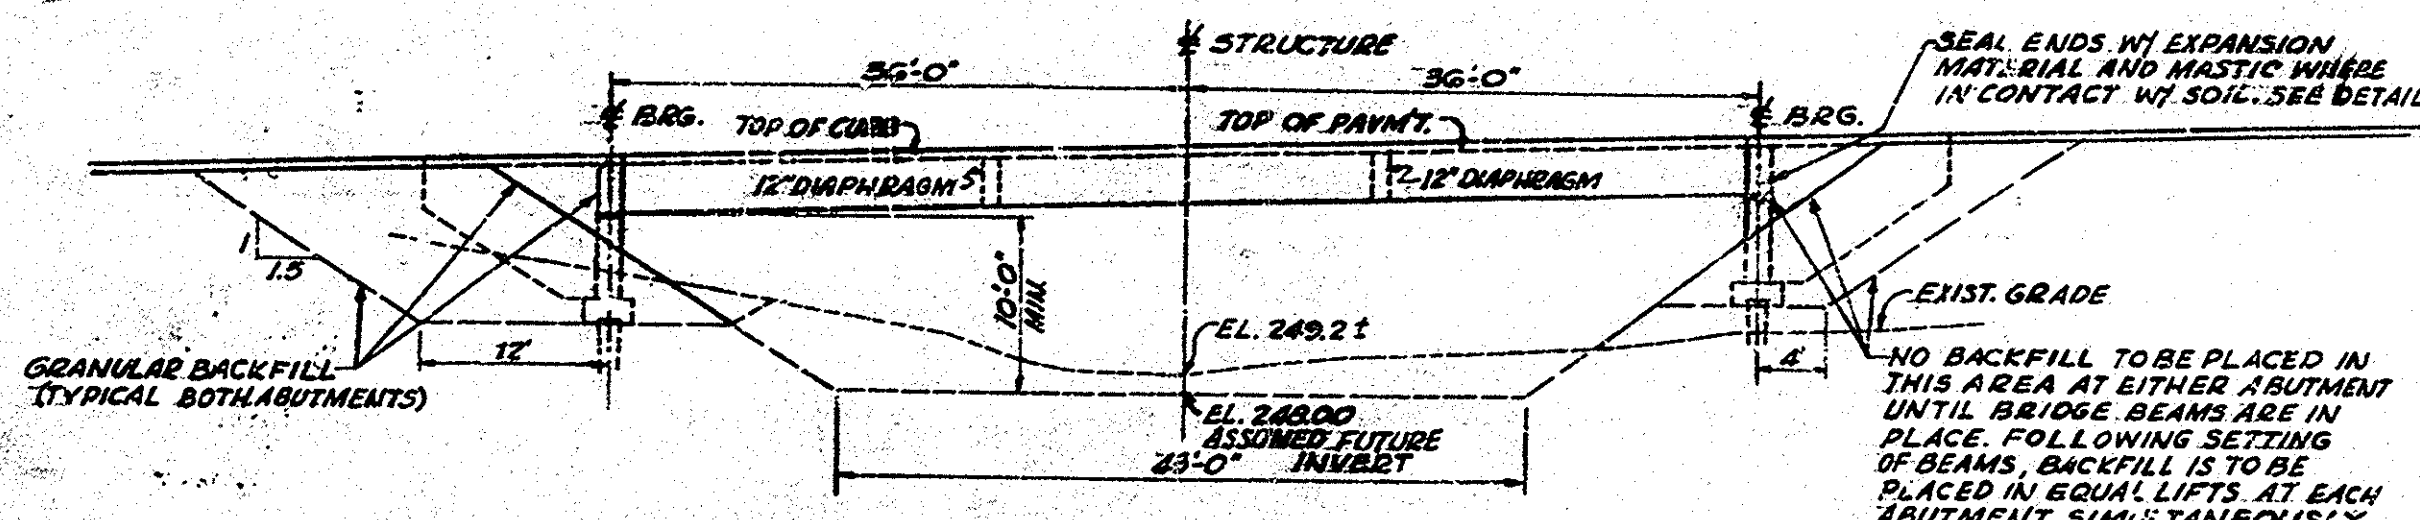


ELEVATION
SCALE 1/8" = 1'-0"

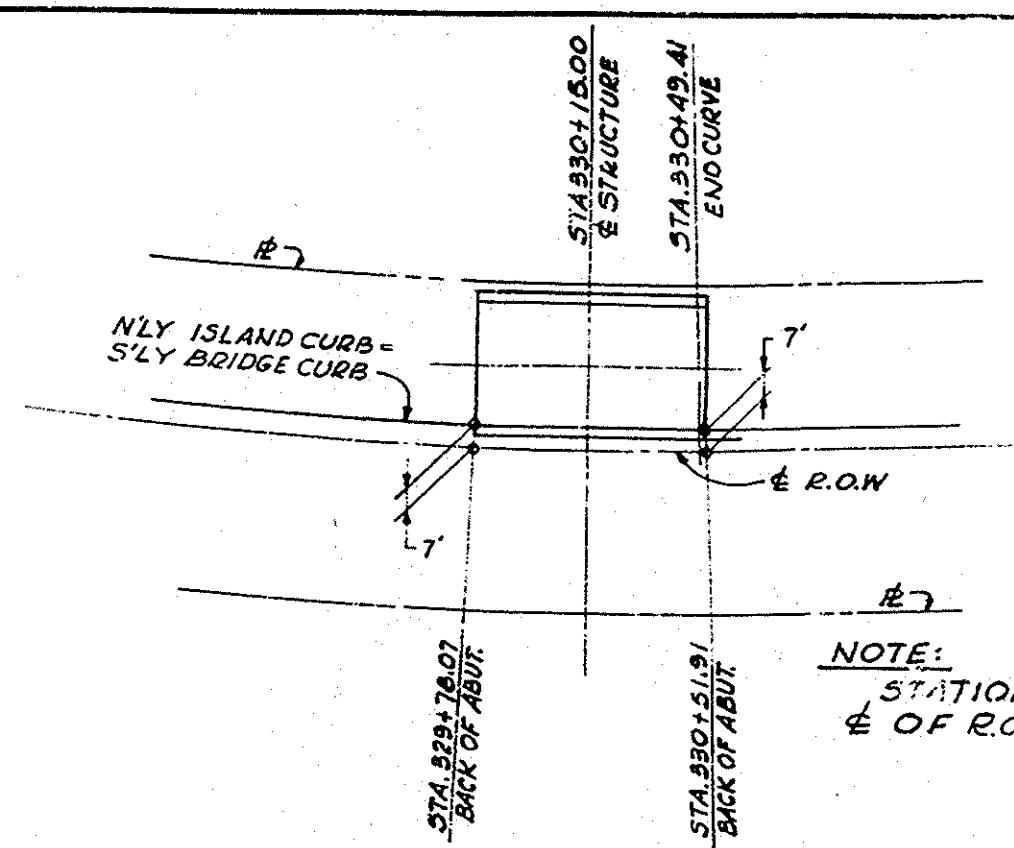

STRUCTURE LOCATION PLAN
SCALE 1" = 40'-0"

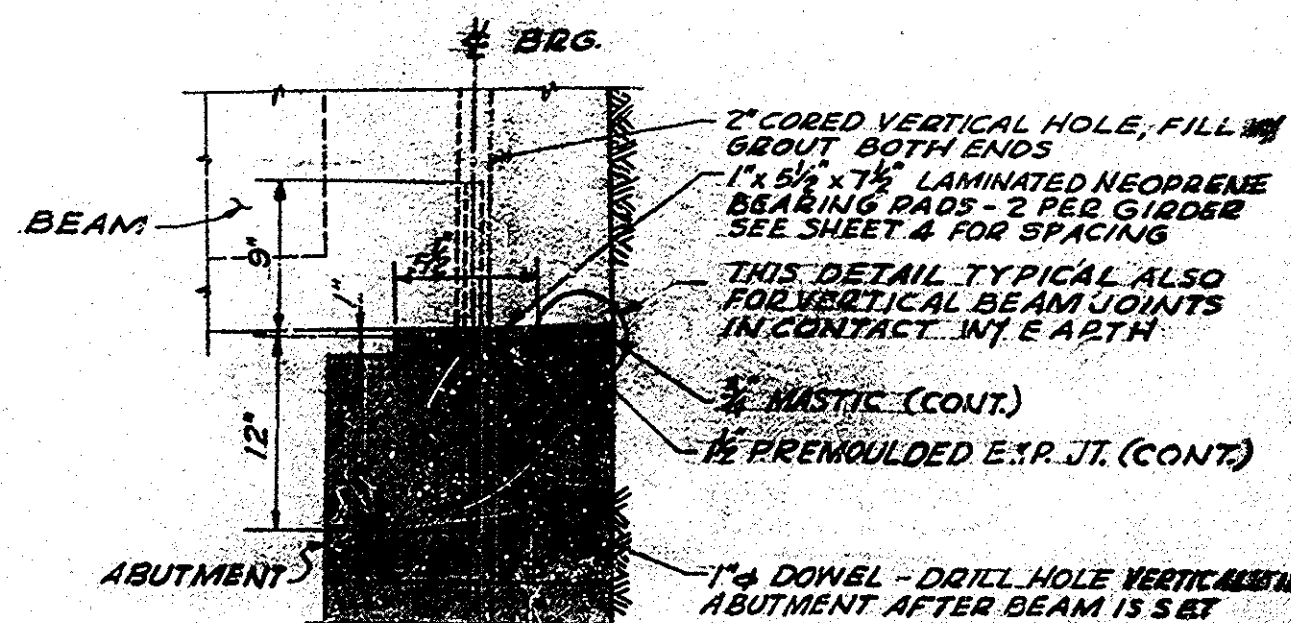

SECTION OF END BRG.
SCALE 1/2" = 1'-0"

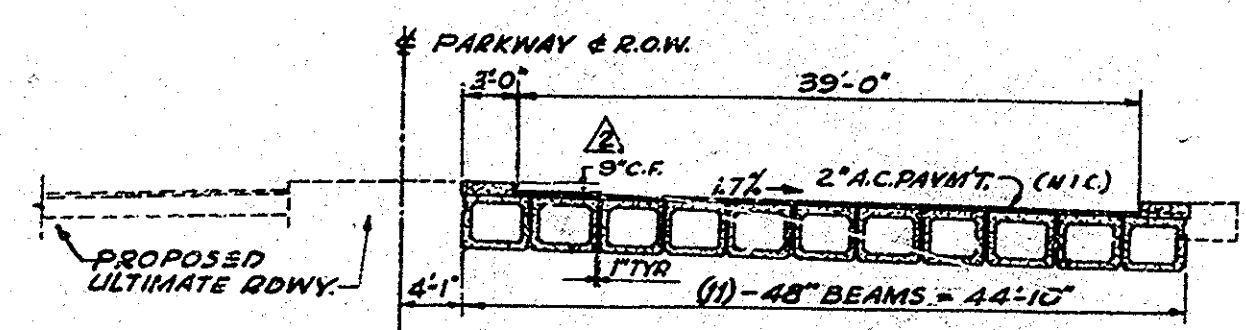

TRANSVERSE SECTION
SCALE 1/8" = 1'-0"

APPROVED BY: *[Signature]* DATE *May 3, 1963*
A.S. KOCH
ORANGE COUNTY SURVEYOR &
ROAD COMMISSIONER

DATE 3/25/63	BY 368	CHANGE T.C. ELEV.
BY 7645	ABC	CHANGE CURB HEIGHT
	NYC	

CROWN VALLEY PARKWAY
OSO CREEK BRIDGE
GENERAL PLAN & SECTIONS

ENGINEERING - SCIENCE, INC.
ENGINEERS AND CONSULTANTS
150 EAST FOOTHILL BOULEVARD
ARCADIA, CALIFORNIA
ELIOTT 9-9381

OSO Creek Bridge Over Crown Valley Parkway

#14536 - OC-3 - 1963
CROWN VALLEY PARKWAY SSC-281
OVER OSO CREEK Thru 922-A2