




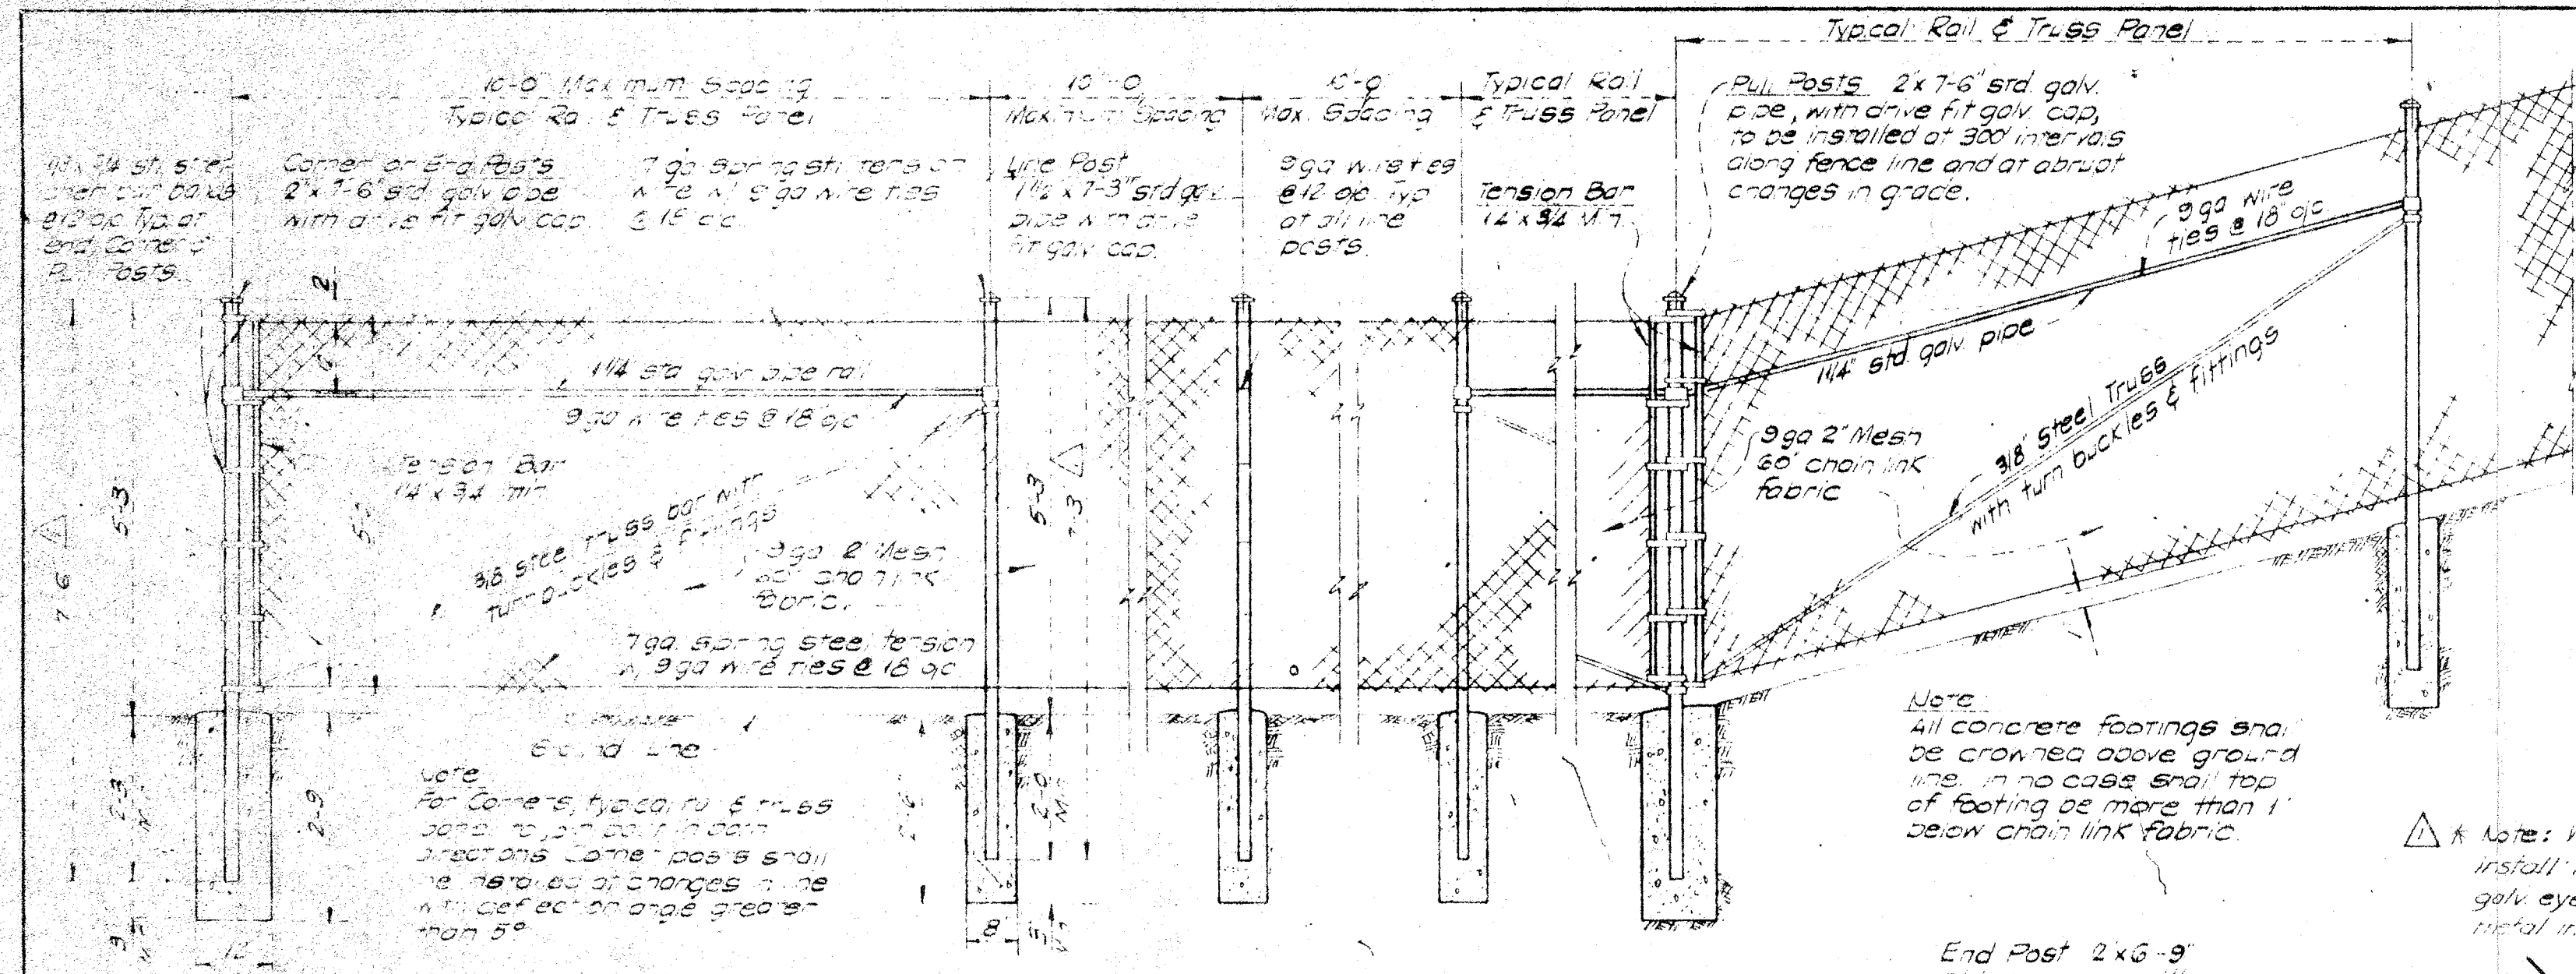


**TYPICAL FENCE ELEVATION
TYPE I CHAIN LINK
RIGHT OF WAY FENCE
SCALE 1/2"=1'-0"**

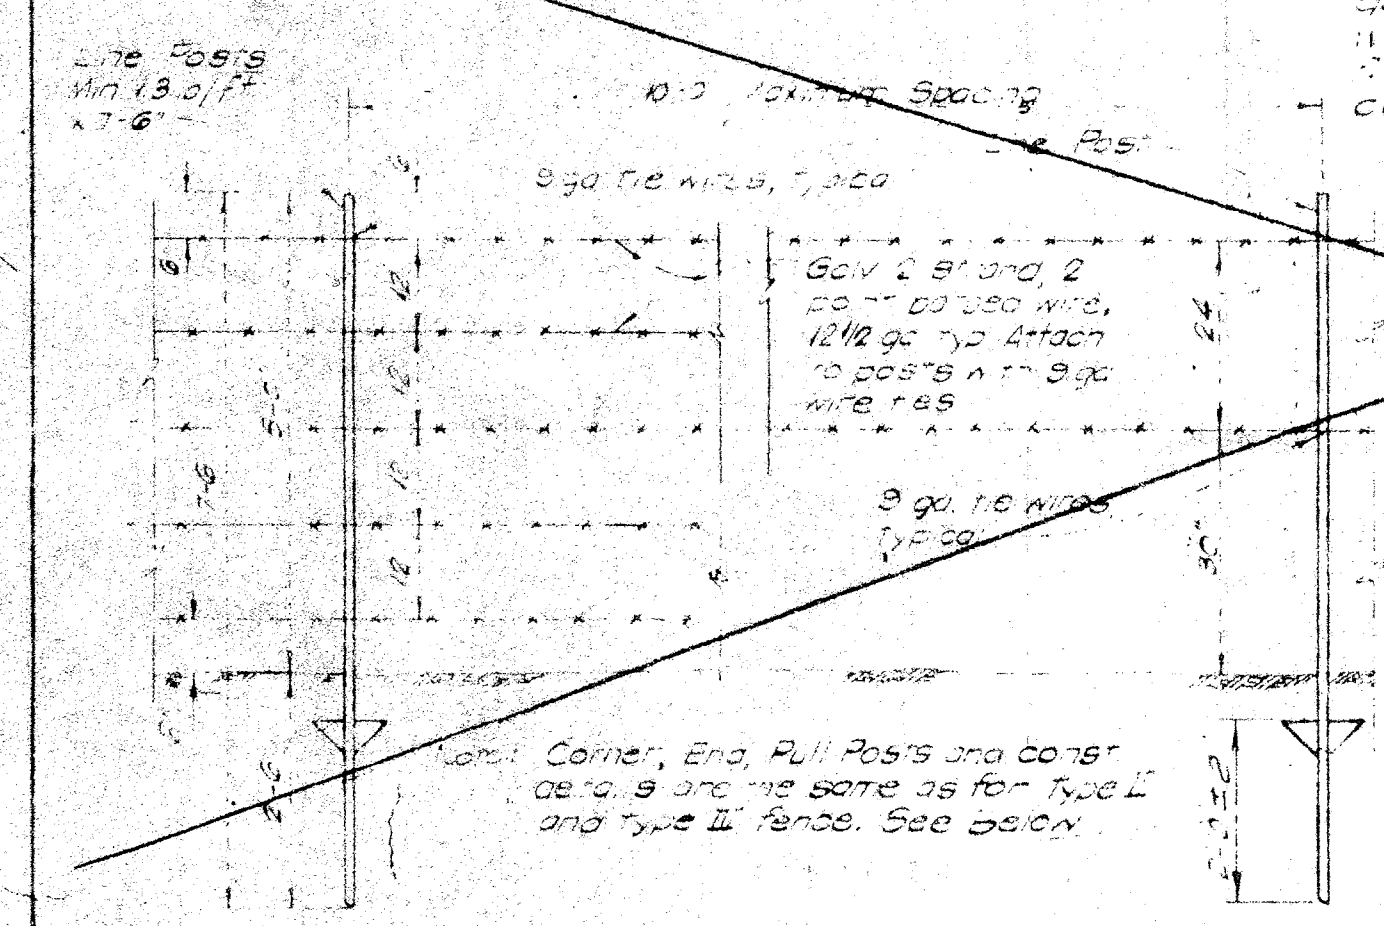


**TYPICAL FENCE ELEVATION
BARBED WIRE FENCING
SCALE 1/2"=1'-0"**

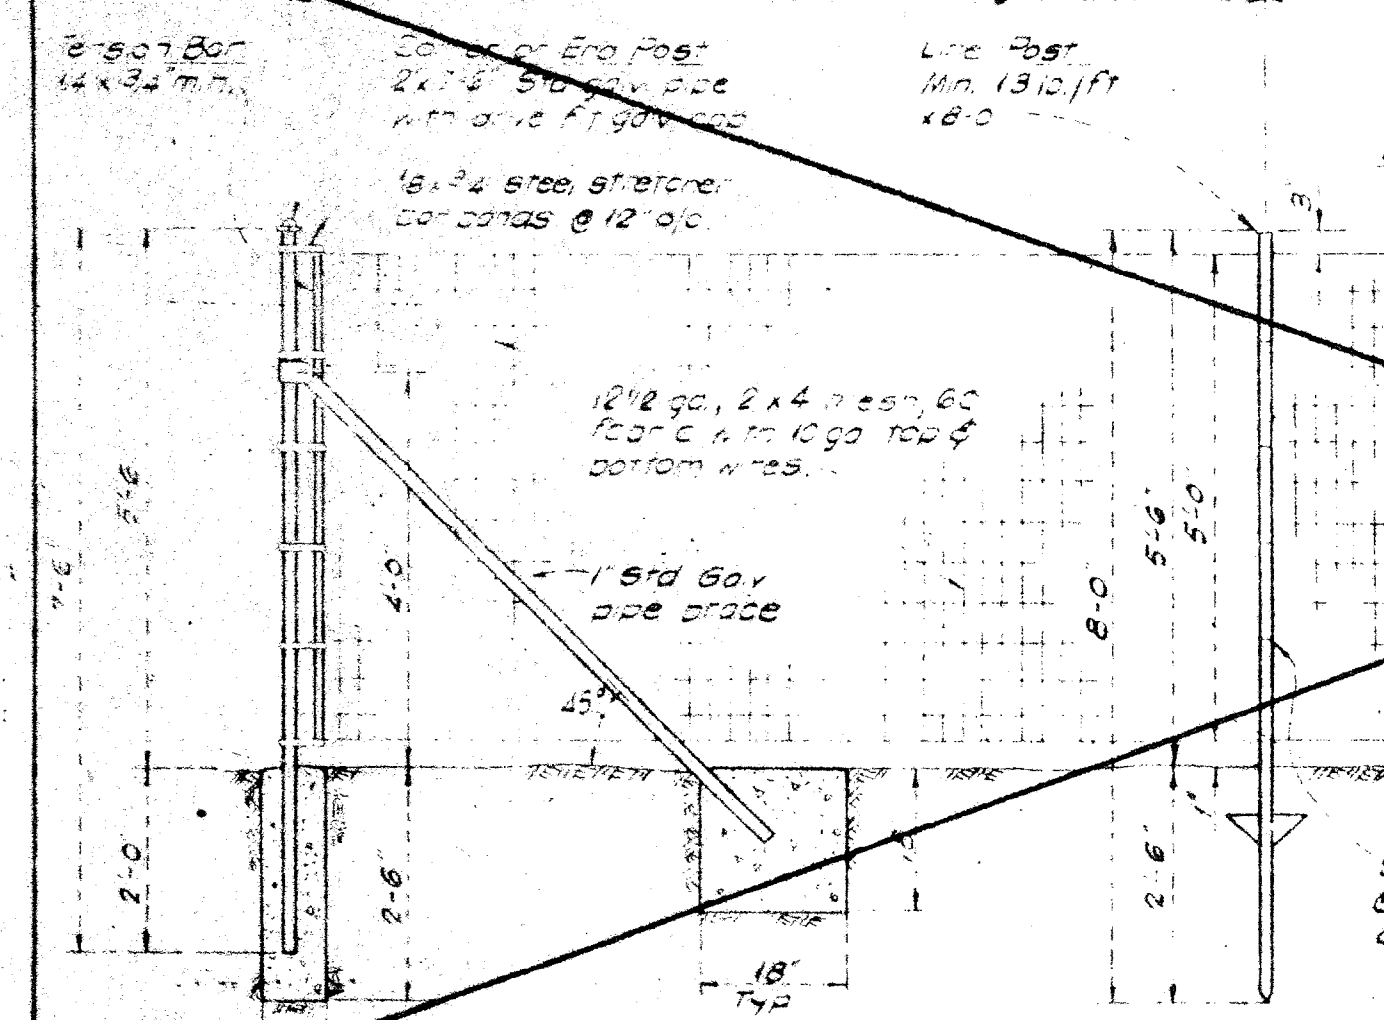

**TYPE II
2"X4" MESH FENCE**

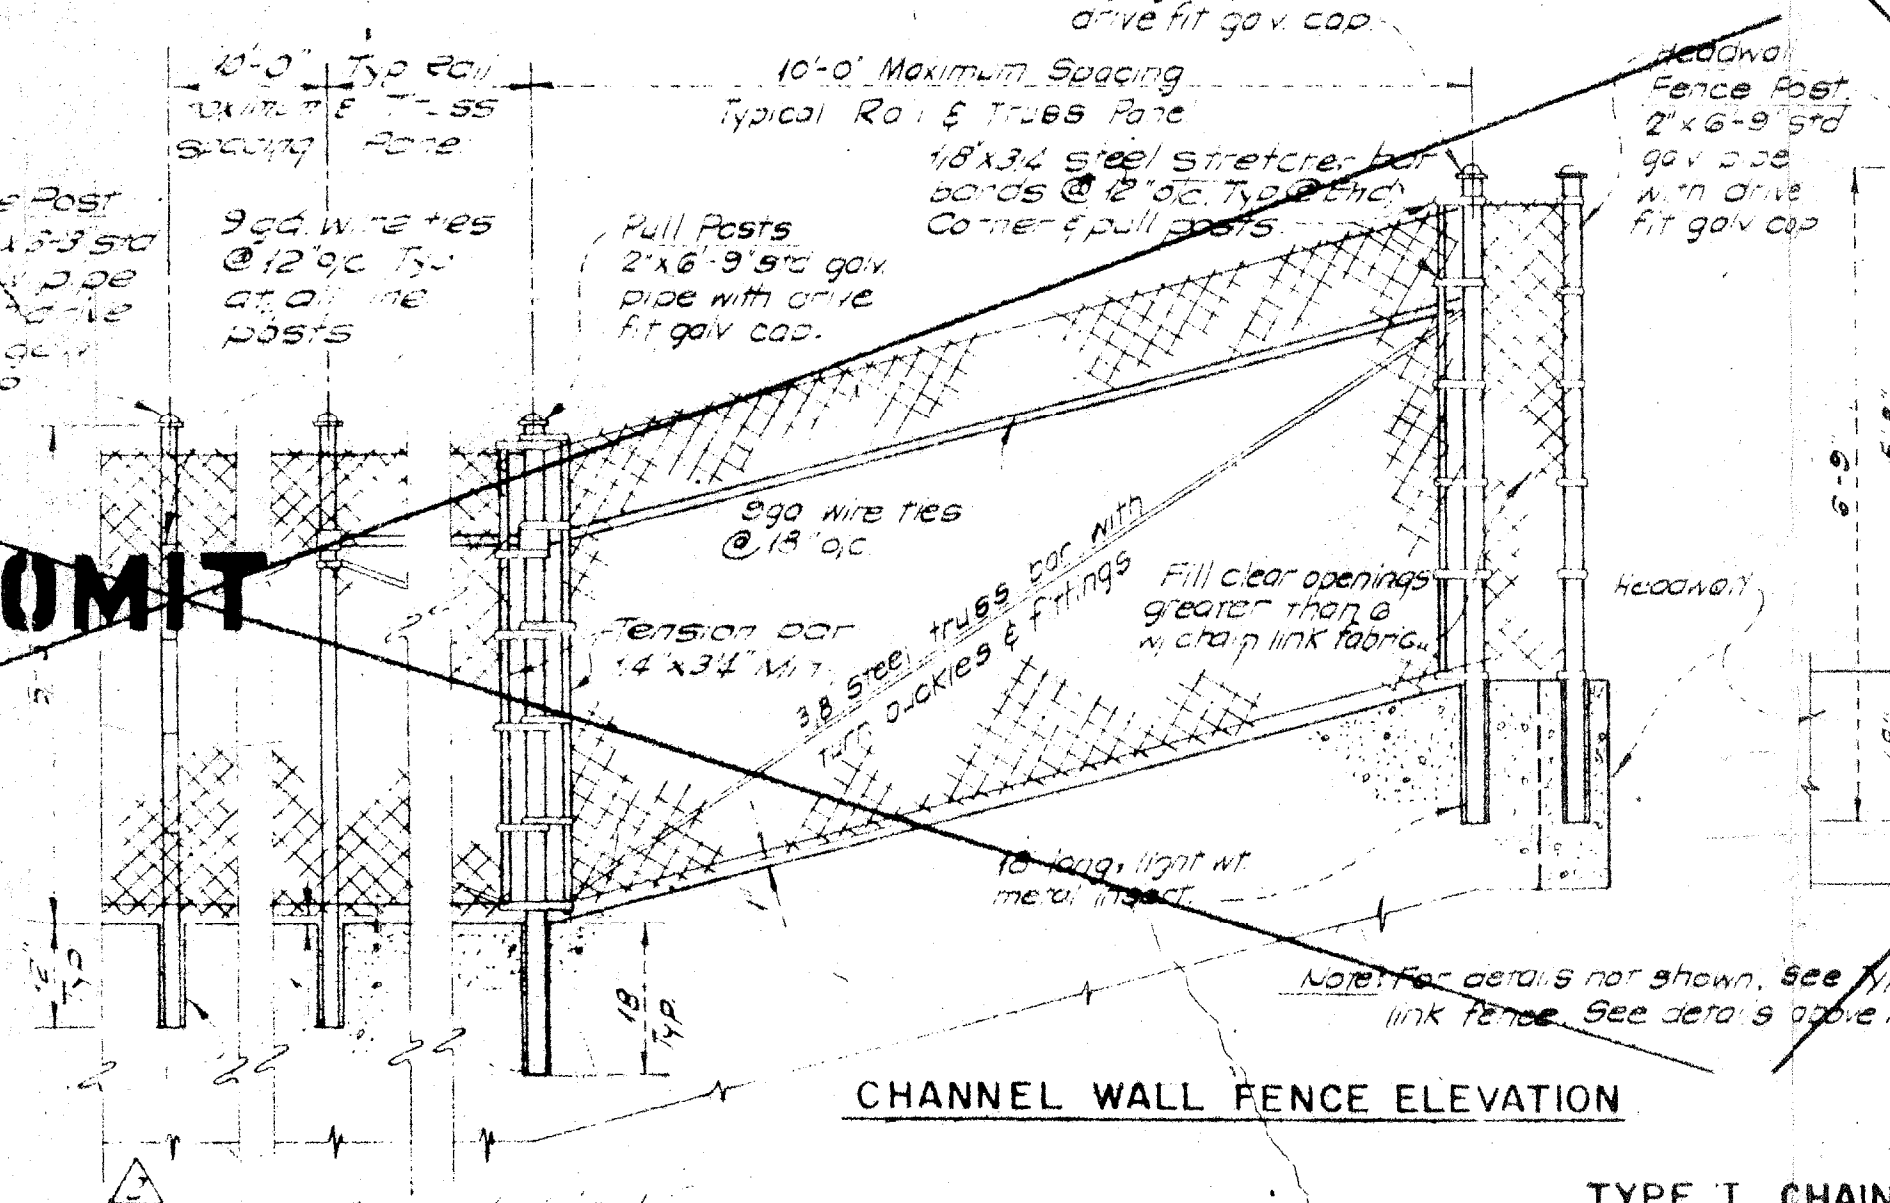


CHANNEL WALL FENCE ELEVATION

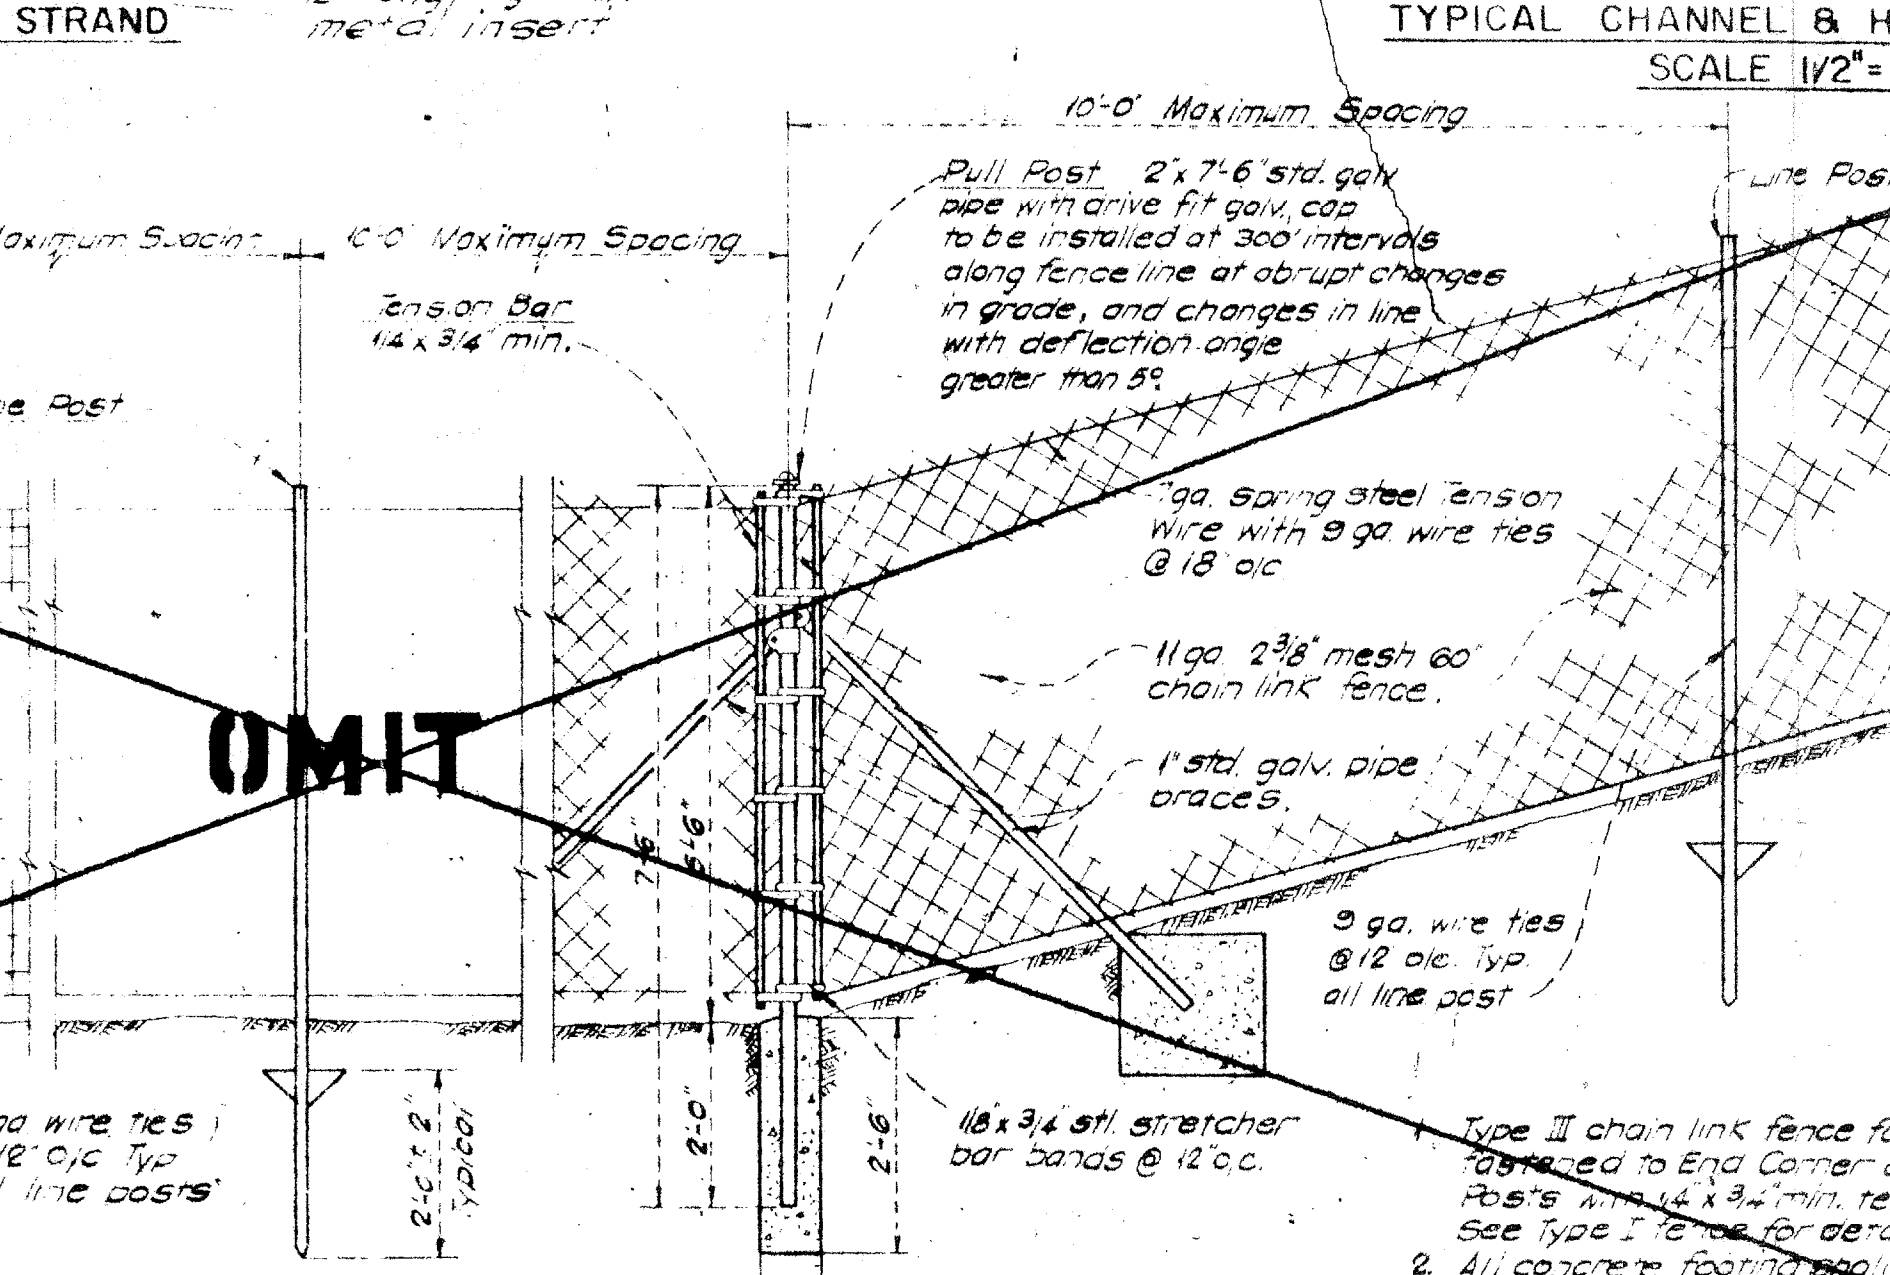


**TYPE I CHAIN LINK
TYPICAL CHANNEL & HEADWALL FENCE
SCALE 1/2"=1'-0"**

**TYPICAL FENCE ELEVATION
SCALE 1/2"=1'-0"**


**TYPE III
CHAIN LINK FENCE**

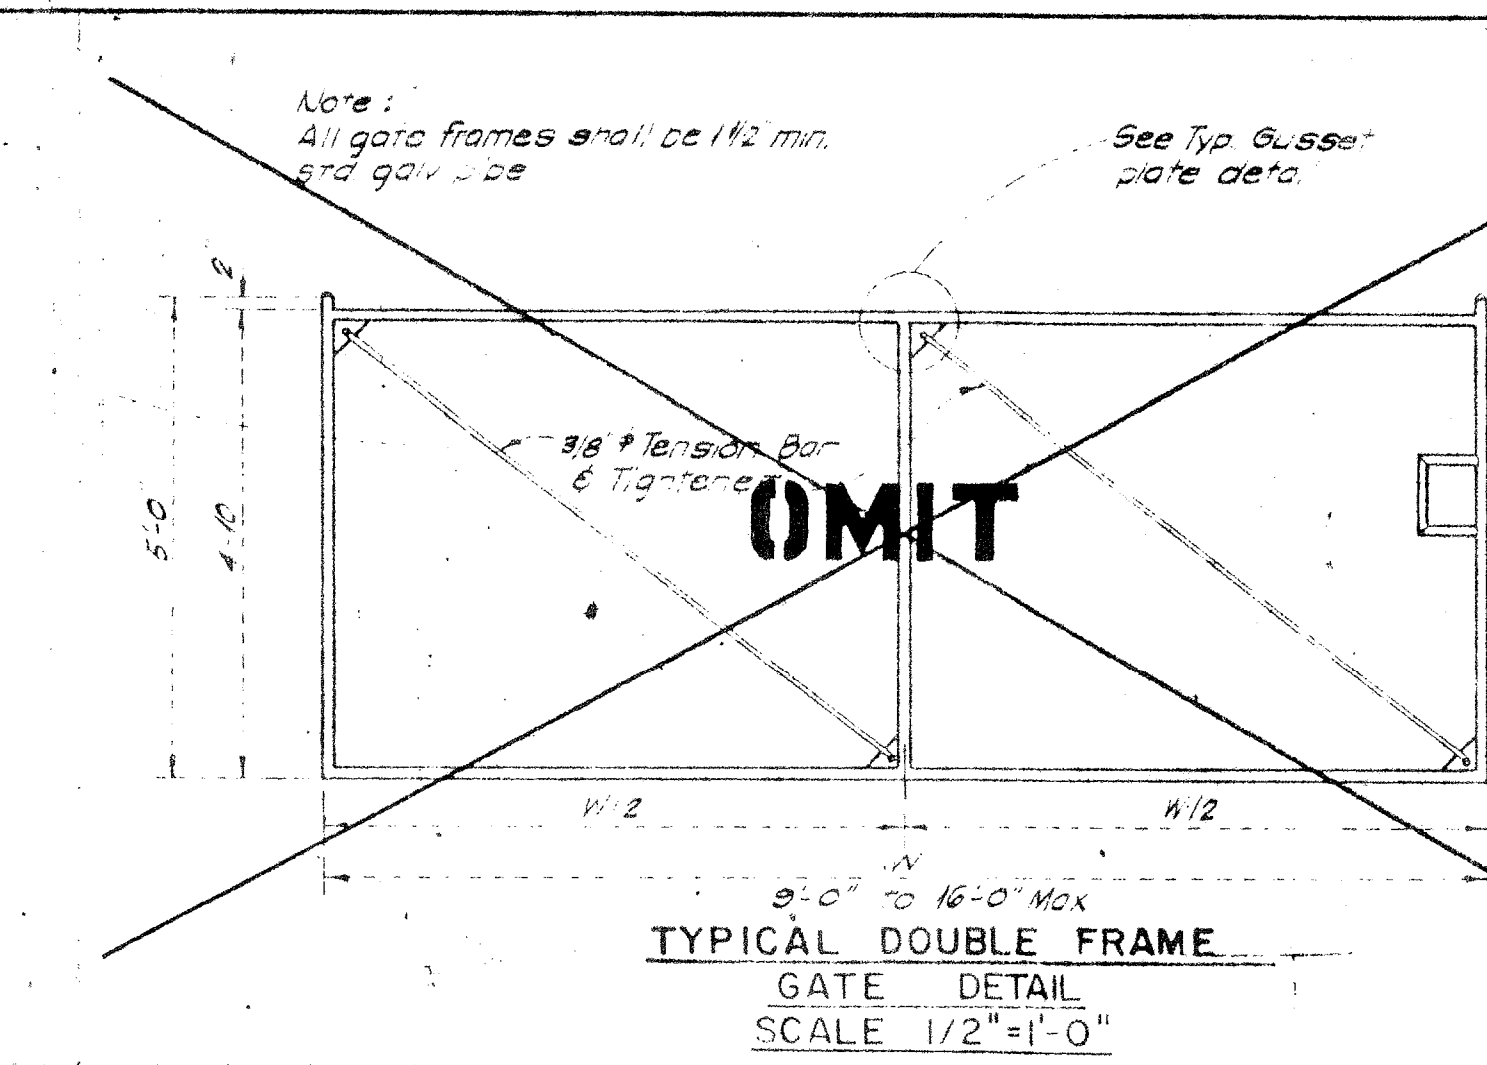


**TYPICAL DOUBLE FRAME
GATE DETAIL
SCALE 1/2"=1'-0"**

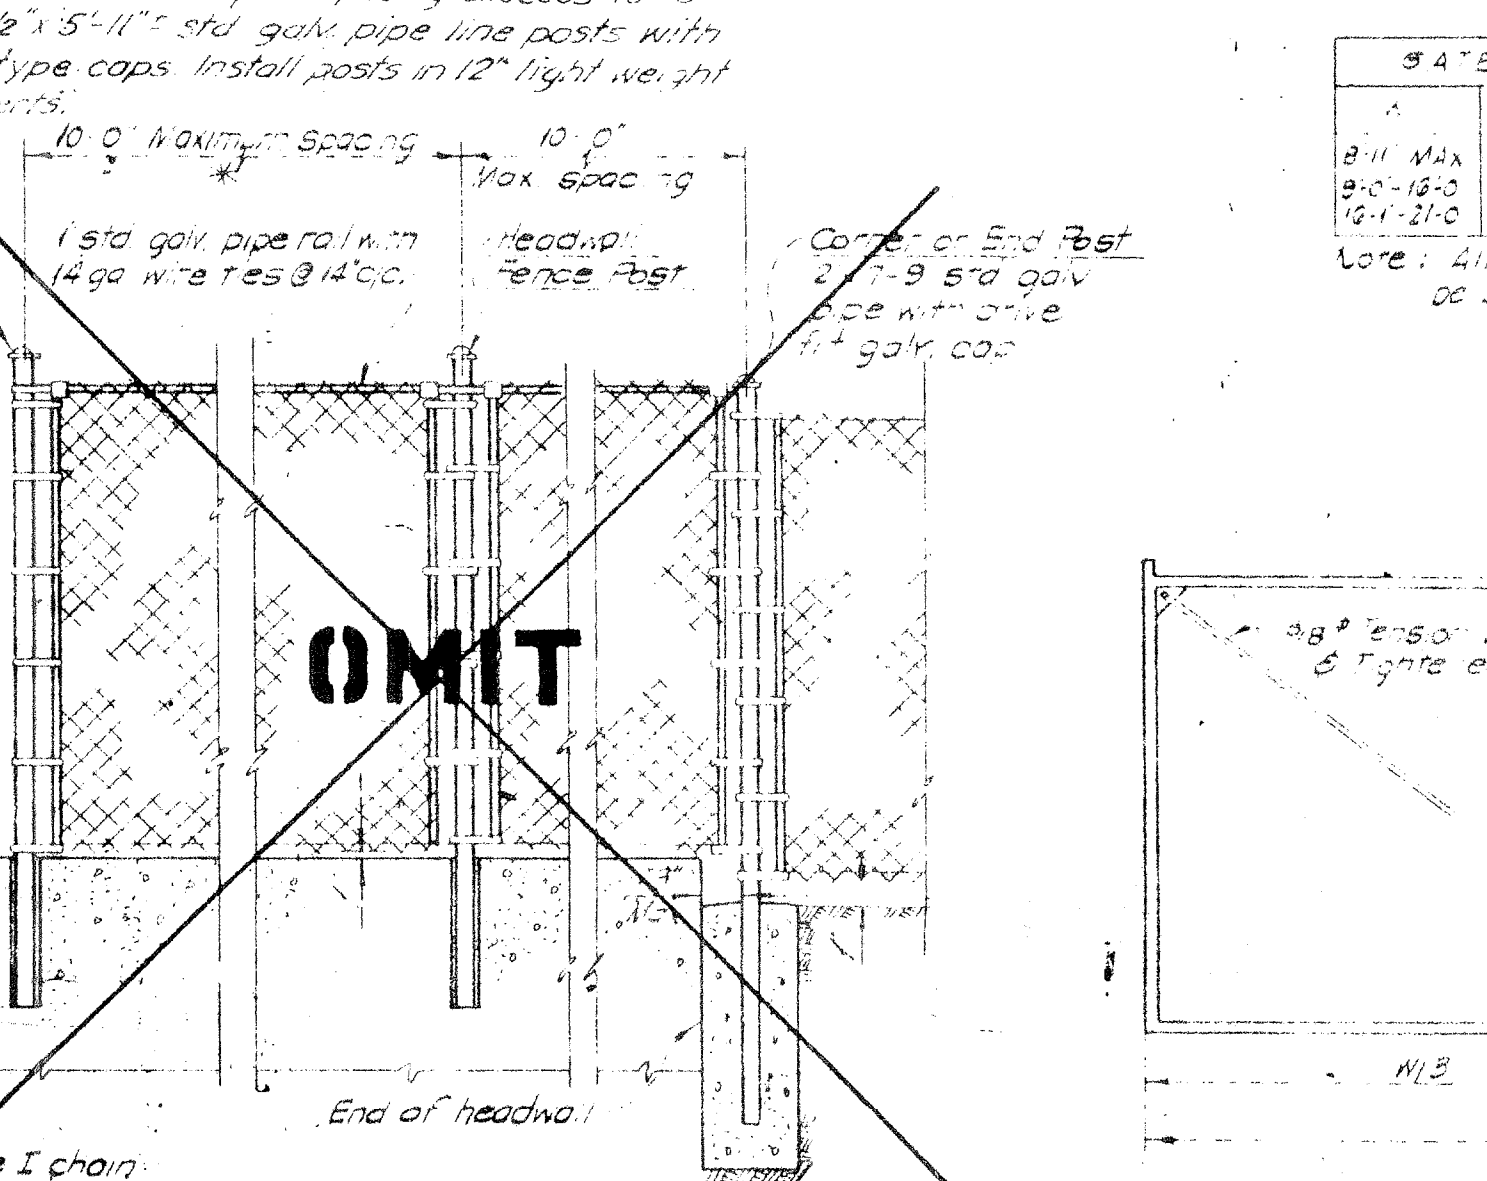


HEADWALL FENCE ELEVATION

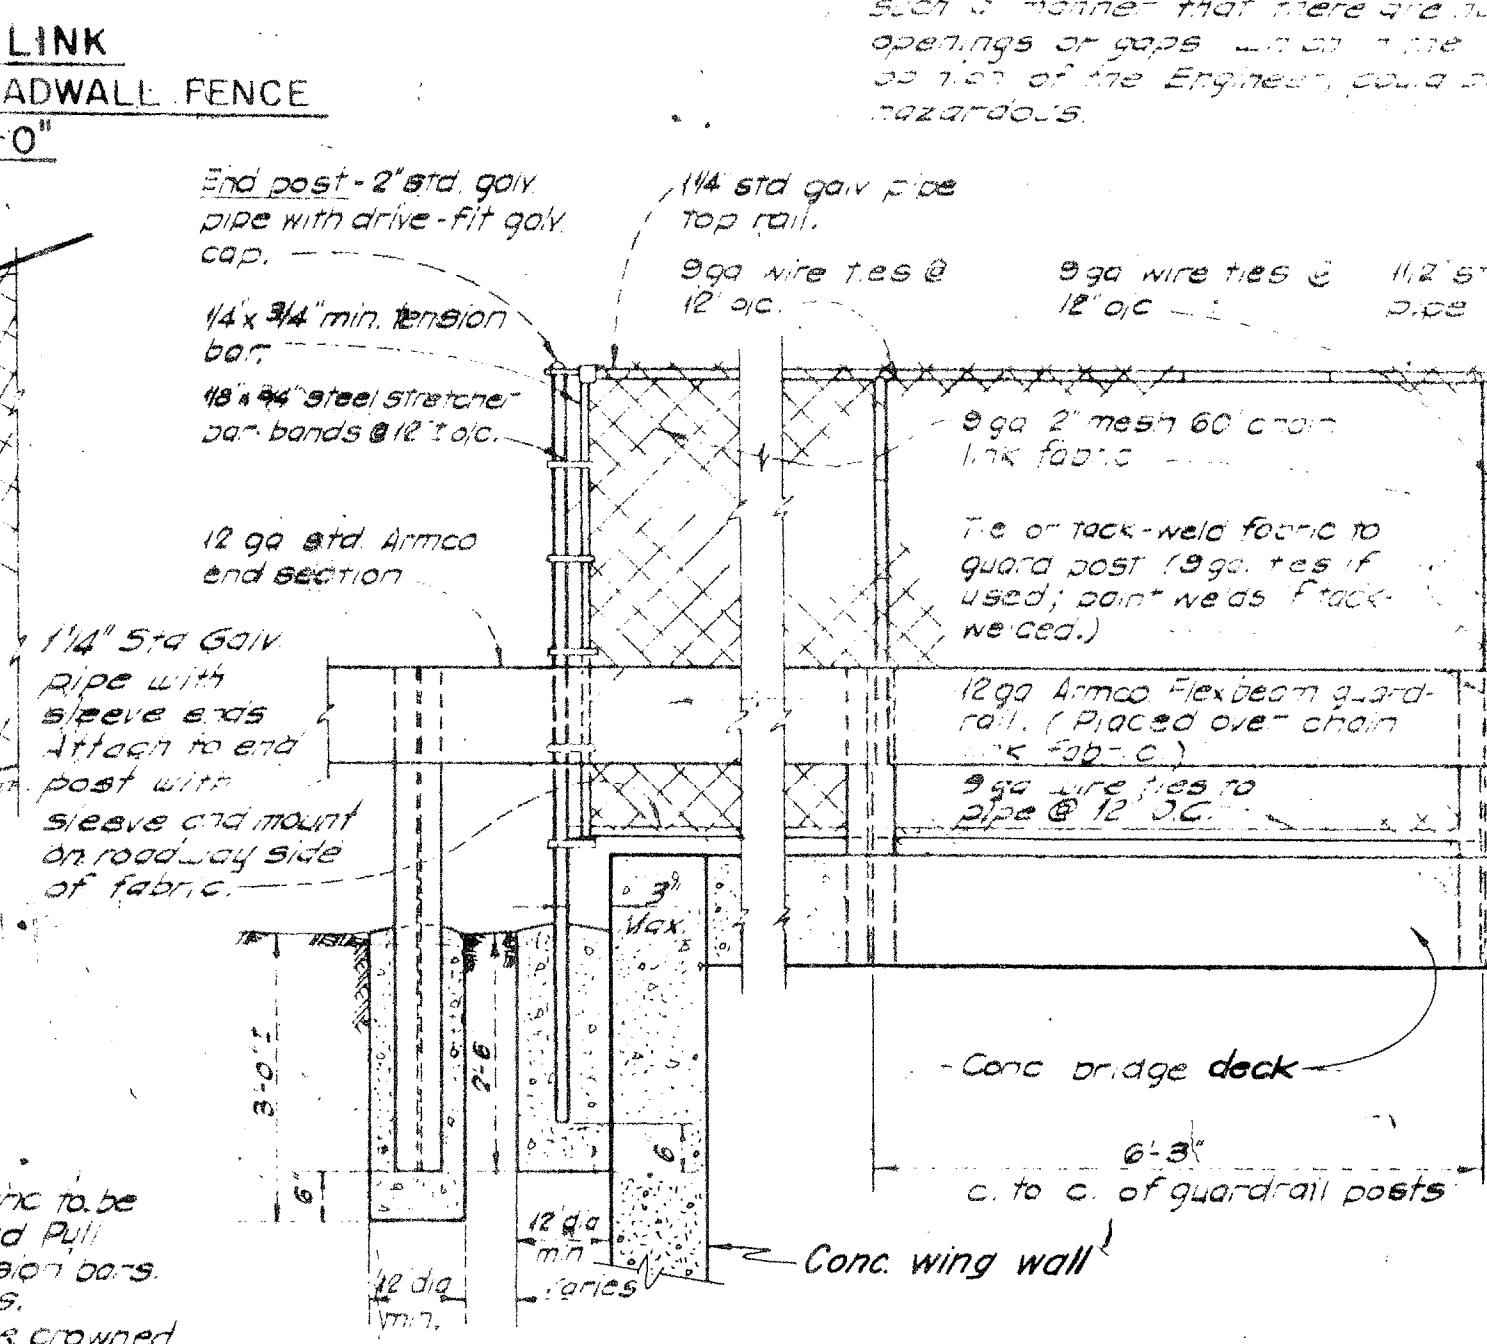


**BRIDGE GUARDRAIL AND FENCE
SCALE 1/2"=1'-0"**

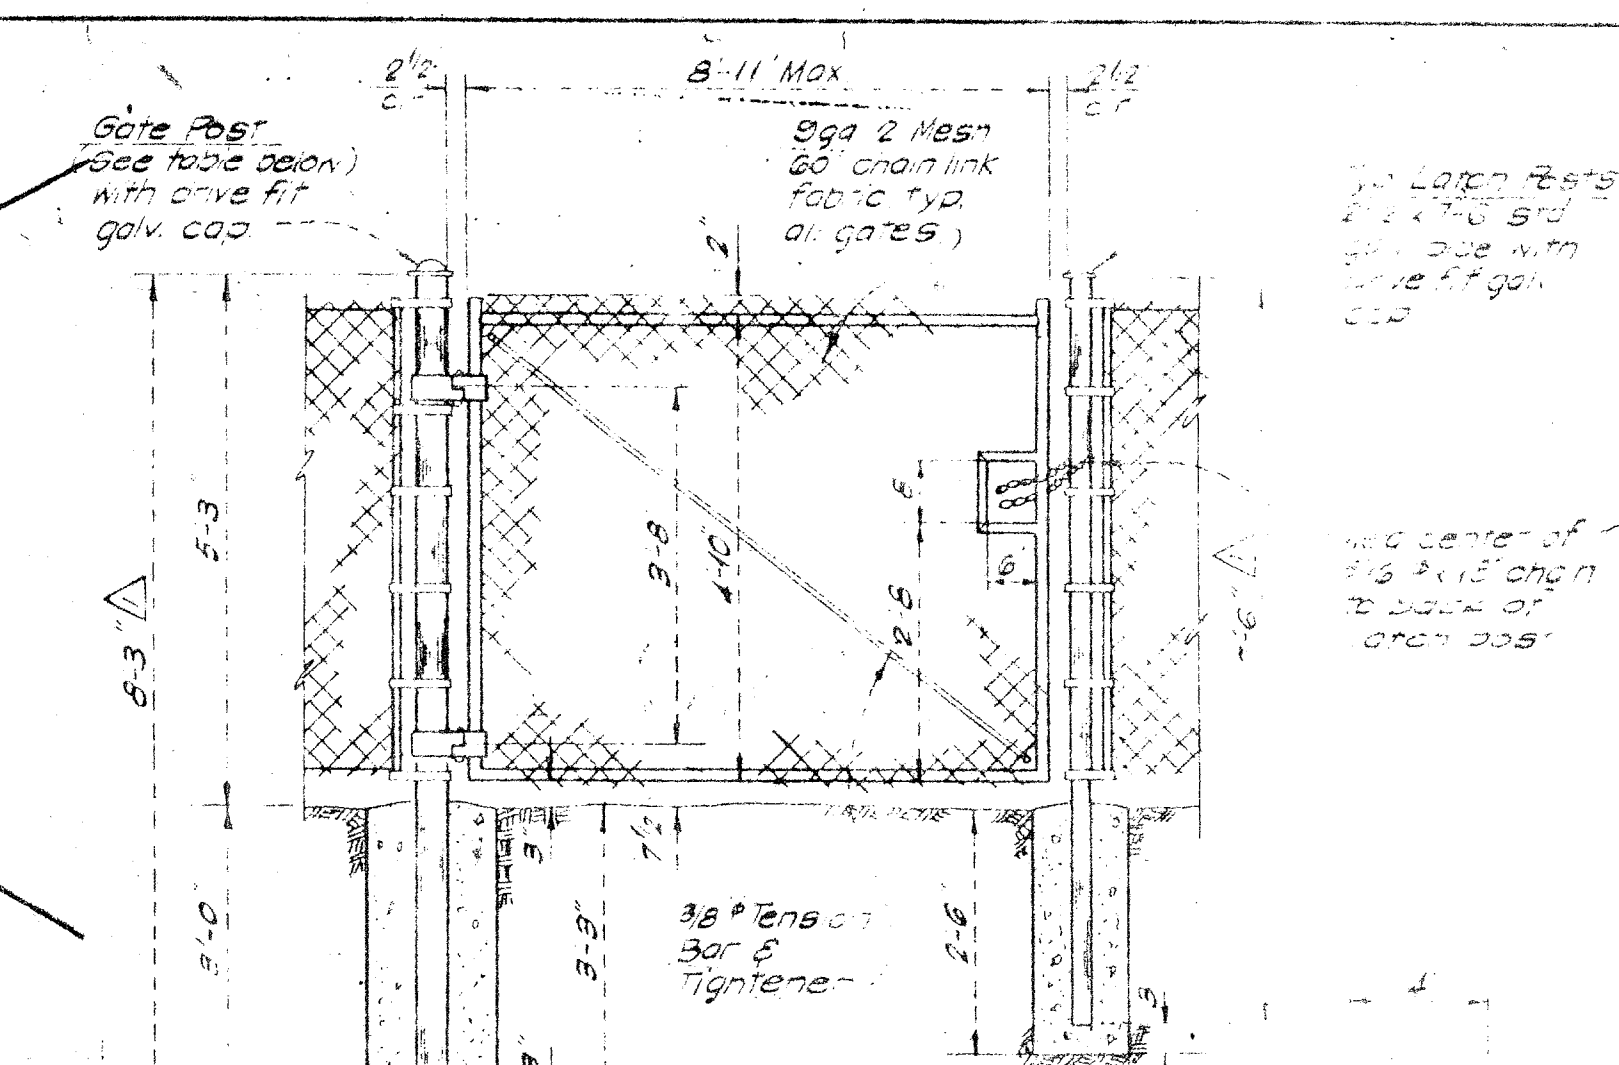

**TYPICAL SINGLE FRAME GATE
AND GATE POST DETAIL
SCALE 1/2"=1'-0"**

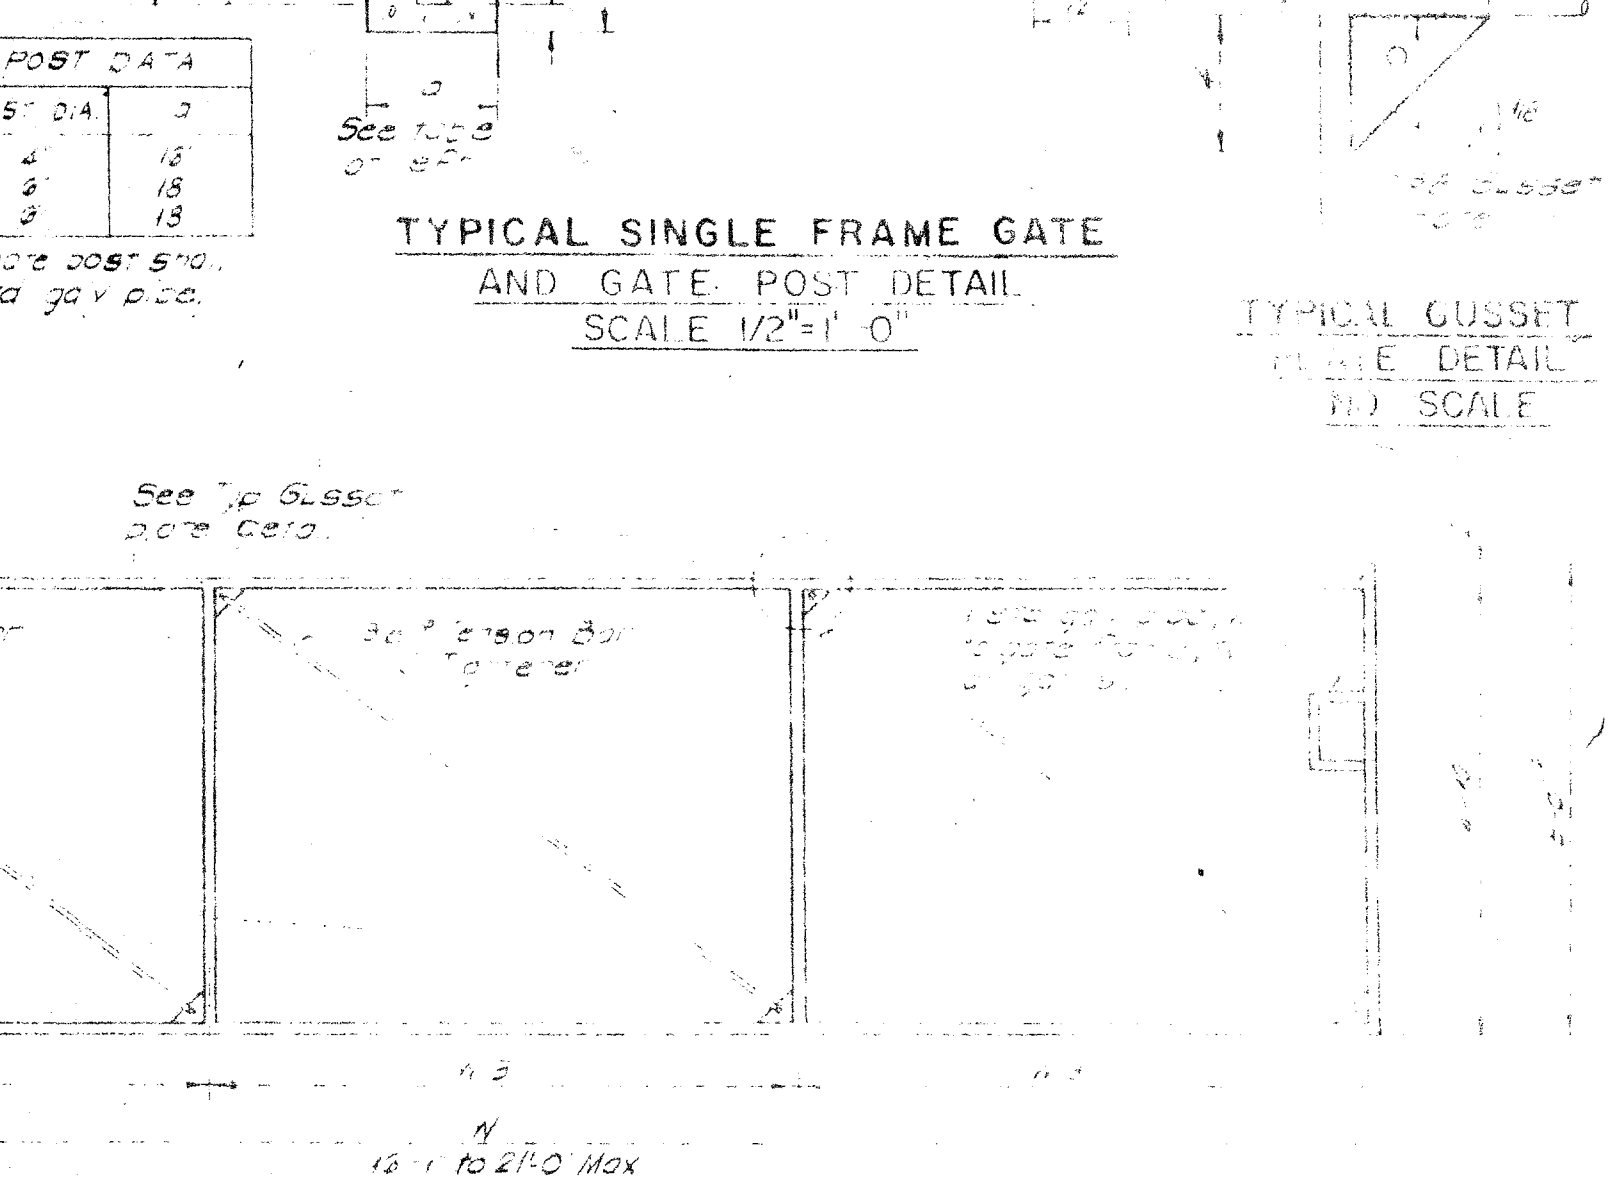

**TYPICAL TRIPLE FRAME
GATE DETAIL
SCALE 1/2"=1'-0"**

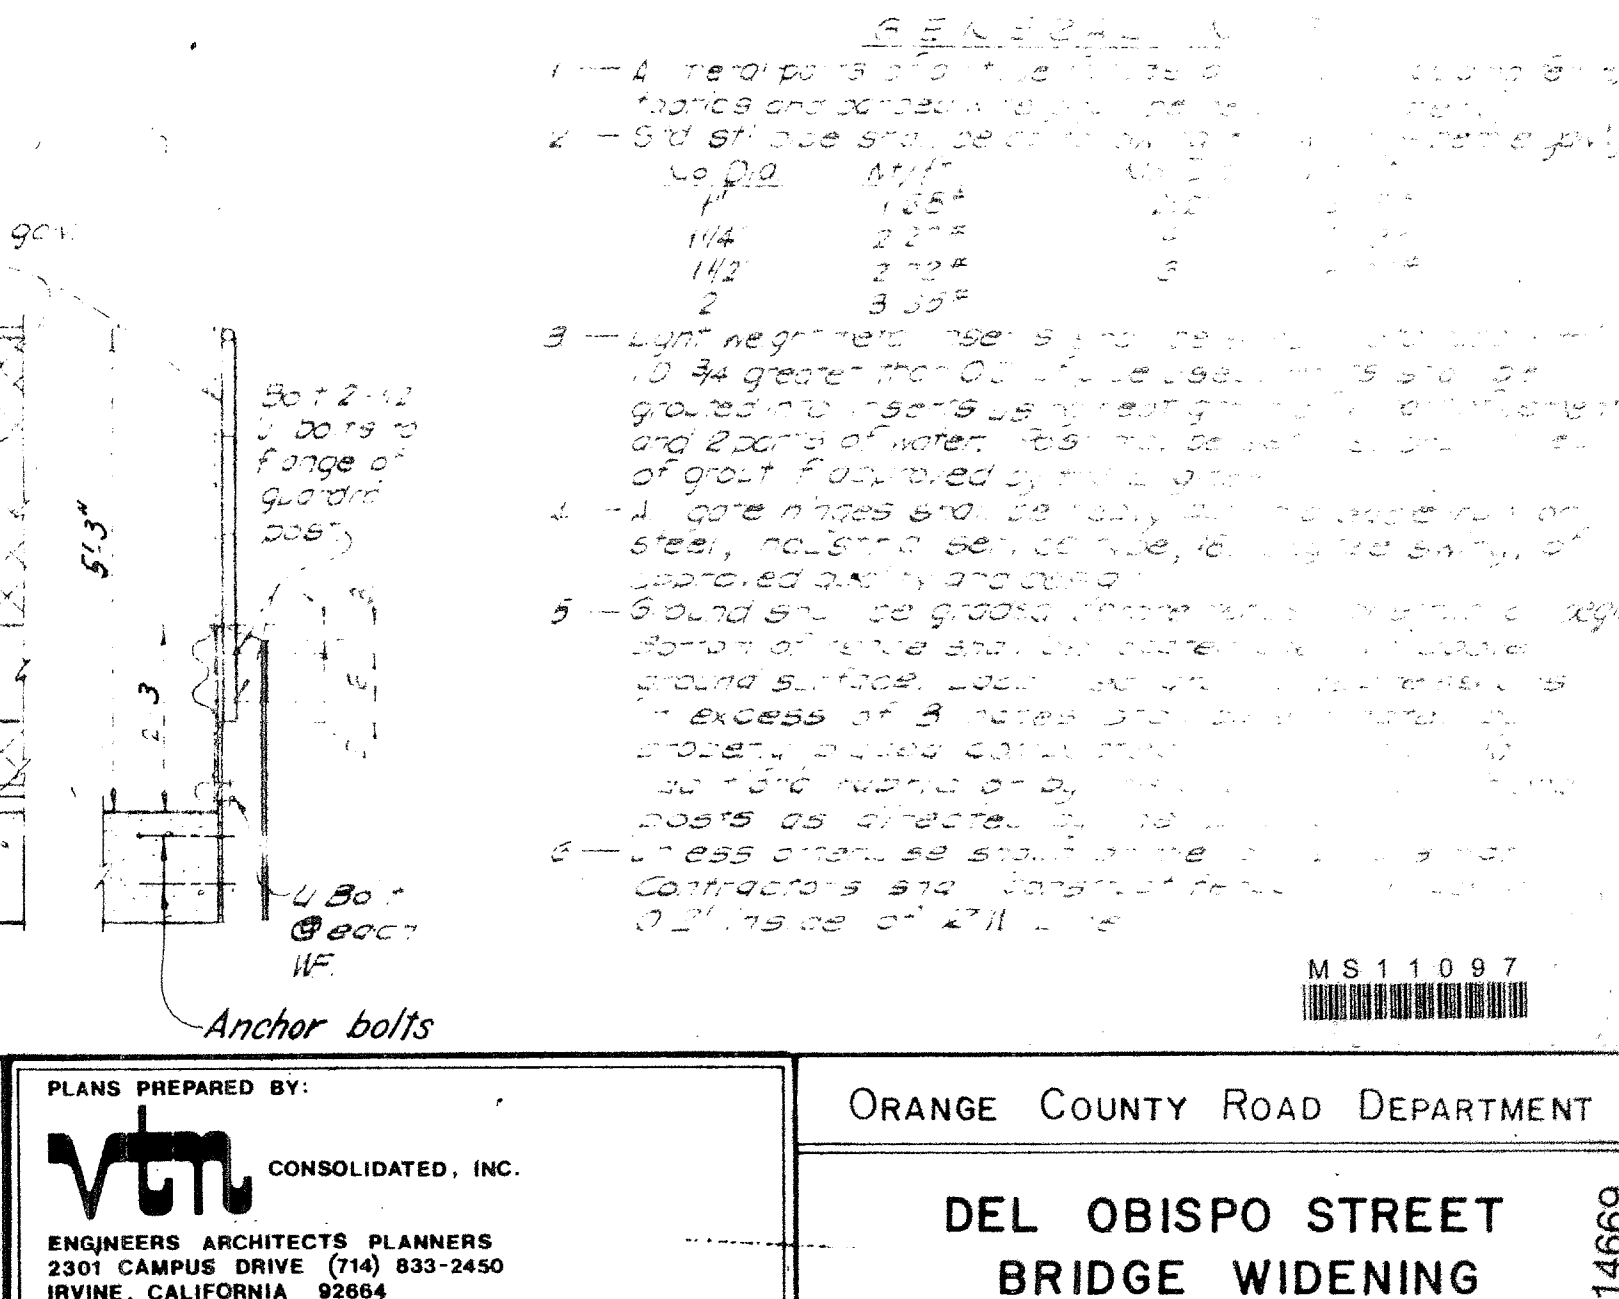

**TYPICAL GUSSET
SCALE 1/2"=1'-0"**

PLANS PREPARED BY:
VTC CONSOLIDATED, INC.
ENGINEERS ARCHITECTS PLANNERS
2301 CAMPUS DRIVE (714) 833-2450
IRVINE, CALIFORNIA 92614

PROJECT MANAGER M.Z. Foroutan
DESIGNED BY M.Z.F.
DRAWN BY *[Signature]* CHK. BY *[Signature]*
APPROVED *[Signature]* REG. NO. 21328
DATE 1975 JOB NO. 238-43

ORANGE COUNTY ROAD DEPARTMENT

**DEL OBISPO STREET
BRIDGE WIDENING
OVER TRABUCO CREEK**


TYPICAL FENCE & GATE DETS.

scale sheet 12 of 13

MS11097


014669

M 98-13-12

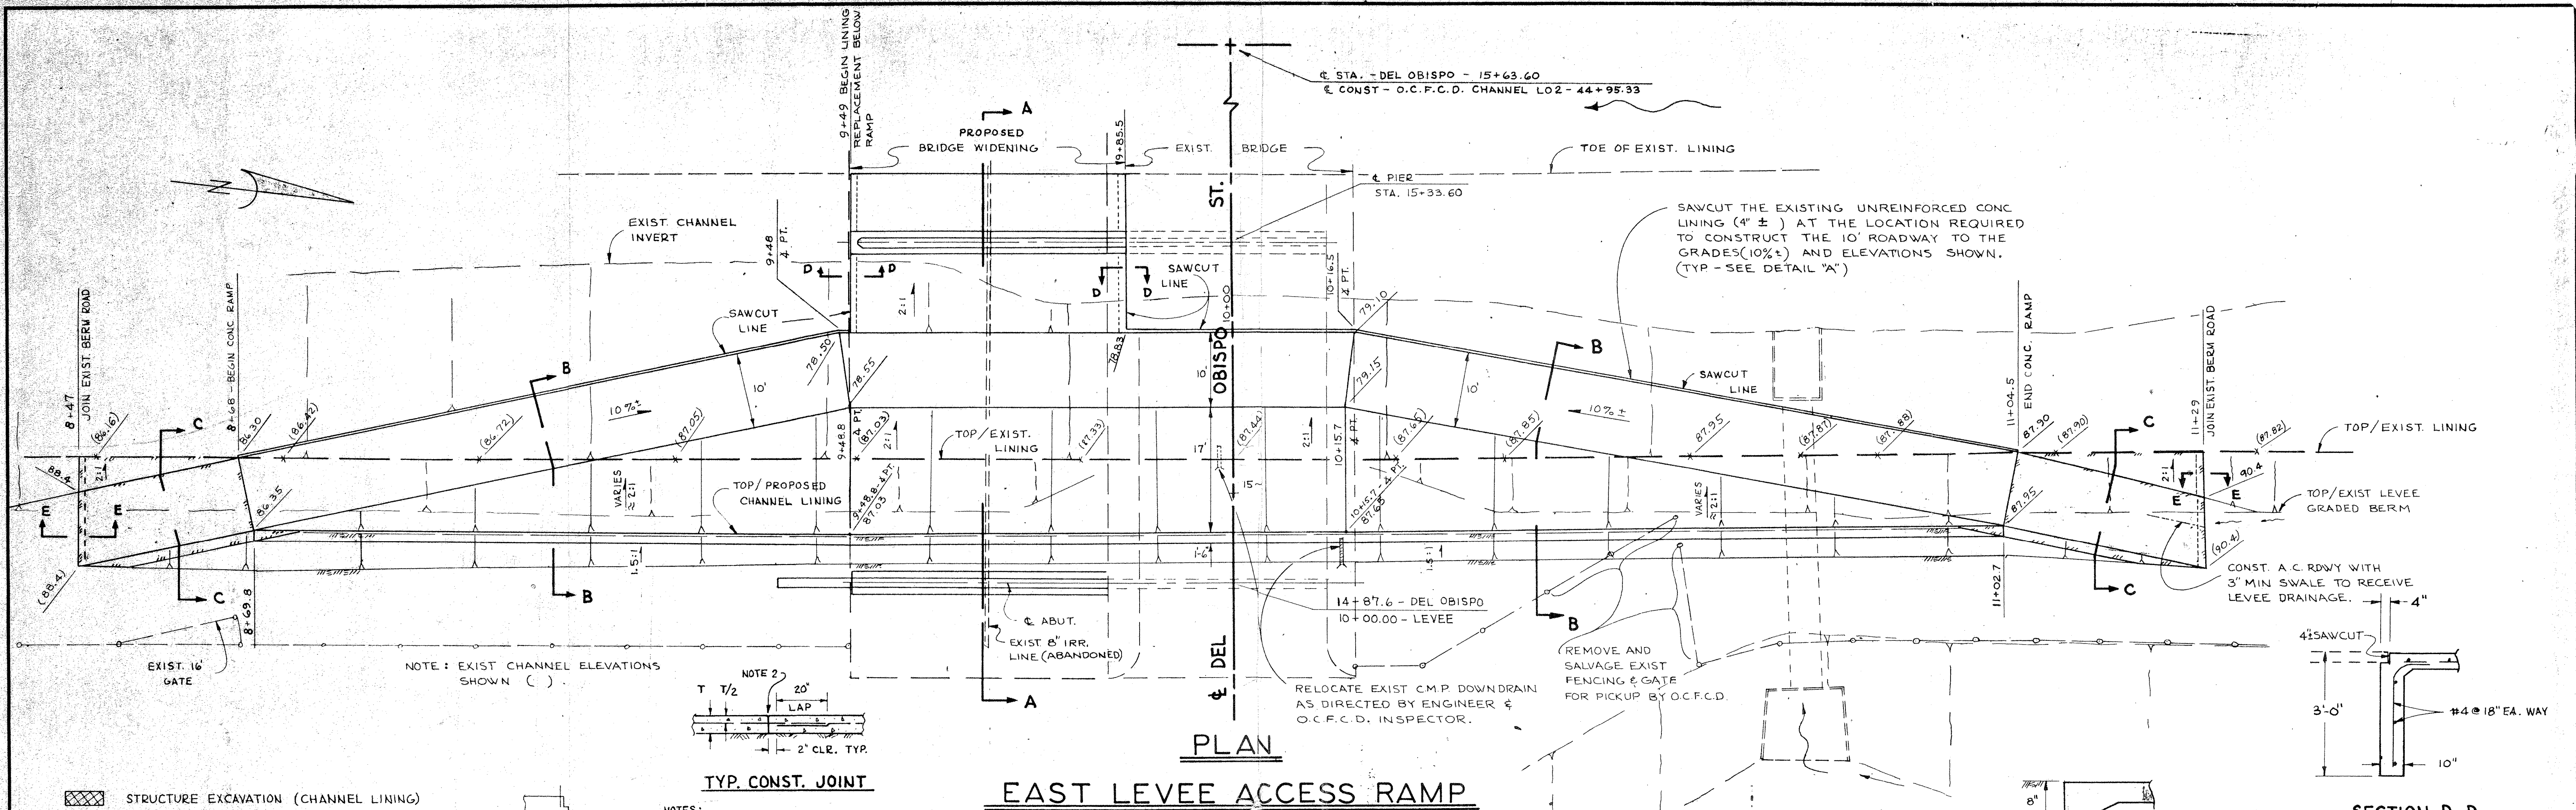


PLAN EAST LEVEE ACCESS RAMP SCALE: 1"=10'-0"


- NOTES:
1. ALL CONST. JOINTS TO BE IN THE SAME PLANE FOR THE ENTIRE STRUCTURE.
 2. ROUND WITH EDGING TOOL OR SCORE @ 50" MAX.

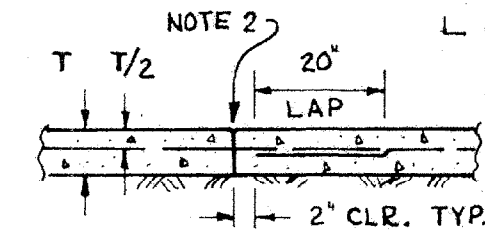


TYP. CONST. JOINT

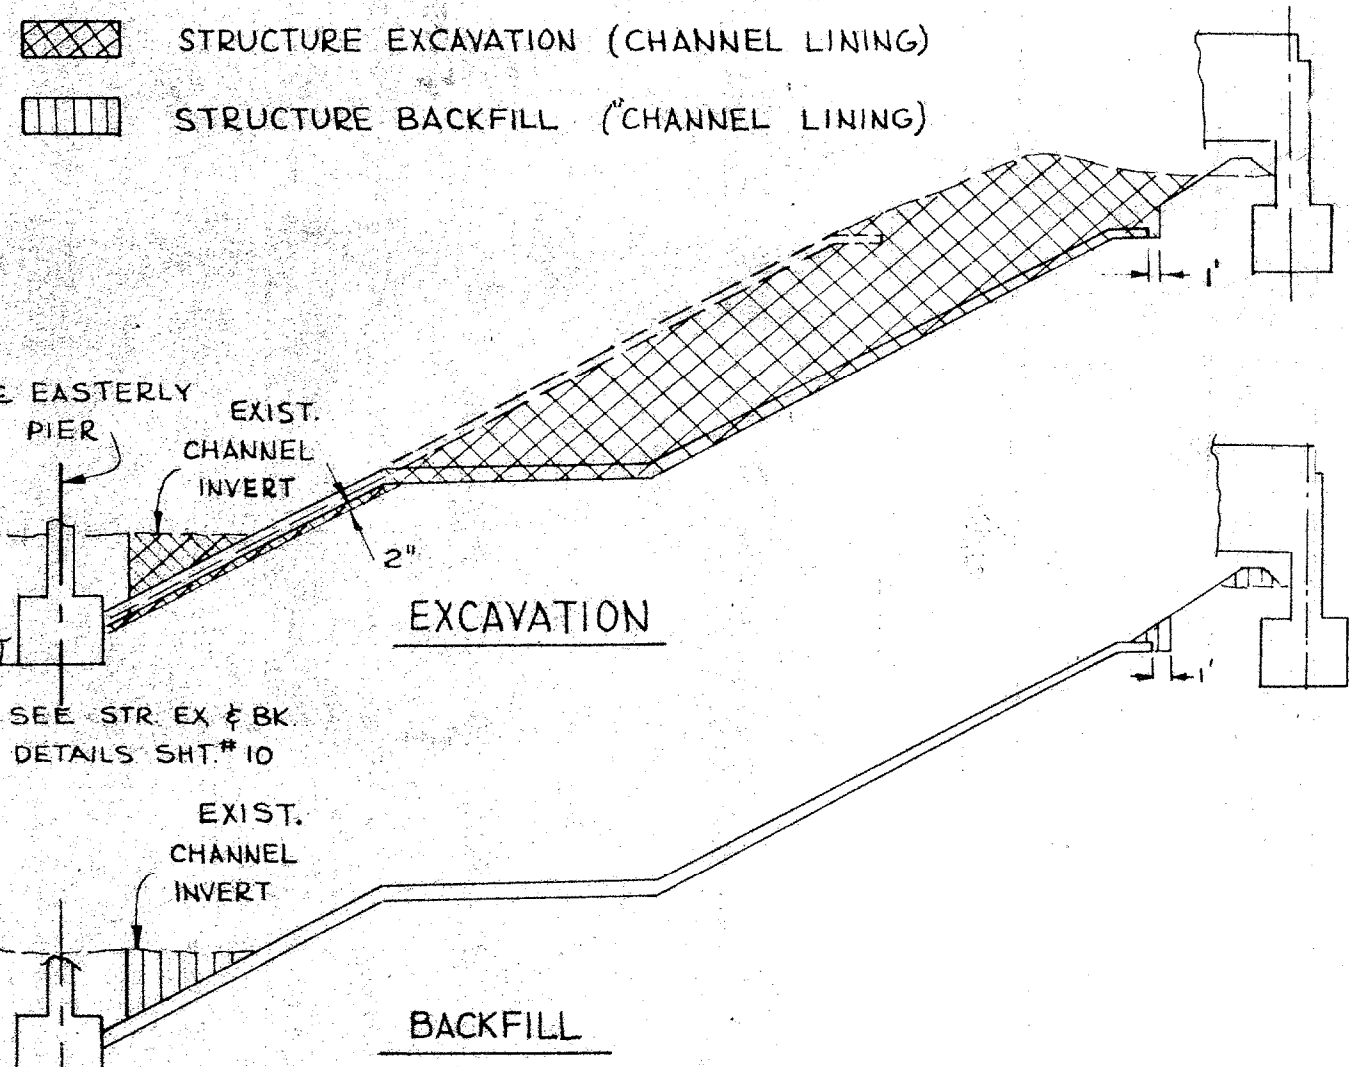


STRUCTURE EXCAVATION AND BACKFILL FOR
R.C. CHANNEL LINING
NO SCALE

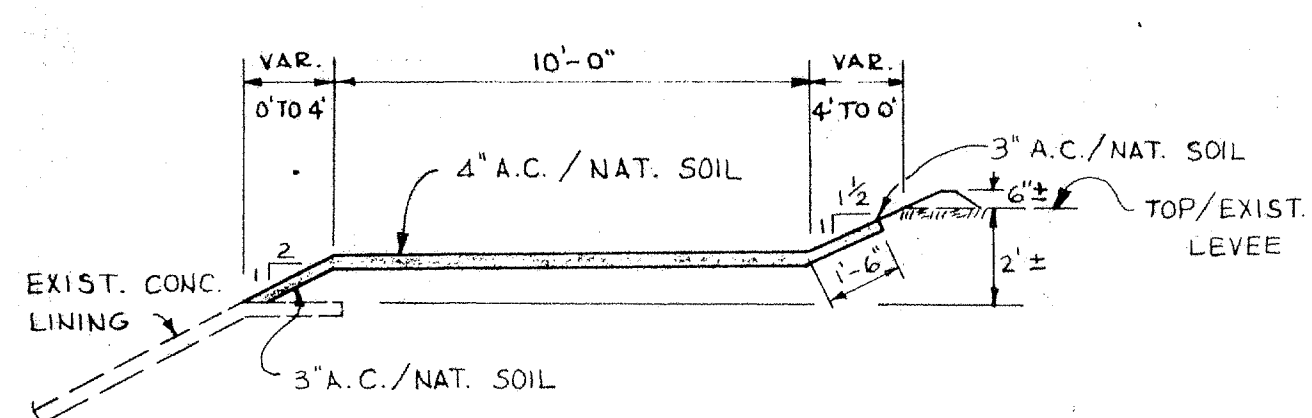


SECTION C-C
SCALE: 1/4"=1'-0"

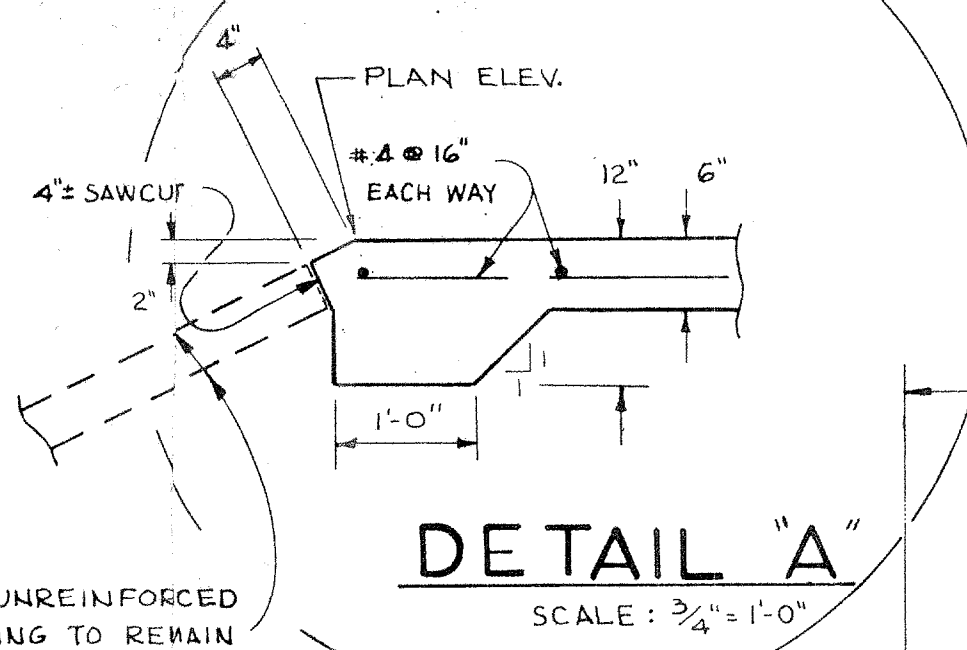


DETAIL "A"
SCALE: 3/4"=1'-0"

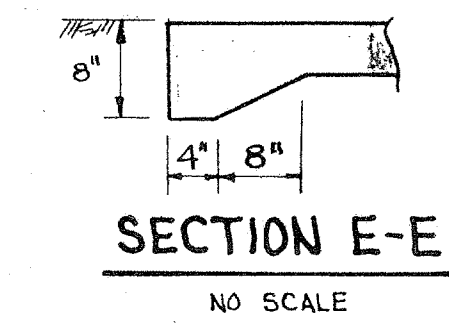


SECTION E-E
NO SCALE

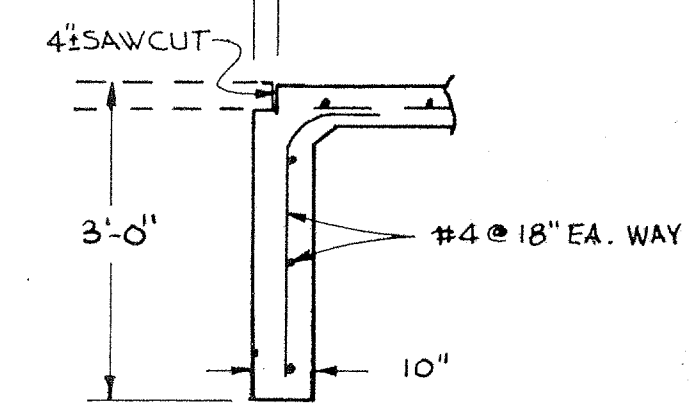

SECTION D-D
CUT-OFF WALL DETAIL
SCALE: 3/8"=1'-0"

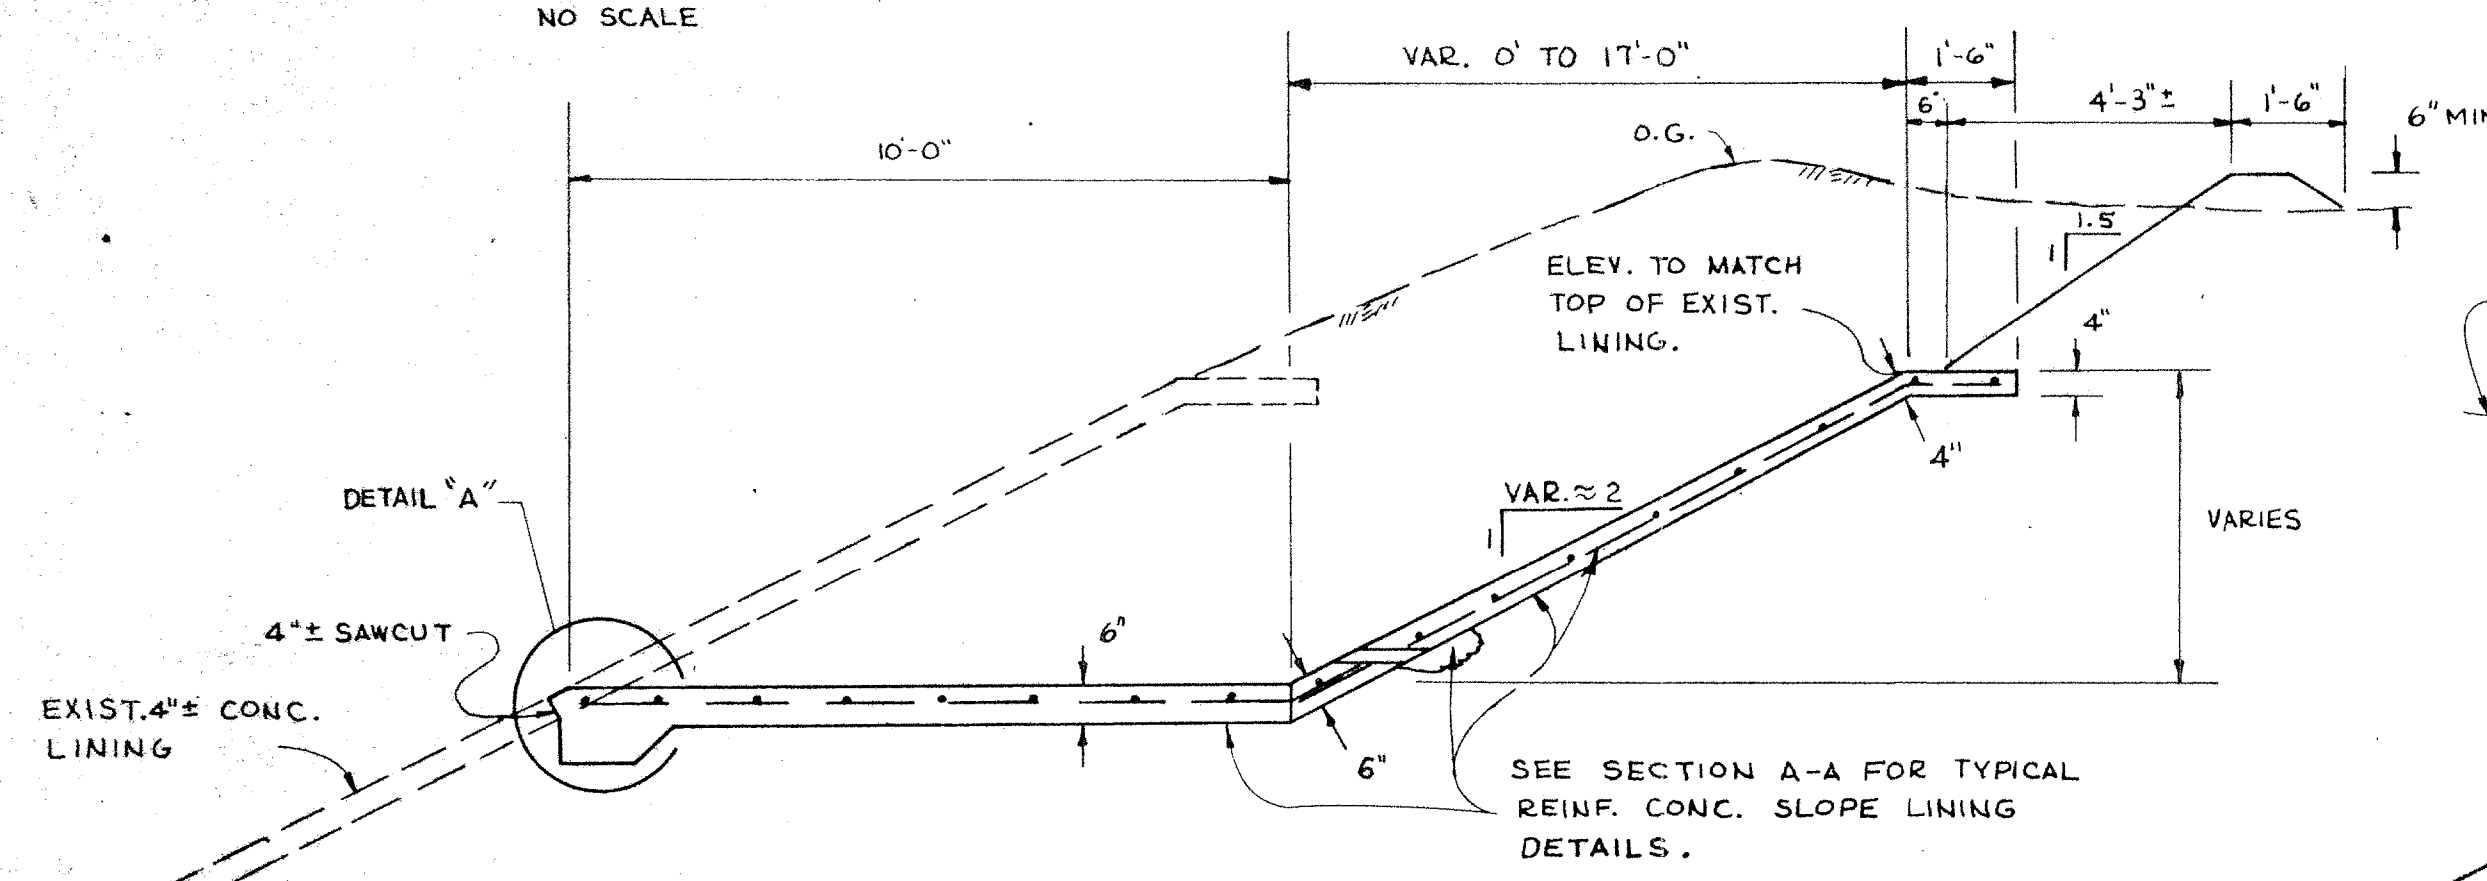

SECTION B-B
SCALE: 3/8"=1'-0"

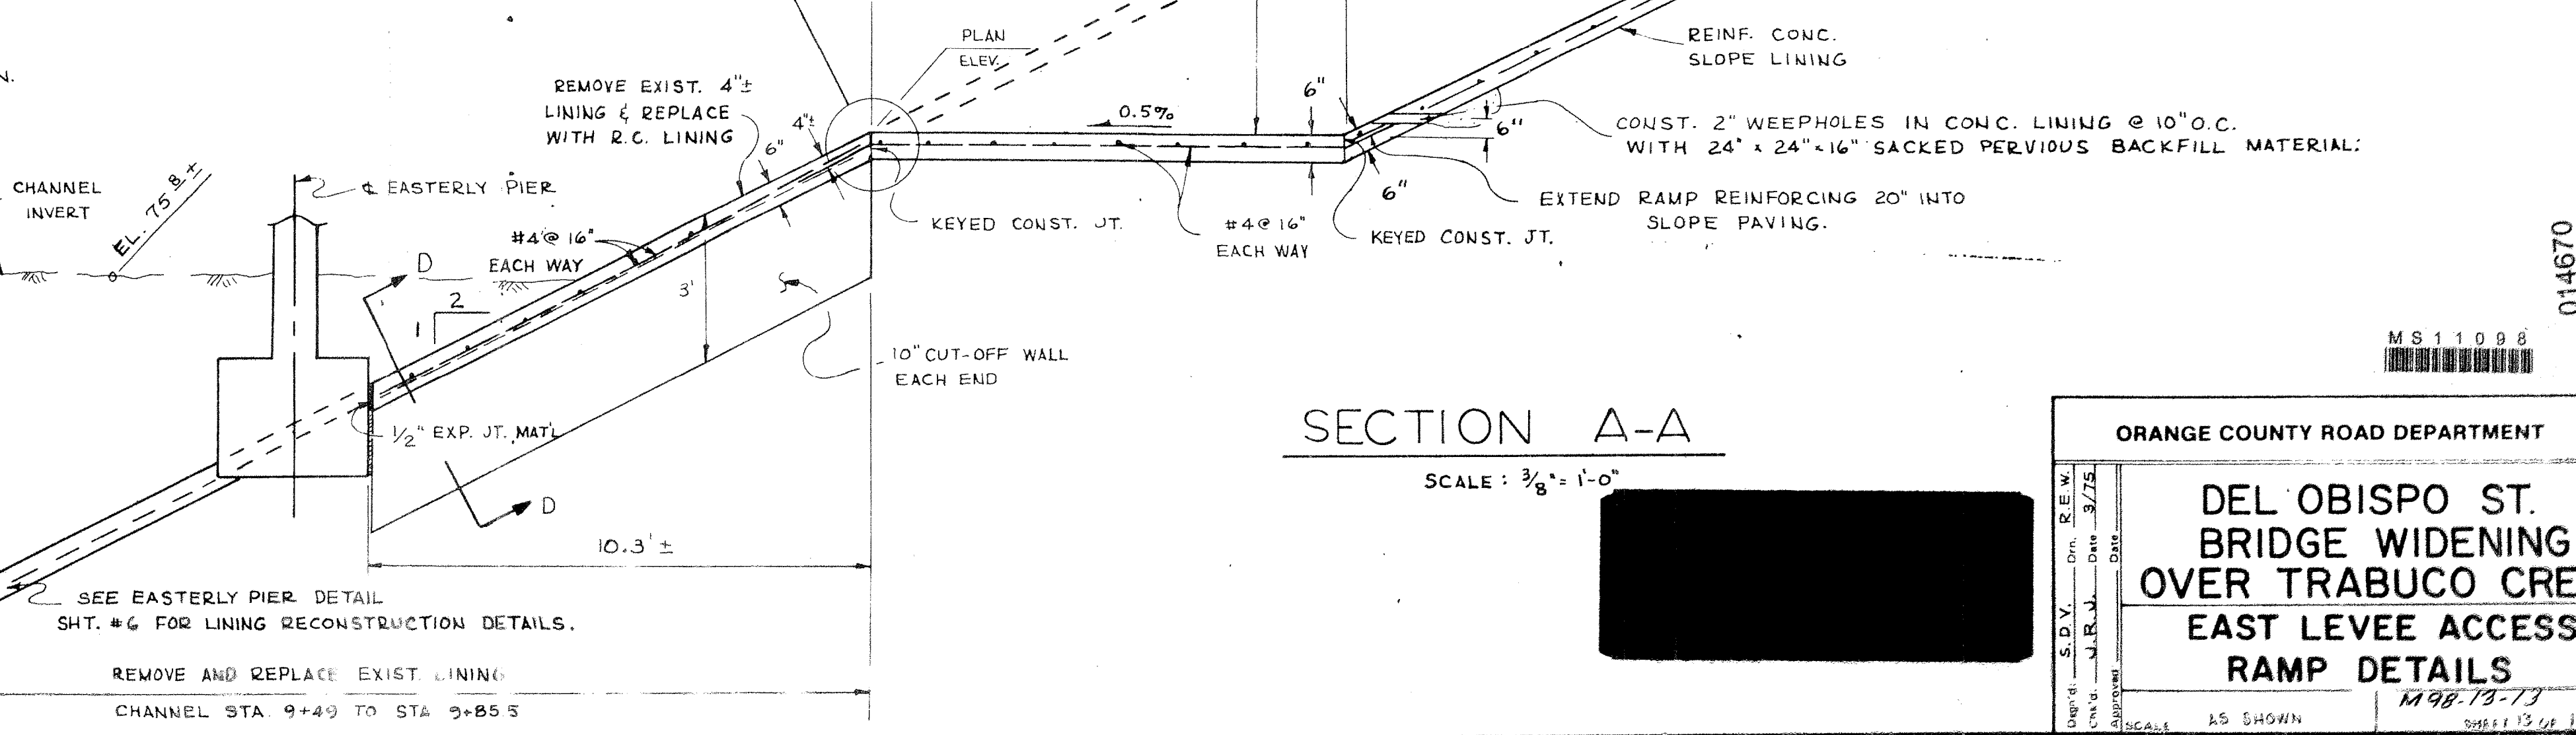

SECTION A-A
SCALE: 3/8"=1'-0"

ORANGE COUNTY ROAD DEPARTMENT

DEL OBISPO ST.
BRIDGE WIDENING
OVER TRABUCO CREEK
EAST LEVEE ACCESS
RAMP DETAILS

MS 11096

15 SHOWN

1987.13-73

014670