



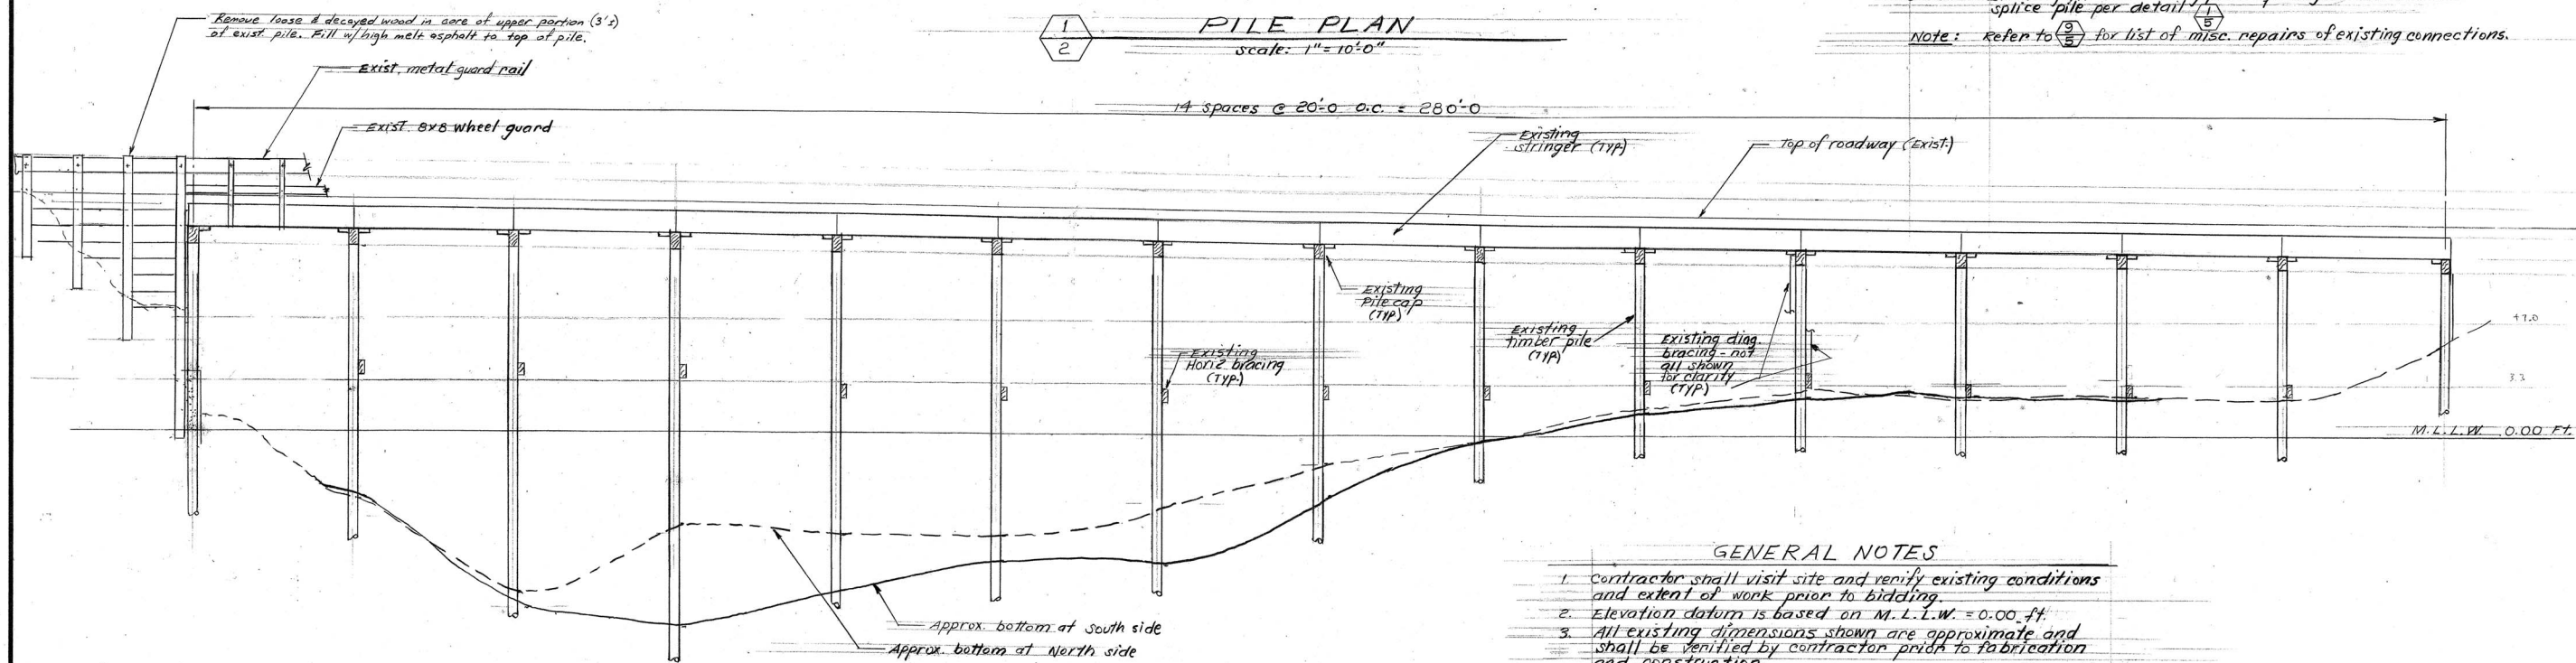

- ## GENERAL NOTES
1. Contractor shall visit site and verify existing conditions and extent of work prior to bidding.
 2. Elevation datum is based on M.L.L.W. = 0.00 ft.
 3. All existing dimensions shown are approximate and shall be verified by contractor prior to fabrication and construction.
 4. All work shall be in accordance with the specifications, County of Orange requirements and all applicable codes and ordinances.
 5. All materials shall be in conformance with the "special provisions" specification.

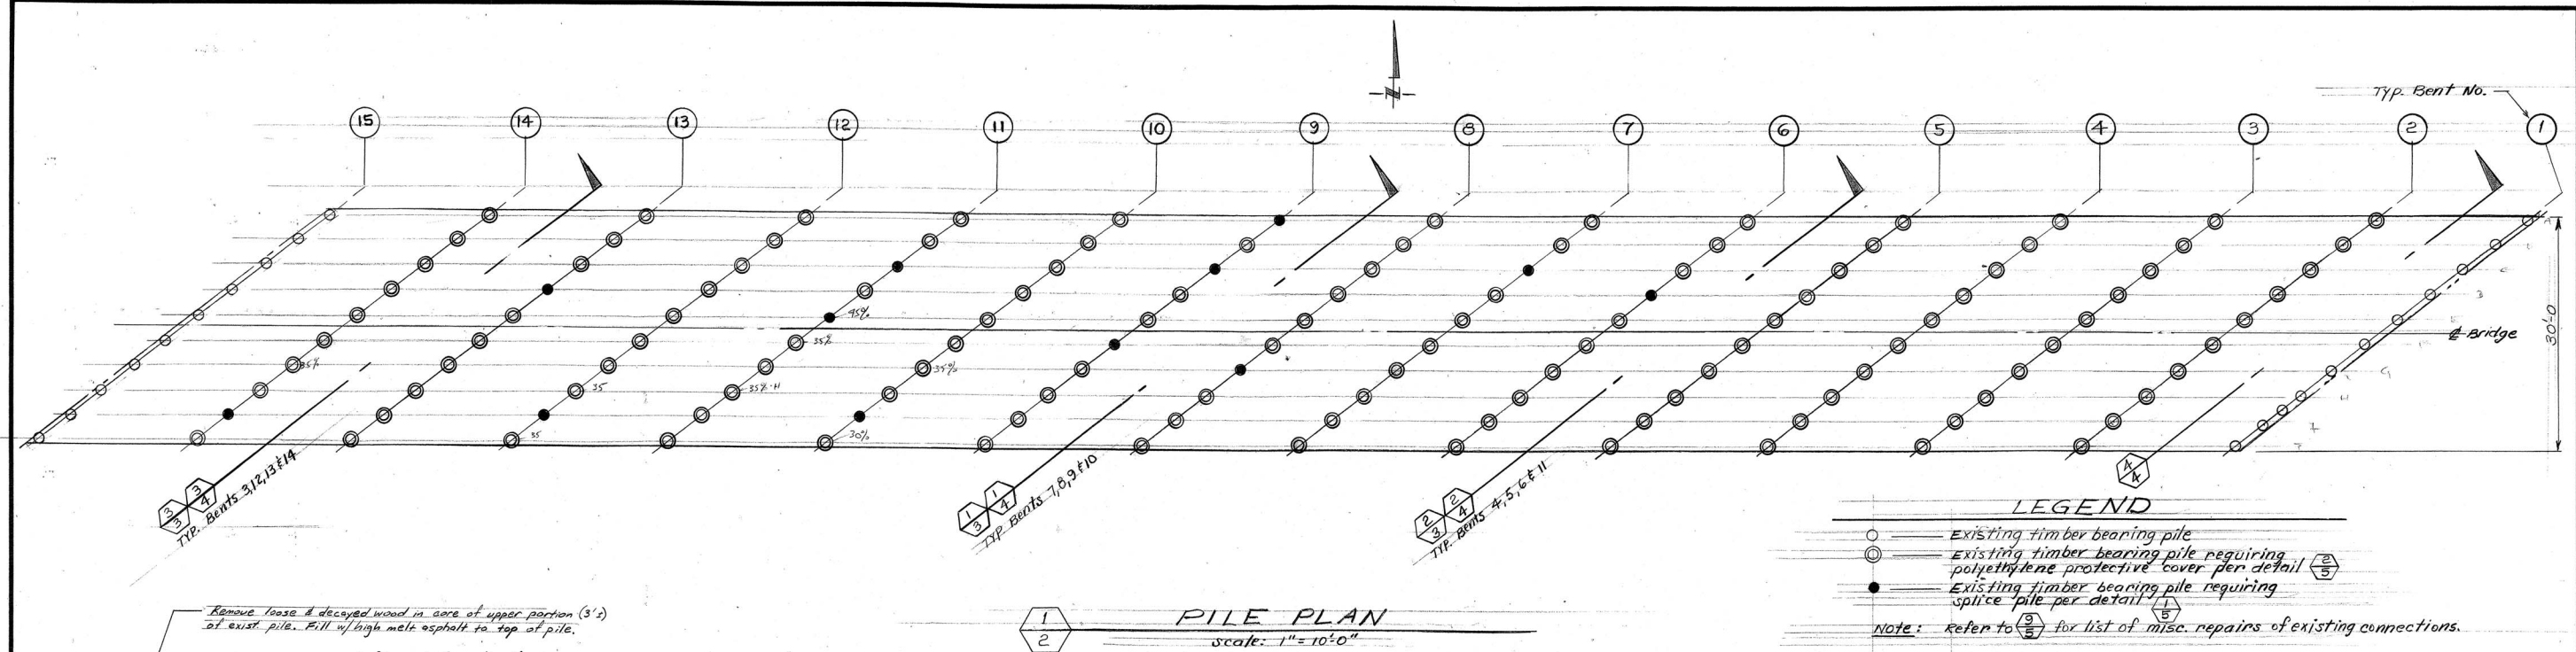

(213) 831-0080 SAN PEDRO, CALIFORNIA		MARK DATE DESCRIPTION		PREPARED UNDER SUPERVISION OF		SHEET	
DRAWN F.M. APP'D <i>[Signature]</i>		SCALE Noted		REVISIONS		DATE	
JOB NO. 87170		DESIGNED		SCALE		DWG. NO.	
DATE 10-8-87		DRAWN		AS SHOWN 11-6-87		374-32. 5-1	
		CHECKED				OF 5	