



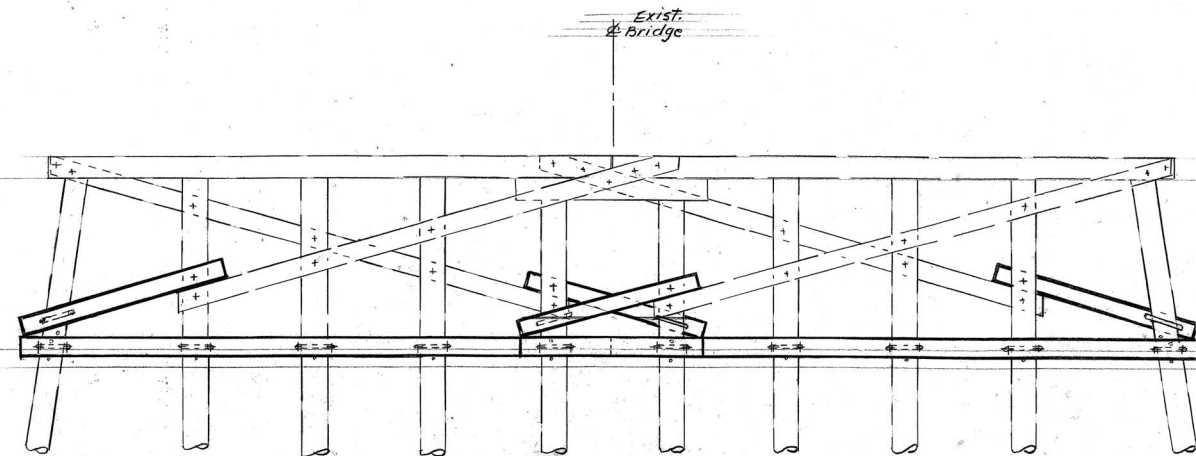


NOTE: Refer to 4 for notations

3 CROSS SECTION ~ BENTS 3, 12, 13 & 14
scale: 1/4" = 1'-0"

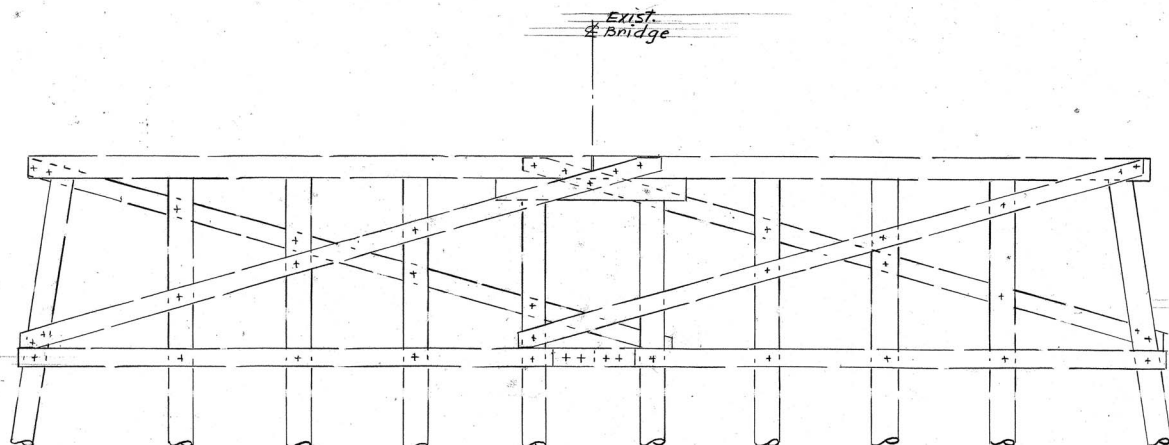


NOTE: Refer to 4 for notations

4 CROSS SECTION ~ BENT 2
scale: 1/4" = 1'-0"

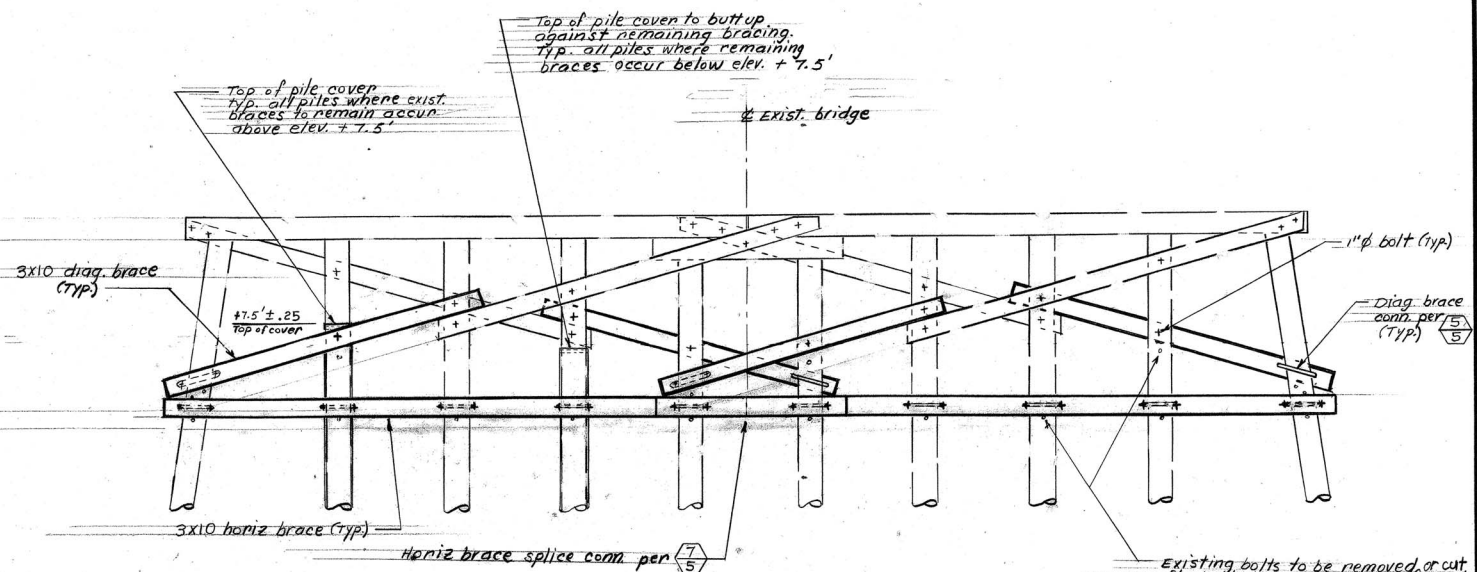

1 CROSS SECTION ~ BENTS 7, 8, 9 & 10
scale: 1/4" = 1'-0"

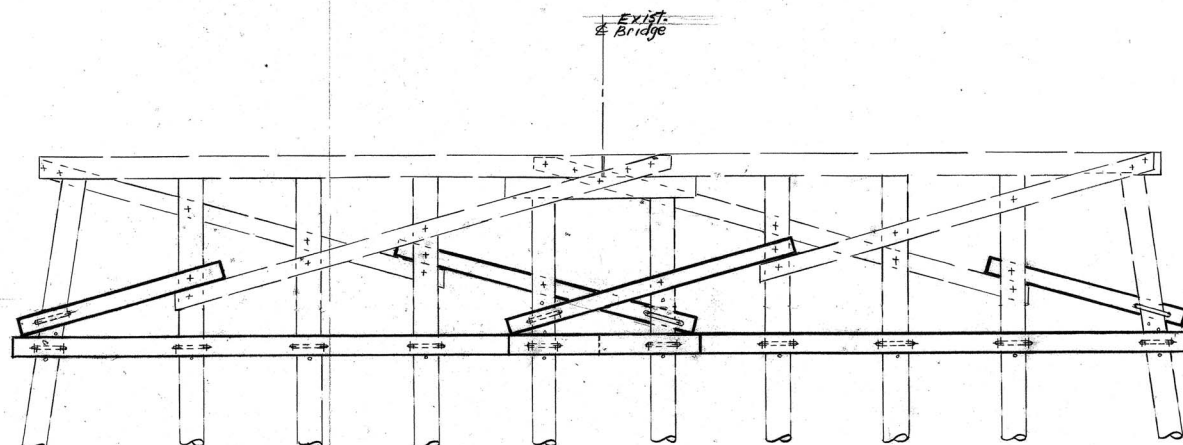

NOTE: Refer to 4 for notations

2 CROSS SECTION ~ BENTS 4, 5, 6 & 11
scale: 1/4" = 1'-0"



DRAWN F.M.	CHECKED D.D.H.	SCALE 1/4" = 1'-0"
DATE 10-8-87	JOB NO. 87170	

ORANGE COUNTY ENVIRONMENTAL MANAGEMENT AGENCY		
REFURBISHMENT OF EDINGER AVE. BRIDGE		
BRACING REPLACEMENT		
MARK	DATE	DESCRIPTION
REVISIONS		
DESIGNED	DATE	DWG. NO.
DRAWN	CHECKED	AS SHOWN
PREPARED UNDER SUPERVISION OF		
SCALE AS SHOWN	DATE 11-16-87	DWG. NO. 24432.5-1
SHEET 4 OF 5		