



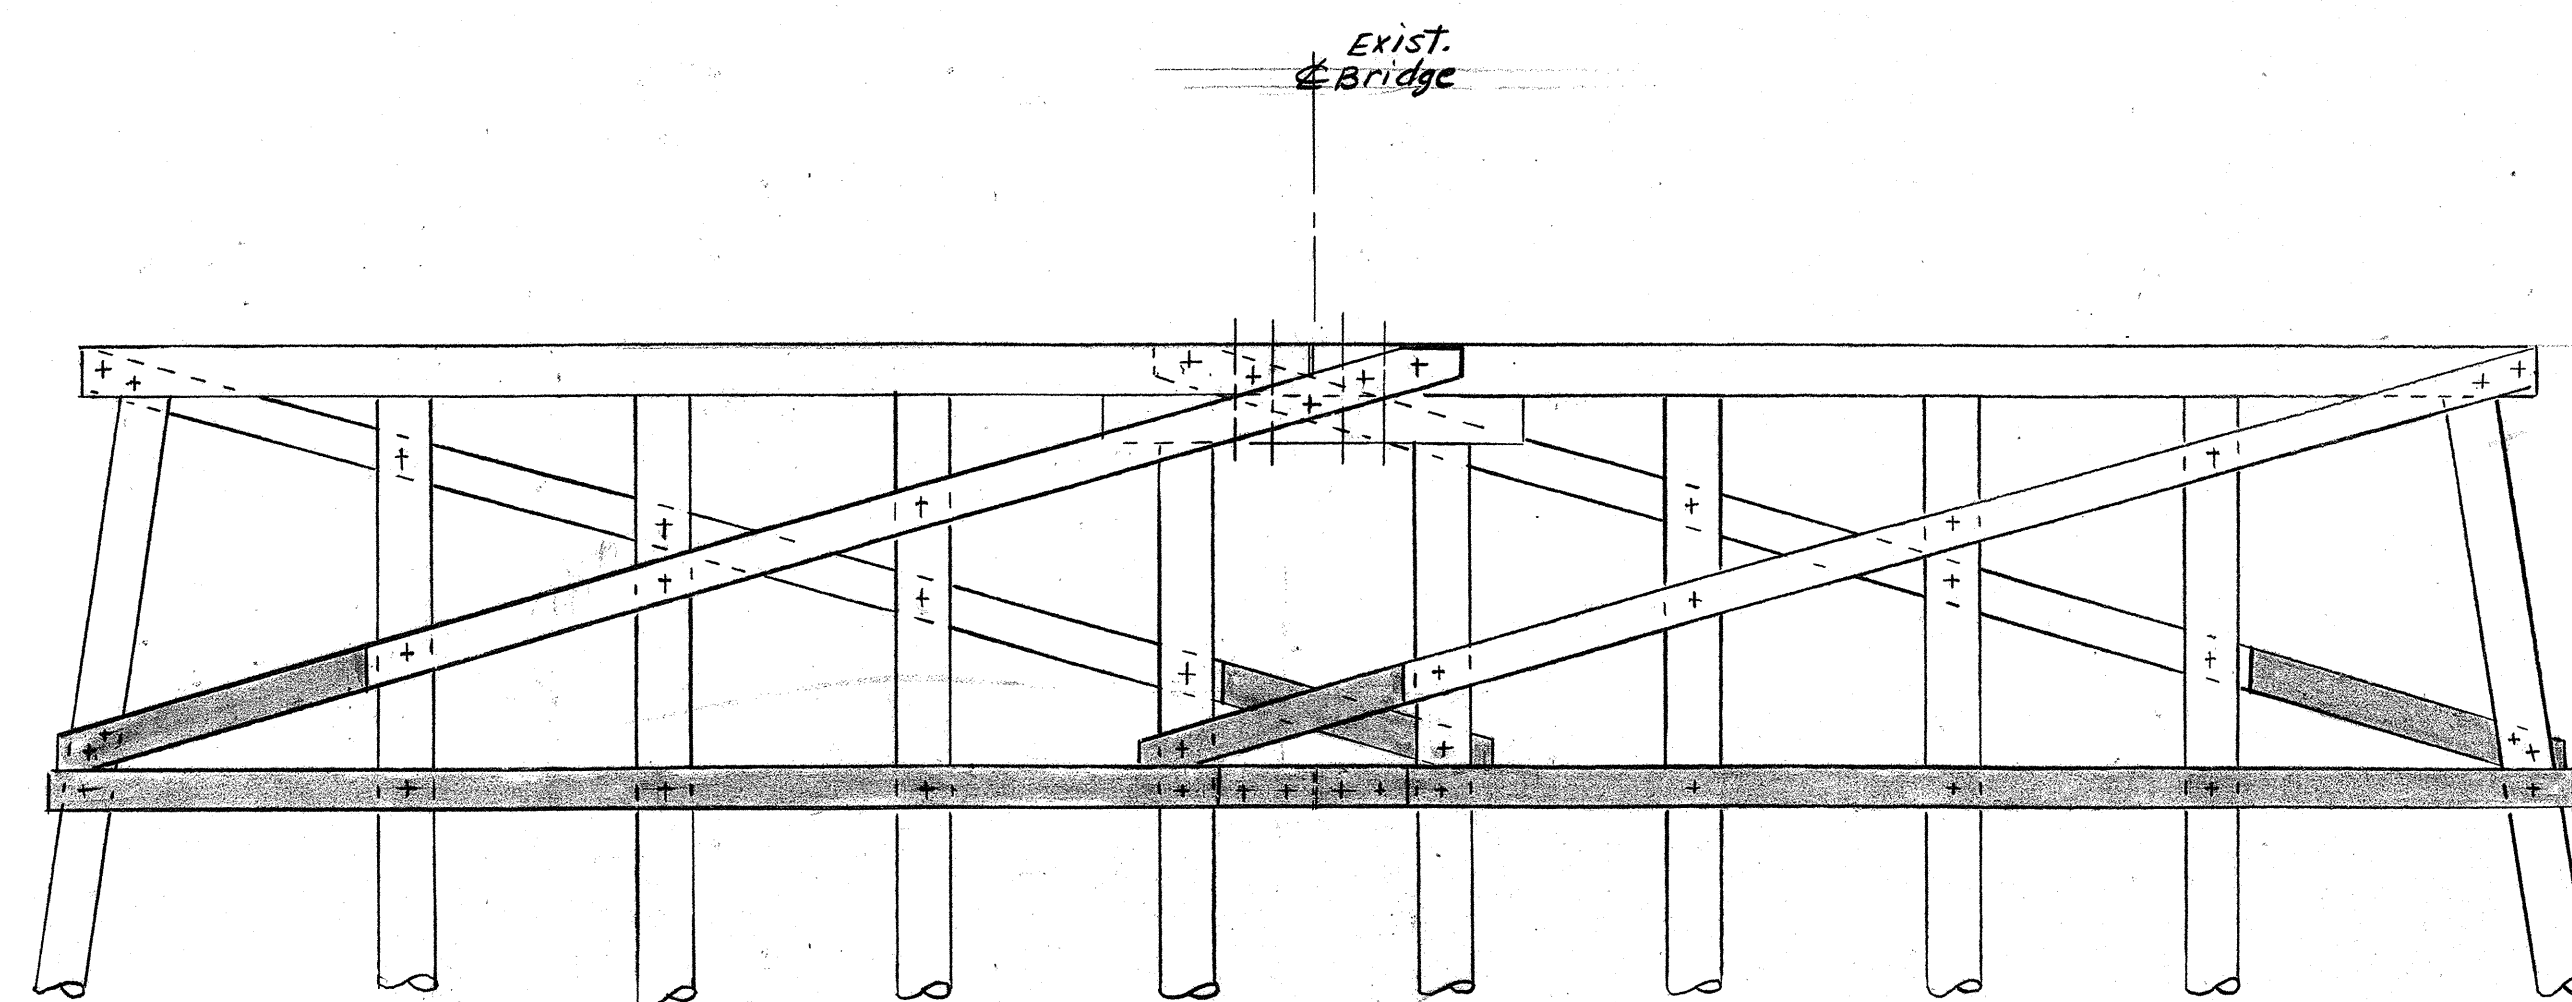


Note: refer to $\frac{2}{3}$ for notations.

$\frac{3}{3}$ CROSS SECTION ~ BENTS 3, 12, 13 & 14
scale: $\frac{1}{4}'' = 1'-0''$

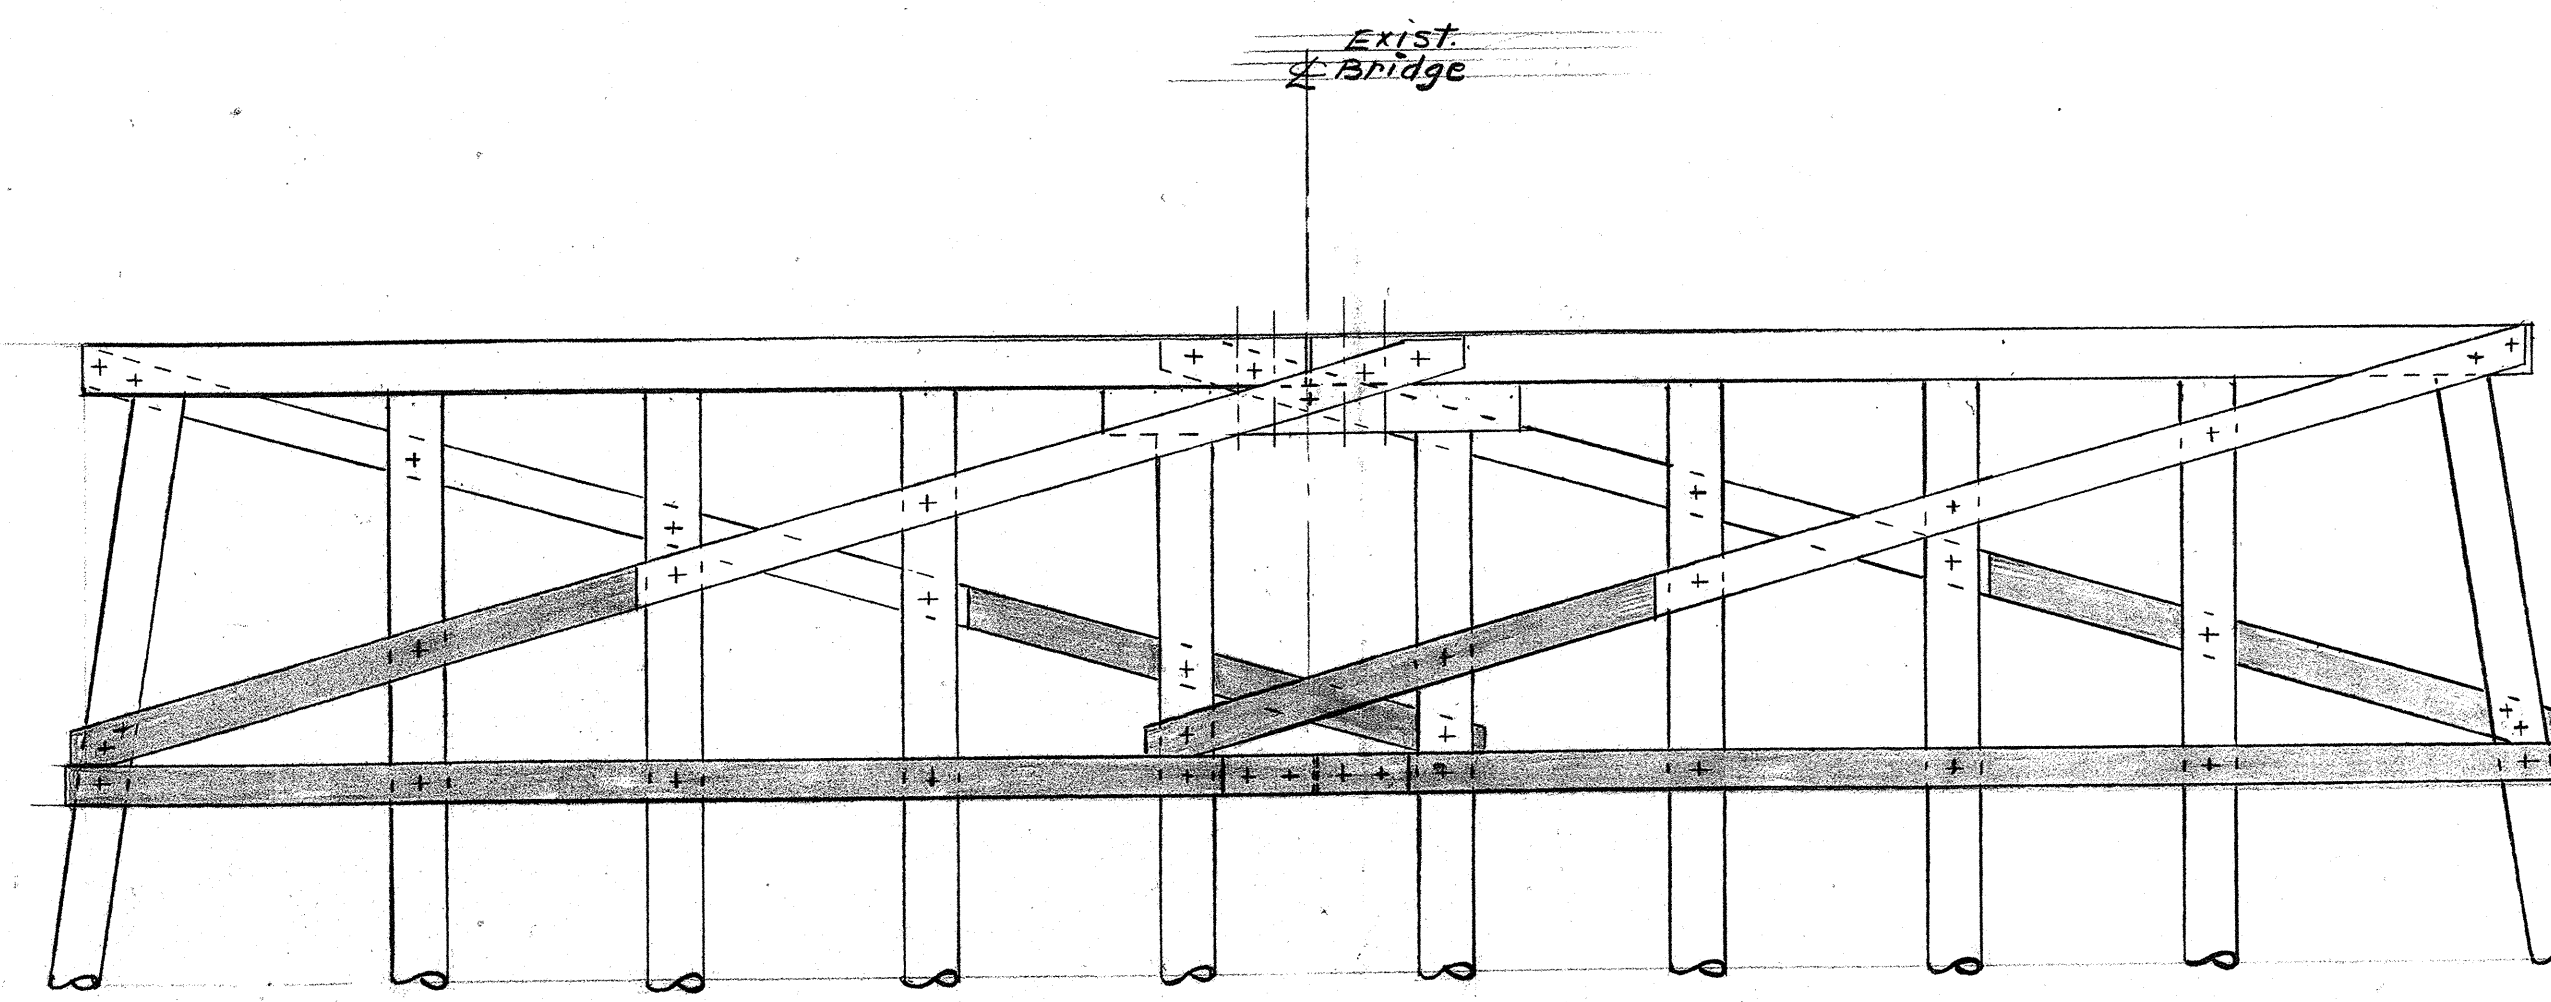

Note: refer to $\frac{2}{3}$ for notations.


$\frac{1}{3}$ CROSS SECTION ~ BENTS 7, 8, 9 & 10
scale: $\frac{1}{4}'' = 1'-0''$

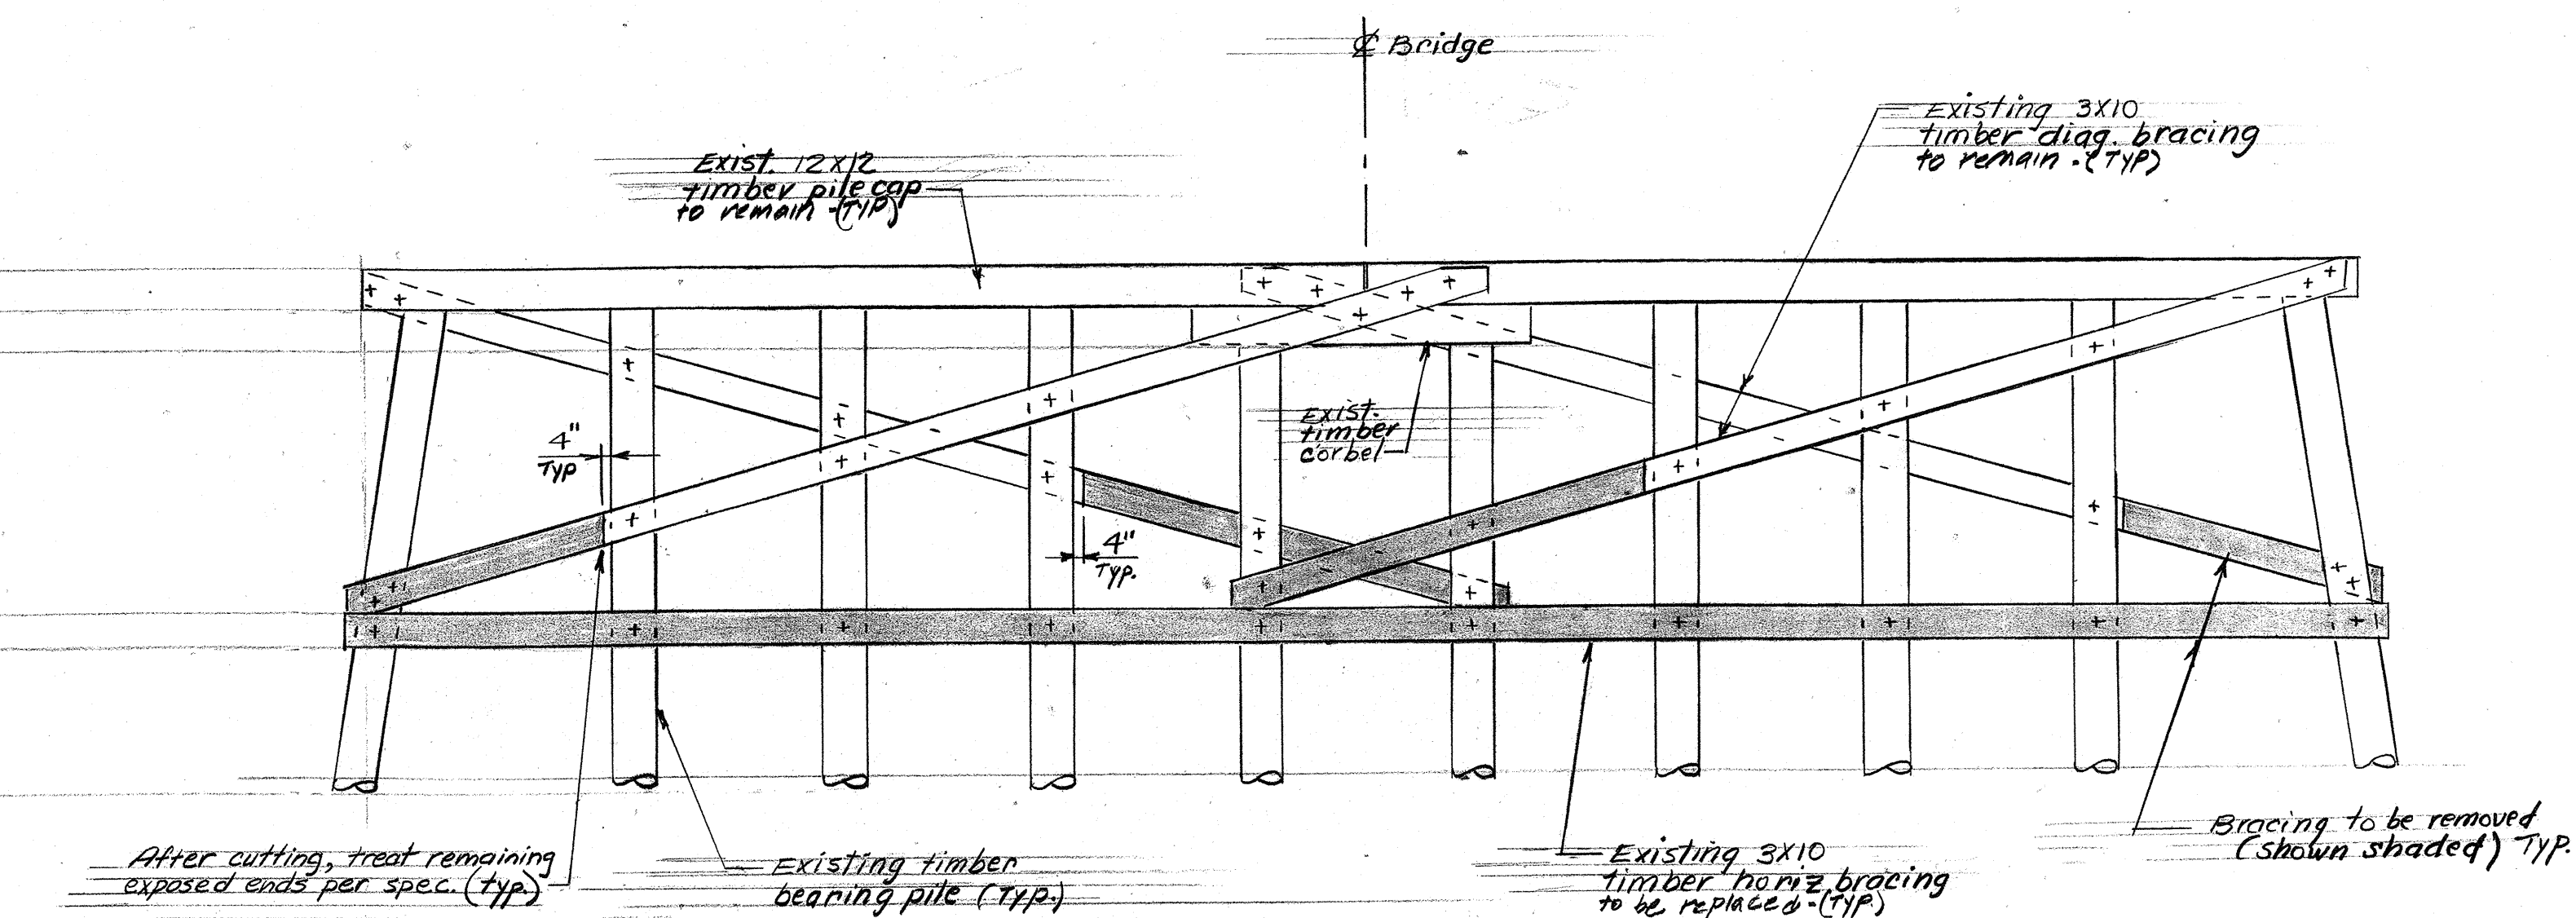

$\frac{2}{3}$ CROSS SECTION ~ BENTS 4, 5, 6 & 11
scale: $\frac{1}{4}'' = 1'-0''$

BRACING REMOVALS

NOTE: SEE SHEET 4 FOR
NEW BRACING TO BE INSTALLED

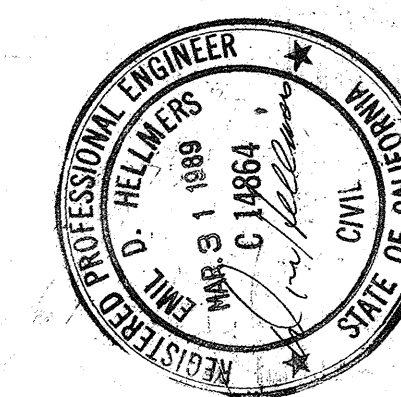

DM DON HELLMAYER ENGINEERING	
(213) 831-0608 SAN PEDRO, CALIFORNIA	
DRAWN F.M. DATE 10-8-87	CHECKED D.P.H. SCALE $\frac{1}{4}'' = 1'-0''$ JOB NO. 87170

ORANGE COUNTY ENVIRONMENTAL MANAGEMENT AGENCY	
REFURBISHMENT OF EDINGER AVE. BRIDGE	
BRACING REMOVALS	
MARK	DATE
DESCRIPTION	
PREPARED UNDER SUPERVISION OF	DATE
DESIGNED	DATE
DRAWN	CHECKED
SCALE AS SHOWN	DATE 11-10-87
DWG. NO. SH 32.5-1	
SHEET 3 OF 5	