


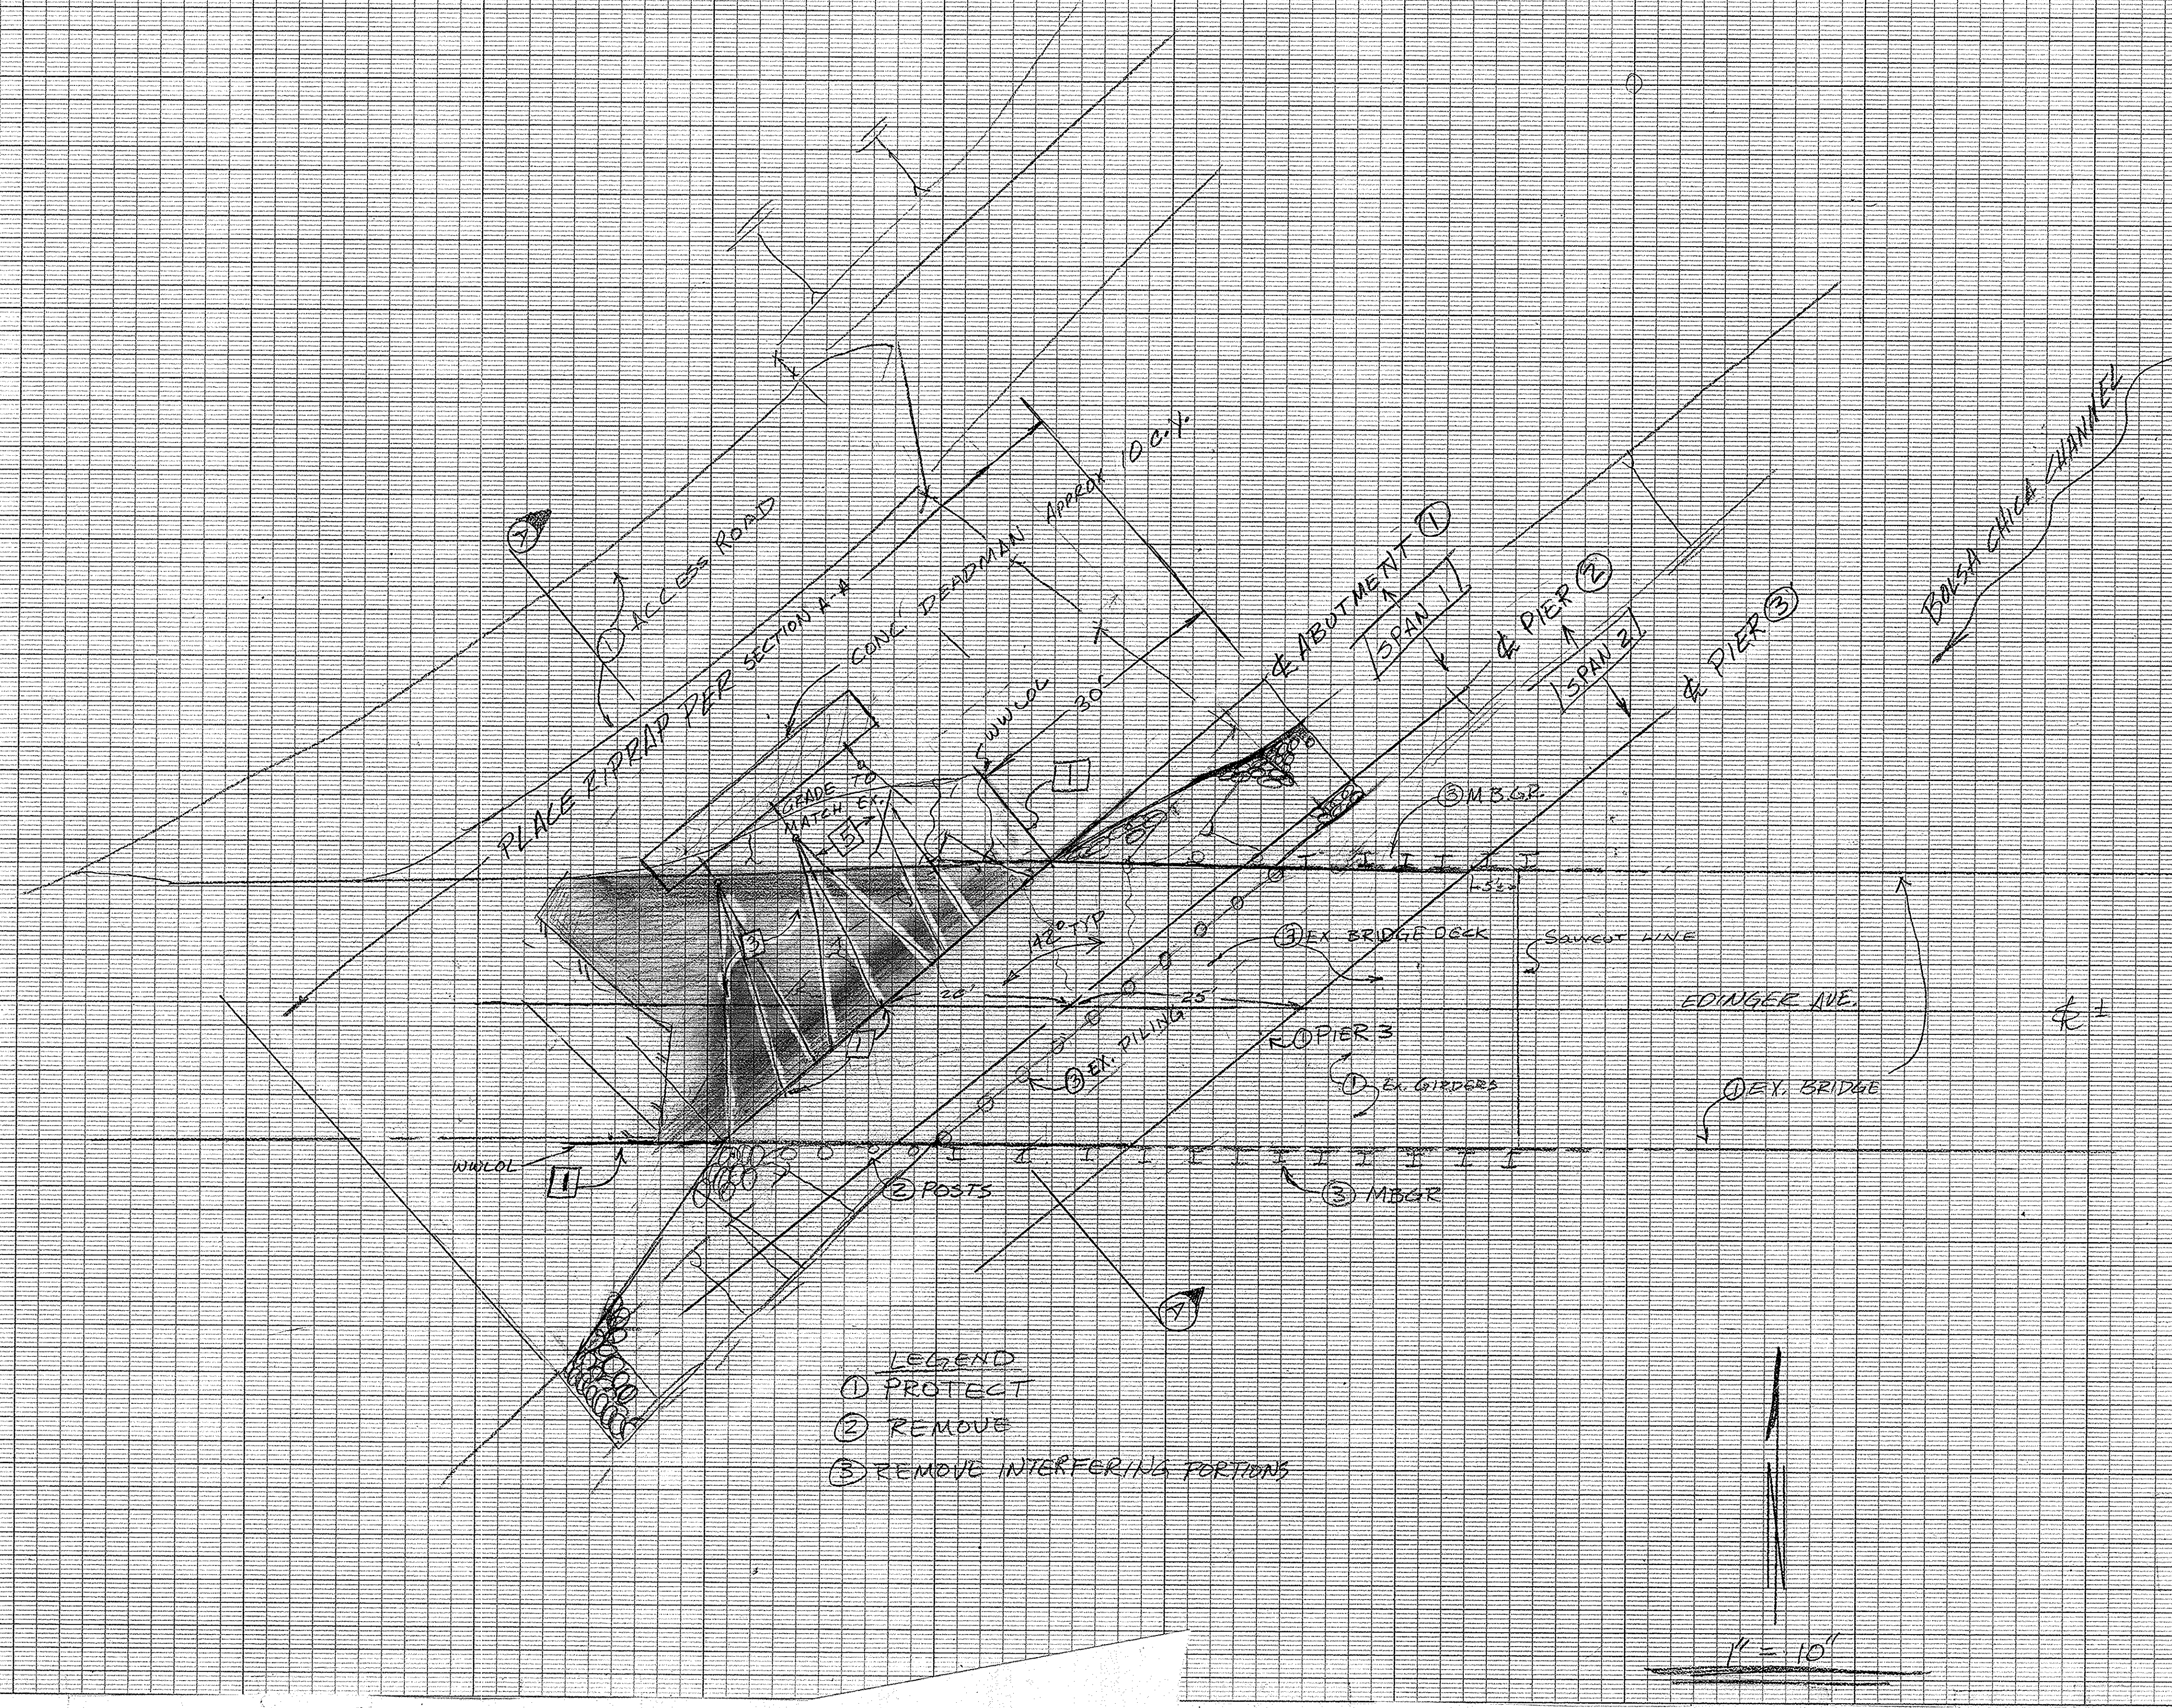

- 1 CONSTRUCT ABUTMENT & WING WALLS PER PLAN
- 2 CONSTRUCT PIER PER PLAN
- 3 PLACE 6" A.C. (45% R.C.) AND 12" A.B. (45% R.C.) AND AS DIRECTED BY THE ENGINEER
- 4 PLACE RIPRAP PER LIMITS SHOWN AND AS DIRECTED BY THE ENGINEER (APPROX 390 CY.)
- 5 PLACE CABLE ANCHORS PER DETAILS TO EXISTING CONCRETE DEADMAN. HAND TIGHTEN CABLE THRU DEADMAN ANCHOR AND SPICE BACK INTO CABLE WITH APPROPRIATE SWAGS.

LEGEND
 ① PROTECT
 ② REMOVE
 ③ REMOVE INTERFERING PORTIONS

1 1/2 0 1 2
 3 inches on original drawing

1" = 10'

		ORANGE COUNTY ENVIRONMENTAL MANAGEMENT AGENCY	
		ACROSS BOLSA CHICA CHANNEL	
MARK	DATE	DESCRIPTION	PREPARED UNDER SUPERVISION OF
DESIGNED		SCALE	DATE
DRAWN		CHECKED	DWG. NO.
		SHEET 1/4	

EDINGER AV. BR. @ SUNSET AQUATIC PARK
 (EMERGENCY REPAIRS)