

SUNSET AQUATIC CHANNEL CHICA EDINGER AV. LOCATION MAP

ORANGE COUNTY


RESOURCES & DEVELOPMENT MANAGEMENT DEPARTMENT SANTA ANA. CALIFORNIA BRYAN SPEEGLE, DIRECTOR


> PLANS FOR TEMPORARY REFURBISHMENT AND DECK REPLACEMENT OF EDINGER AVENUE BRIDGE SUNSET AQUATIC PARK

> > DECEMBER, 2005

PURPOSE OF THIS PROJECT: THIS IS A TEMPORARY REPAIR ONLY TO ALLOW THE FUTURE FUNDING AND CONSTRUCTION OF A NEW BRIDGE WITHIN FIVE YEARS.

FUNDED BY: HARBORS BEACHES & PARKS

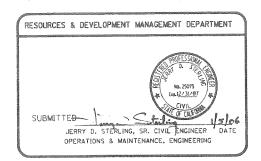

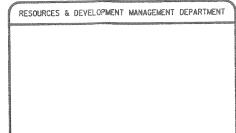

RESOURCES & DEVELOPMENT MANAGEMENT DEPARTMENT

INDEX OF SHEETS

DESCRIPTION SHEET

TITLE SHEET

PLAN

BENT REPAIR

STRUCTURAL DETAILS

DECK DETAIL

BASIS of BEARINGS

THE BASIS OF BEARINGS SHOWN IS THE OCS GPS STATIONS *0940 AND *0944, BEING N76°47'10"W.

HORIZONTAL DATUM


COORDINATES SHOWN HEREON ARE BASED ON THE CALIFORNIA COORDINATE SYSTEM (CCS83), ZONE VI, 1983 NORTH AMERICAN DATUM (1991.35 EPOCH G.P.S. ADJUSTMENT).

DISTANCES SHOWN ARE GROUND, MULTIPLY GROUND DISTANCES BY 0.99998291 TO OBTAIN GRID DISTANCES.

VERTICAL DATUM

B.M. *5_11_19 ELEV. = 10;850_ LEVELED 1995____

NGVD 1929 (1995 O.C.S. ADJUSTMENT)

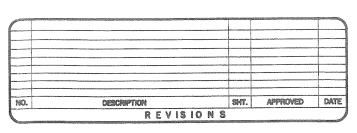

W. O. NO. EH25087