
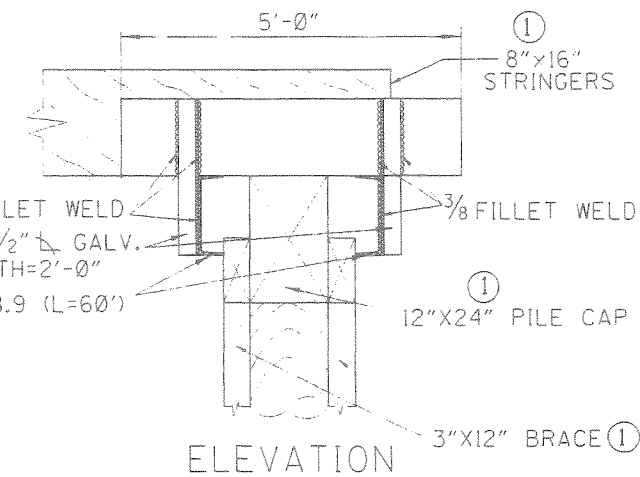
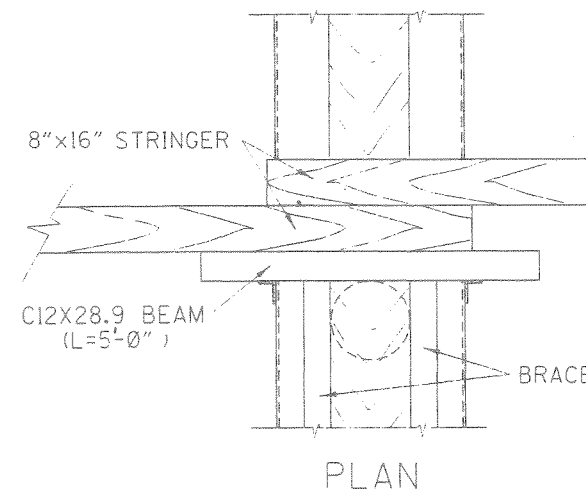
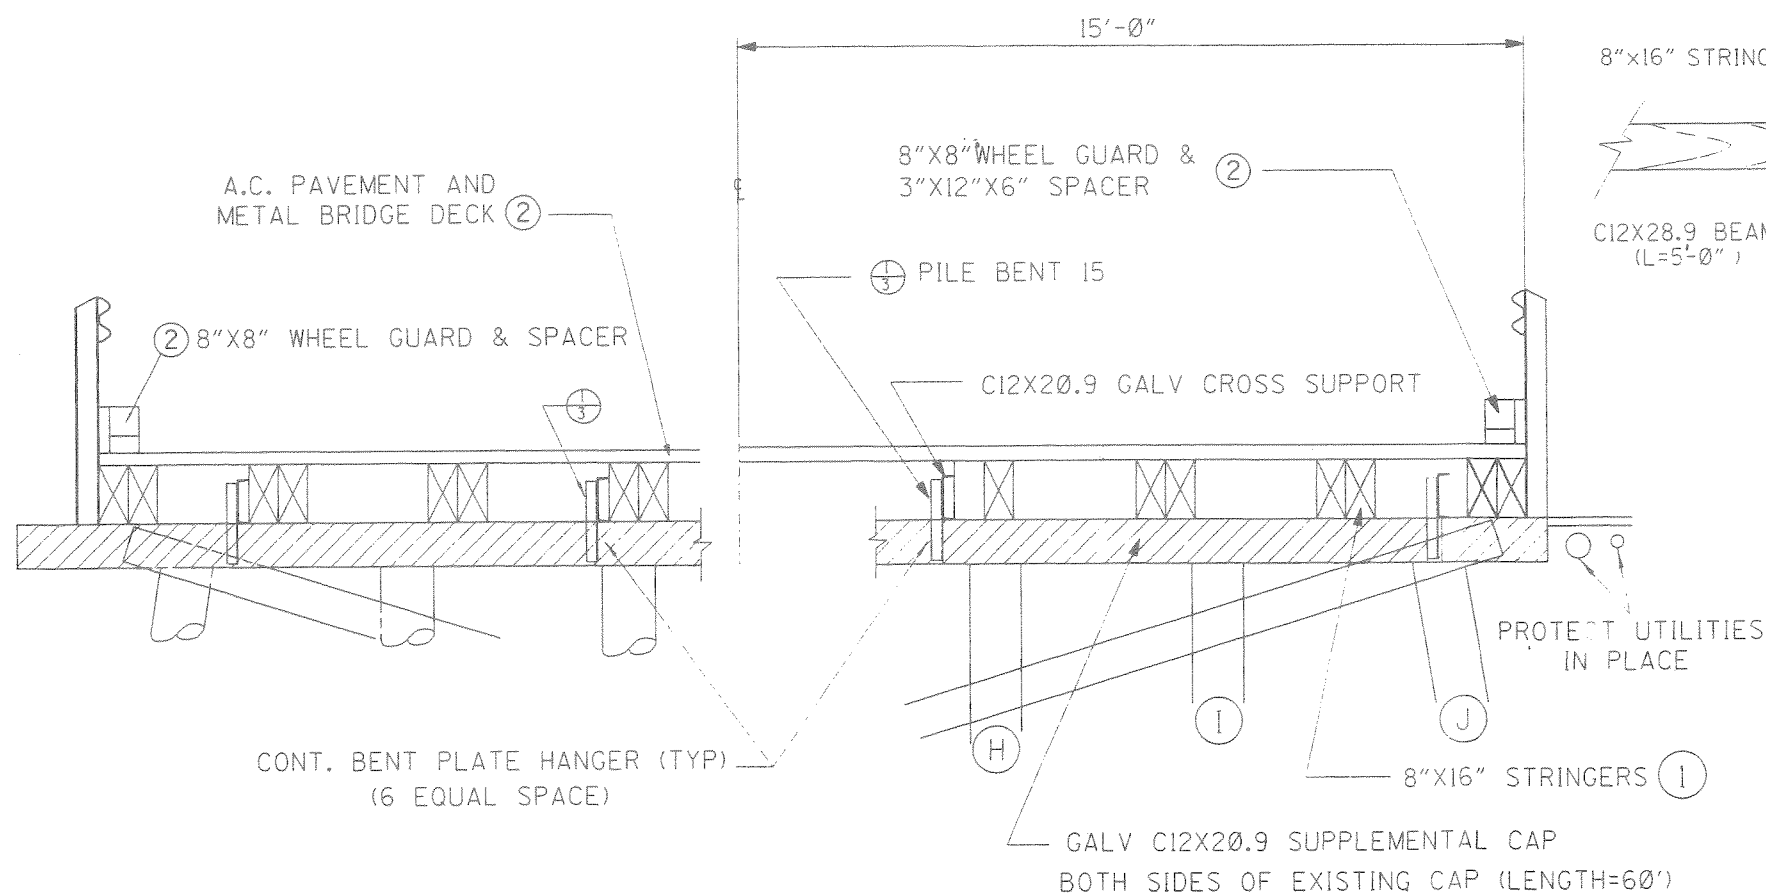


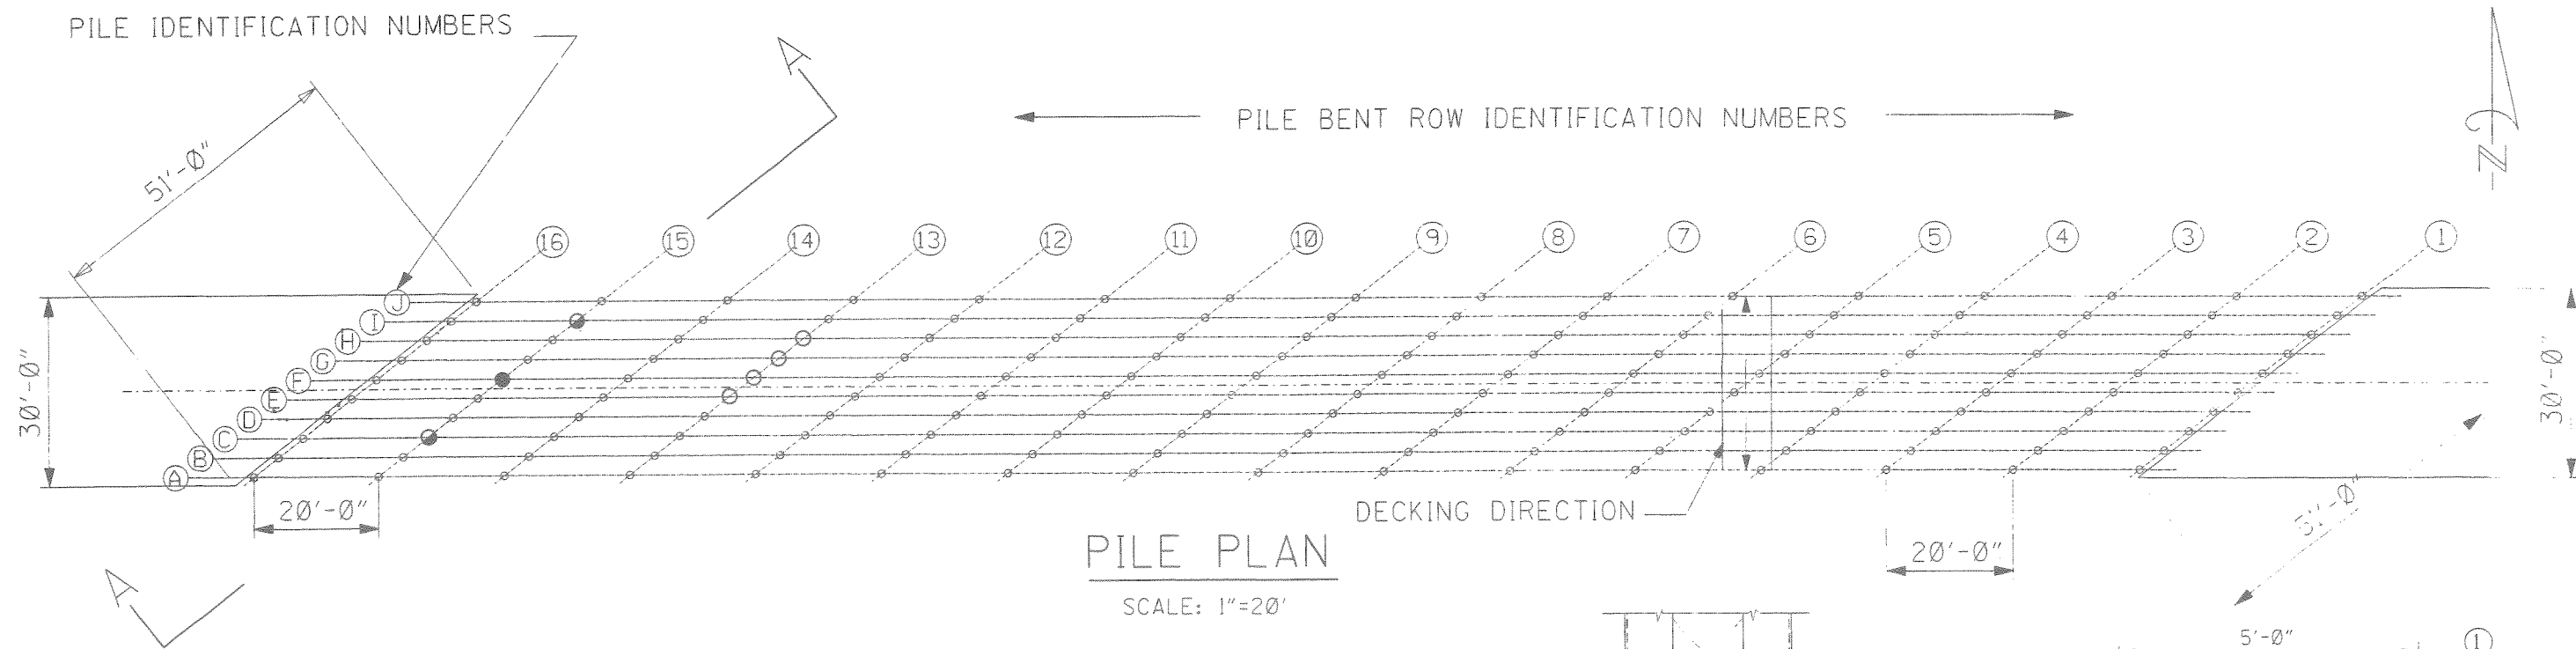

1
3
DETAIL
NTS (TYP. 6 PLACES)

PILE LEGEND

- ⊗ SUSPECT PILE
- ⊙ DESTROYED PILE
- ABRADED PILE

LEGEND

- ① PROTECT
- ② REMOVE
- ③ REMOVE & SALVAGE



ORANGE COUNTY RESOURCES & DEVELOPMENT MANAGEMENT DEPARTMENT			
TEMPORARY REFURBISHMENT AND DECK REPLACEMENT OF EDINGER AVENUE BRIDGE BENT REPAIR			
PREPARED UNDER SUPERVISION	J.D.S.	DATE	SHEET 3 OF 5
DATE 3/2005	DRAWN N.Z.	CHECKED J.D.S.	