



BRIDGE DECK &
ASPHALT TO BE REMOVED

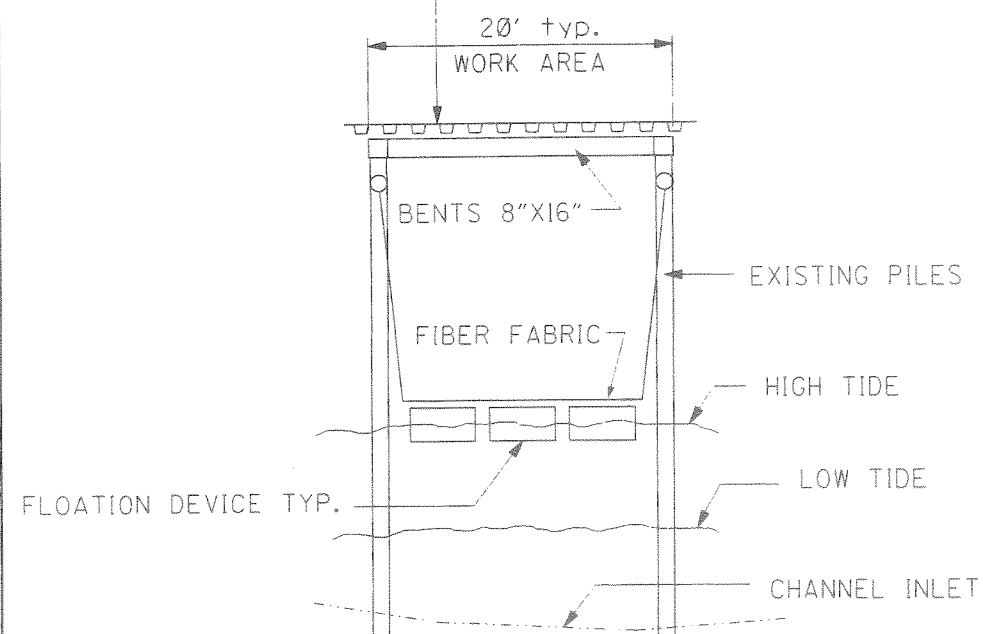

1 DEBRIS CATCHING DEVICE (EXAMPLE ONLY)
NTS


TIMBER TO BE LEVEL
WITH TOP OF 6" CURBS.
CONTRACTOR HAS OPTION OF
USING TREATED TIMBER DAM
FOR A.C., BUT SPACING MUST
PROVIDE FOR ATTACHMENT OF
METAL BEAM 3'-6" ABOVE
SIDEWALK

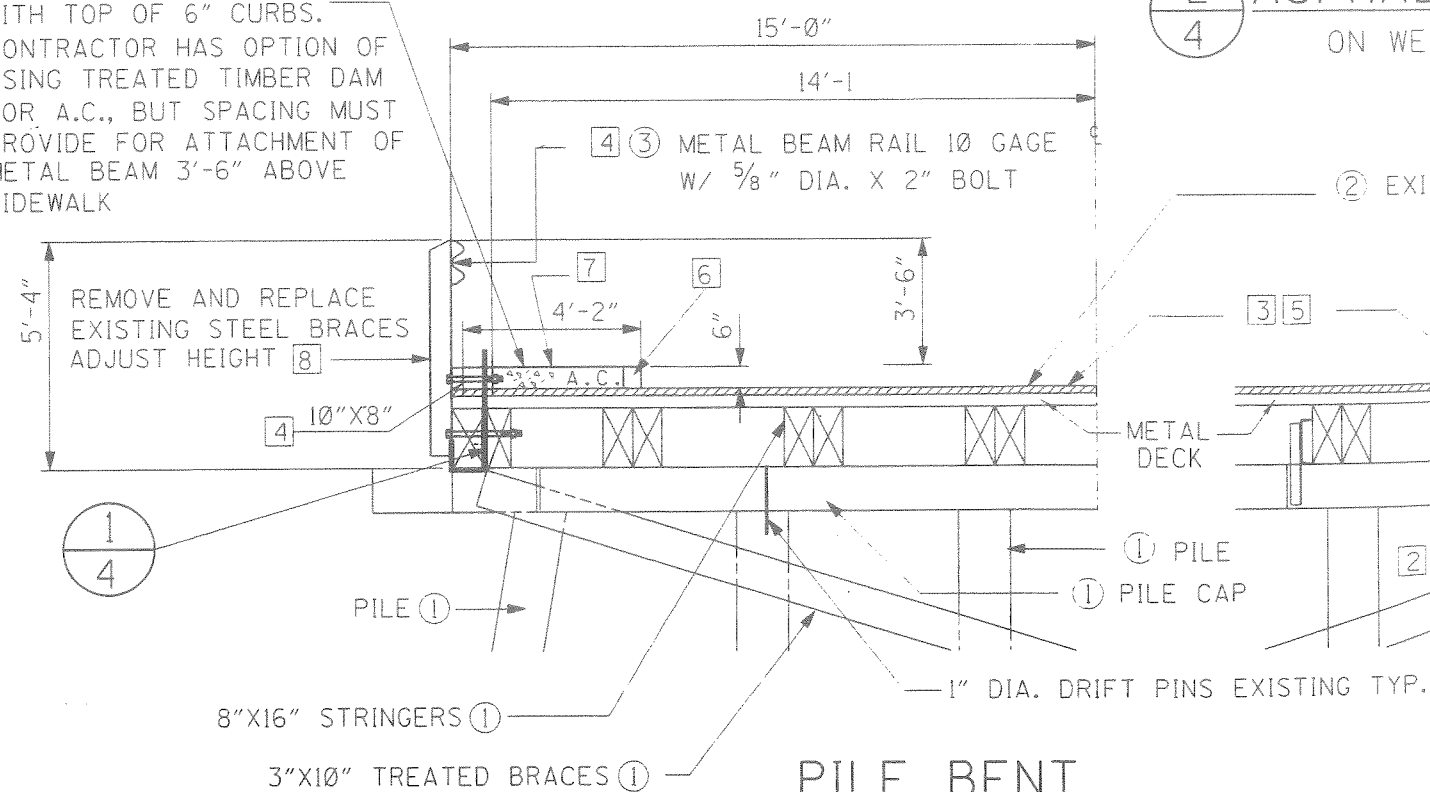


PILE BENT
TYP

CONSTRUCTION NOTES

- 1 PROVIDE A DEBRIS CATCHING DEVICE TO KEEP DEBRIS AND MATERIAL OUT OF BOLSA CHICA CHANNEL PER DETAIL SHEET 4.
- 2 REINFORCE BENT 15 PER PLAN AND DETAILS SHEET 3 (LENGTH=60').
- 3 REPLACE EXISTING 2"X6"X30' STEEL DECK WITH GALV. 12 GAGE 2"X6"X30' ARCO BRIDGE DECK PER PLAN, AND DETAIL SHEETS 4 AND 5.
- 4 INSTALL TREATED 6"X6" AND 3"X6" SPACERS PER PLAN AND DETAILS SHEET 4.
- 5 SURFACE GALV. STEEL DECK WITH 4" ASPHALT PER PLAN AND DETAIL SHEET 4.
- 6 CONST. 317.47 L.F. 6" ASPHALT CURB TYPE C2 PER STD. PLAN APWA 131-0 & DETAIL SHT. 4.
- 7 CONSTRUCT 6" A.C. SIDEWALK PER PLAN AND DETAIL SHEET 4.
- 8 REINSTALL SALVAGED BRIDGE RAILING PER PLAN AND DETAIL SHEET 4.

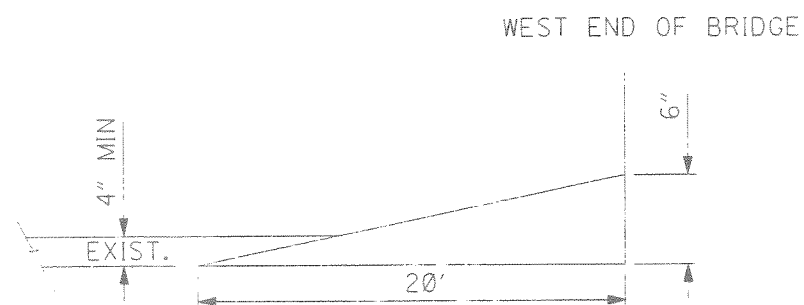

2 ASPHALT RAMP (SIDEWALK)
ON WEST END OF BRIDGE

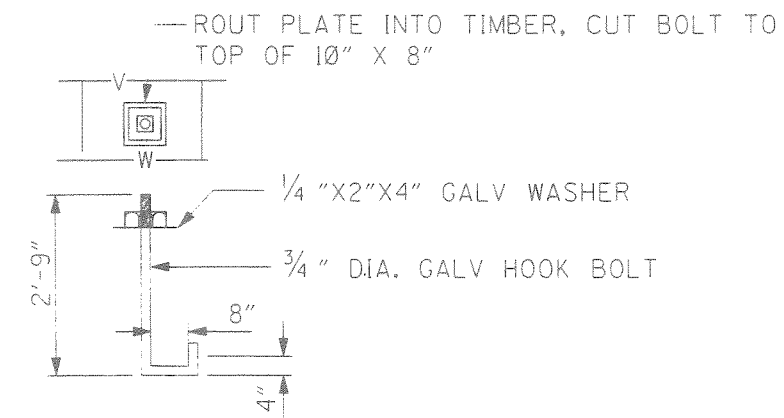

1 HOOK BOLT

LEGEND

- 1 PROTECT
- 2 REMOVE
- 3 REMOVE & SALVAGE
- NEW A.C.

REVISIONS			
SYM.	DESC.	APPD.	DATE

ORANGE COUNTY
RESOURCES & DEVELOPMENT MANAGEMENT DEPARTMENT

TEMPORARY REFURBISHMENT
AND DECK REPLACEMENT
OF EDINGER AVENUE BRIDGE

STRUCTURAL DETAILS

PREPARED UNDER SUPERVISION J.D.S. DATE

DATE
3/2005

DRAWN N.Z.
CHECKED J.D.S.

SHEET
4
OF 5

