

W.O. NO. ER03584
SEPTEMBER 2007

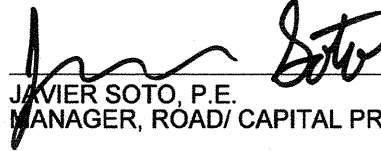
FUNDED BY: COUNTY OF ORANGE
MAINTAINED BY: COUNTY OF ORANGE

No As-Built Changes

AS BUILT

CORRECTIONS BY _____
CONTRACT NO. _____
DATE _____

RESOURCES AND DEVELOPMENT MANAGEMENT DEPARTMENT

SUBMITTED:  JAVIER SOTO, P.E.
MANAGER, ROAD/CAPITAL PROJECTS

 No. 56938
Exp. 6/26/02
CALIF. CIVIL ENGINEER
STATE OF CALIFORNIA

7/23/07
DATE

RECOMMENDED:  TED RIGONI, P.E., PMP
MANAGER, ROAD DIVISION

7/23/07
DATE

APPROVED:  IGNACIO G. OCHOA, P.E.
DIRECTOR PUBLIC WORKS/ CHIEF ENGINEER

7/23/07
DATE

INDEX OF SHEETS	
SHEET	DESCRIPTION
1	TITLE SHEET
2	DETAIL SIGNING & STRIPING PLAN
3	GENERAL PLAN
4	PILE REPAIR DETAILS
5	PIER RETROFIT DETAILS

UTILITY OWNER	PHONE NO.	CONTACT
SOUTH COAST WATER DISTRICT	(949) 499-4555	BOB CLARK
BP PIPELINES	(562) 499-2216	ROB STREED
THE GAS COMPANY	(714) 634-5016	FRANK WINN
VERIZON	(714) 735-6718	ROBERT FLORES
TIME WARNER CO.	(714) 903-8341	JIM SCOTT
S. CALIFORNIA EDISON CO.	(714) 895-0288	PLANNING SUP.
CITY OF HUNTINGTON BEACH	(714) 536-5341	DAVE WEBB
CITY OF HNTB, WATER DEPT.	(714) 536-5259	STEVE KRIEGER
CITY OF HNTB, SEWER DEPT.	(714) 374-1706	RON RATHBUN

BENCH MARK:

BASIS OF BEARINGS:

[illegible]

W. O. NO. ER03584

DWG. NO.

SHEET 1 OF 5