



MARK	DESCRIPTION	DATE	APPR.


PREPARED UNDER THE RESPONSIBLE CHARGE OF:

R. HOISINGTON
DATE: 8/13/2007

DESIGNED BY: C. PHUNG
DRAWN BY: J. VILLALOBOS / C. PHUNG
CHECKED BY: R. HOISINGTON
DRAWING CODE:
FILE NAME:
PLOT DATE: 8/13/2007
SCALE: 1" = 40'

ORANGE COUNTY
RESOURCES & DEVELOPMENT
MANAGEMENT DEPARTMENT
PREPARED BY:
BRIDGE DESIGN SECTION

PILE REPAIR AT BENT 15
FOR THE
EDINGER AVENUE BRIDGE
OVER
BOLSA CHICA CHANNEL

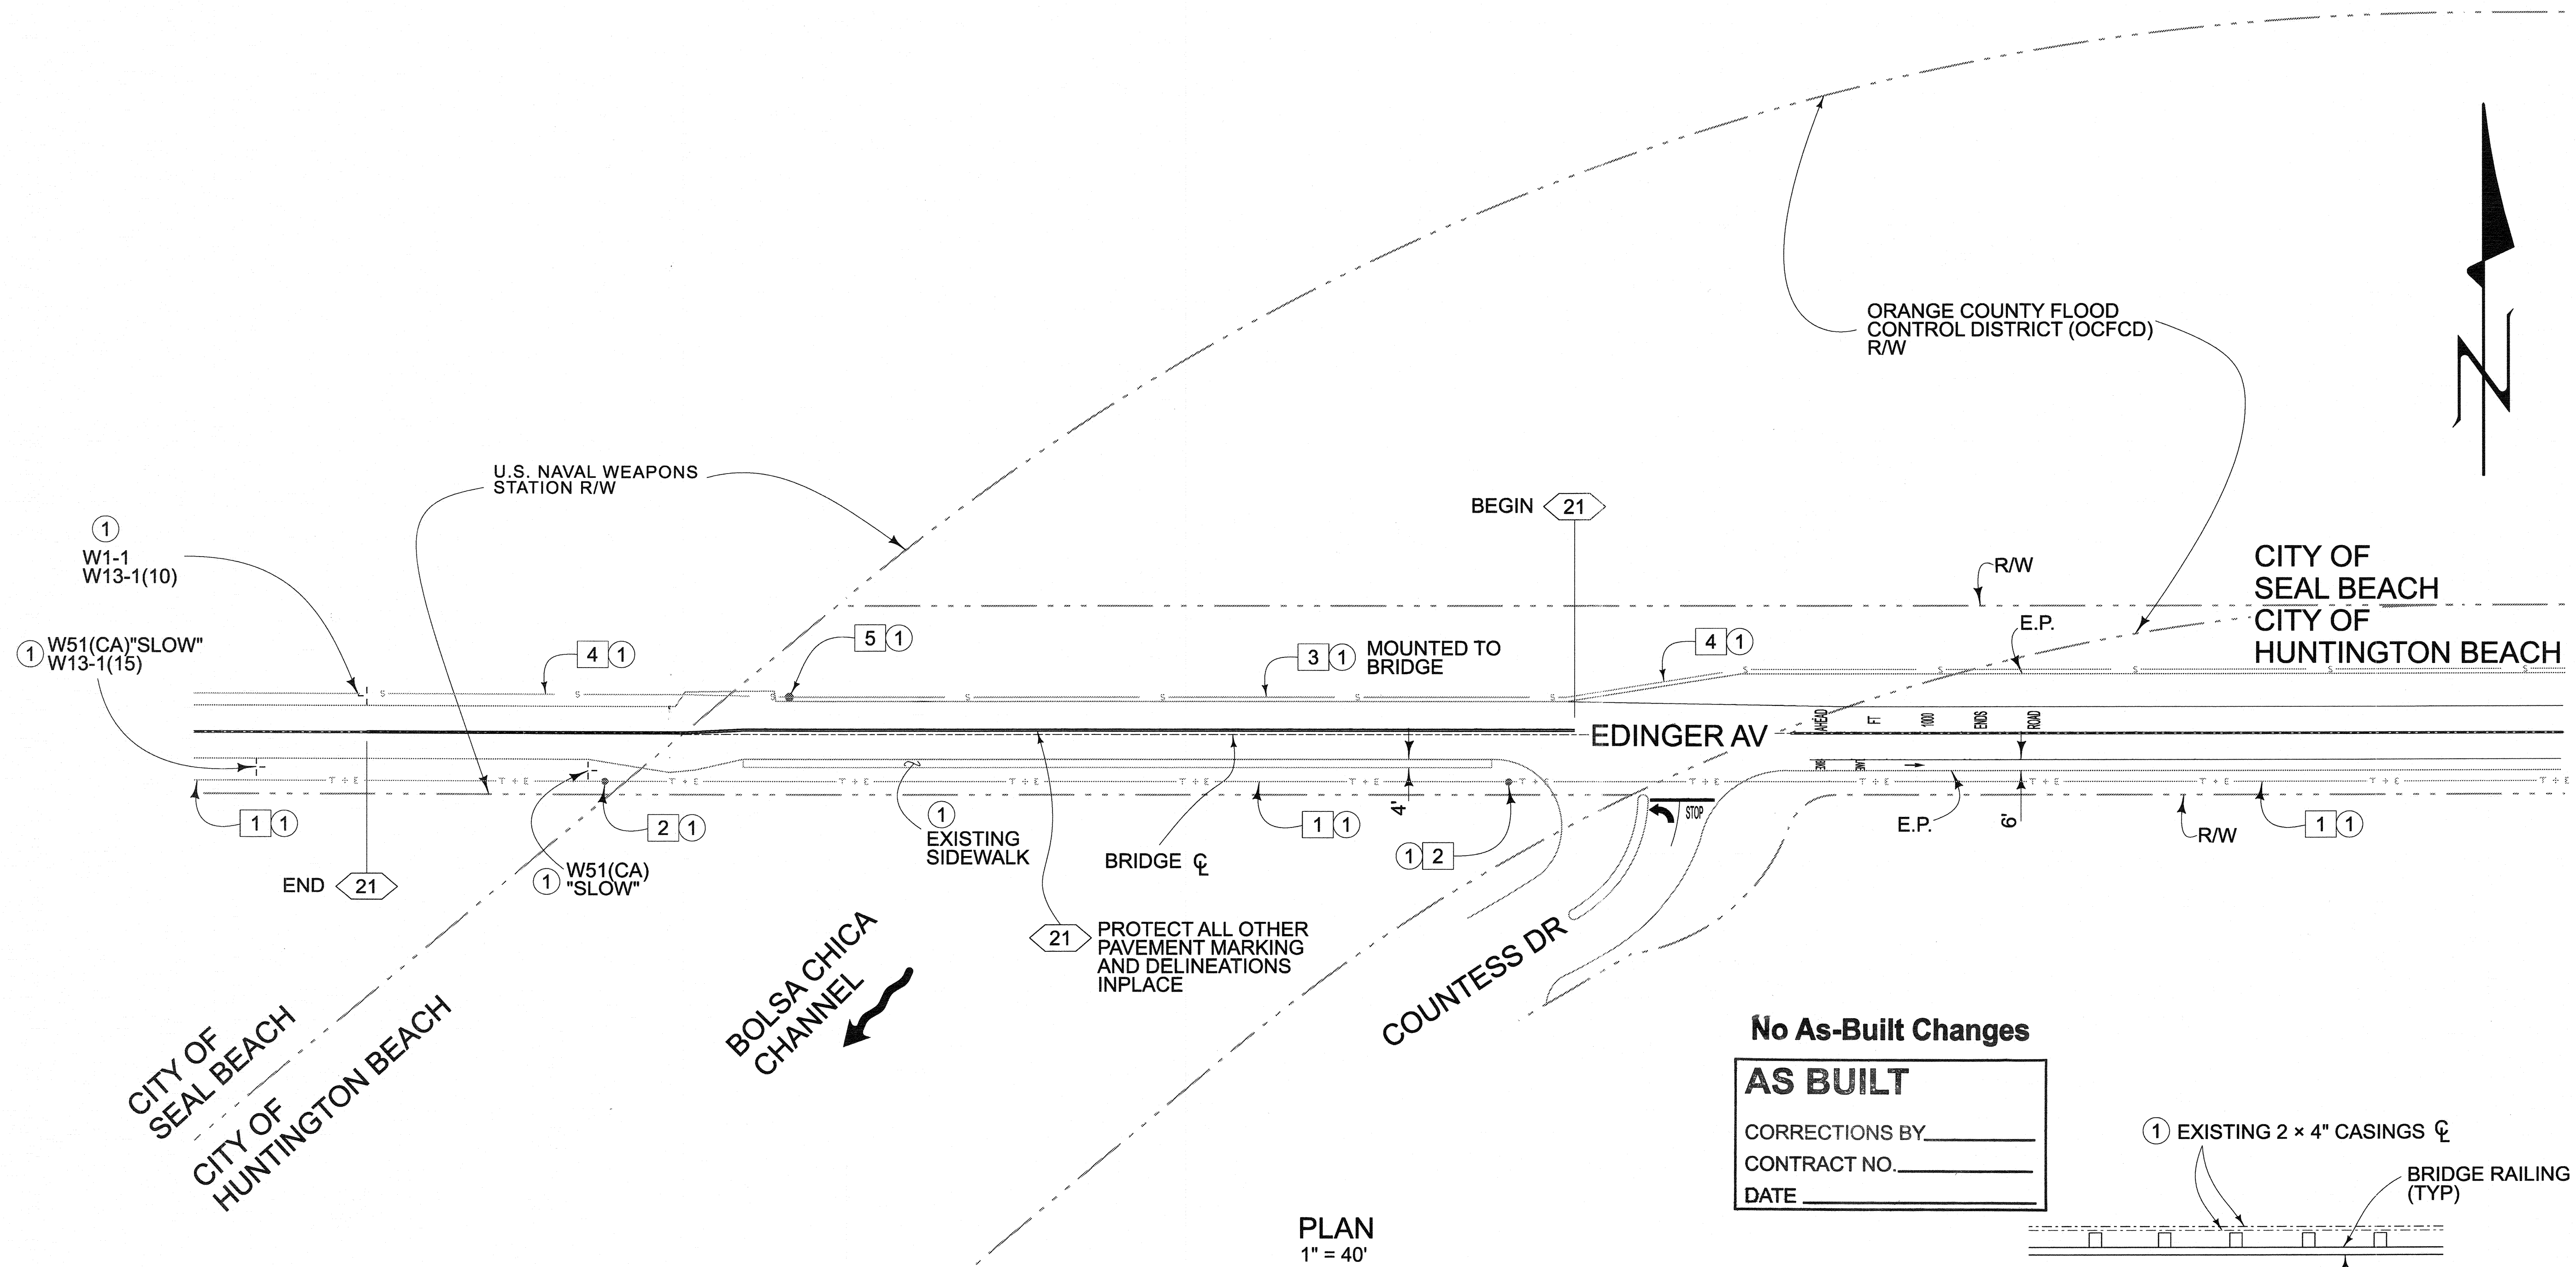

PLAN
1" = 40'

UTILITIES

- 1 EXISTING OVERHEAD POWER & PHONE LINES (SCE + SBC)
- 2 EXISTING POWER POLE (SCE)
- 3 EXISTING CITY OF HB 2 x 2" SEWER FORCEMAIN IN 2 x 4" EXPOSED ENCASINGS MOUNTED TO BRIDGE
- 4 EXISTING CITY OF HB 2x2" & 1x4" UNDERGROUND SEWER FORCEMAIN
- 5 EXISTING CITY OF HB 2x1" AIR VALVE IN 20"Ø EXPOSED VENT PIPE

LEGEND:

- 1 PROTECT IN PLACE
- xx CALTRANS STANDARD PLANS PAVEMENT MARKERS AND TRAFFIC LINES DETAIL NUMBER SHEET A20A & A20B


No As-Built Changes

AS BUILT

CORRECTIONS BY: _____

CONTRACT NO. _____

DATE _____

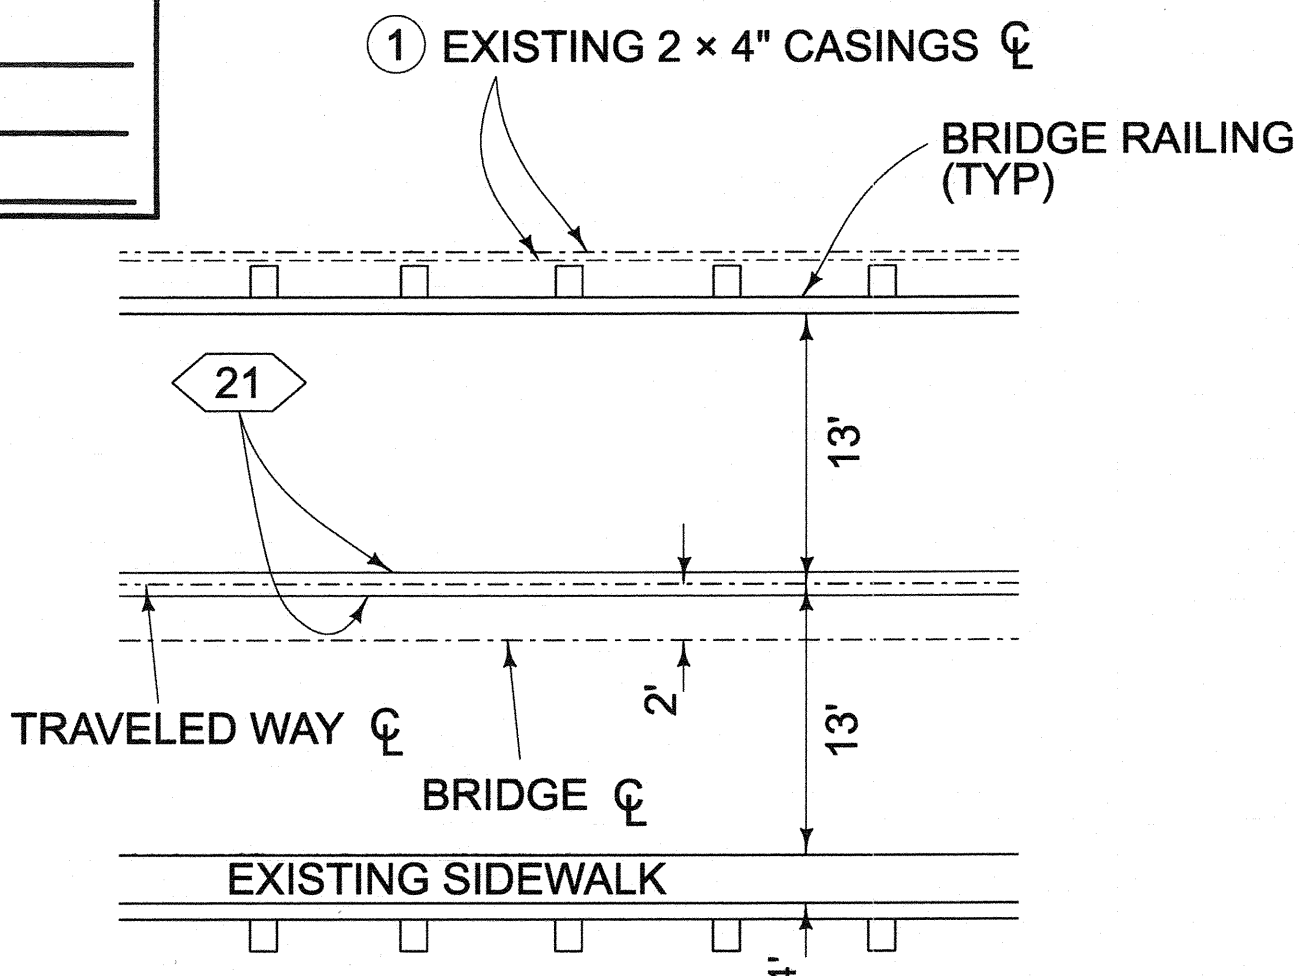

STRIPING DETAIL
NTS

CONSTRUCTION NOTES :
1. ALL SIGNS ARE EXISTING/PROTECT IN PLACE