


CORRECTIONS BY _____
CONTRACT NO. _____
DATE _____

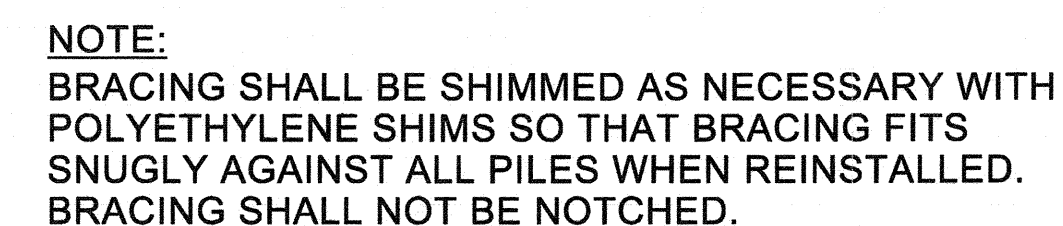

NOT TO SCALE

1. INSTALL NEW GALVANIZED HARDWARE FOR POSTED PILES, NEW TIMBER BRACE, AND PILE CAP SPLICE
2. POLYETHYLENE PILE COVER AND LINER:
PILE COVERS SHALL BE 160 MIL BLACK POLYETHYLENE. LINER SHALL BE 6 MIL POLYETHYLENE. THE CONTRACTOR SHALL INSTALL PILE COVERS AND LINERS TO OBTAIN A TIGHT FIT WITHOUT FISH MOUTHS AT JOINTS. LINER SHALL BE FITTED SNUGLY ENOUGH TO PRODUCE A NEAR AIR-TIGHT FIT. REMOVE KNOTS, MARINE GROWTH AND SURFACE OBSTRUCTIONS ON THE PILES AS NECESSARY TO ACHIEVE A SMOOTH TIGHT FIT. REFER TO THE SPECIFICATION FOR INSTALLATION.
3. DRILL MAX 2"Ø HOLE THROUGH EXISTING C12x28.9 AS CLOSE AS POSSIBLE TO MID-DEPTH TO INSTALL THESE LAG SCREWS AND TO LOOSEN AND RE-TIGHTEN BRACING. APPLY COLD DIP GALVANIZING TO EXPOSED METAL.

CONTRACTOR SHALL VERIFY ALL CONTROLLING FIELD DIMENSIONS BEFORE ORDERING OR FABRICATING ANY MATERIALS.

