

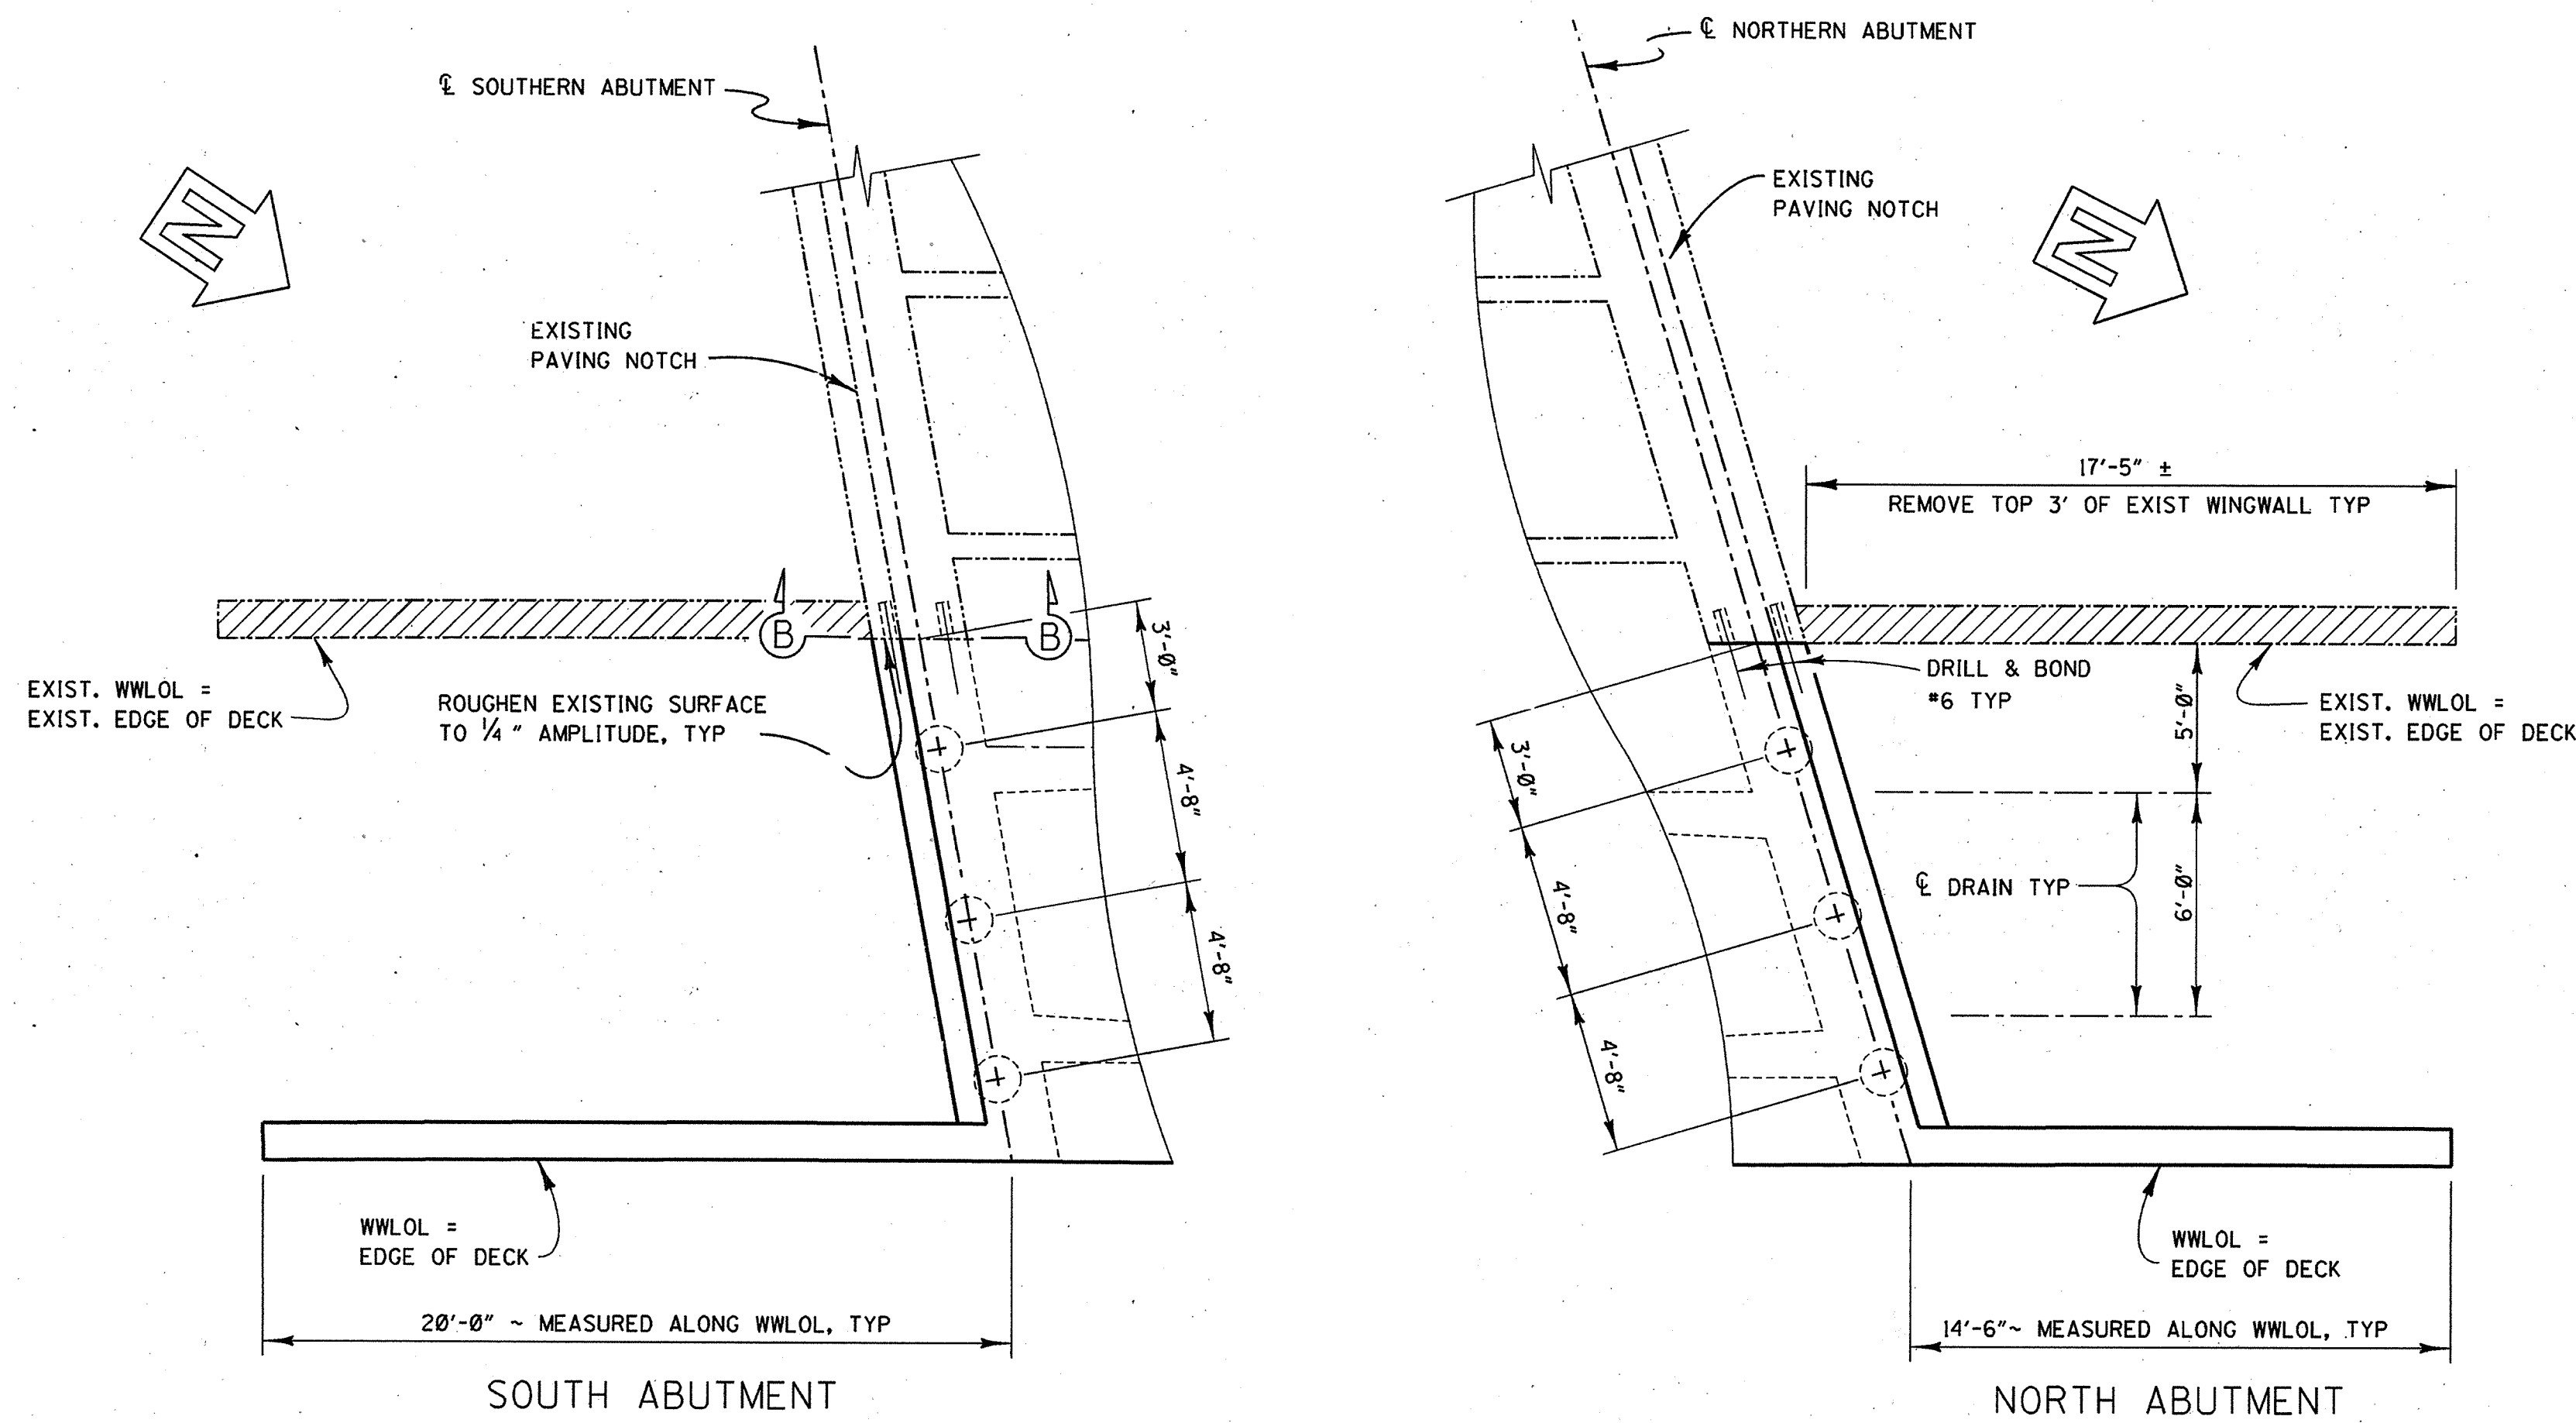
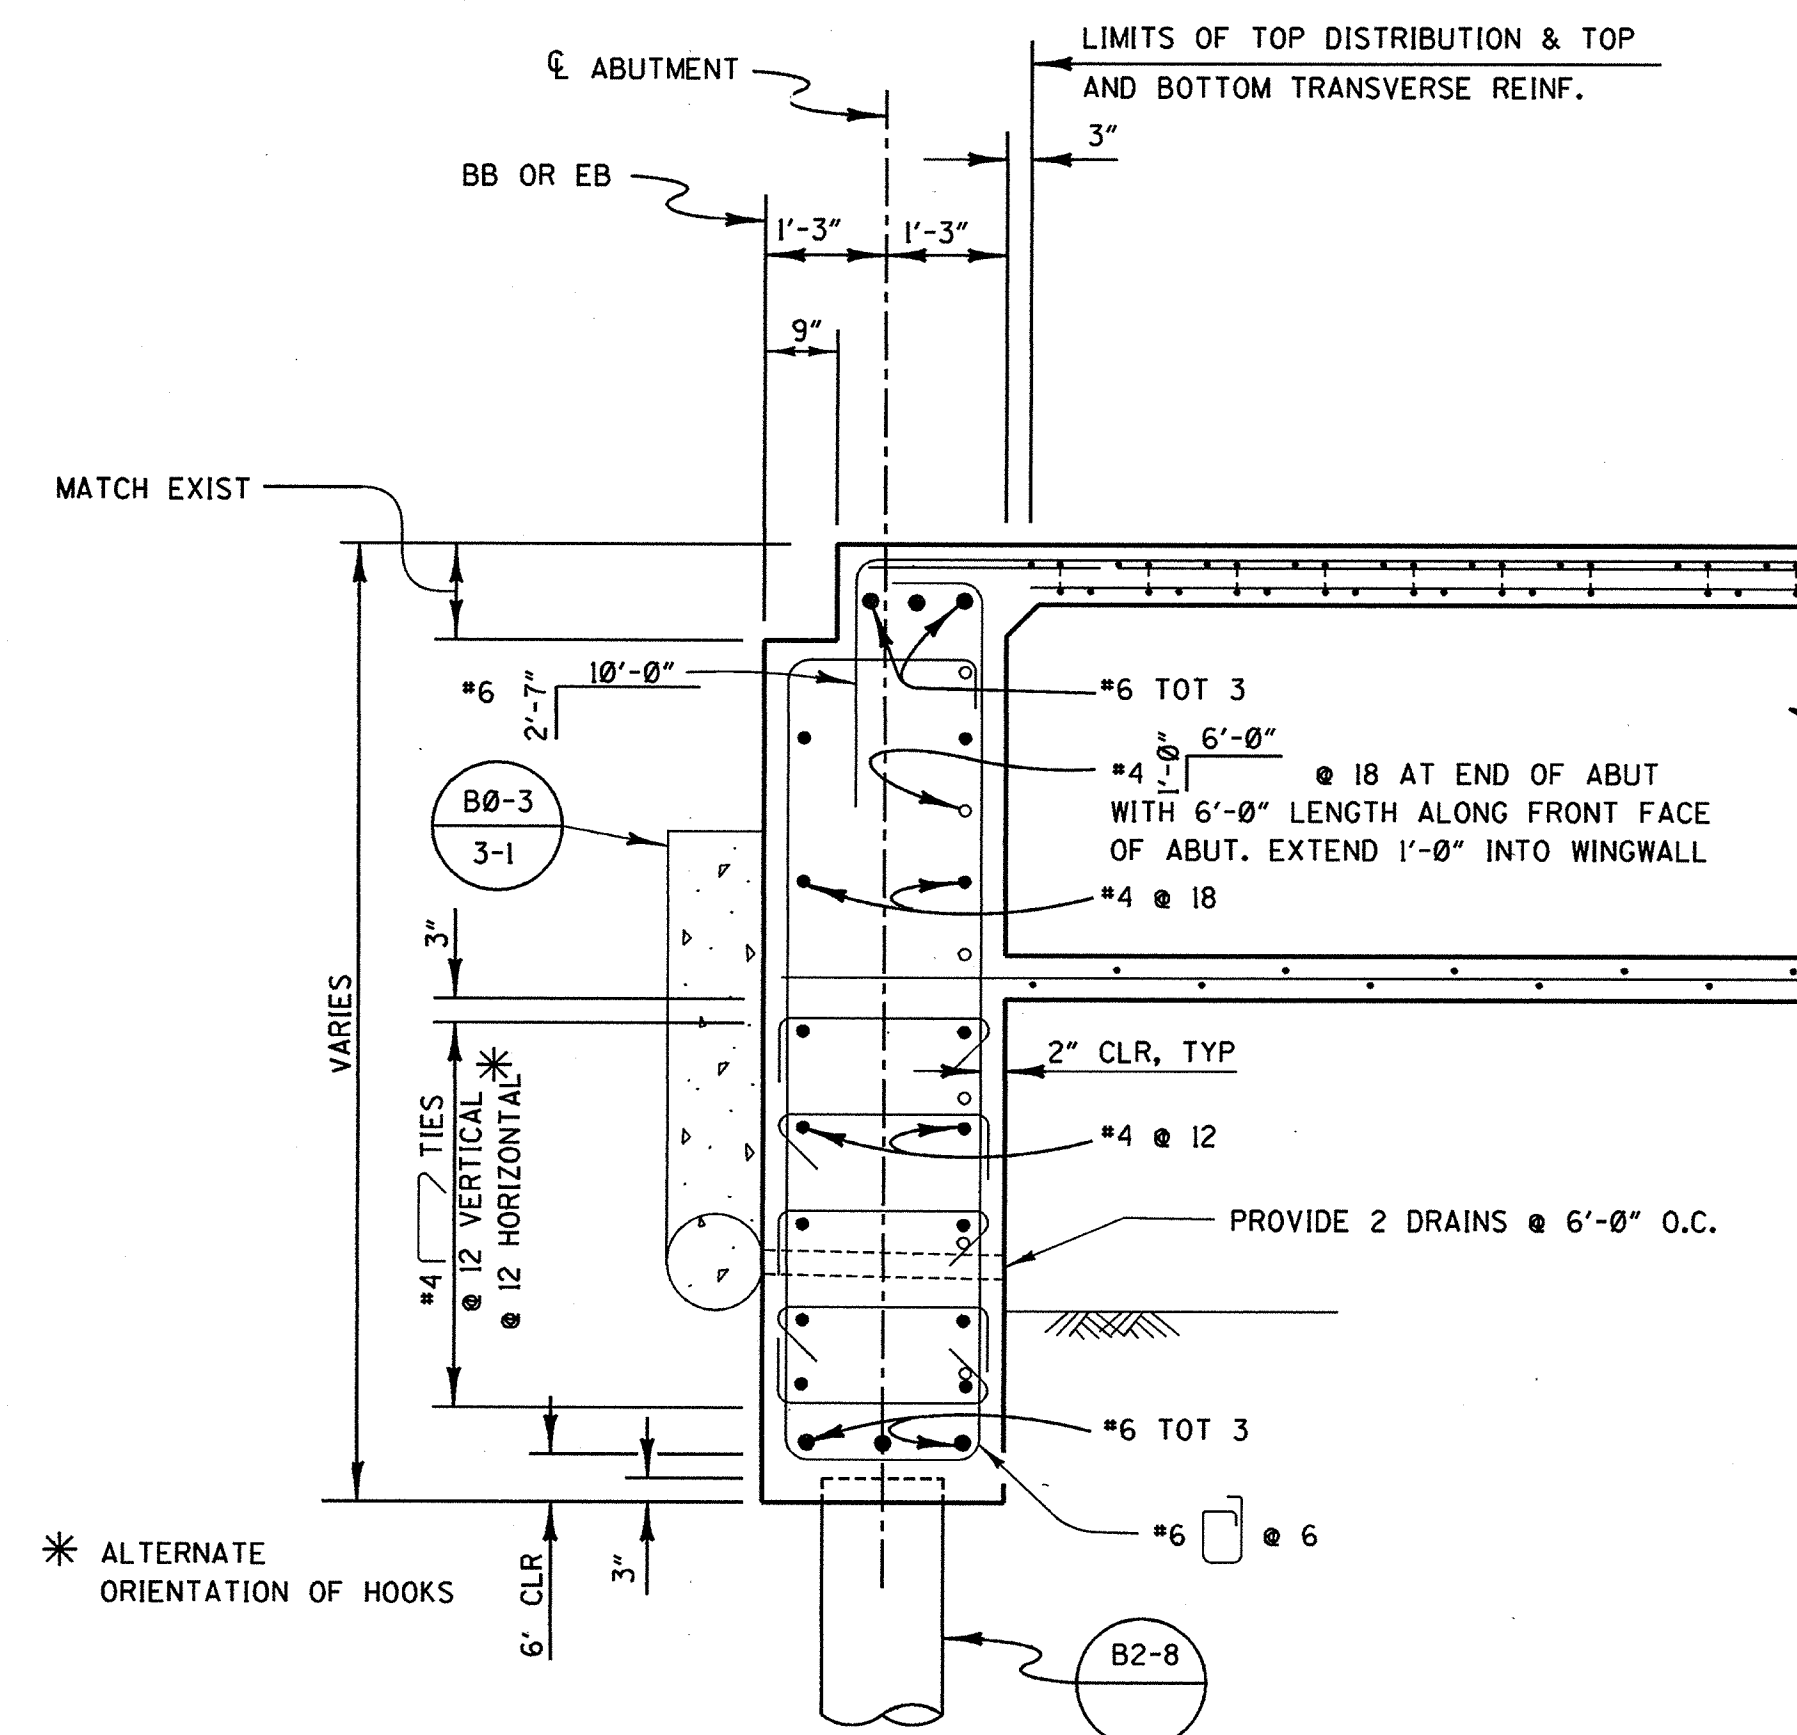
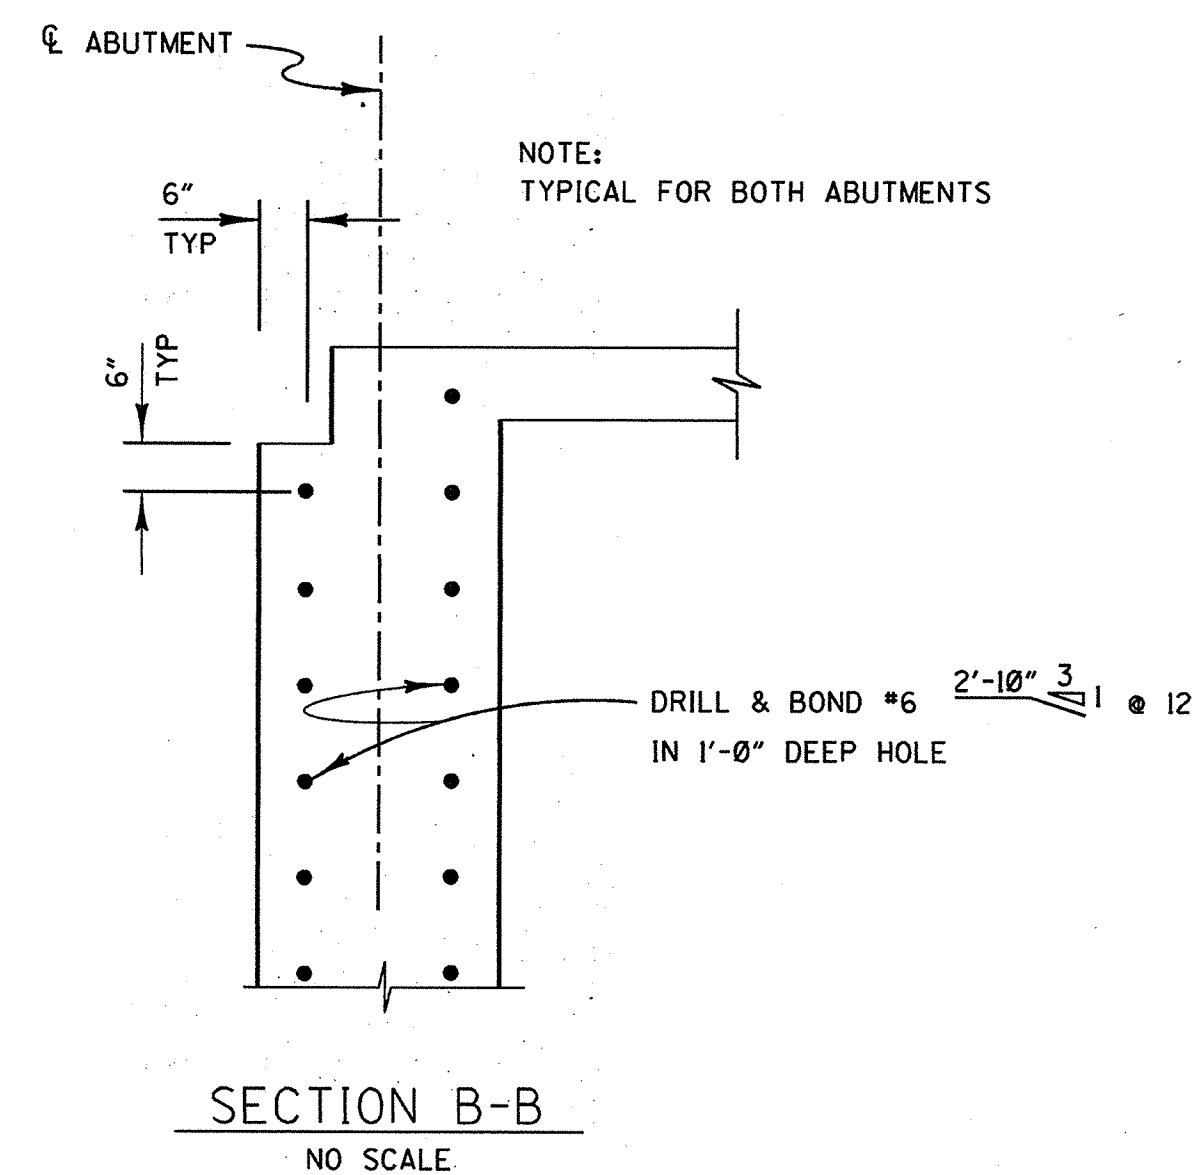


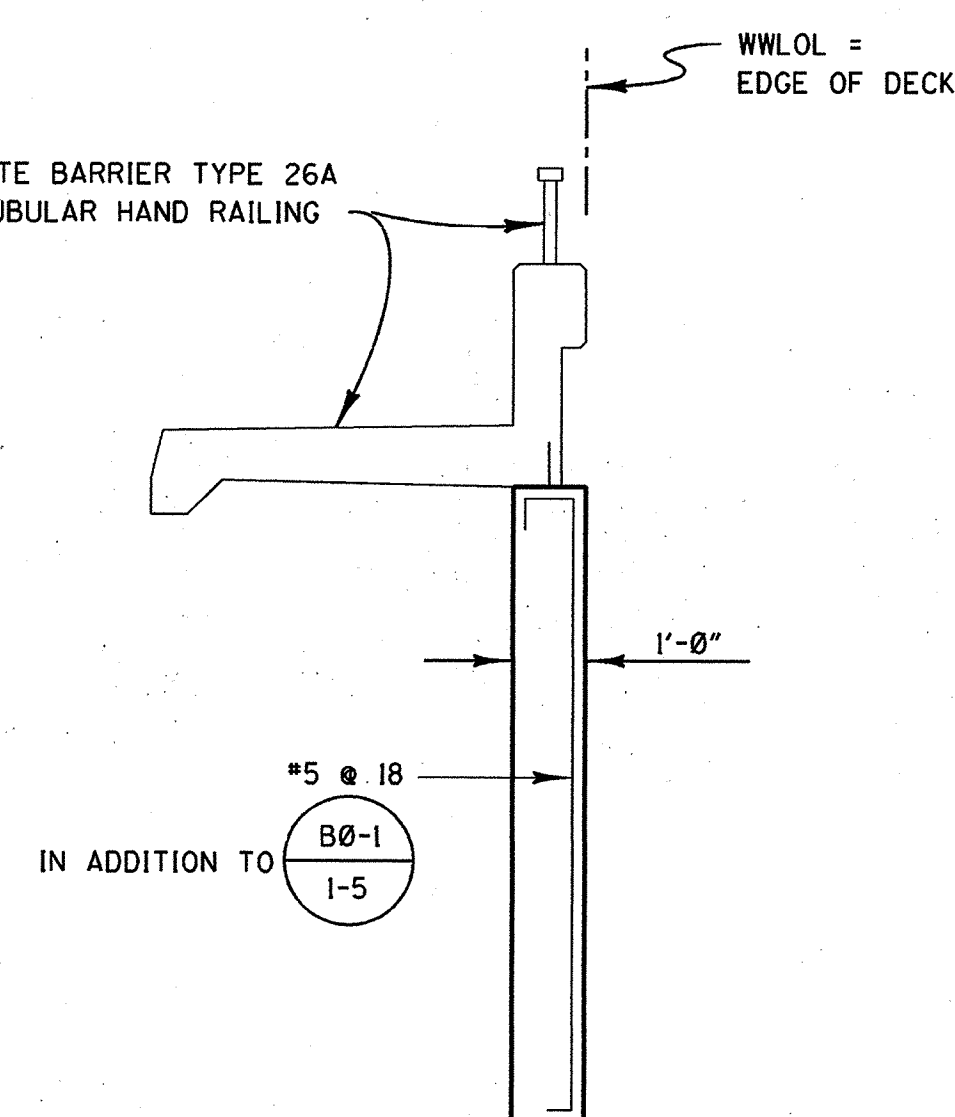


/// DENOTES LIMITS OF BRIDGE REMOVAL PORTION

PLAN
1/4" = 1'-0"

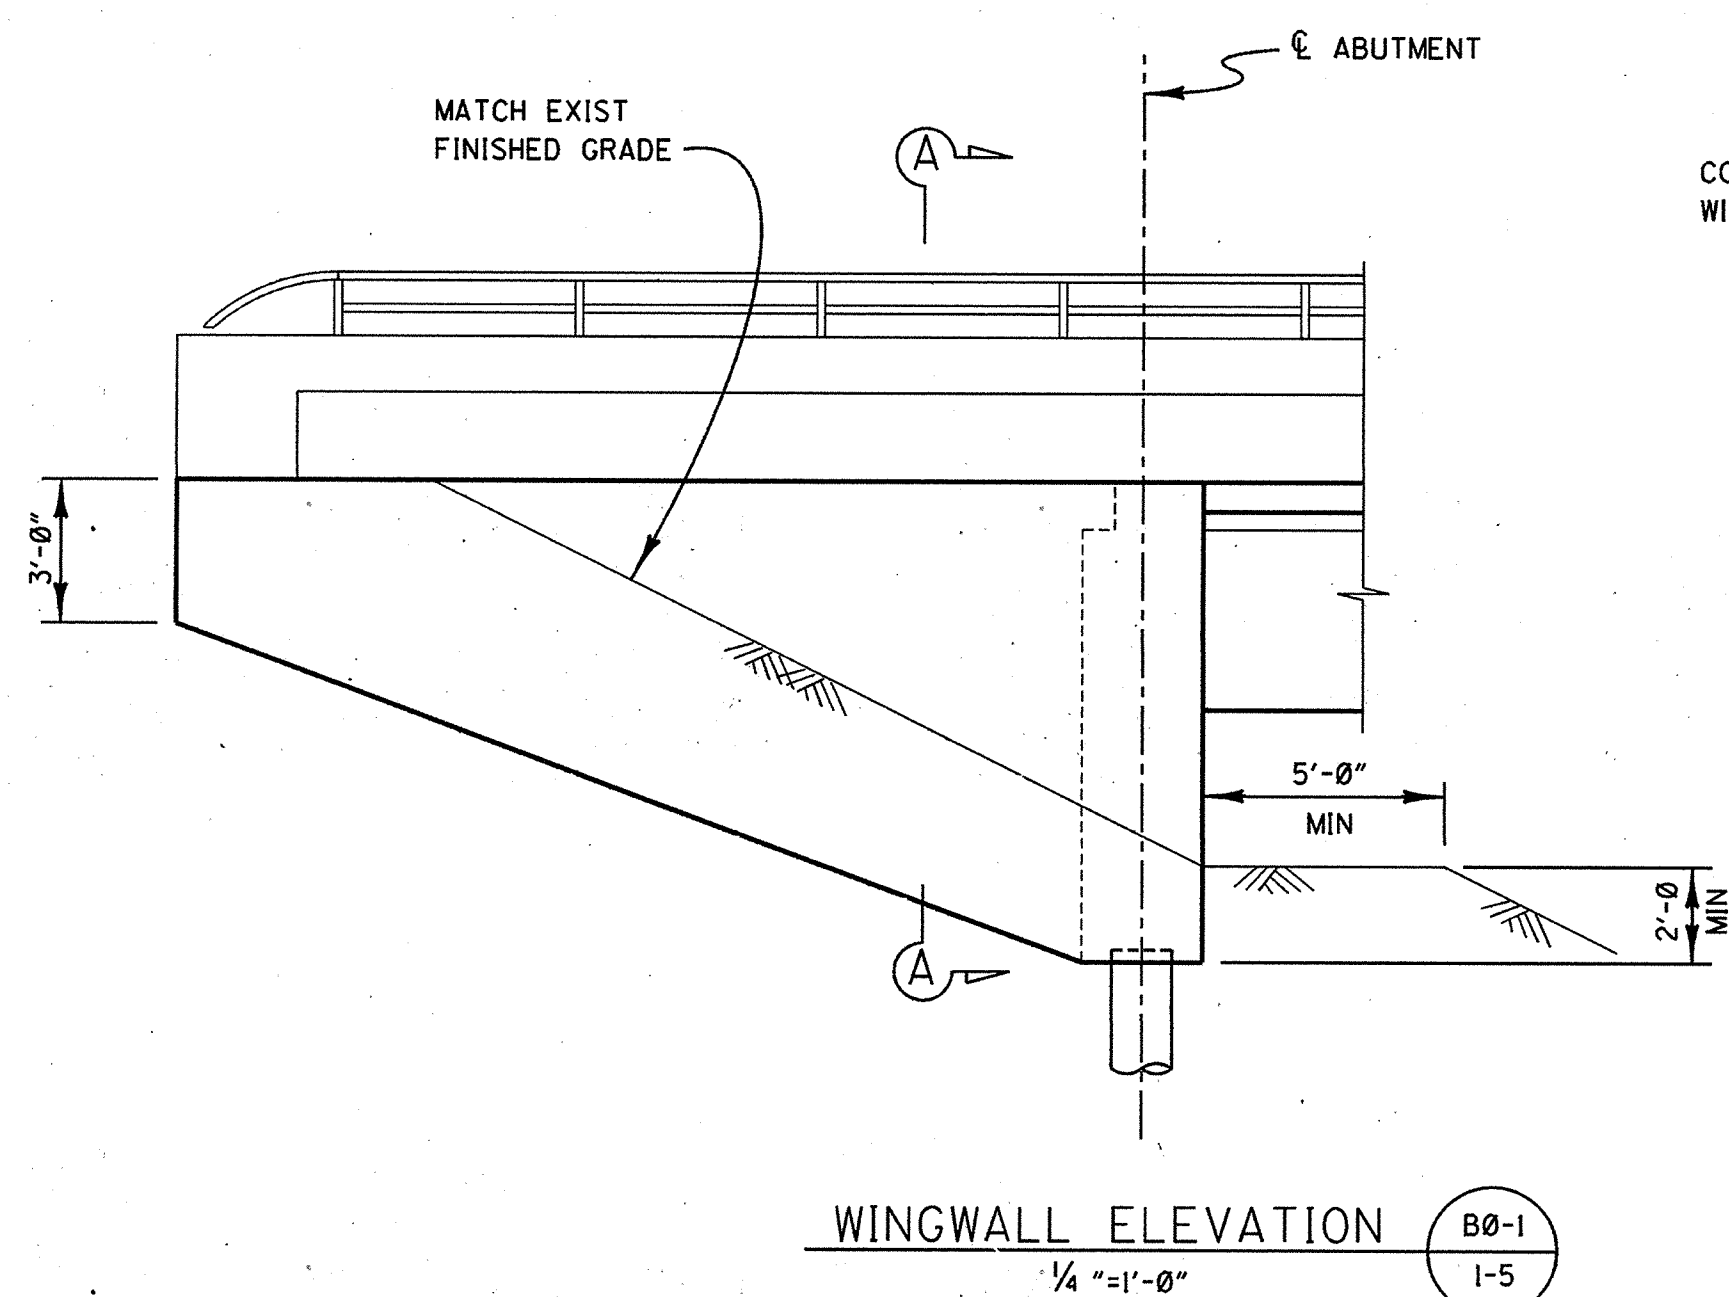

ORANGE COUNTY ENVIRONMENTAL MANAGEMENT AGENCY	
BRIDGE PLANS FOR PETERS CANYON CHANNEL OVERCROSSING (F06) WIDEN	
ABUTMENT DETAILS	
DESIGNED YOLANDA LABIA	SHEET 122
DRAWN G. BROWN	CHECKED CHING-FENG CHEN
SCALE AS SHOWN	DATE 6-97
DRAWING NO. F06-301-1	DATE 6-97

URS GREINER, INC.
1241 EAST DYER ROAD, SUITE 250
SANTA ANA, CALIFORNIA 92705-5605

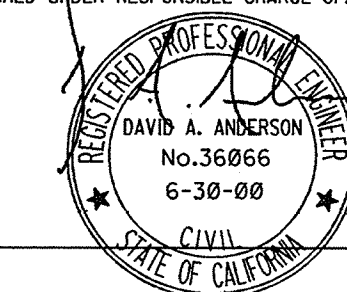

DE 1 46157