
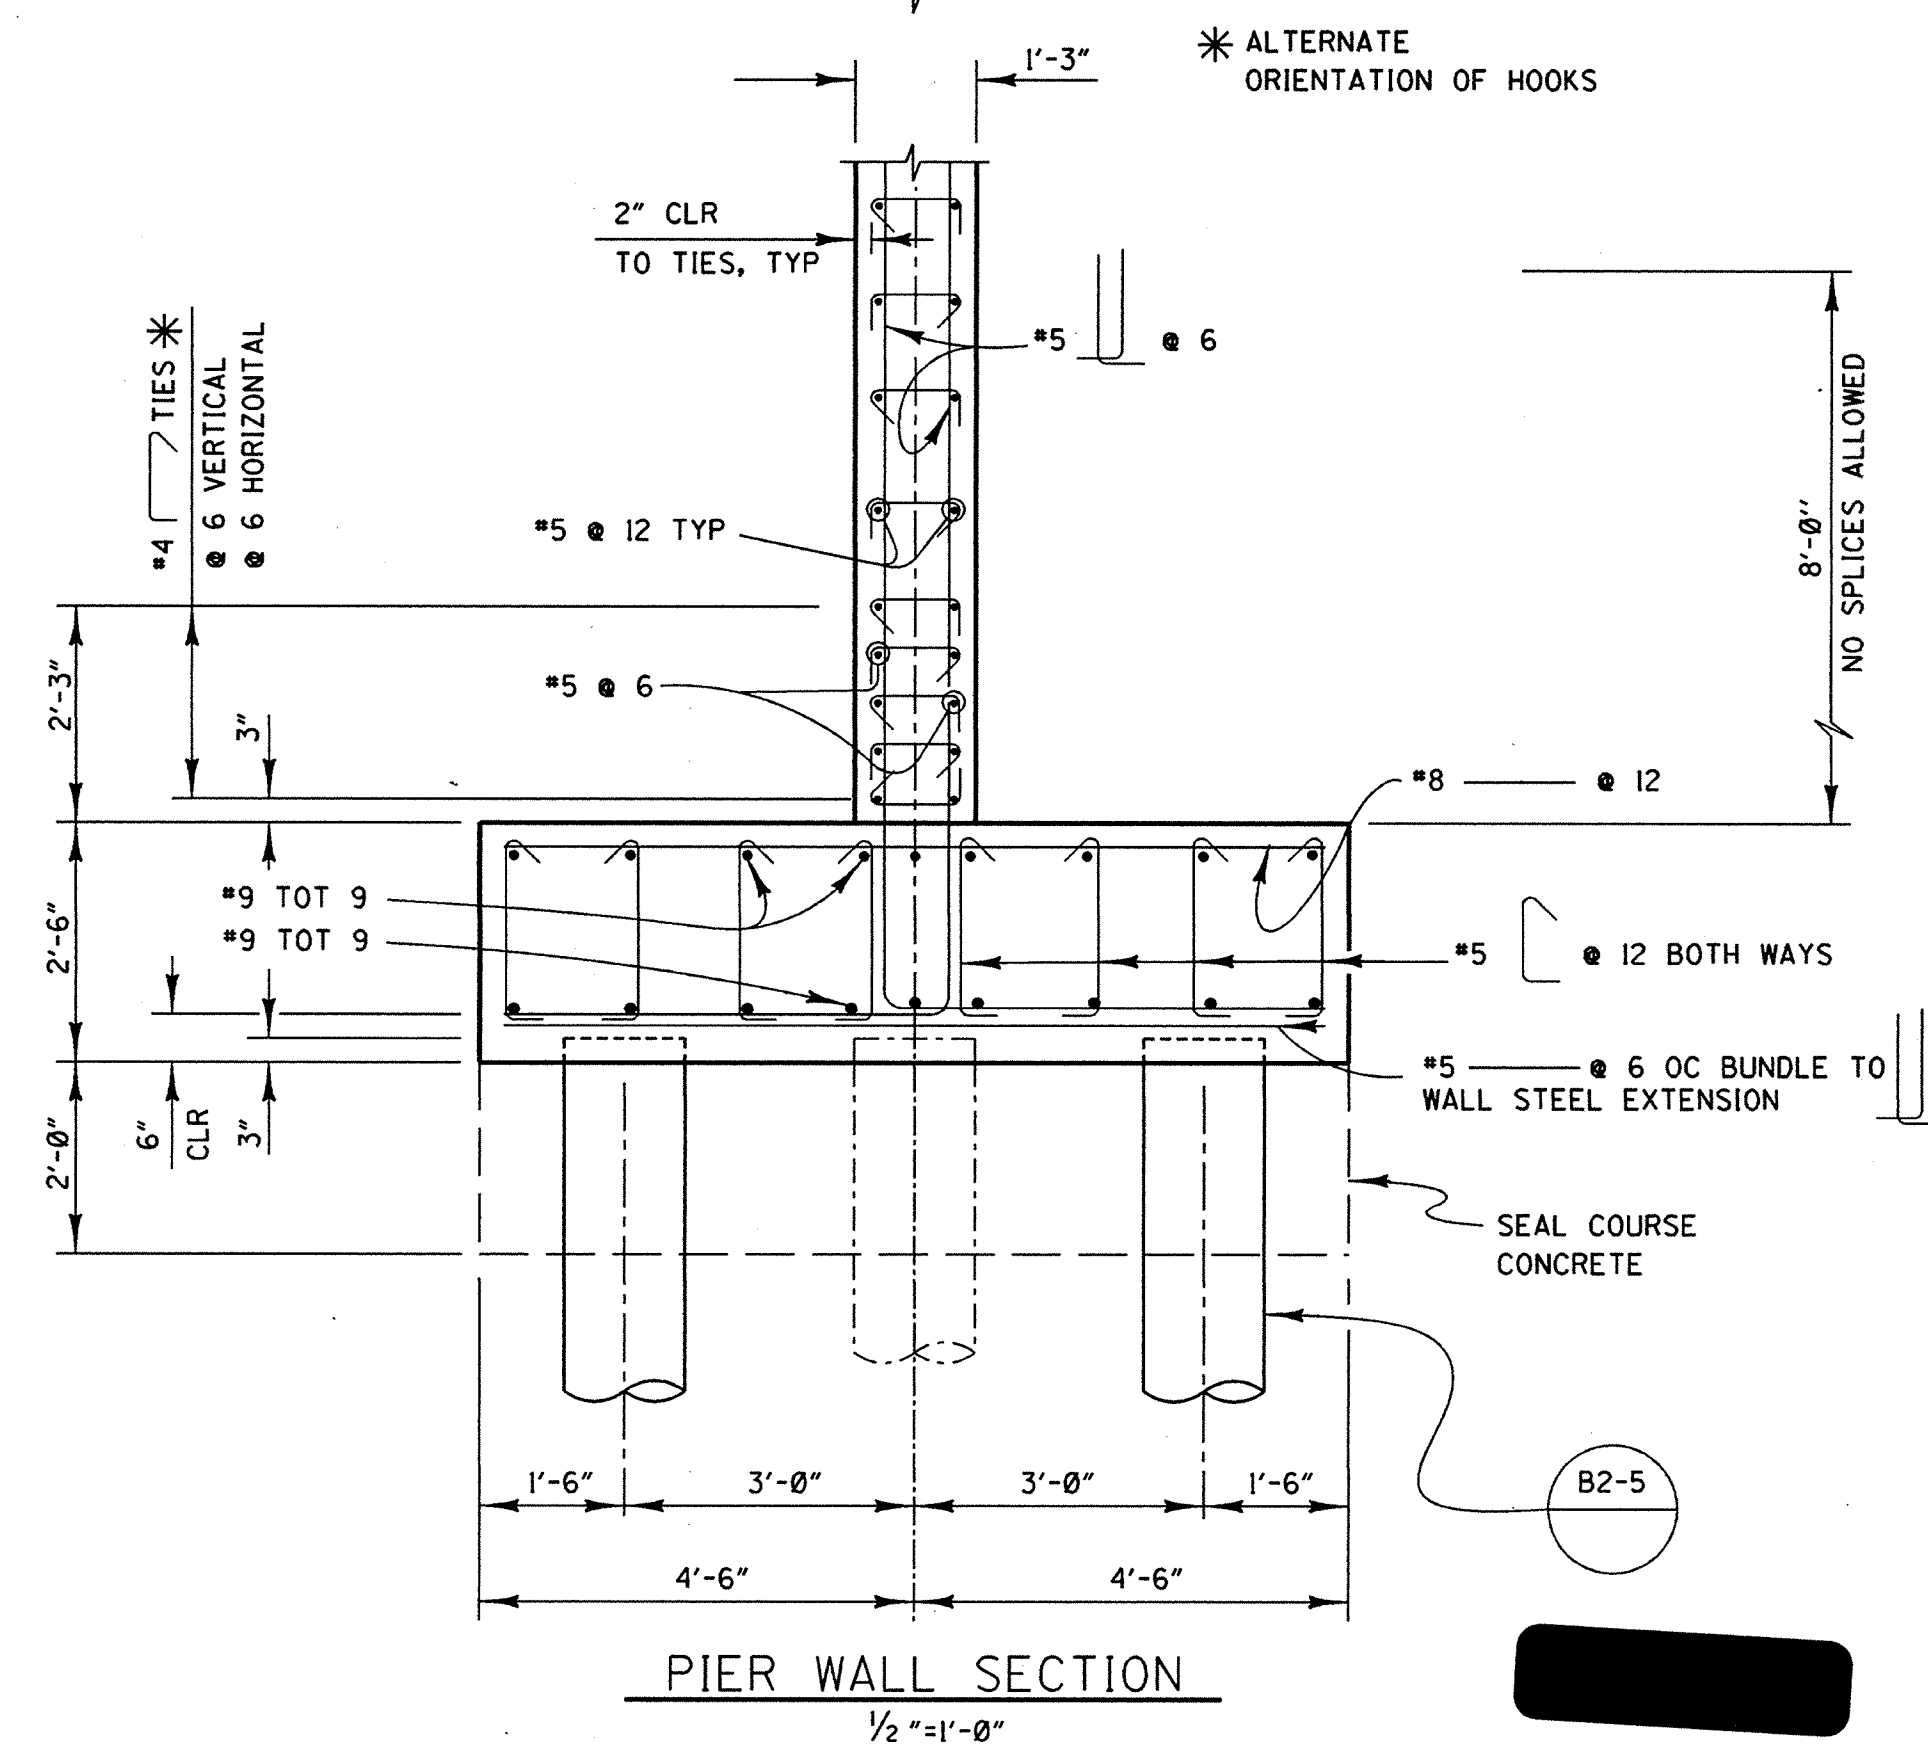
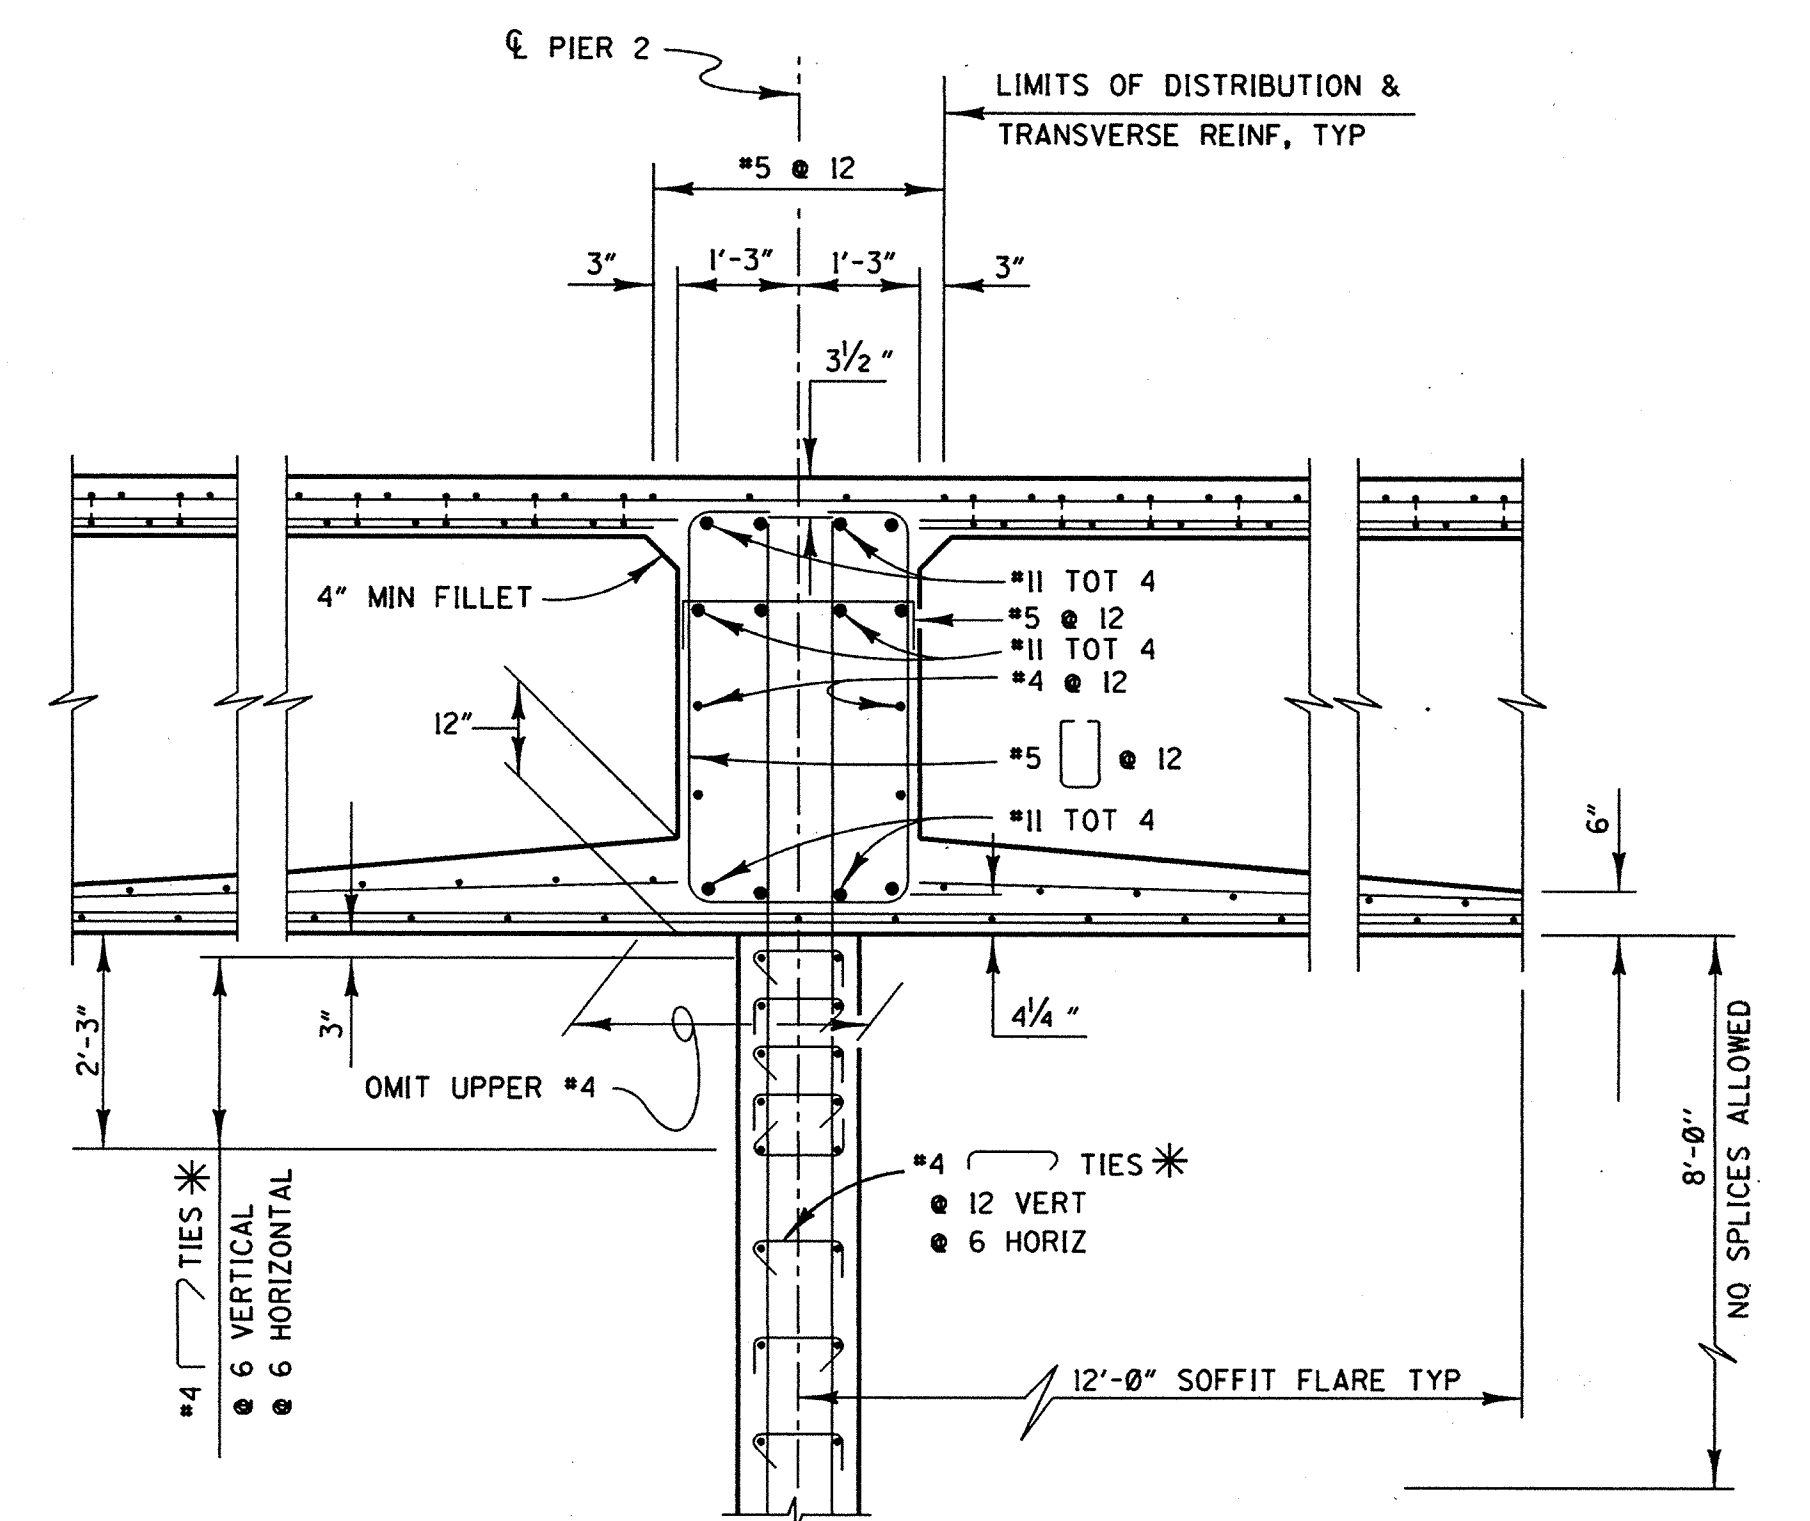
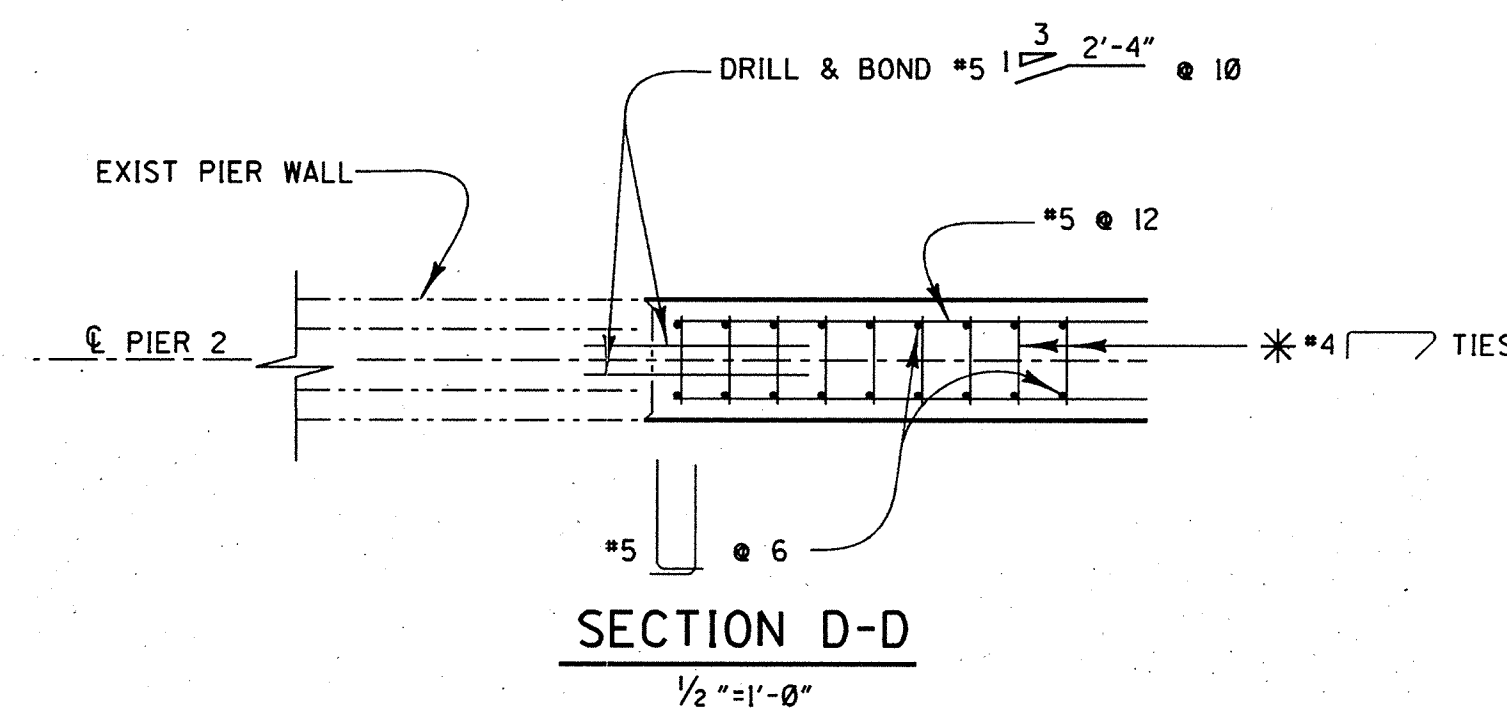
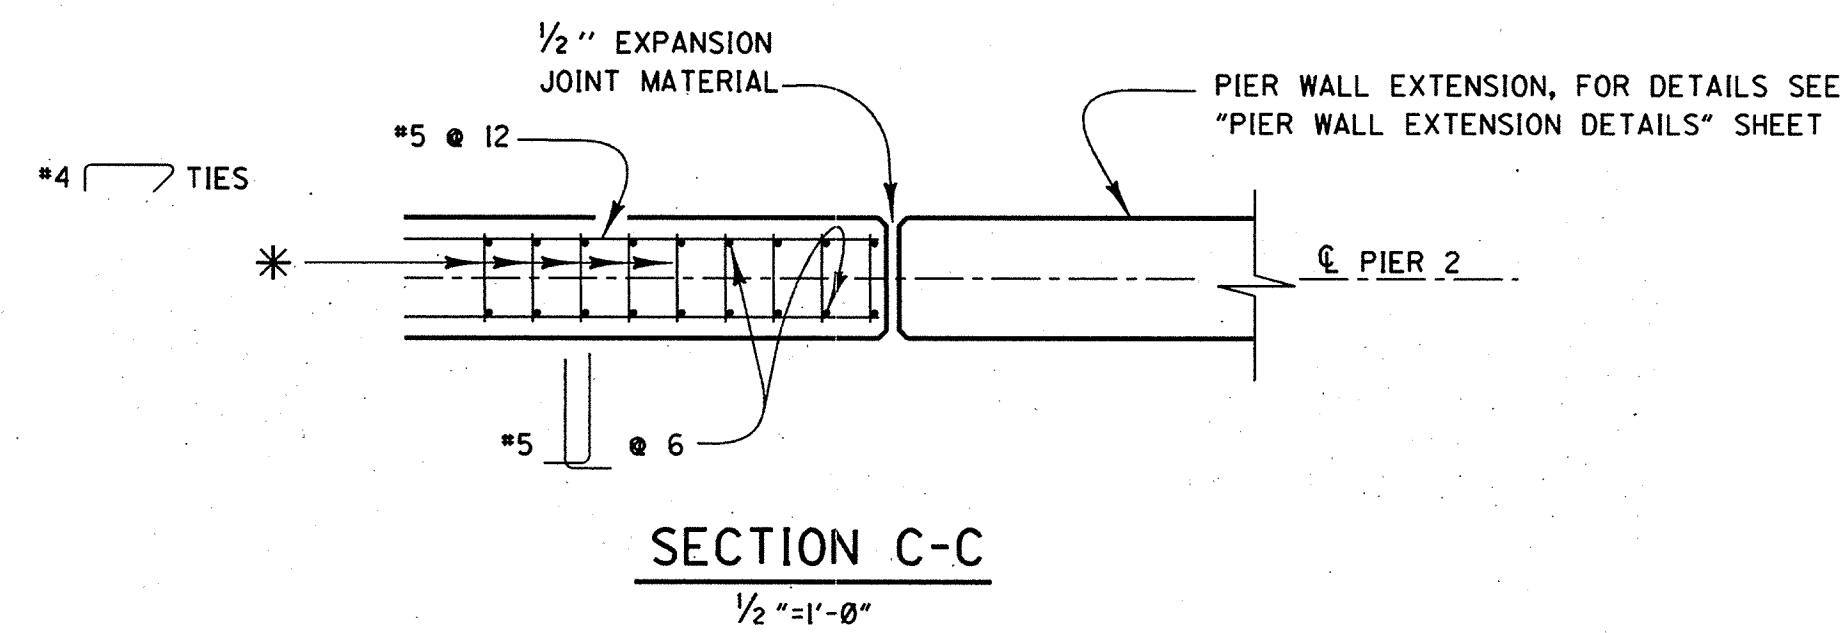
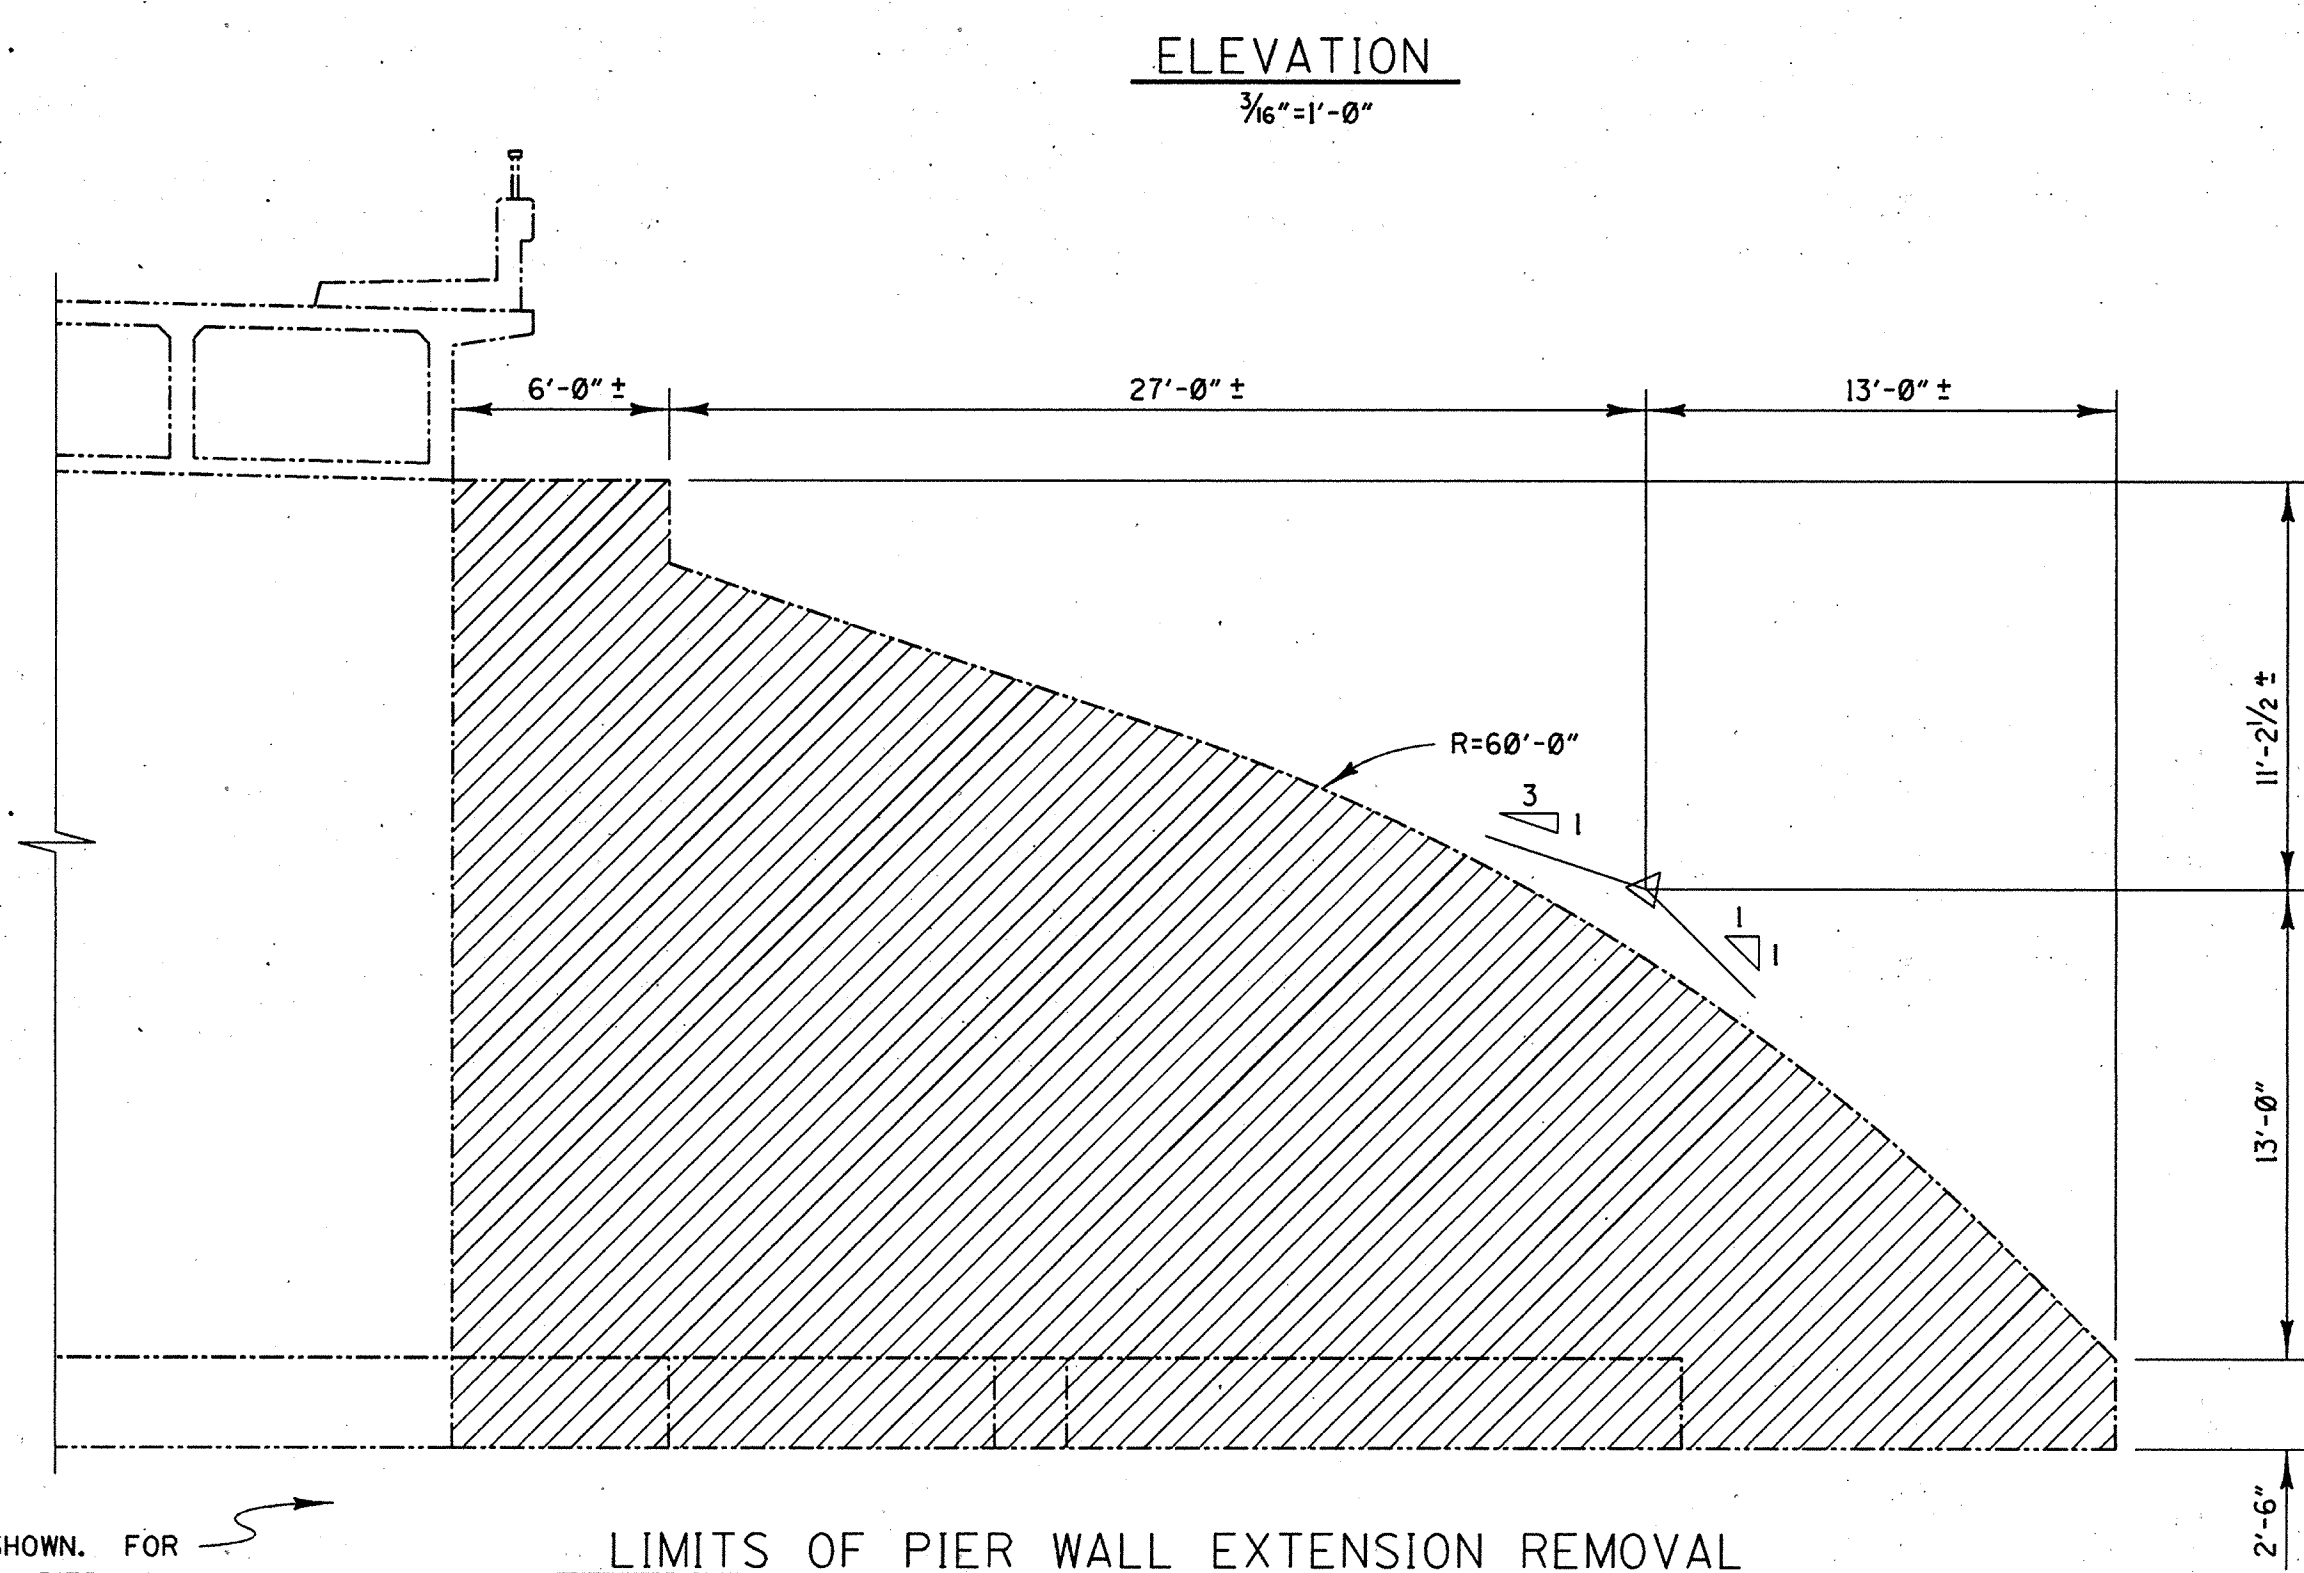
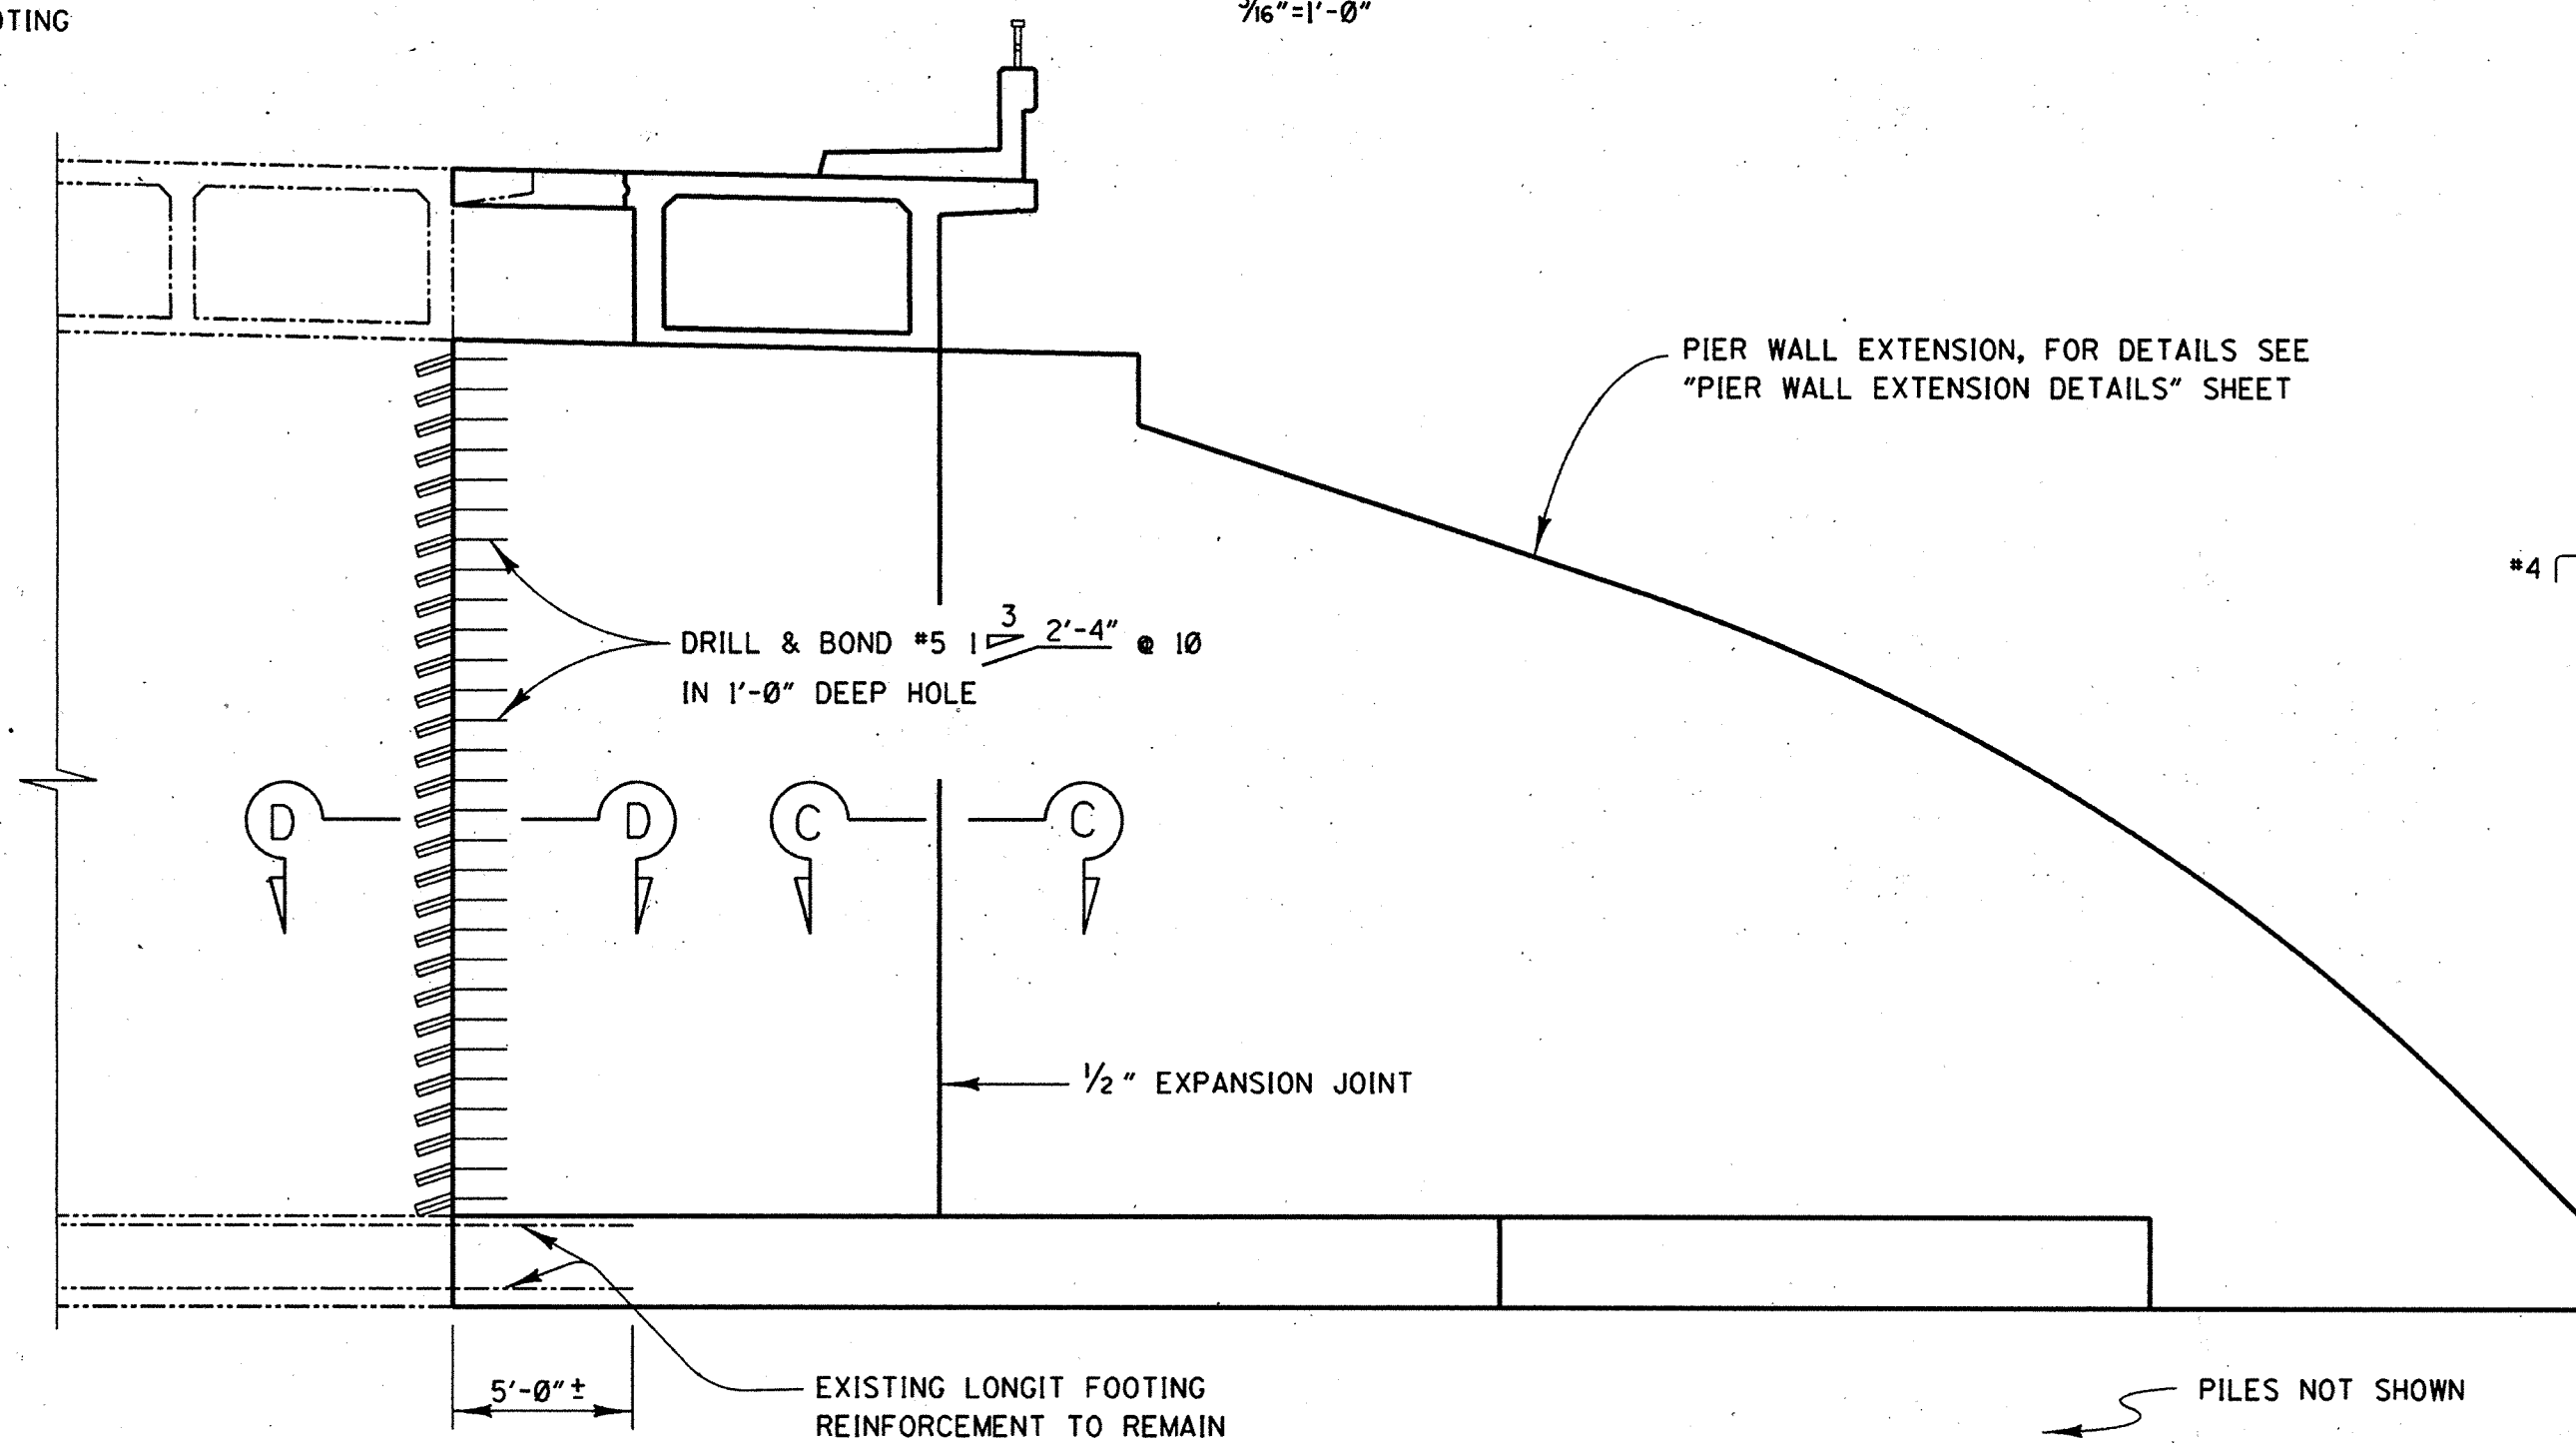


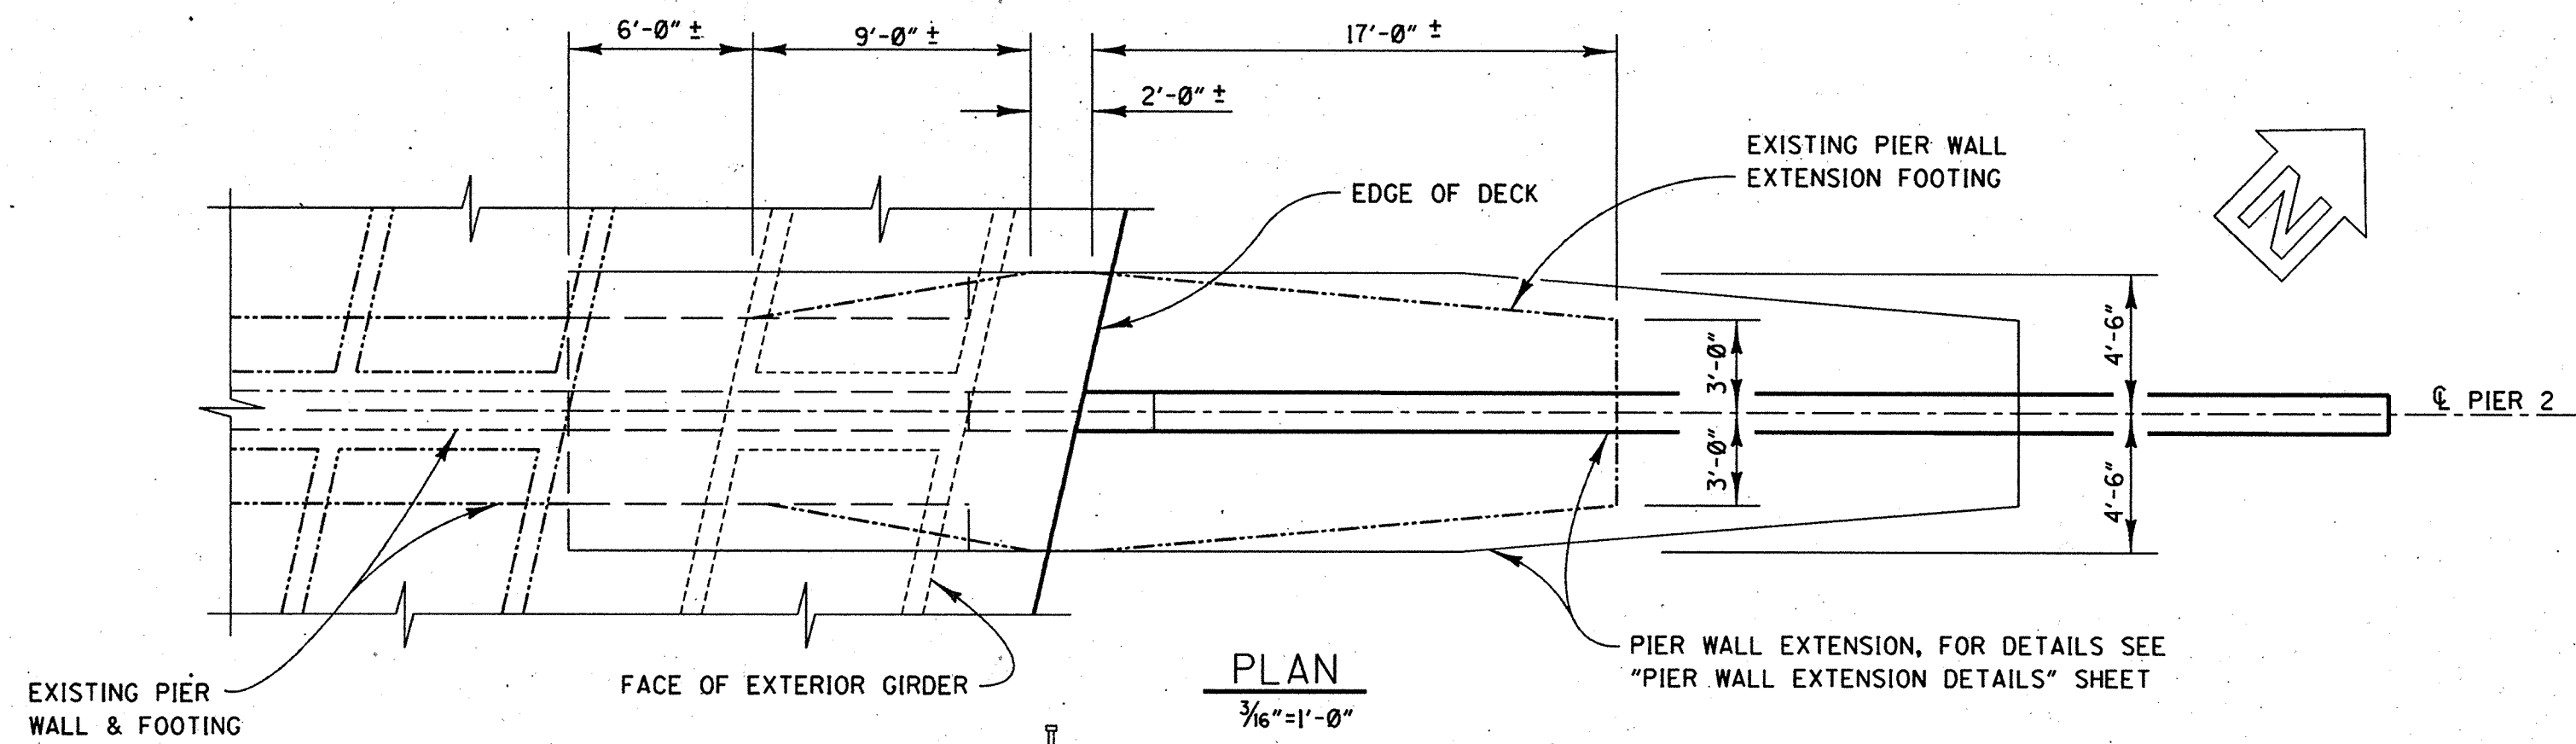

NOTE:
SEAL COURSE TO BE PLACED ONLY WHEN ORDERED BY THE ENGINEER. ESTIMATED QUANTITIES INVOLVED ARE BASED ON THE SEAL THICKNESS SHOWN. THE THICKNESS TO BE USED WILL BE DETERMINED IN THE FIELD BY THE ENGINEER. WHEN SEAL IS NOT USED, THE BOTTOM OF THE REINFORCED FOOTING SHALL REMAIN AT THE ELEVATION SHOWN.

URS GREINER, INC.
1241 EAST DYER ROAD, SUITE 250
SANTA ANA, CALIFORNIA 92705-5605

ORANGE COUNTY ENVIRONMENTAL MANAGEMENT AGENCY		BRIDGE PLANS FOR PETERS CANYON CHANNEL OVERCROSSING (F06) WIDEN	
PIER 2 DETAILS		SHEET 123	
DESIGNED YOLANDA LABIA		CHECKED CHING-FENG CHEN	
DRAWN G. BROWN		SCALE AS SHOWN	
DATE 6-97		DRAWING NO. F06-301-1	
DATE 5-97		DATE 6-97	

DET 116157