




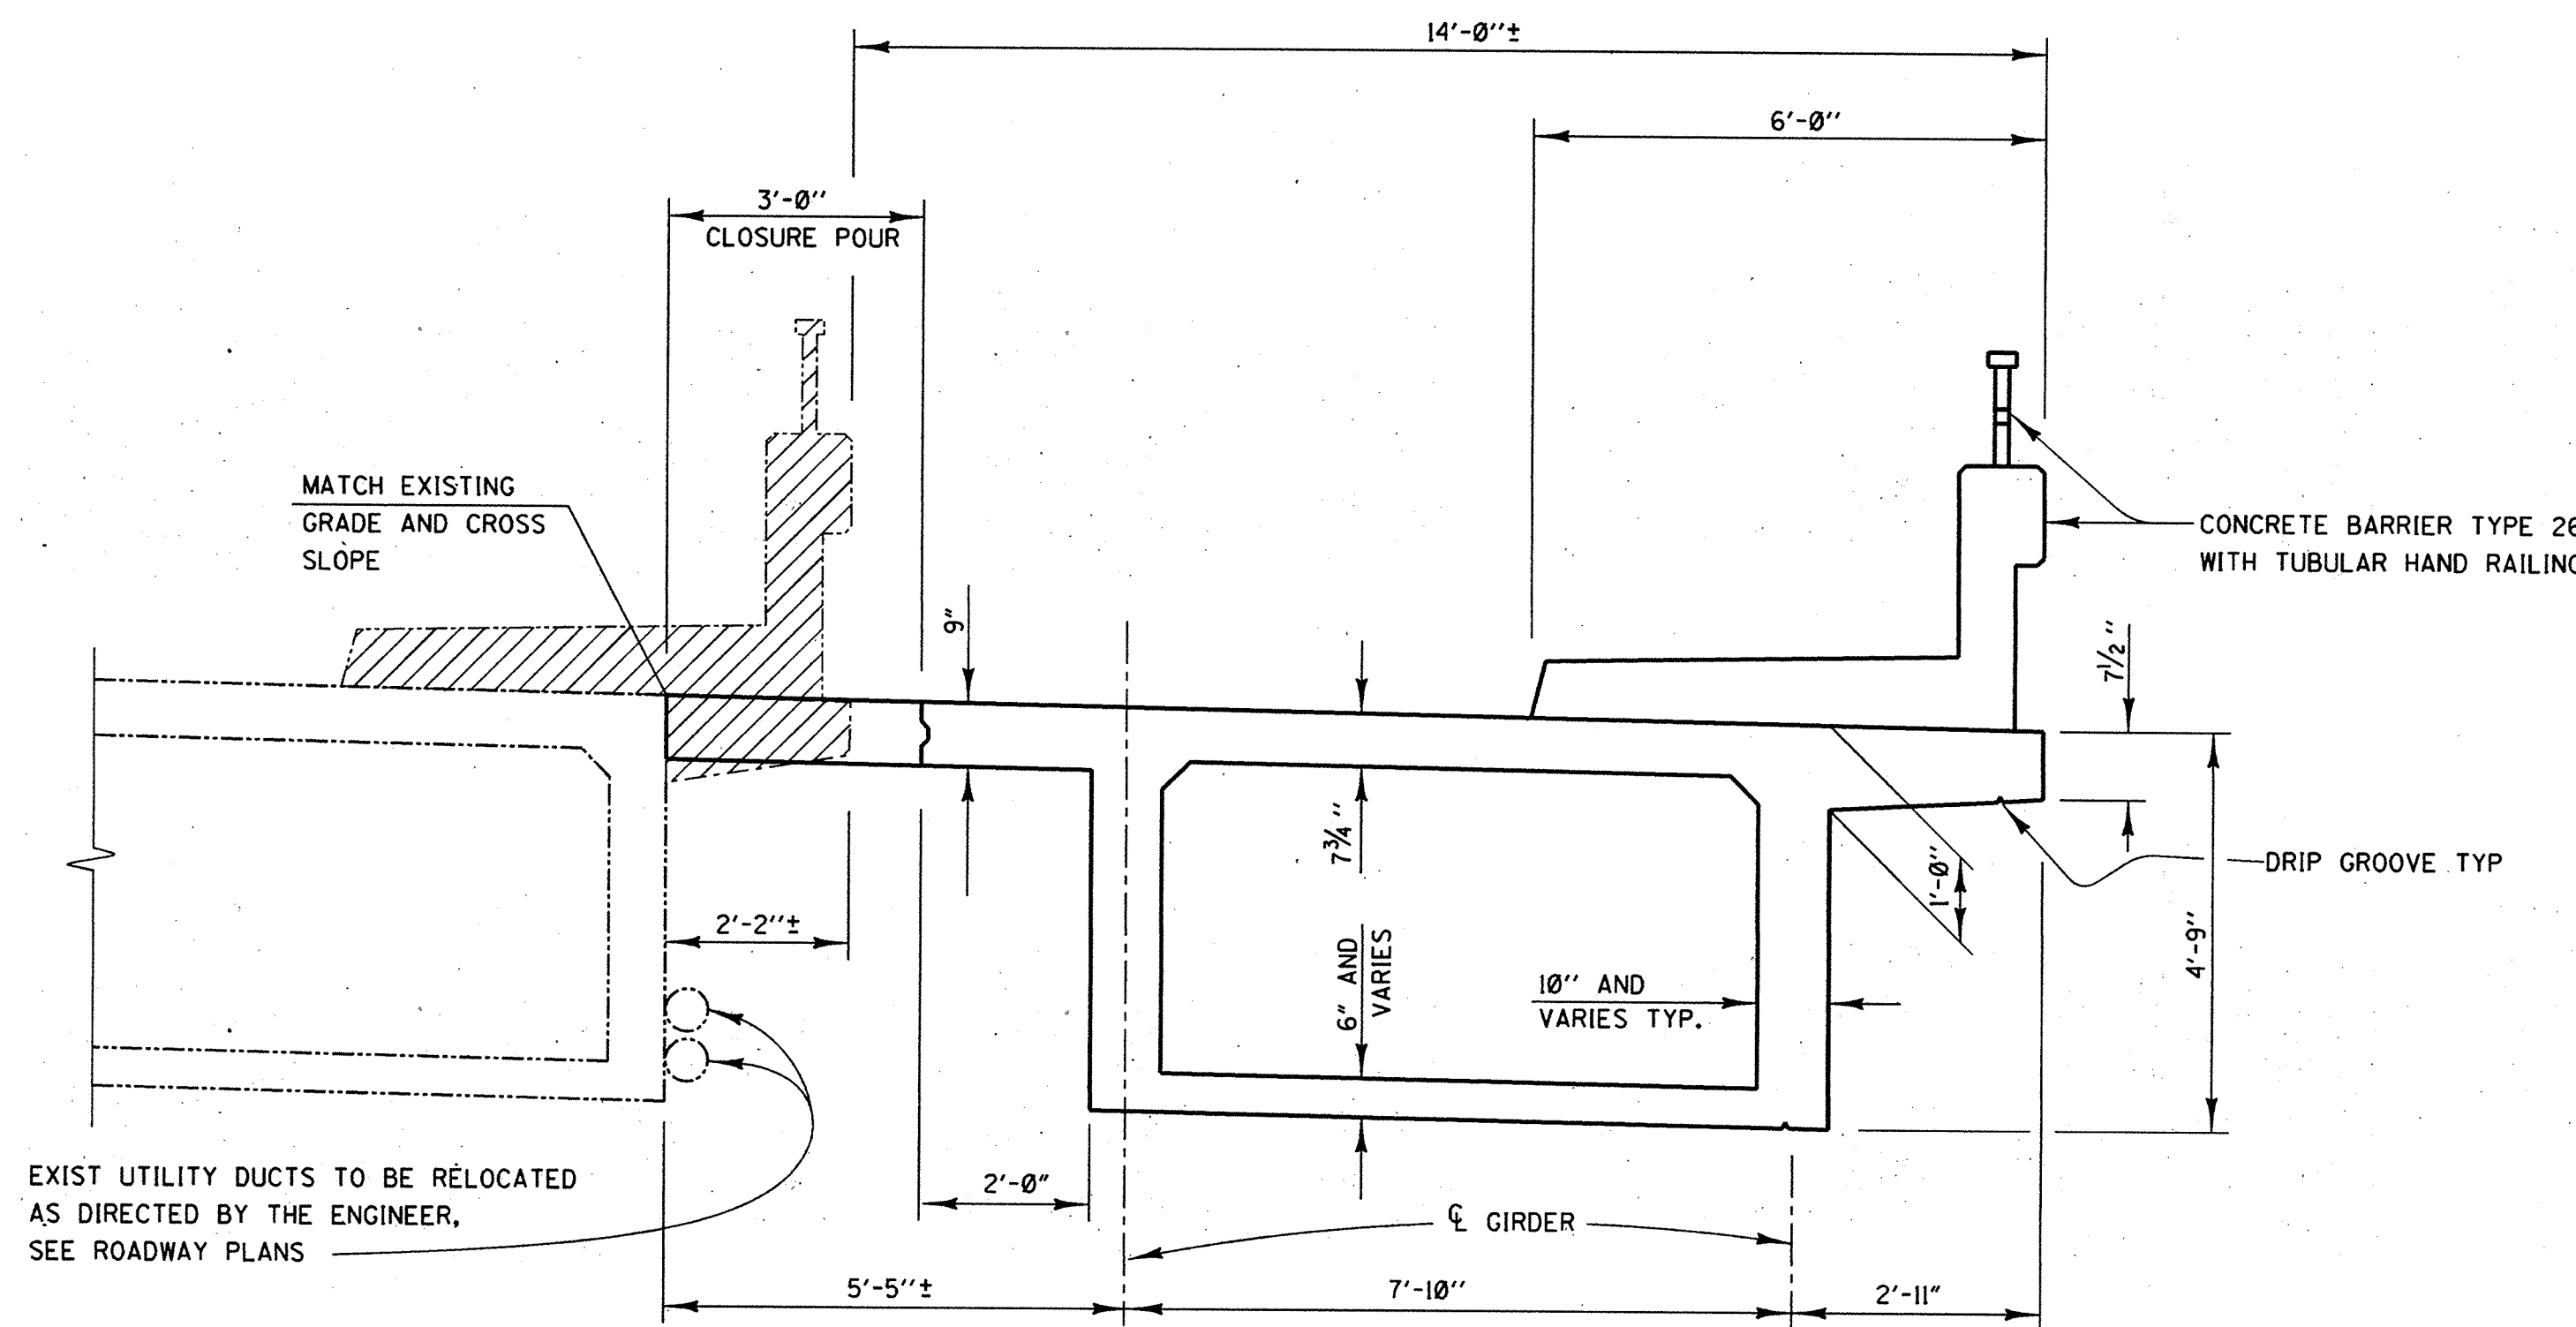


TYPICAL SECTION
1/2" = 1'-0"

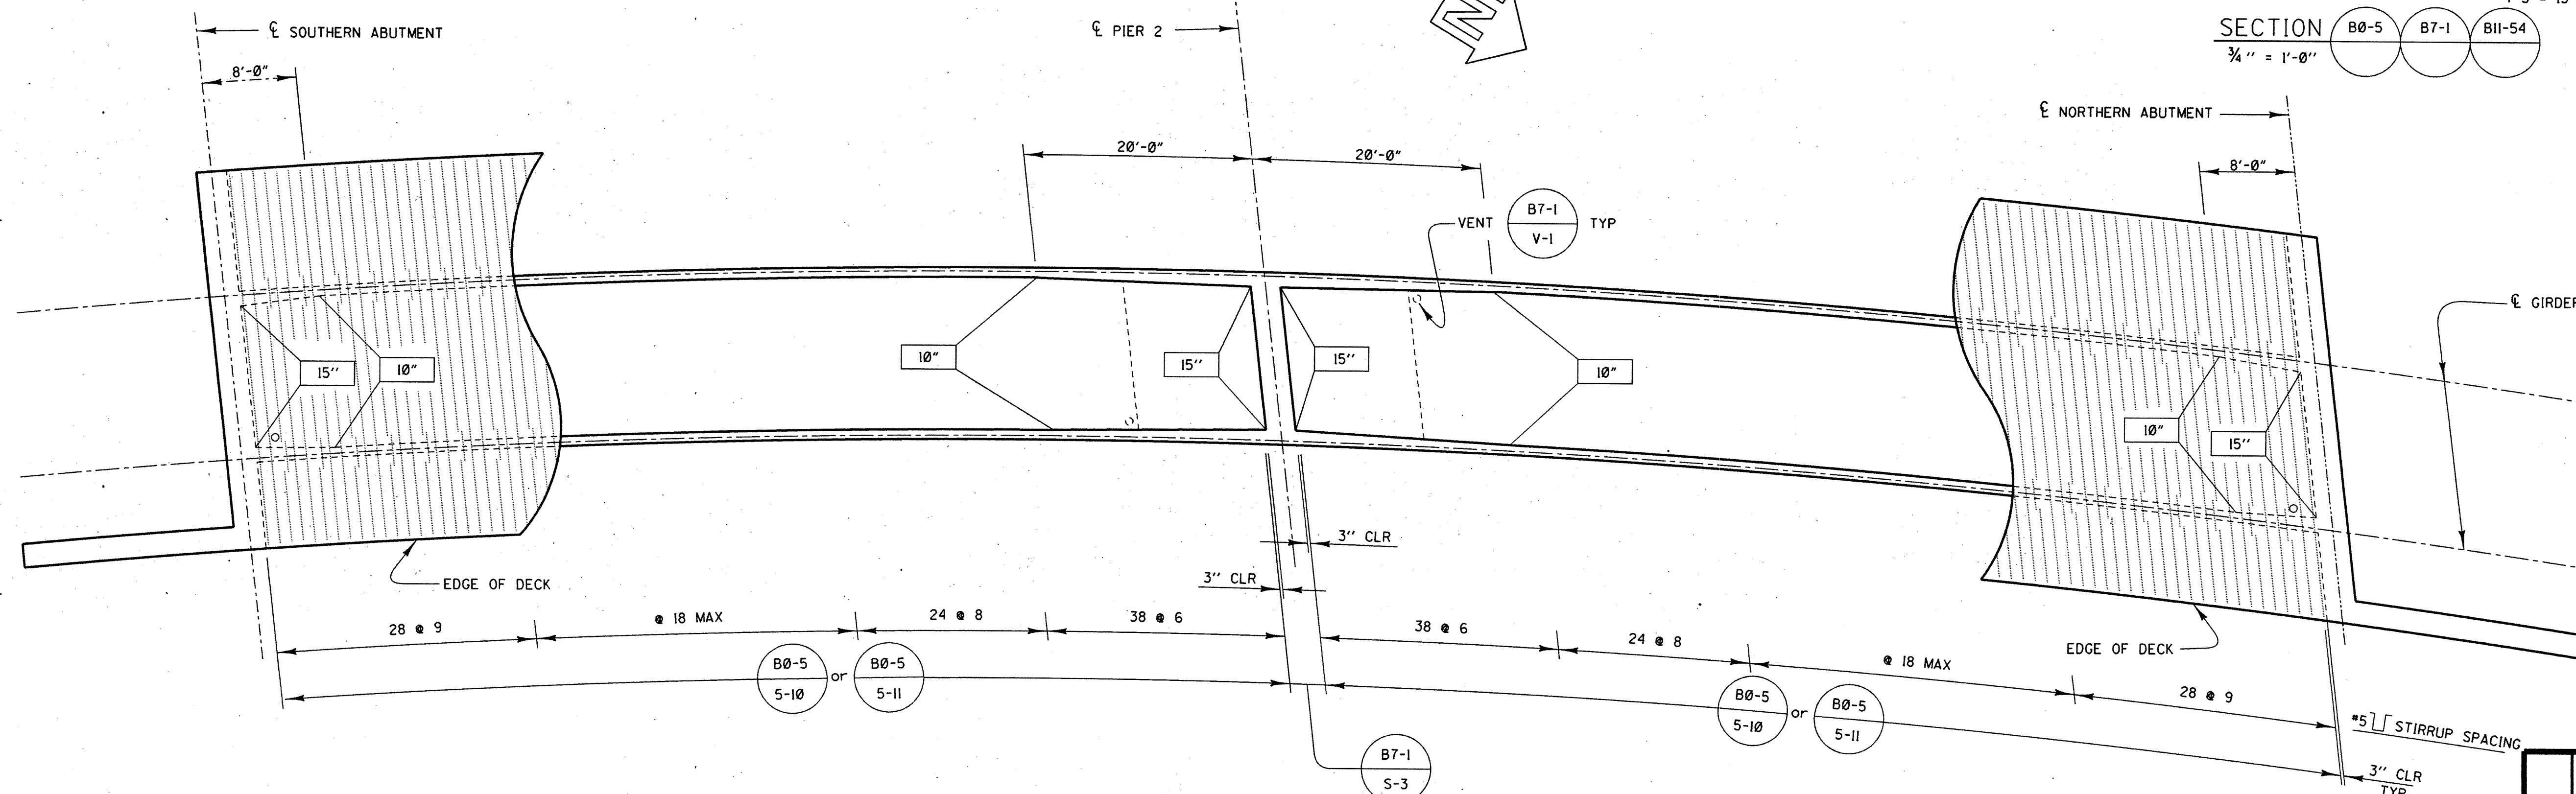

GIRDER LAYOUT
NO SCALE

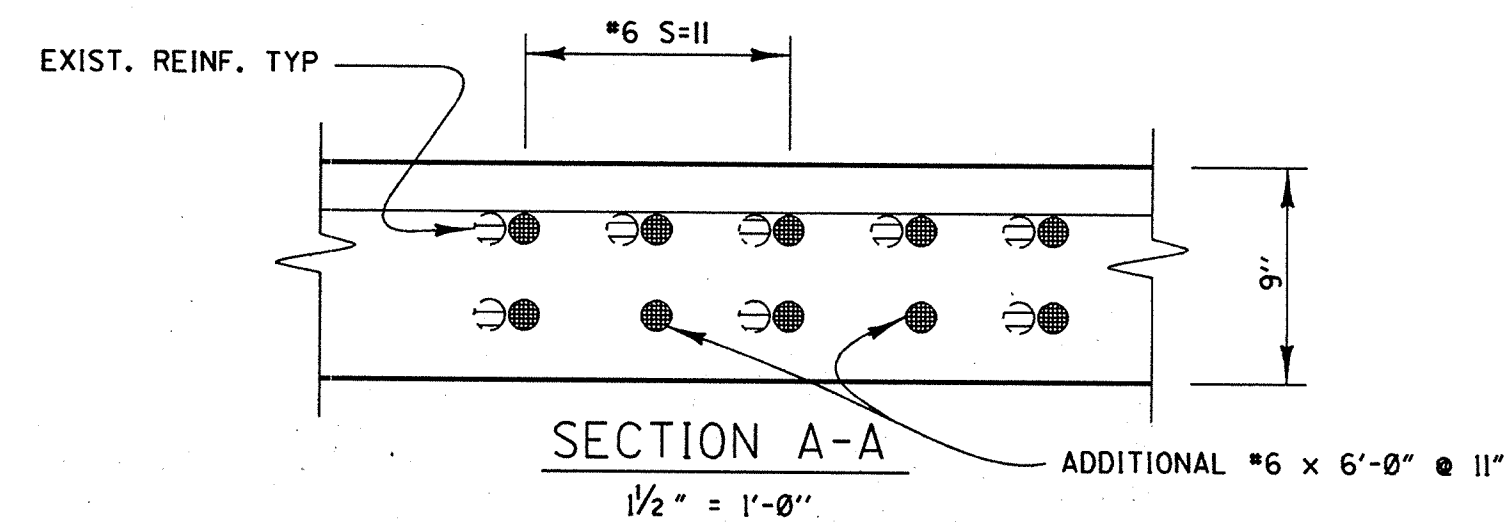

SECTION A-A
1/2" = 1'-0"

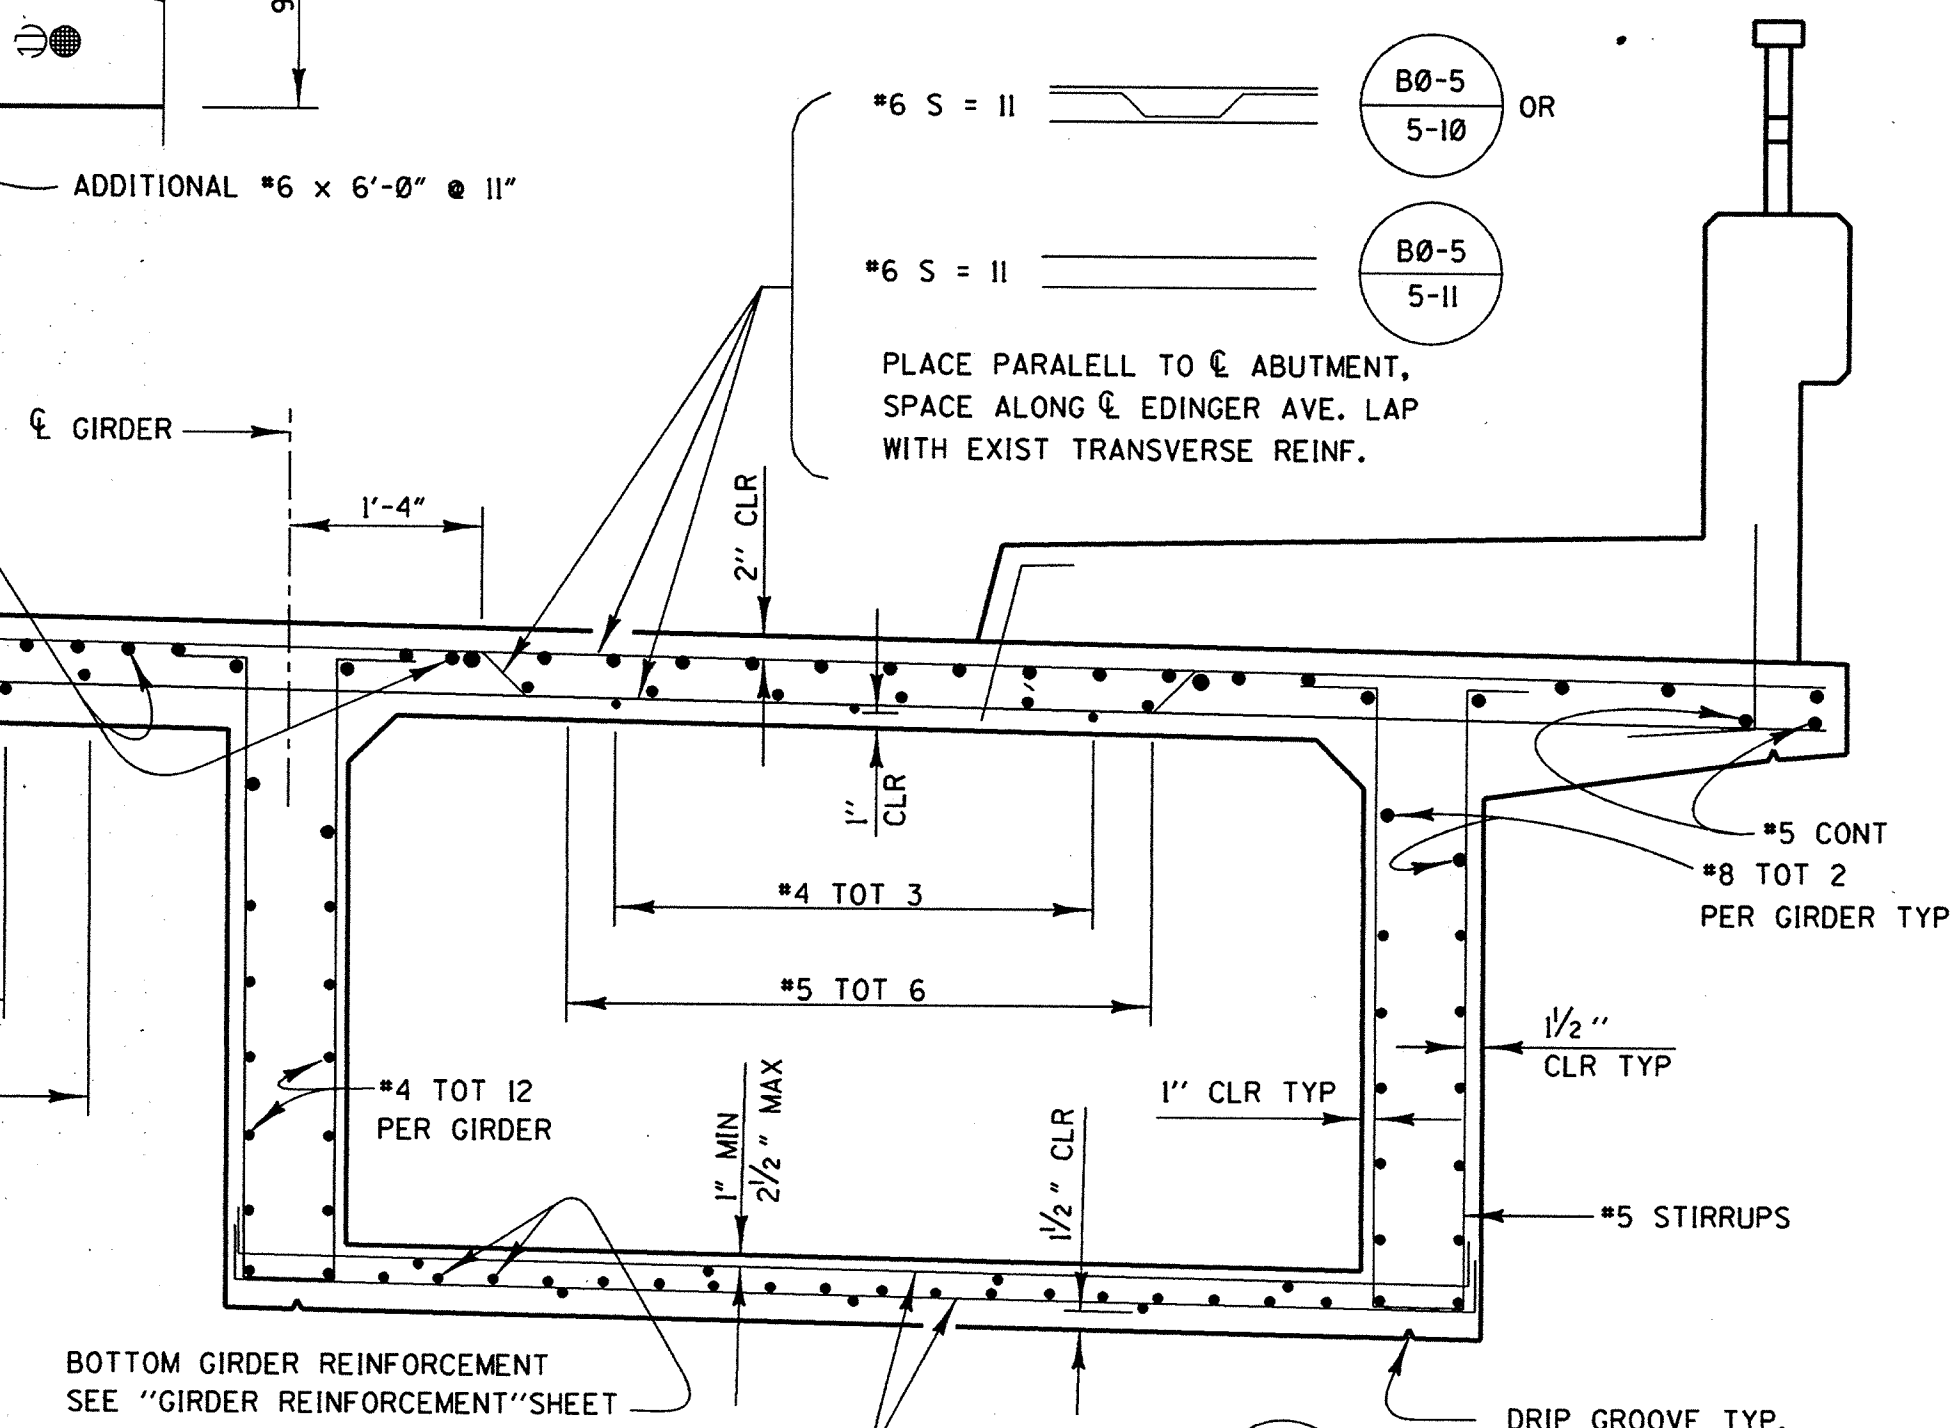

SECTION B0-5 B7-1 B11-54
3/4" = 1'-0"

- NOTES:
1. REMOVE EXISTING SIDEWALK AND OVERHANG. EXISTING TRANSVERSE DECK REINFORCING TO REMAIN IN PLACE.
 2. SPLICE TOGETHER EXIST. AND NEW DECK TRANSVERSE REINF.
- /// DENOTES LIMITS OF BRIDGE REMOVAL (PORTION)

URS GREINER, INC.
1241 EAST DYER ROAD, SUITE 250
SANTA ANA, CALIFORNIA 92705-5605

ORANGE COUNTY ENVIRONMENTAL MANAGEMENT AGENCY	
BRIDGE PLANS FOR PETERS CANYON CHANNEL OVERCROSSING (F06) WIDEN	
TYPICAL SECTION AND GIRDER LAYOUT	
DESIGNED YOLANDA LABIA	SHEET 124
DRAWN G. BROWN	CHECKED CHING-FENG CHEN
SCALE AS SHOWN	DATE 6-97
DRAWING NO. F06-301-1	OF 130

DR 1 U6157