
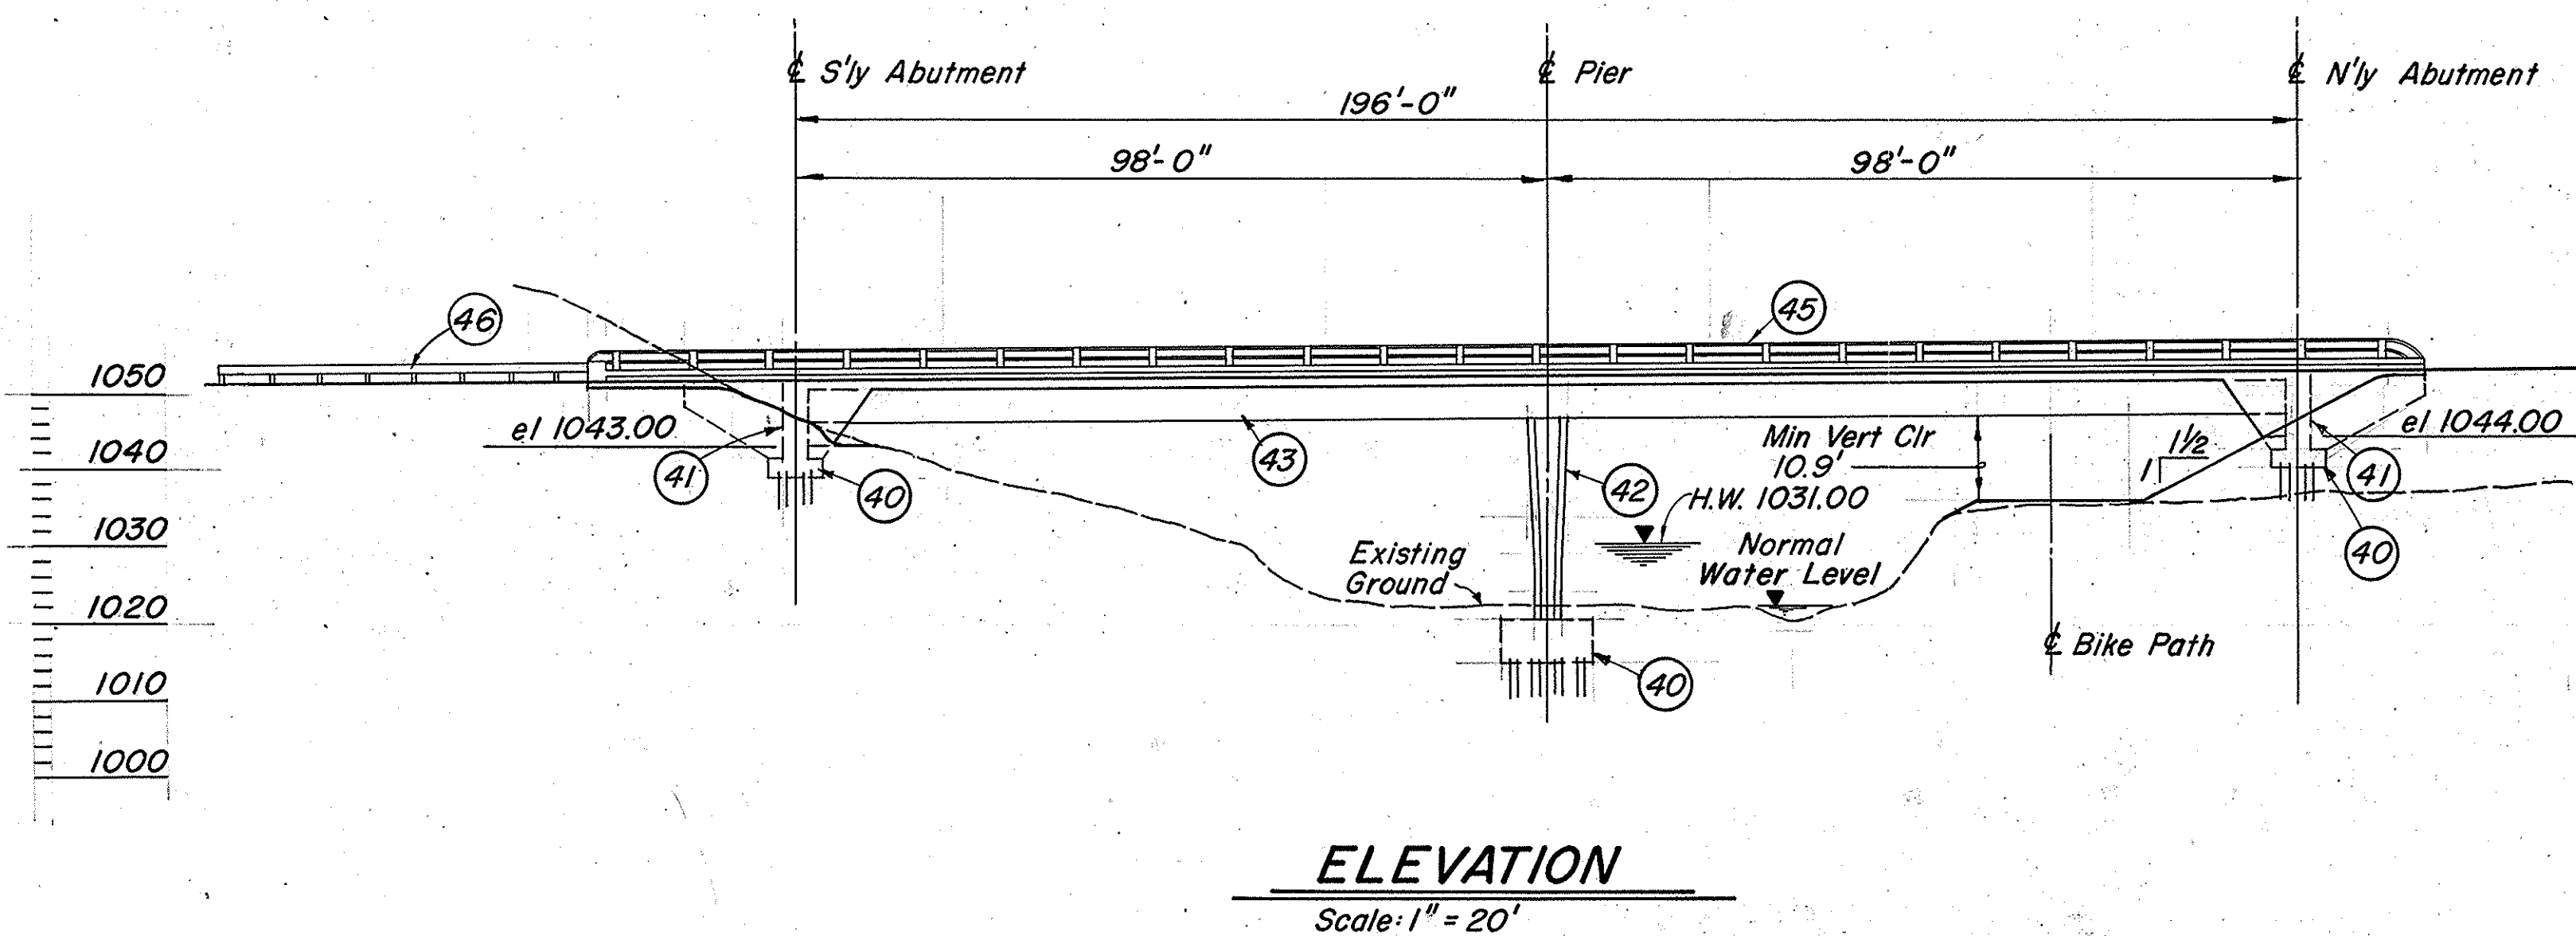
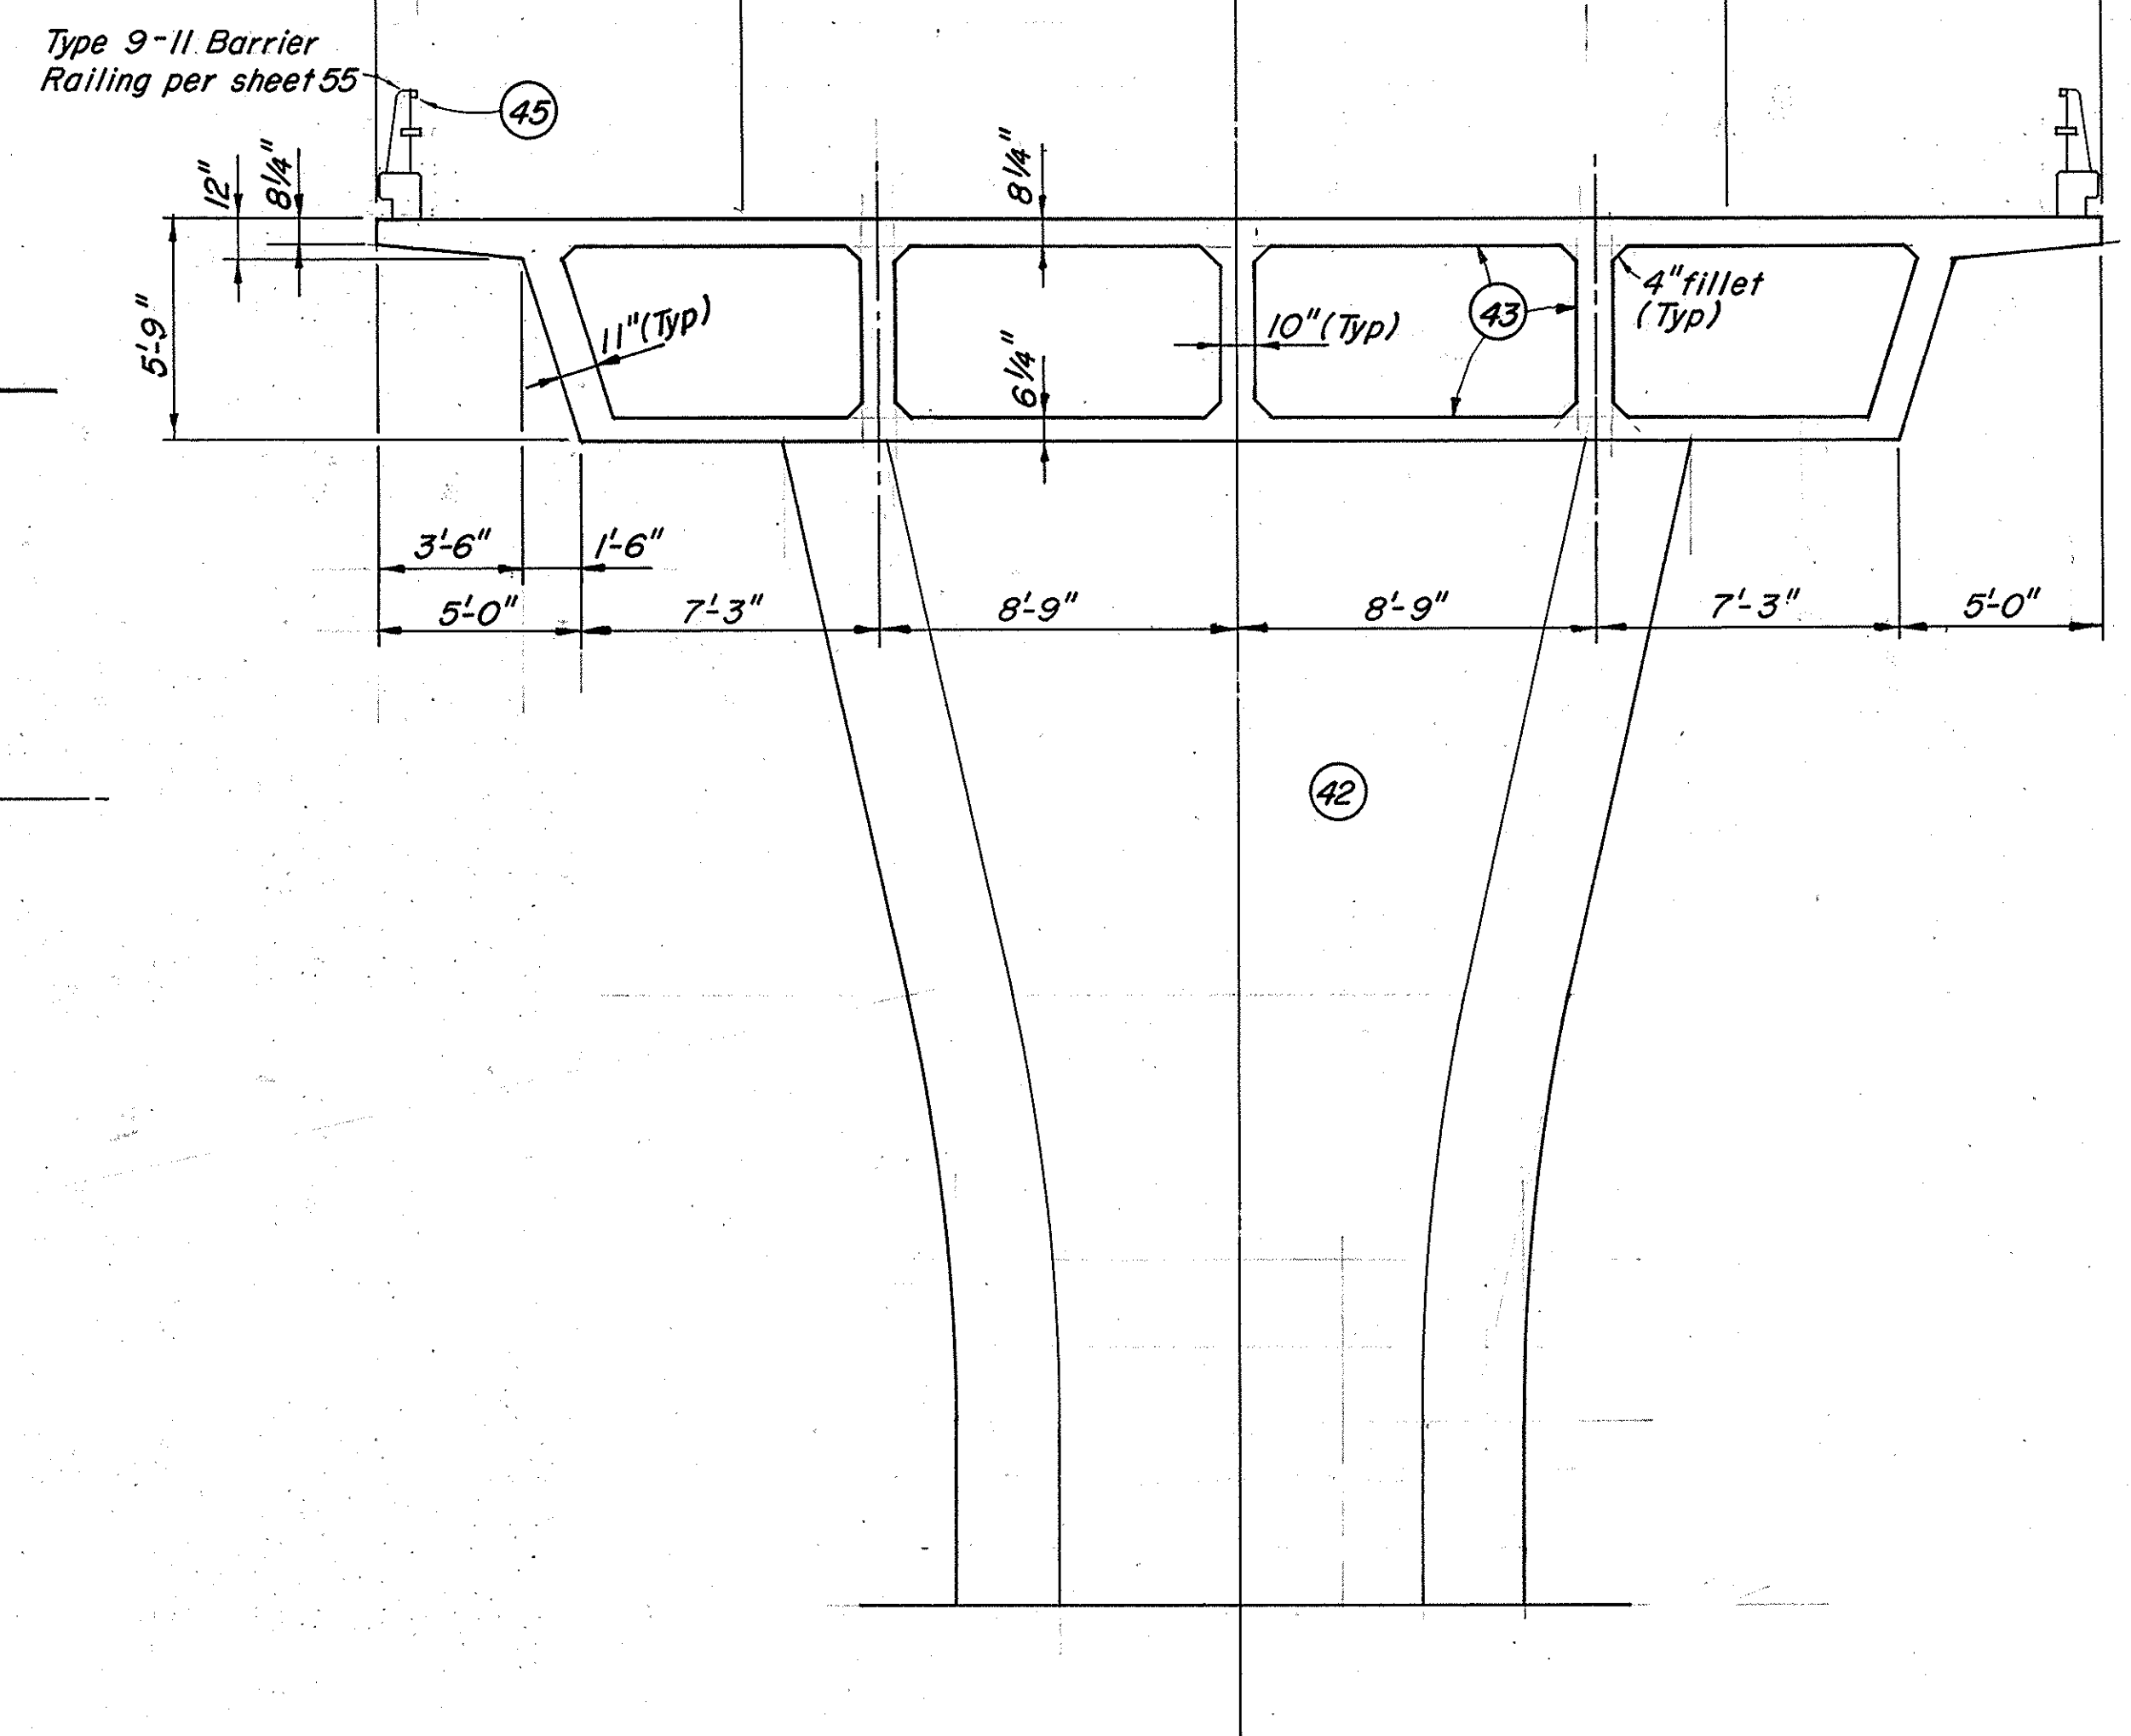


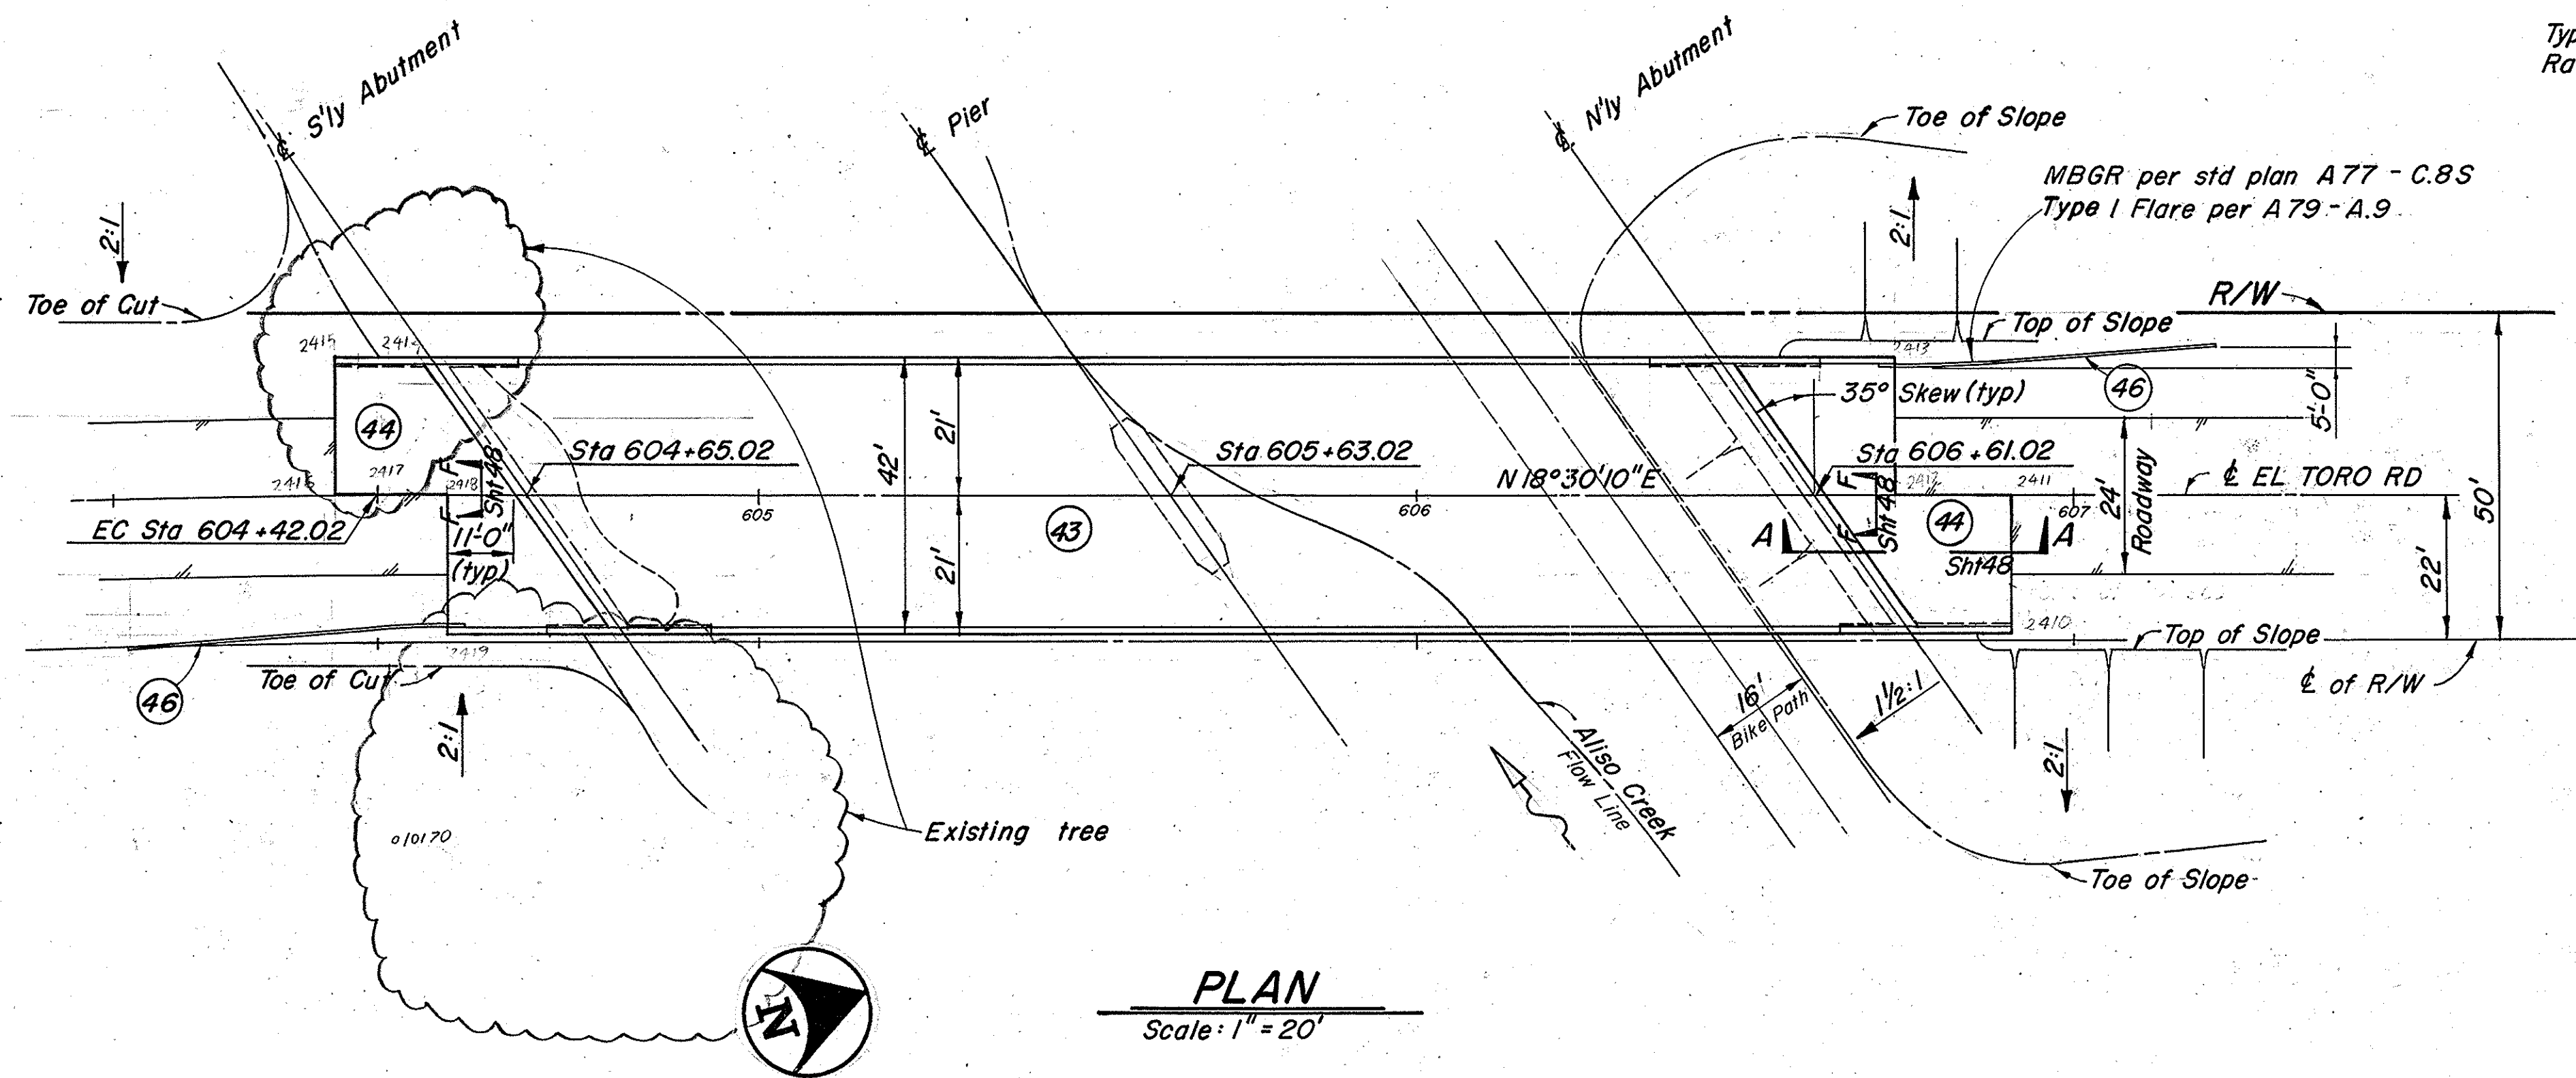

CONSTRUCTION NOTES:

- (40) Piles and pile caps (Sheets 46 & 47)
- (41) Abutments and wingwalls (Sheets 43, 47 & 48)
- (42) Center pier (Sheets 43, 49 & 50)
- (43) Box Girder (Sheets 43, 45, 51, 52, 53 & 54)
- (44) Approach slabs (Sheet 48)
- (45) Barrier Railing (Sheet 55)
- (46) Metal Beam Guard Railing (per std plan A 77 - C.B.S.)

1 1/2 0 1 2
3 inches on original drawing

				ORANGE COUNTY ENVIRONMENTAL MANAGEMENT AGENCY	
				EL TORO ROAD BRIDGE NO. AL 0.5 AT ALISO CREEK	
				GENERAL PLAN, ELEVATION & SECTION	
MARK	DATE	DESCRIPTION	PREPARED UNDER SUPERVISION OF	DATE	SHEET
		REVISIONS	SCALE	DATE	DWG. NO.
DESIGNED	DL		AS SHOWN		
DRAWN	JM	CHECKED			