




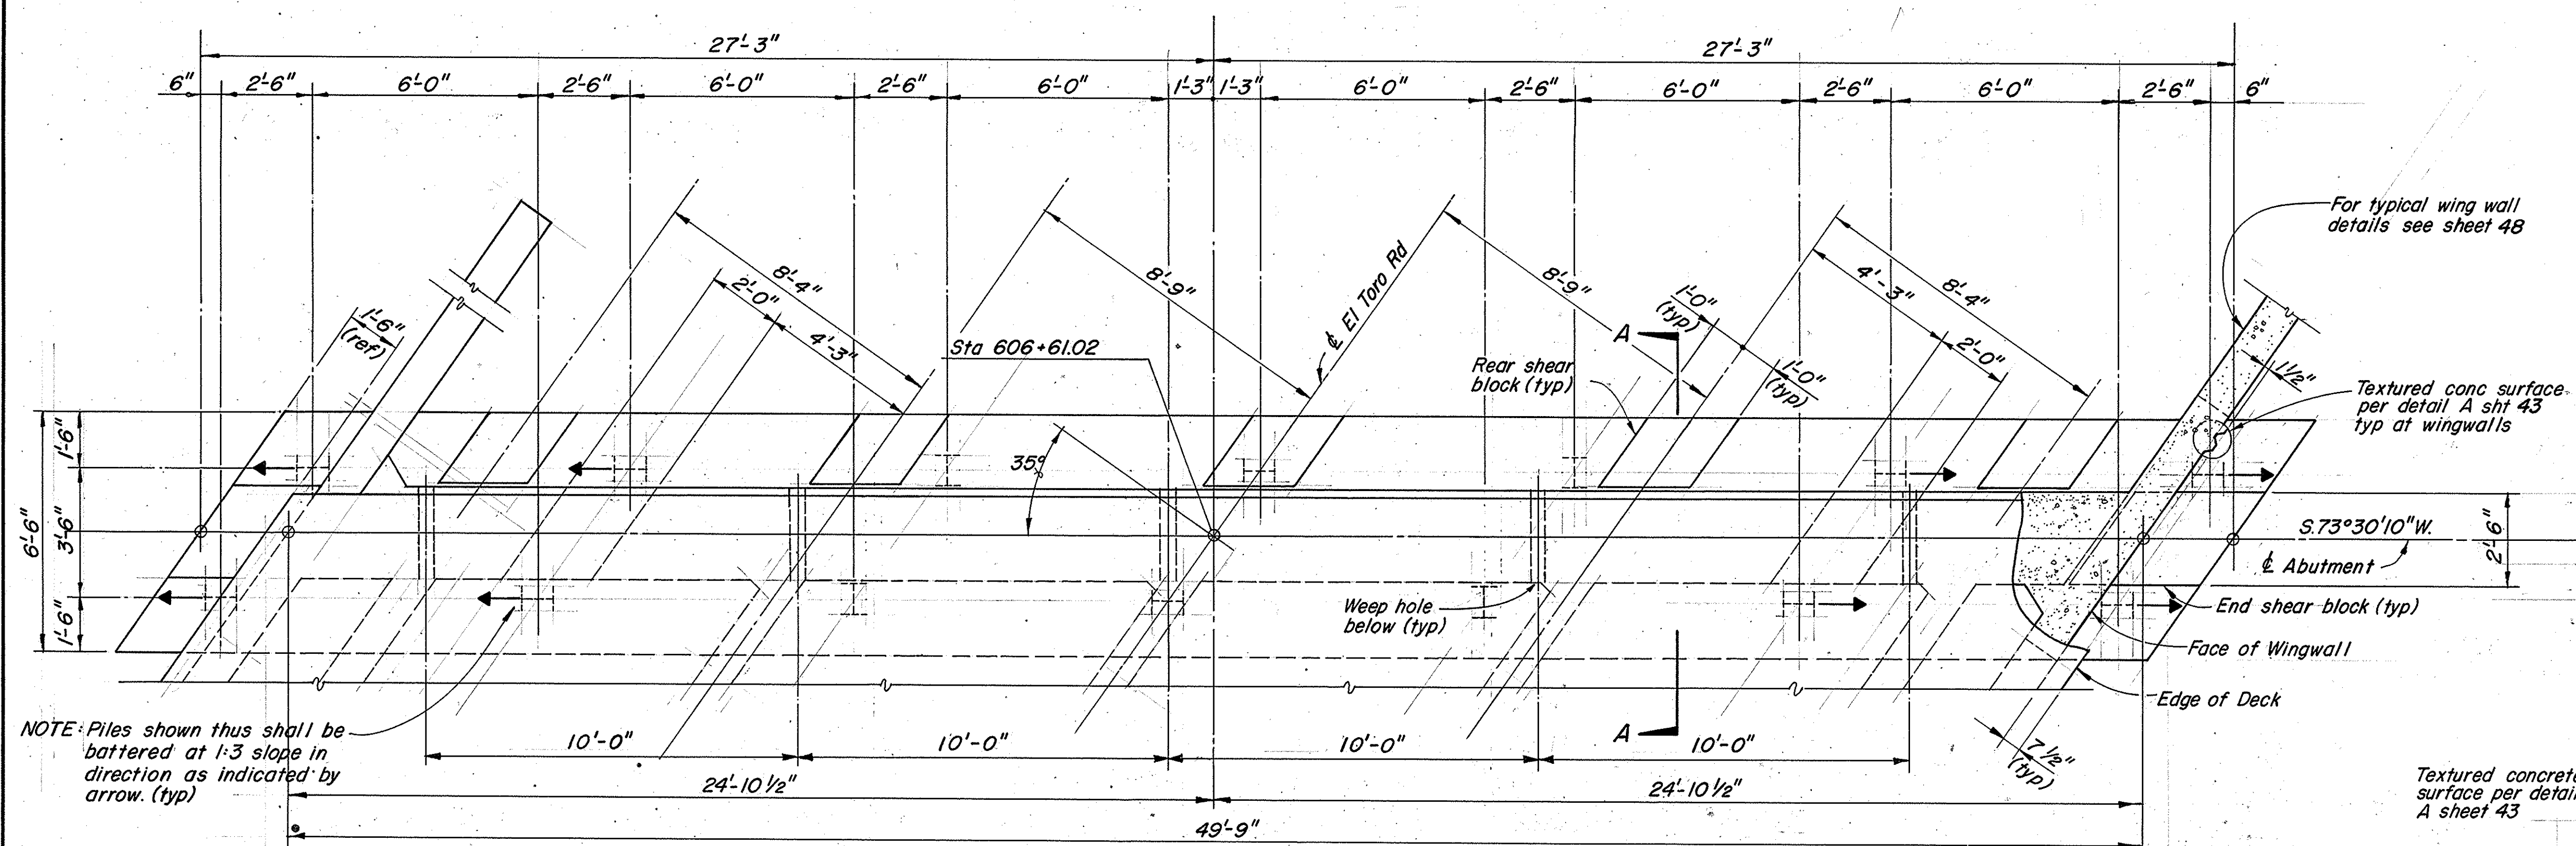


**PLAN**  
SCALE: 3/8" = 1'-0"

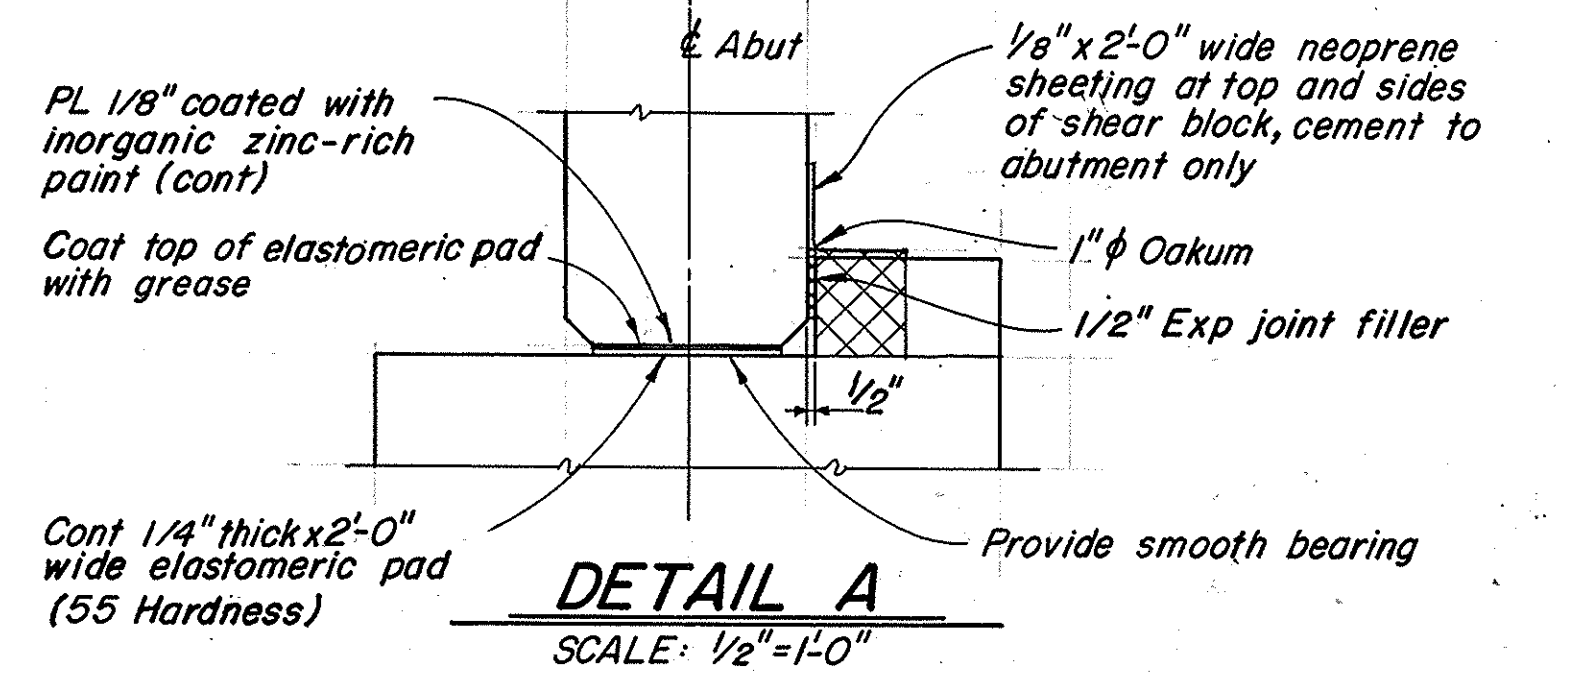


DETAIL A  
SCALE: 1/2" = 1'-0"

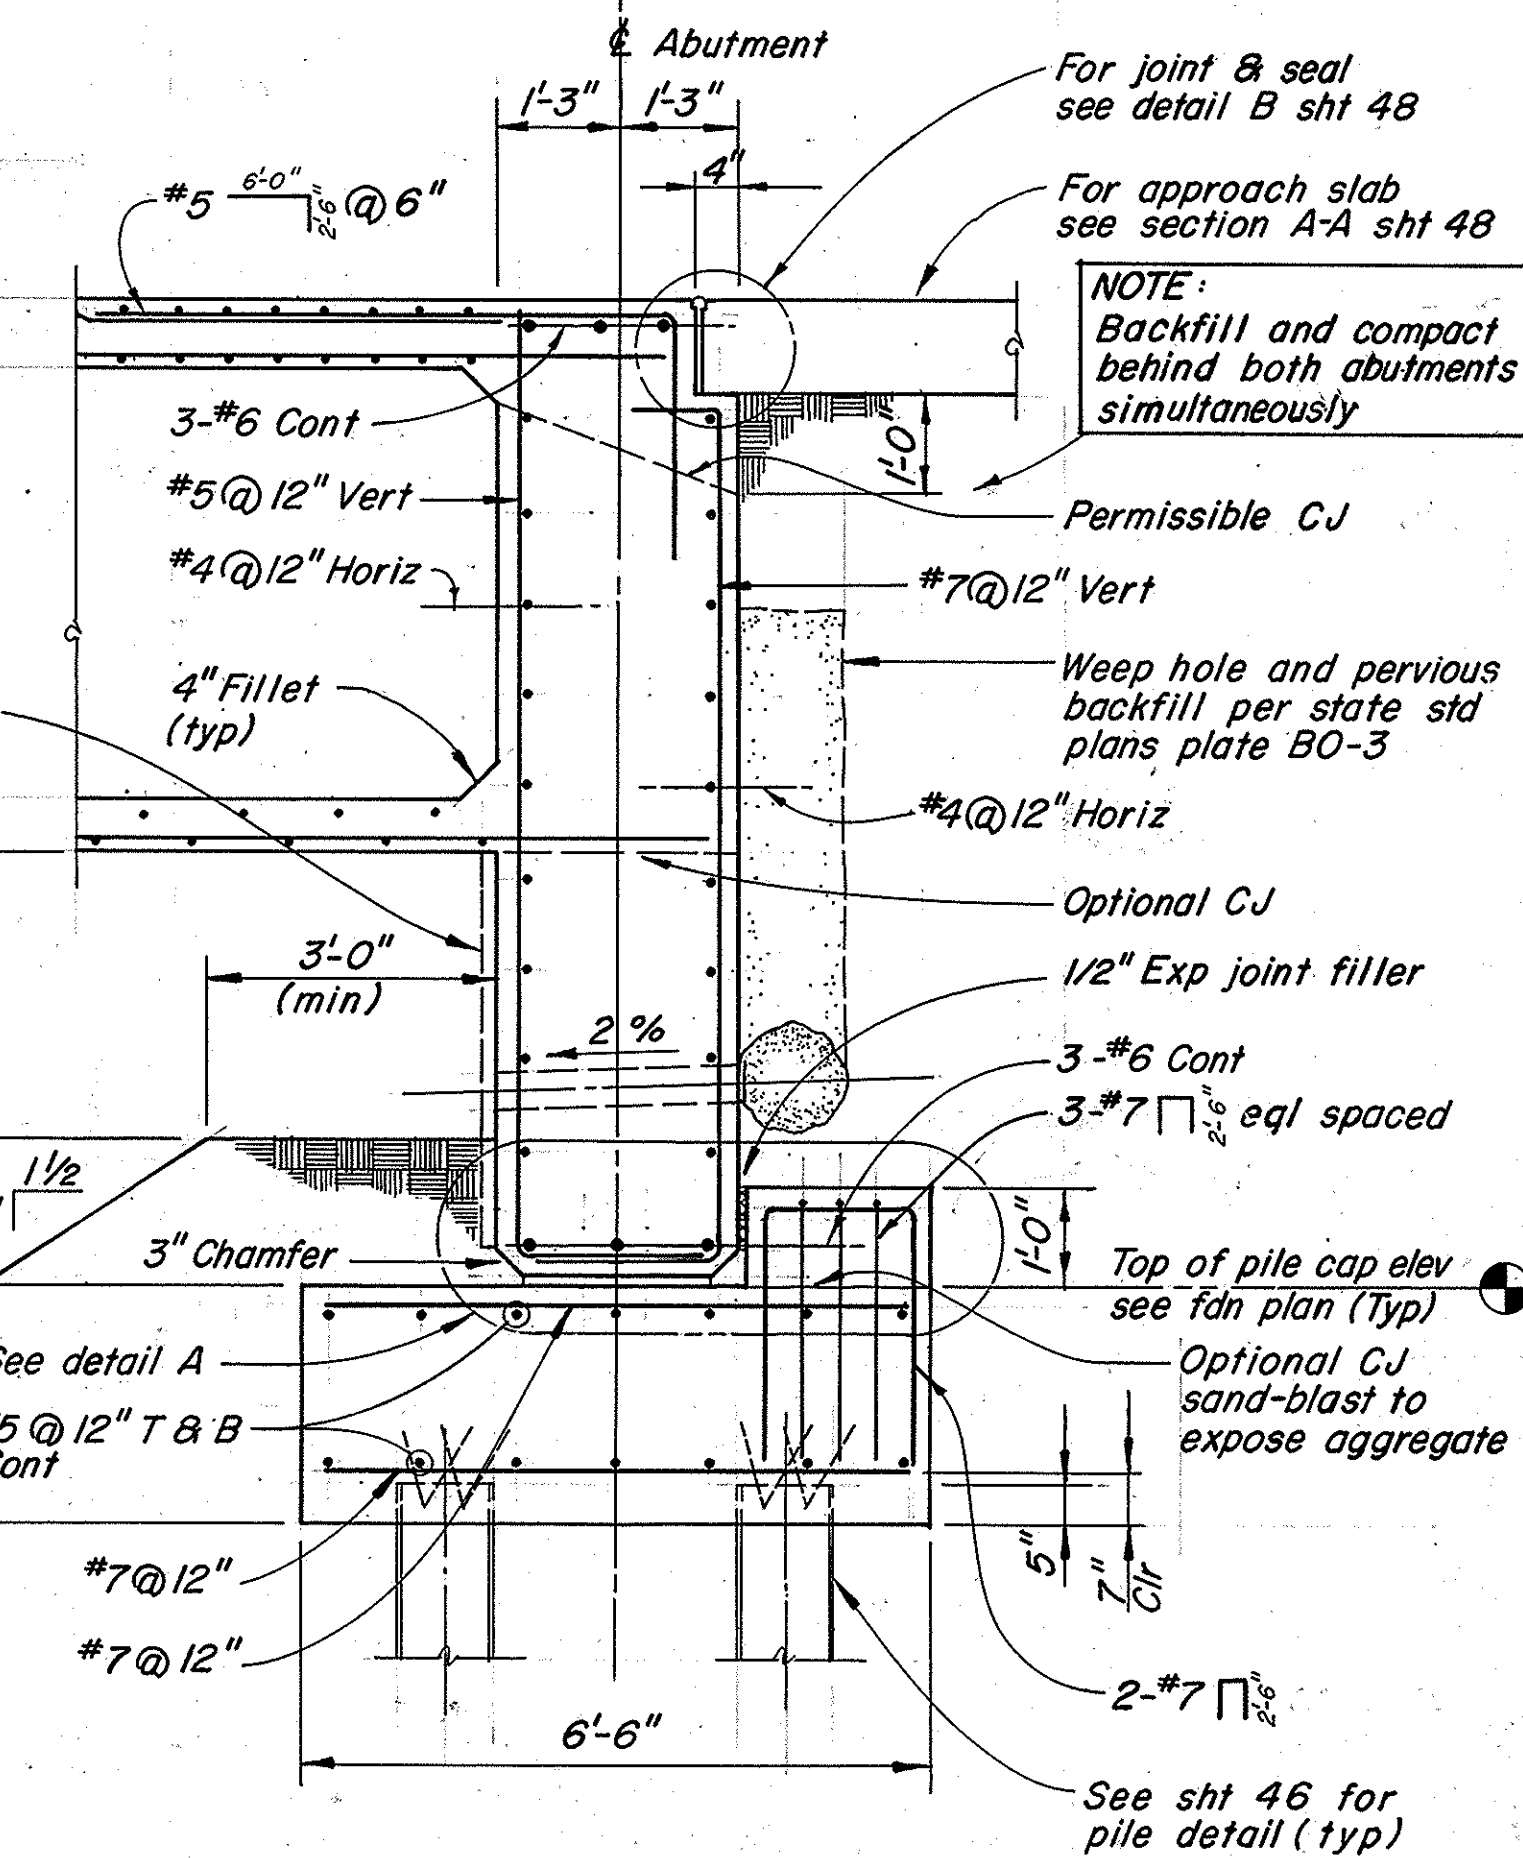

**SECTION "A-A"**  
SCALE: 1/2" = 1'-0"

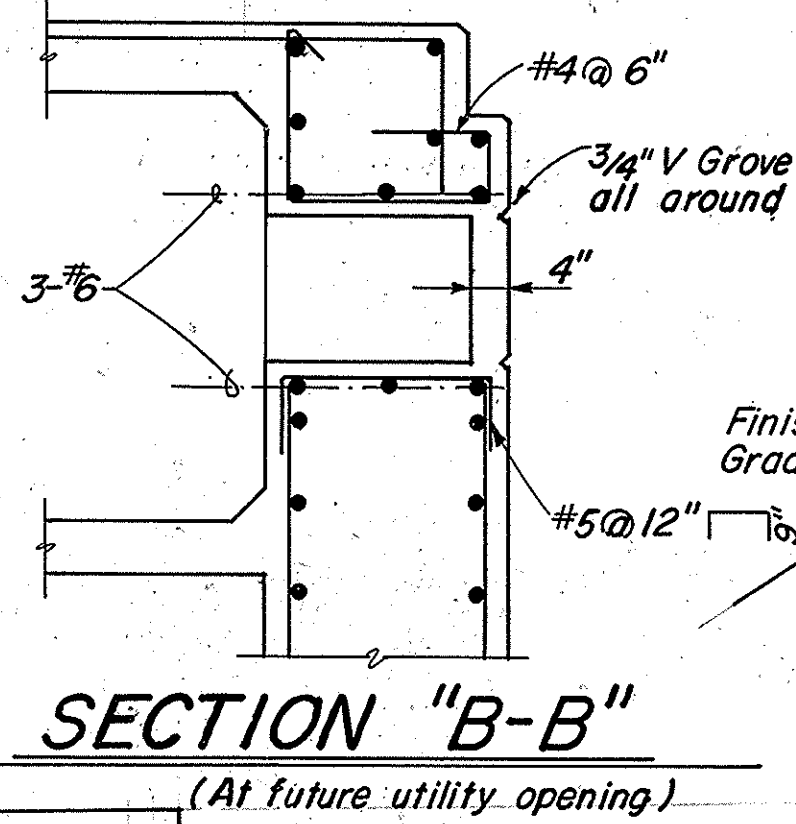

**SECTION "B-B"**  
(At future utility opening)

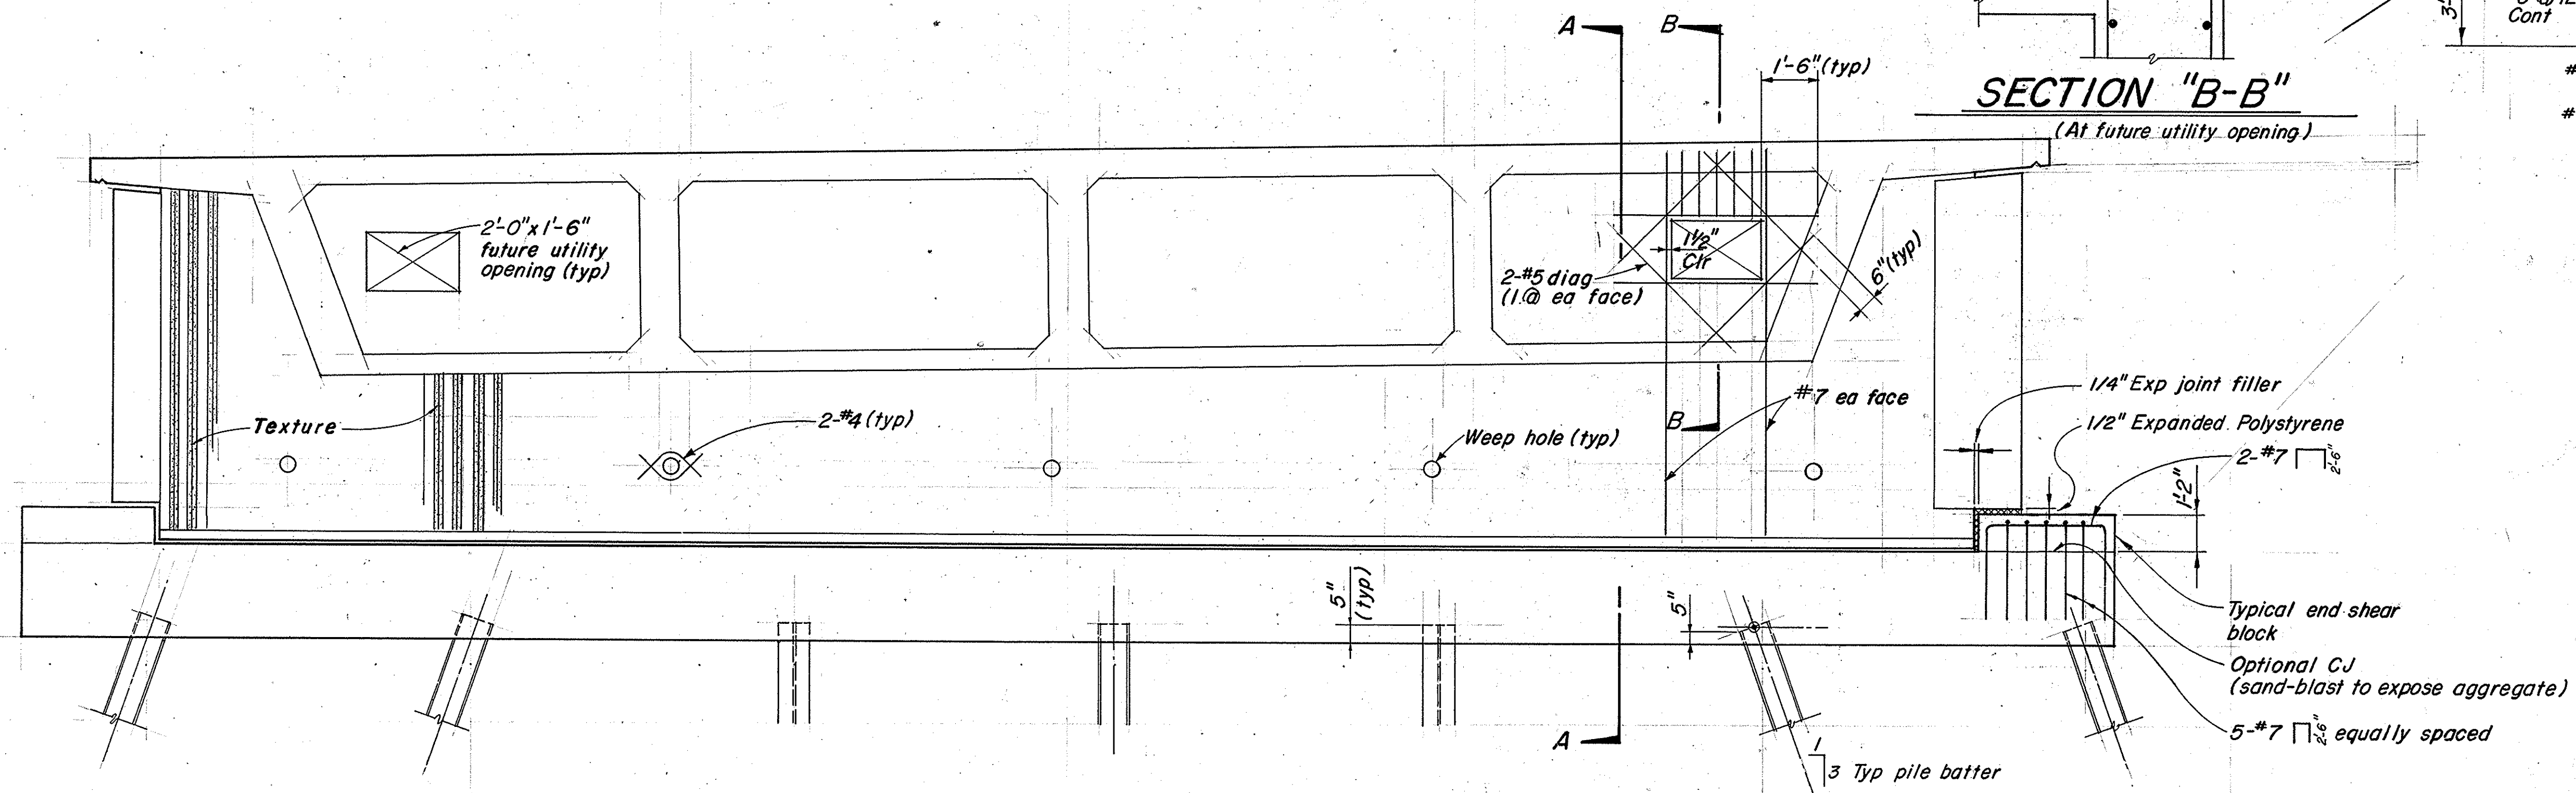

**ELEVATION**  
SCALE: 3/8" = 1'-0"



|                                                  |         |             |                |
|--------------------------------------------------|---------|-------------|----------------|
| ORANGE COUNTY<br>ENVIRONMENTAL MANAGEMENT AGENCY |         |             |                |
| <b>EL TORO ROAD BRIDGE</b>                       |         |             |                |
| NO. AL 0.5 AT<br>ALISO CREEK                     |         |             |                |
| TYPICAL                                          |         | ABUTMENT    |                |
| MARK                                             | DATE    | DESCRIPTION | PREPARED UNDER |
| DESIGNED                                         | SCALE   | DATE        | DATE           |
| DRAWN                                            | CHECKED | AS SHOWN    | DWG. NO.       |
| SHEET                                            |         |             | 47             |