

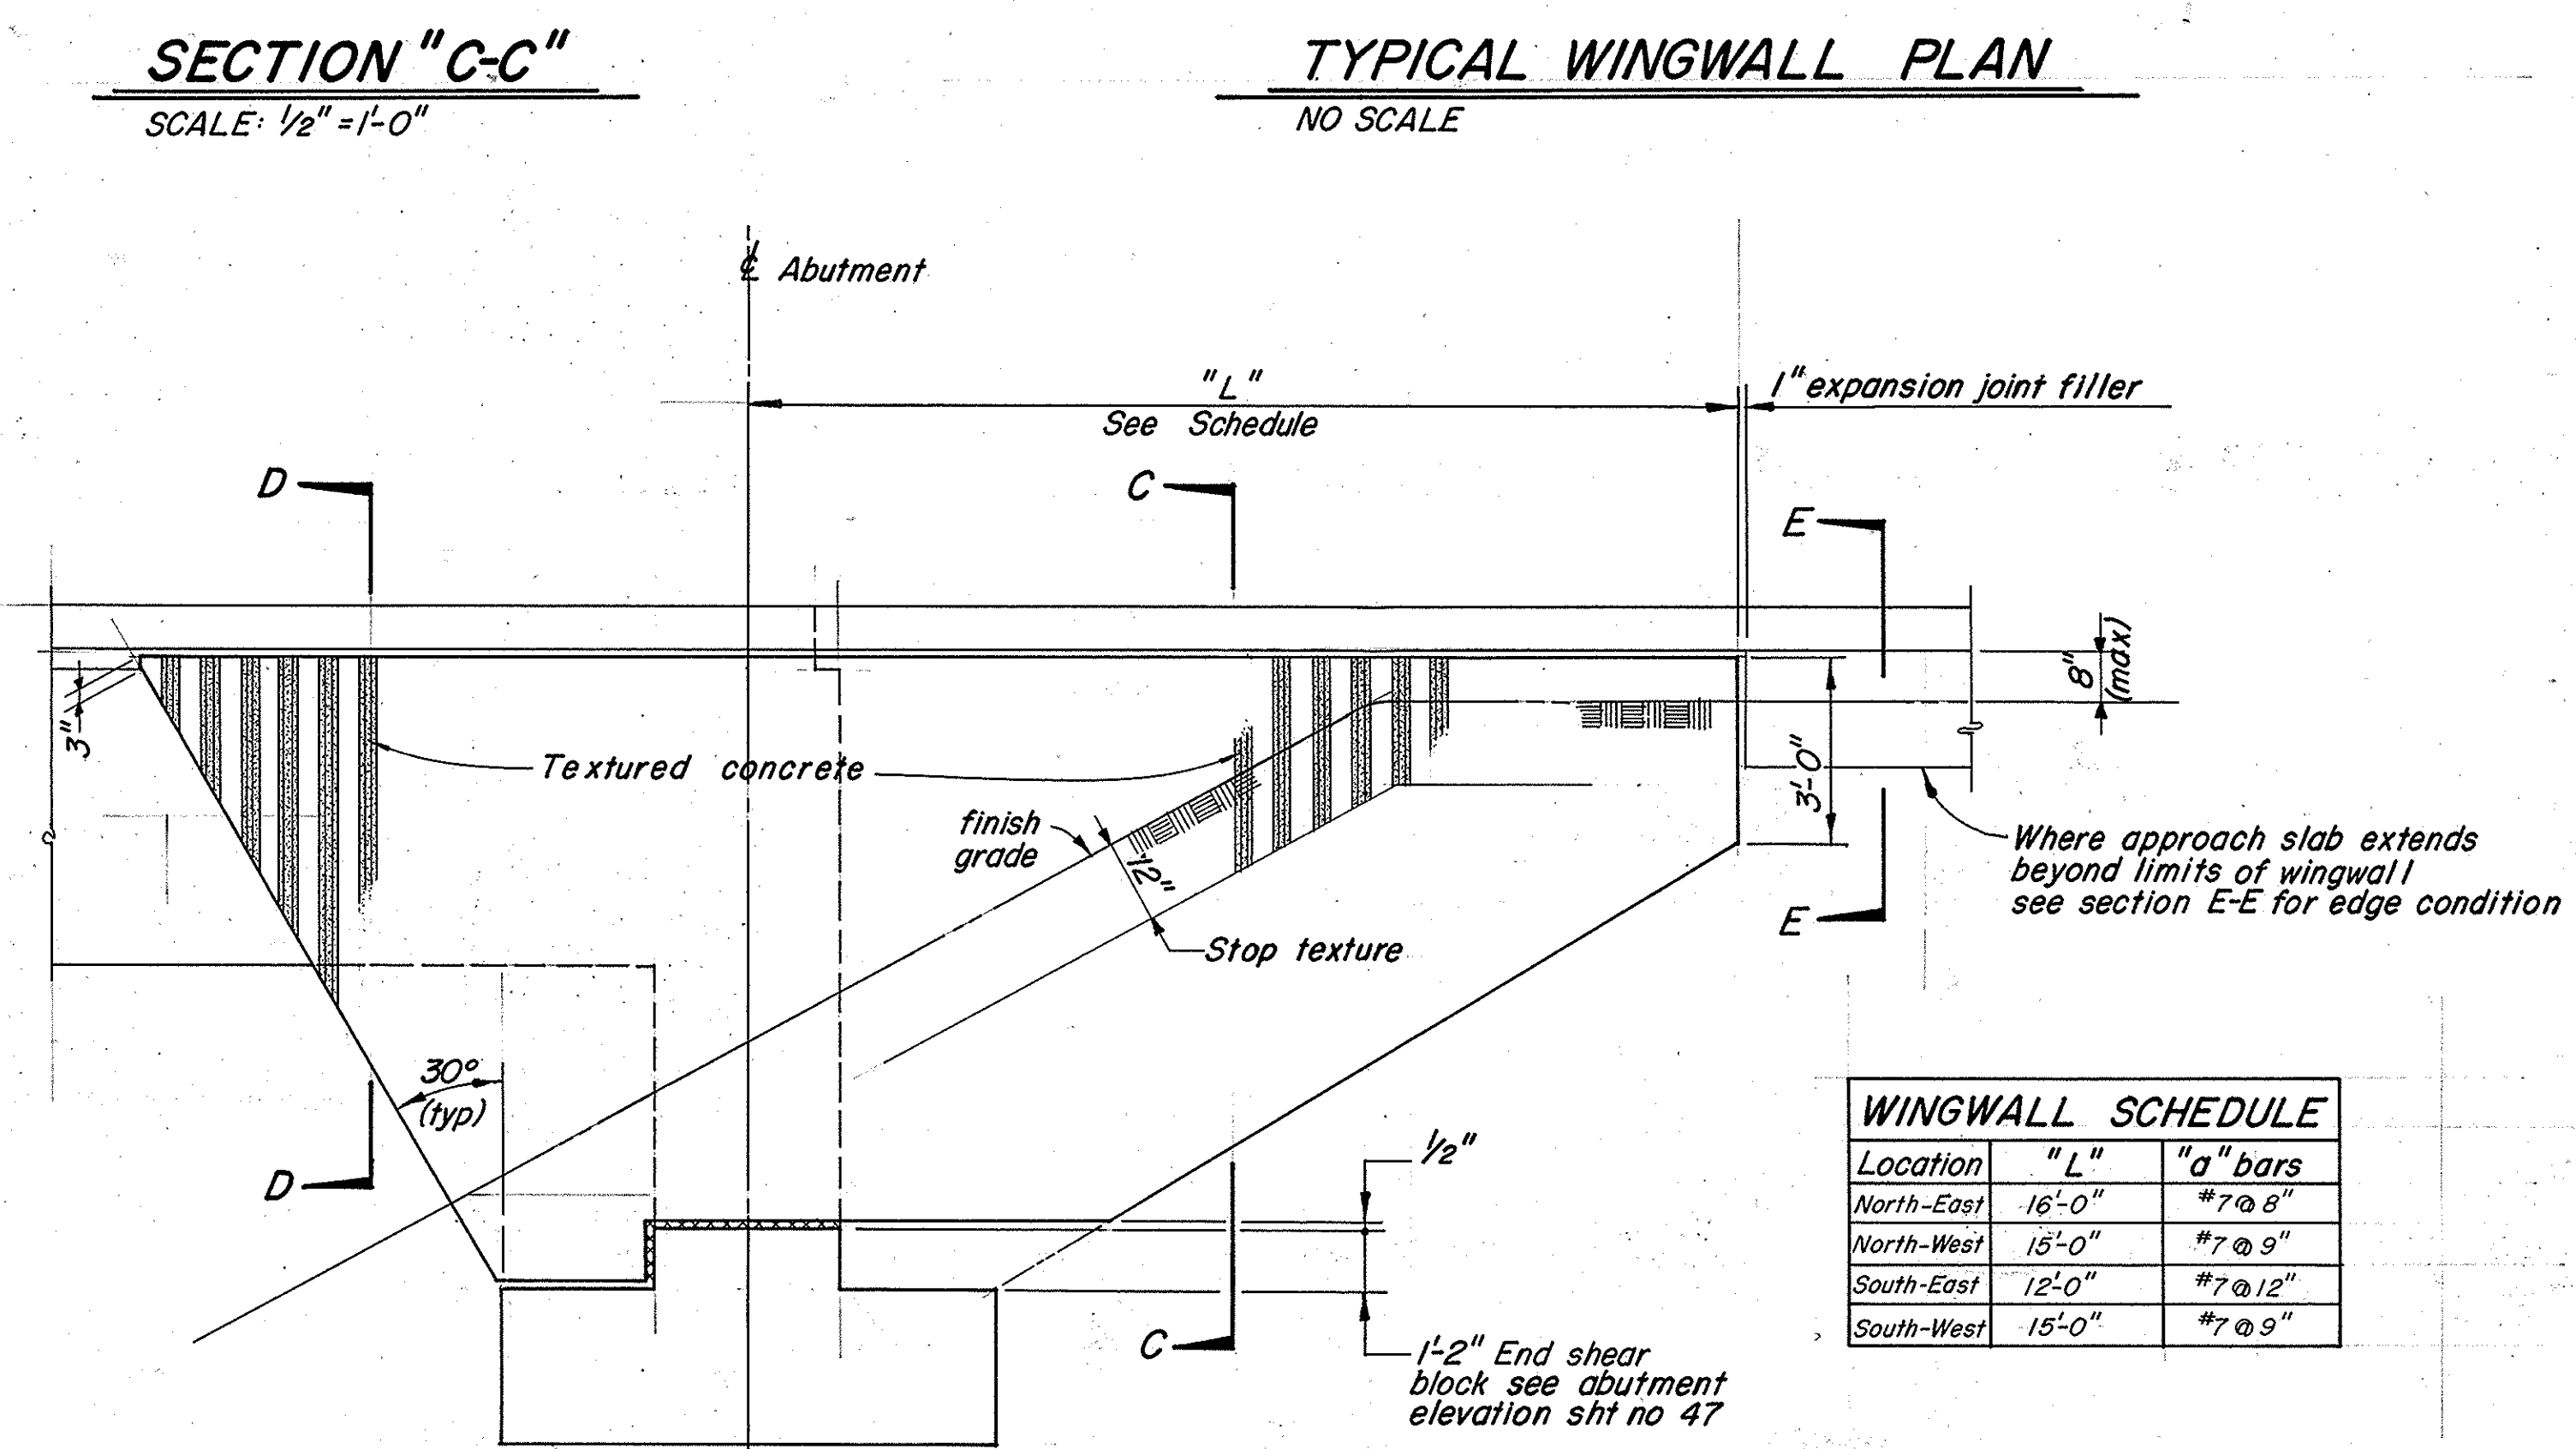
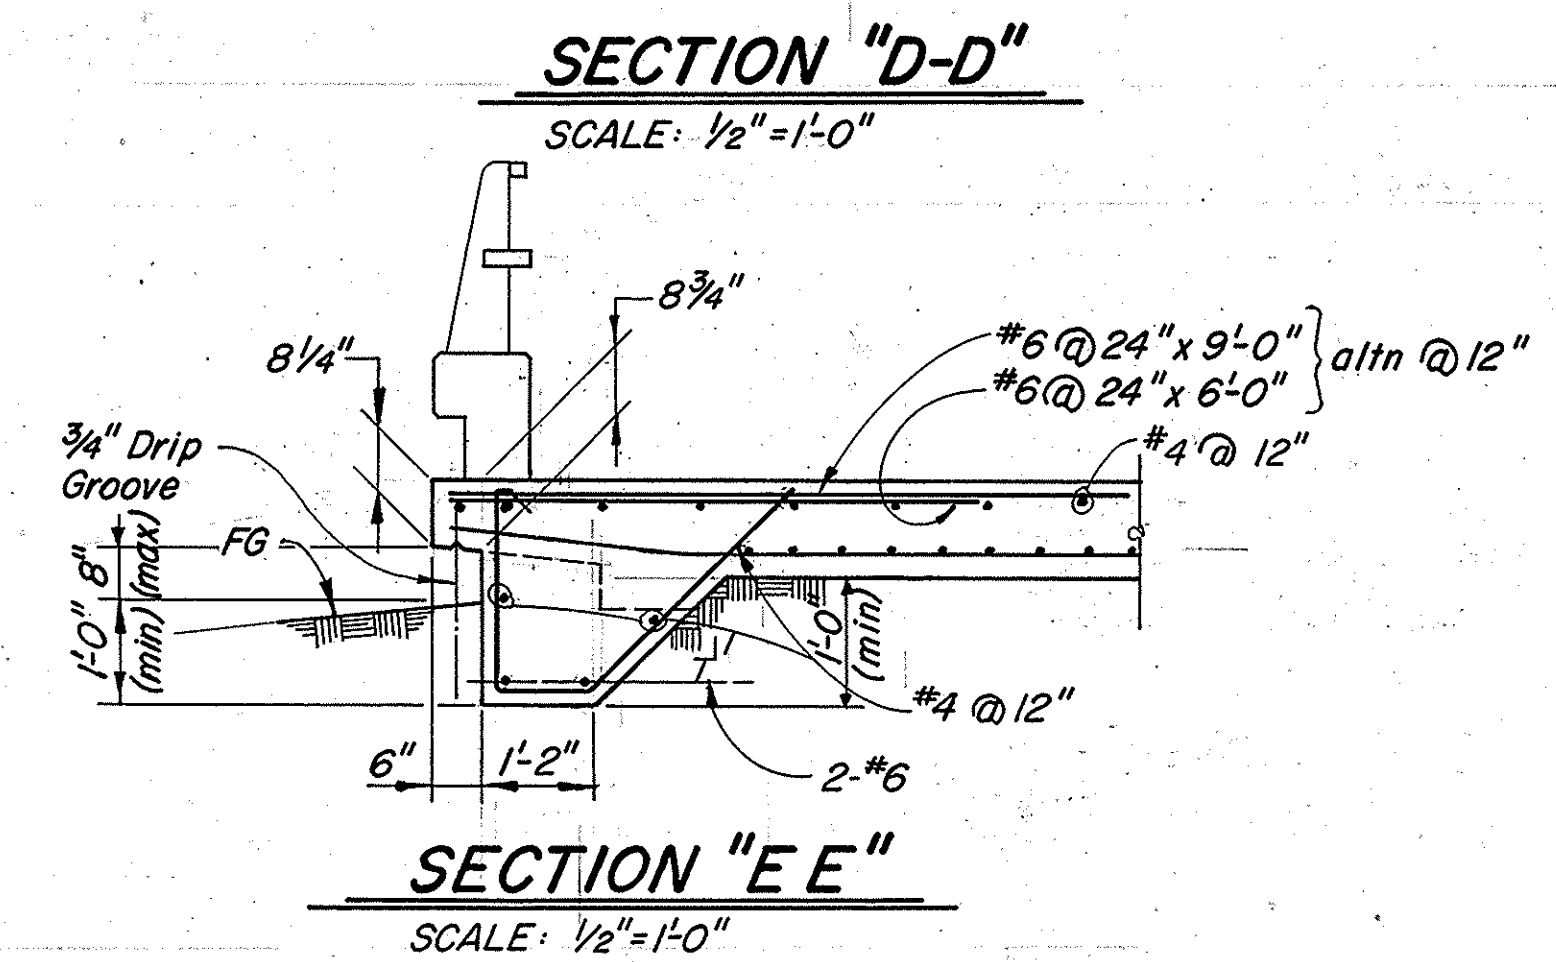
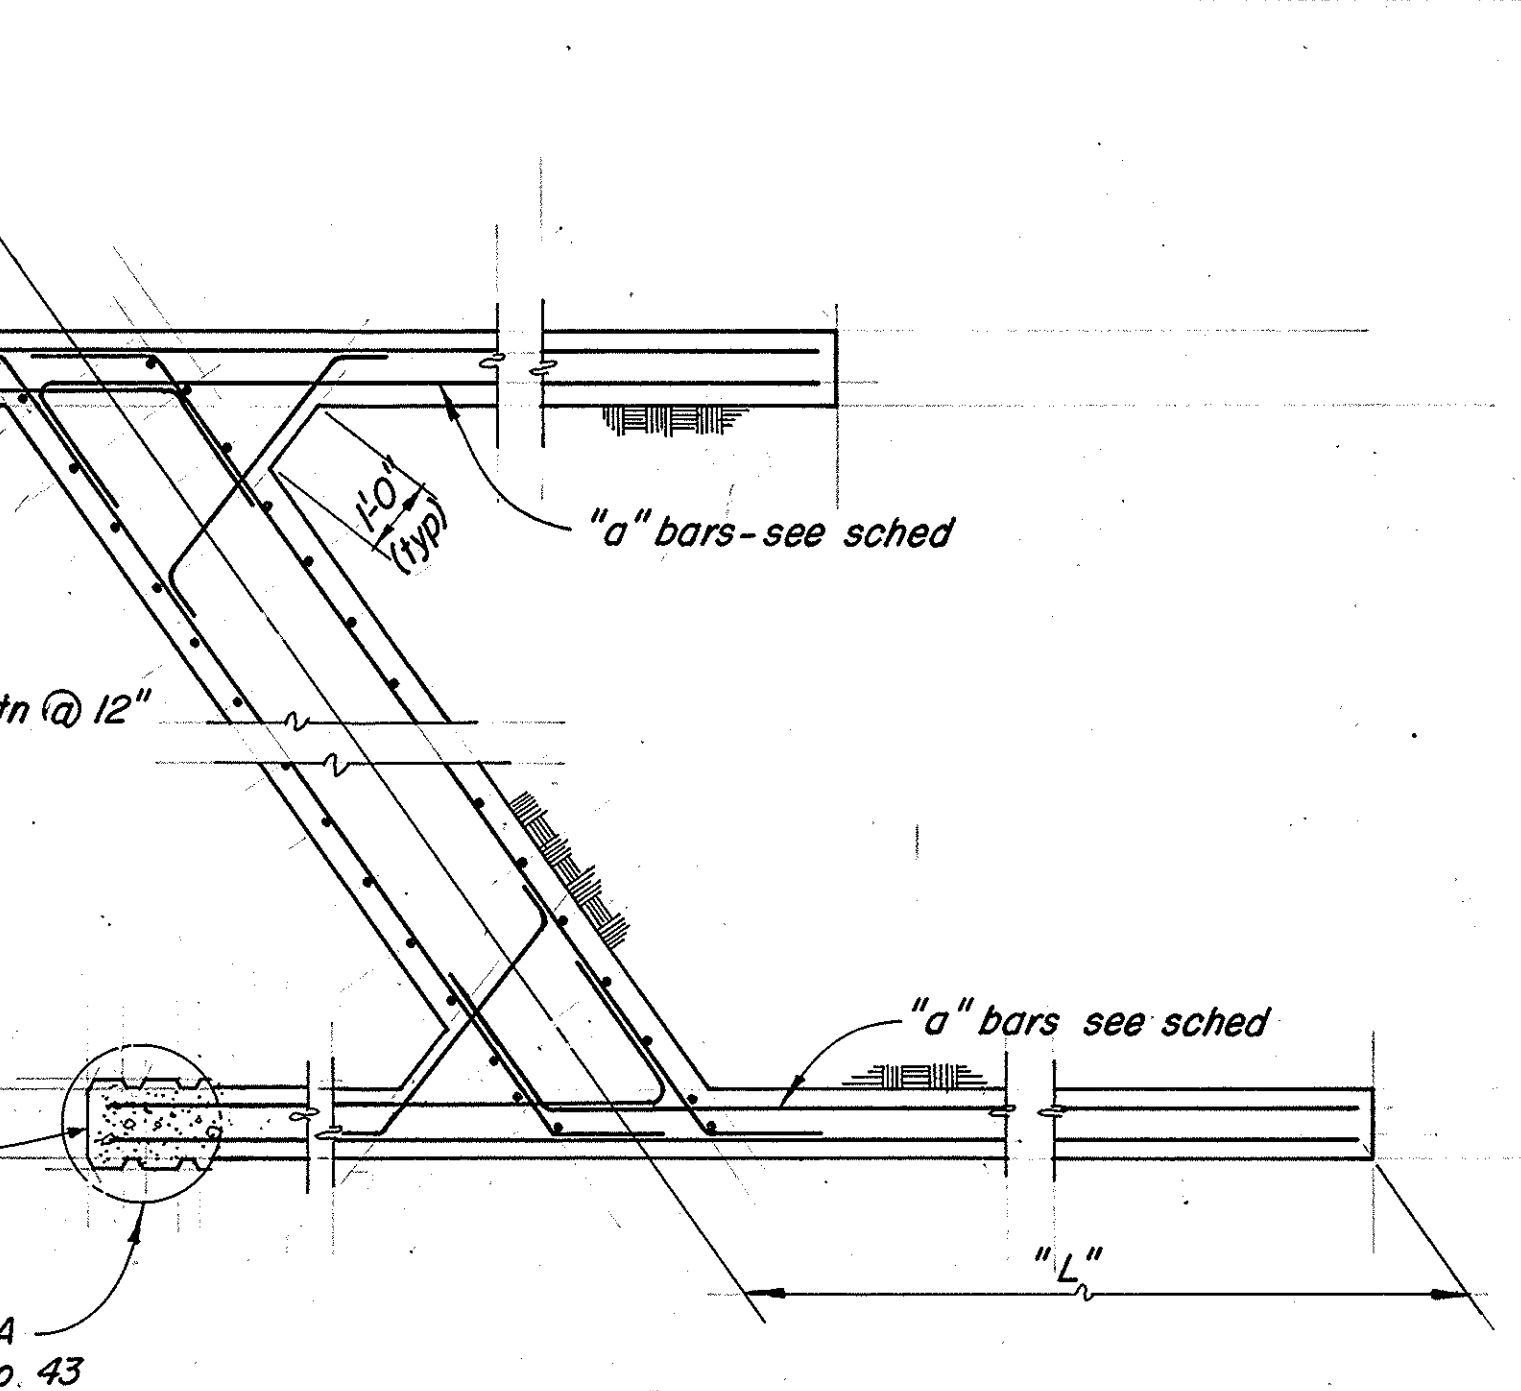
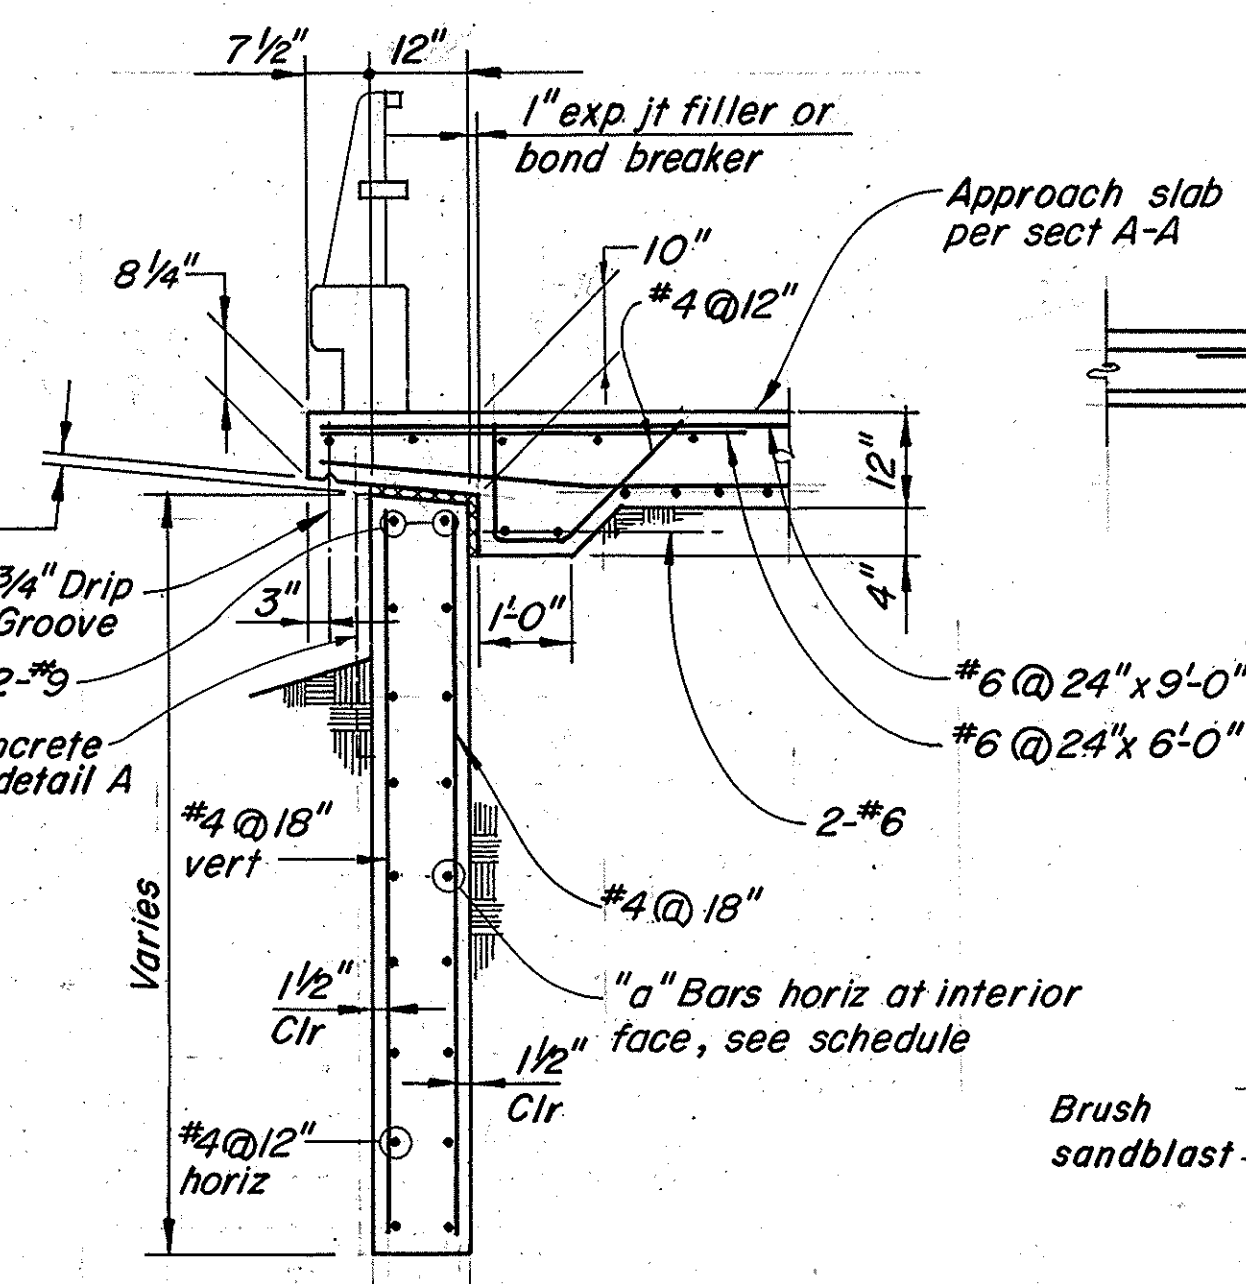
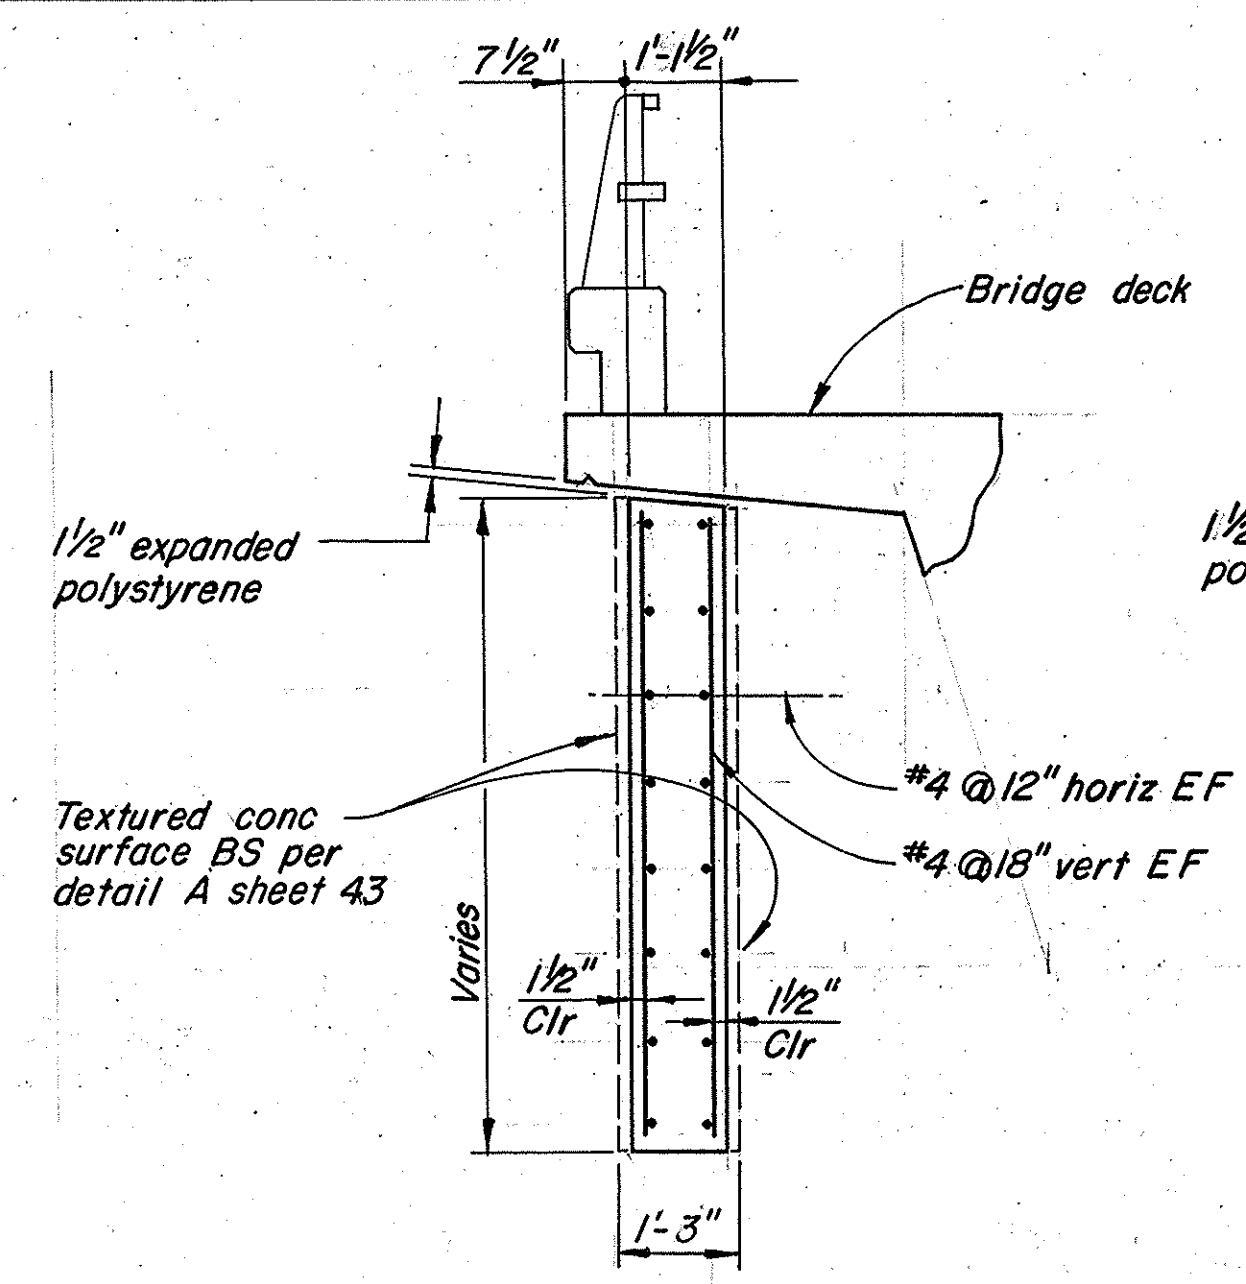
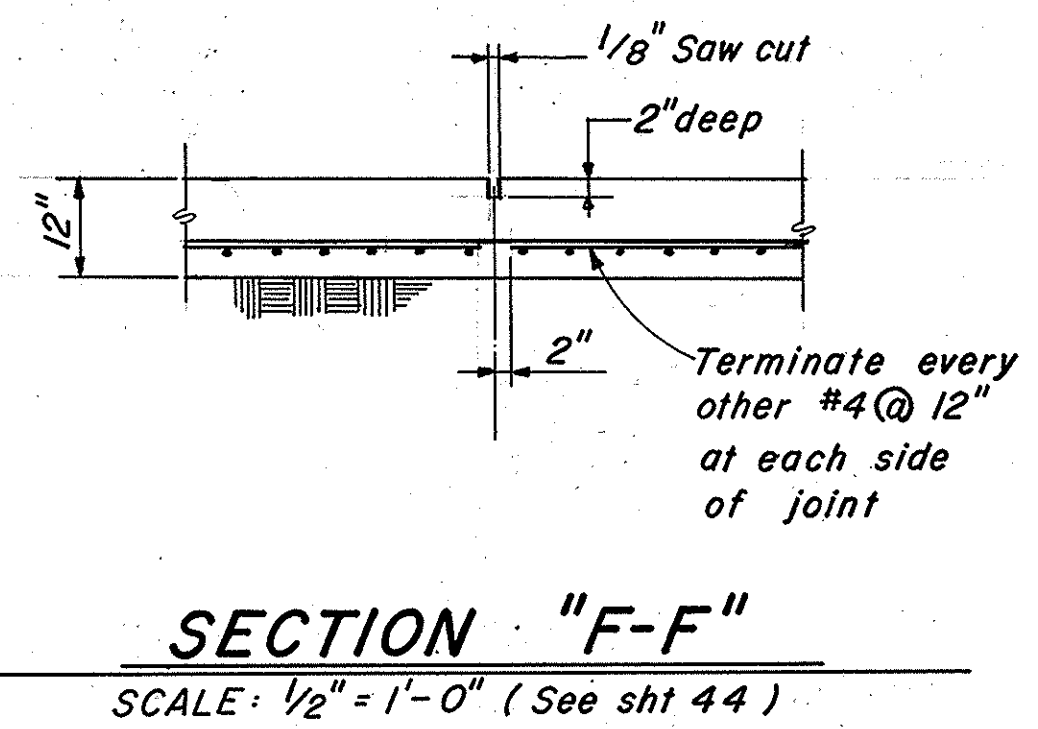


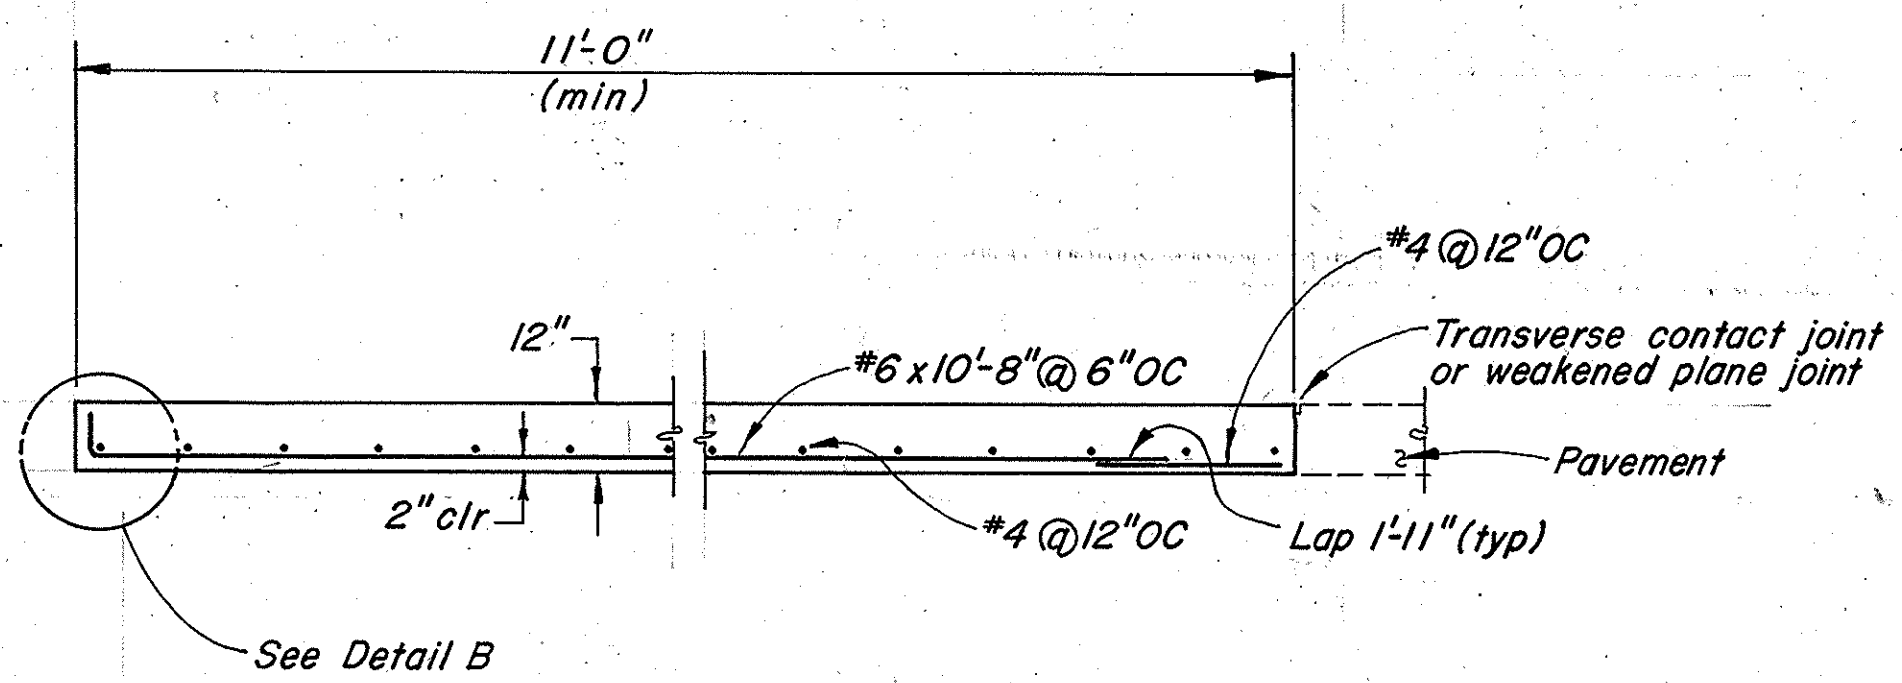

WINGWALL SCHEDULE		
Location	"L"	"a" bars
North-East	16'-0"	#7 @ 8"
North-West	15'-0"	#7 @ 9"
South-East	12'-0"	#7 @ 12"
South-West	15'-0"	#7 @ 9"

1 1/2 0 1 2
3 inches on original drawing

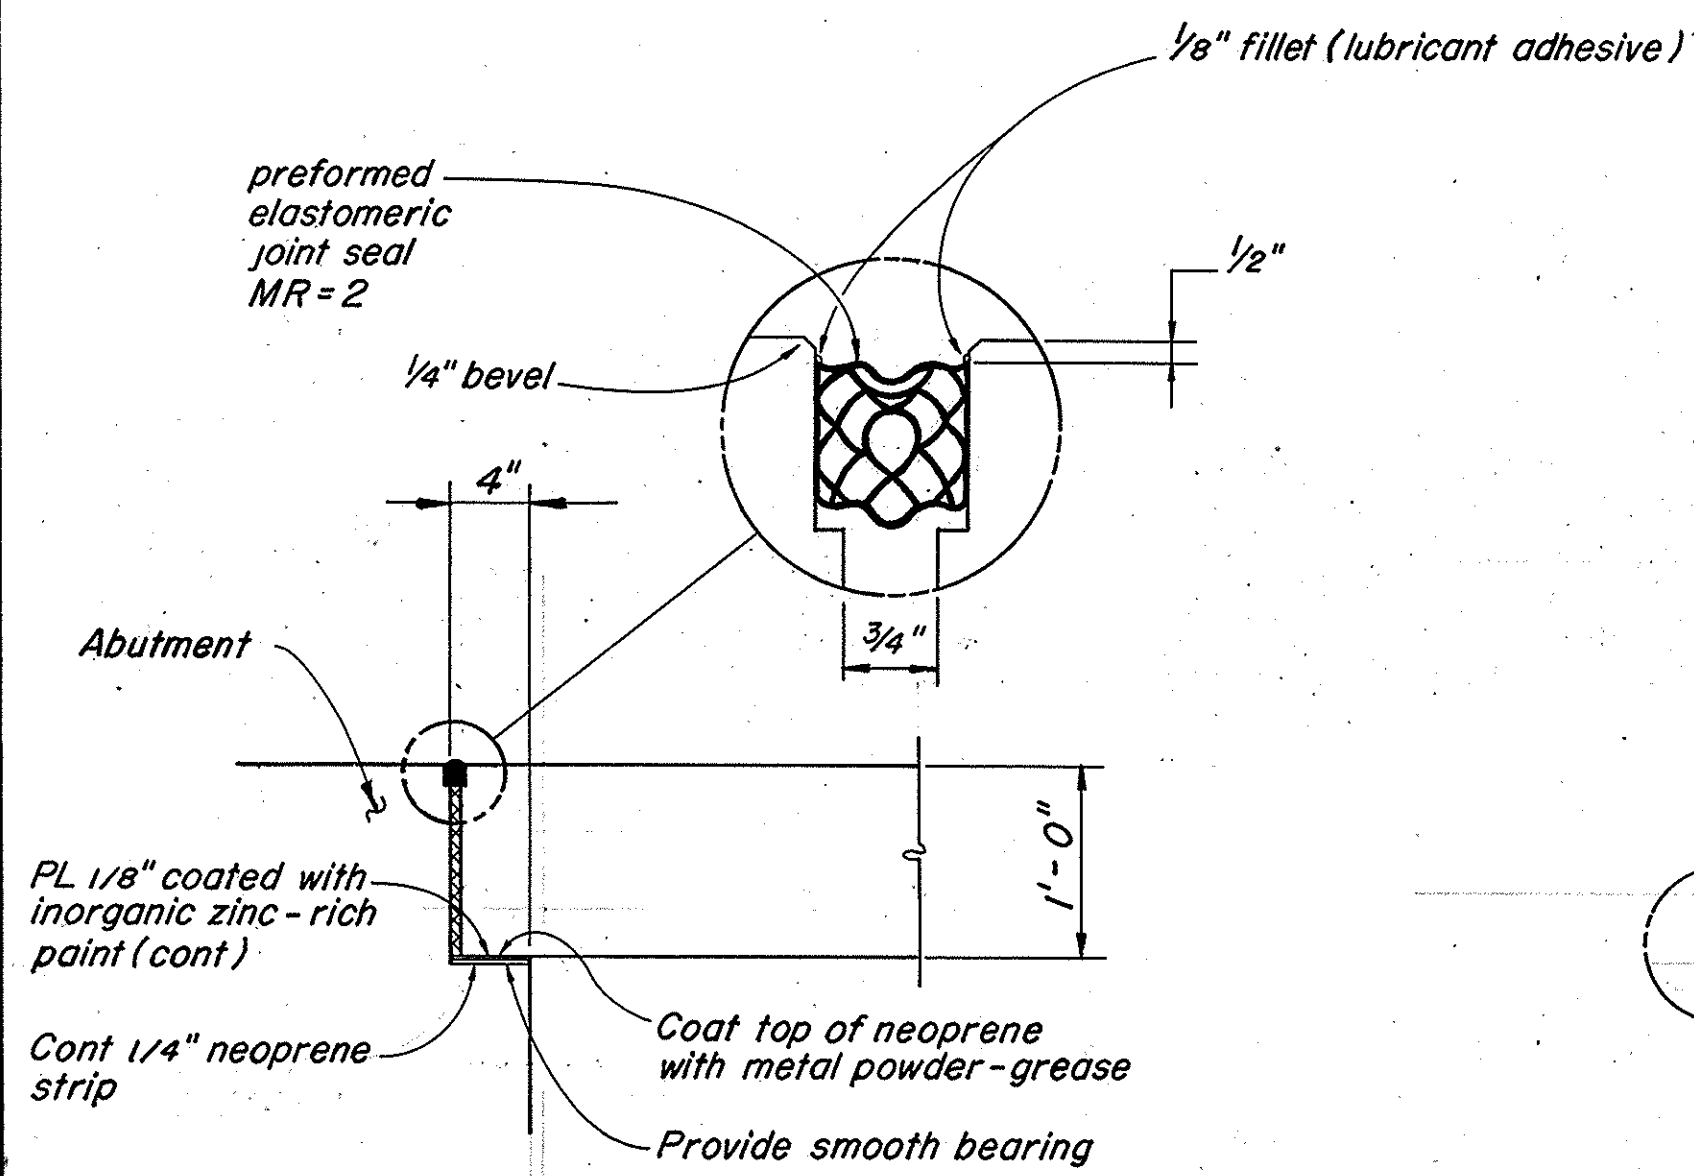

ORANGE COUNTY ENVIRONMENTAL MANAGEMENT AGENCY		EL TORO ROAD BRIDGE NO. AL 0.5 AT ALISO CREEK	
TYPICAL WING WALL & APPROACH SLAB			
MARK	DATE	DESCRIPTION	PREPARED UNDER SUPERVISION OF
DESIGNED	DTL	SCALE	DATE
DRAWN	JM	CHECKED	AS SHOWN
REVISIONS		DWG. NO.	
SHEET		48	