

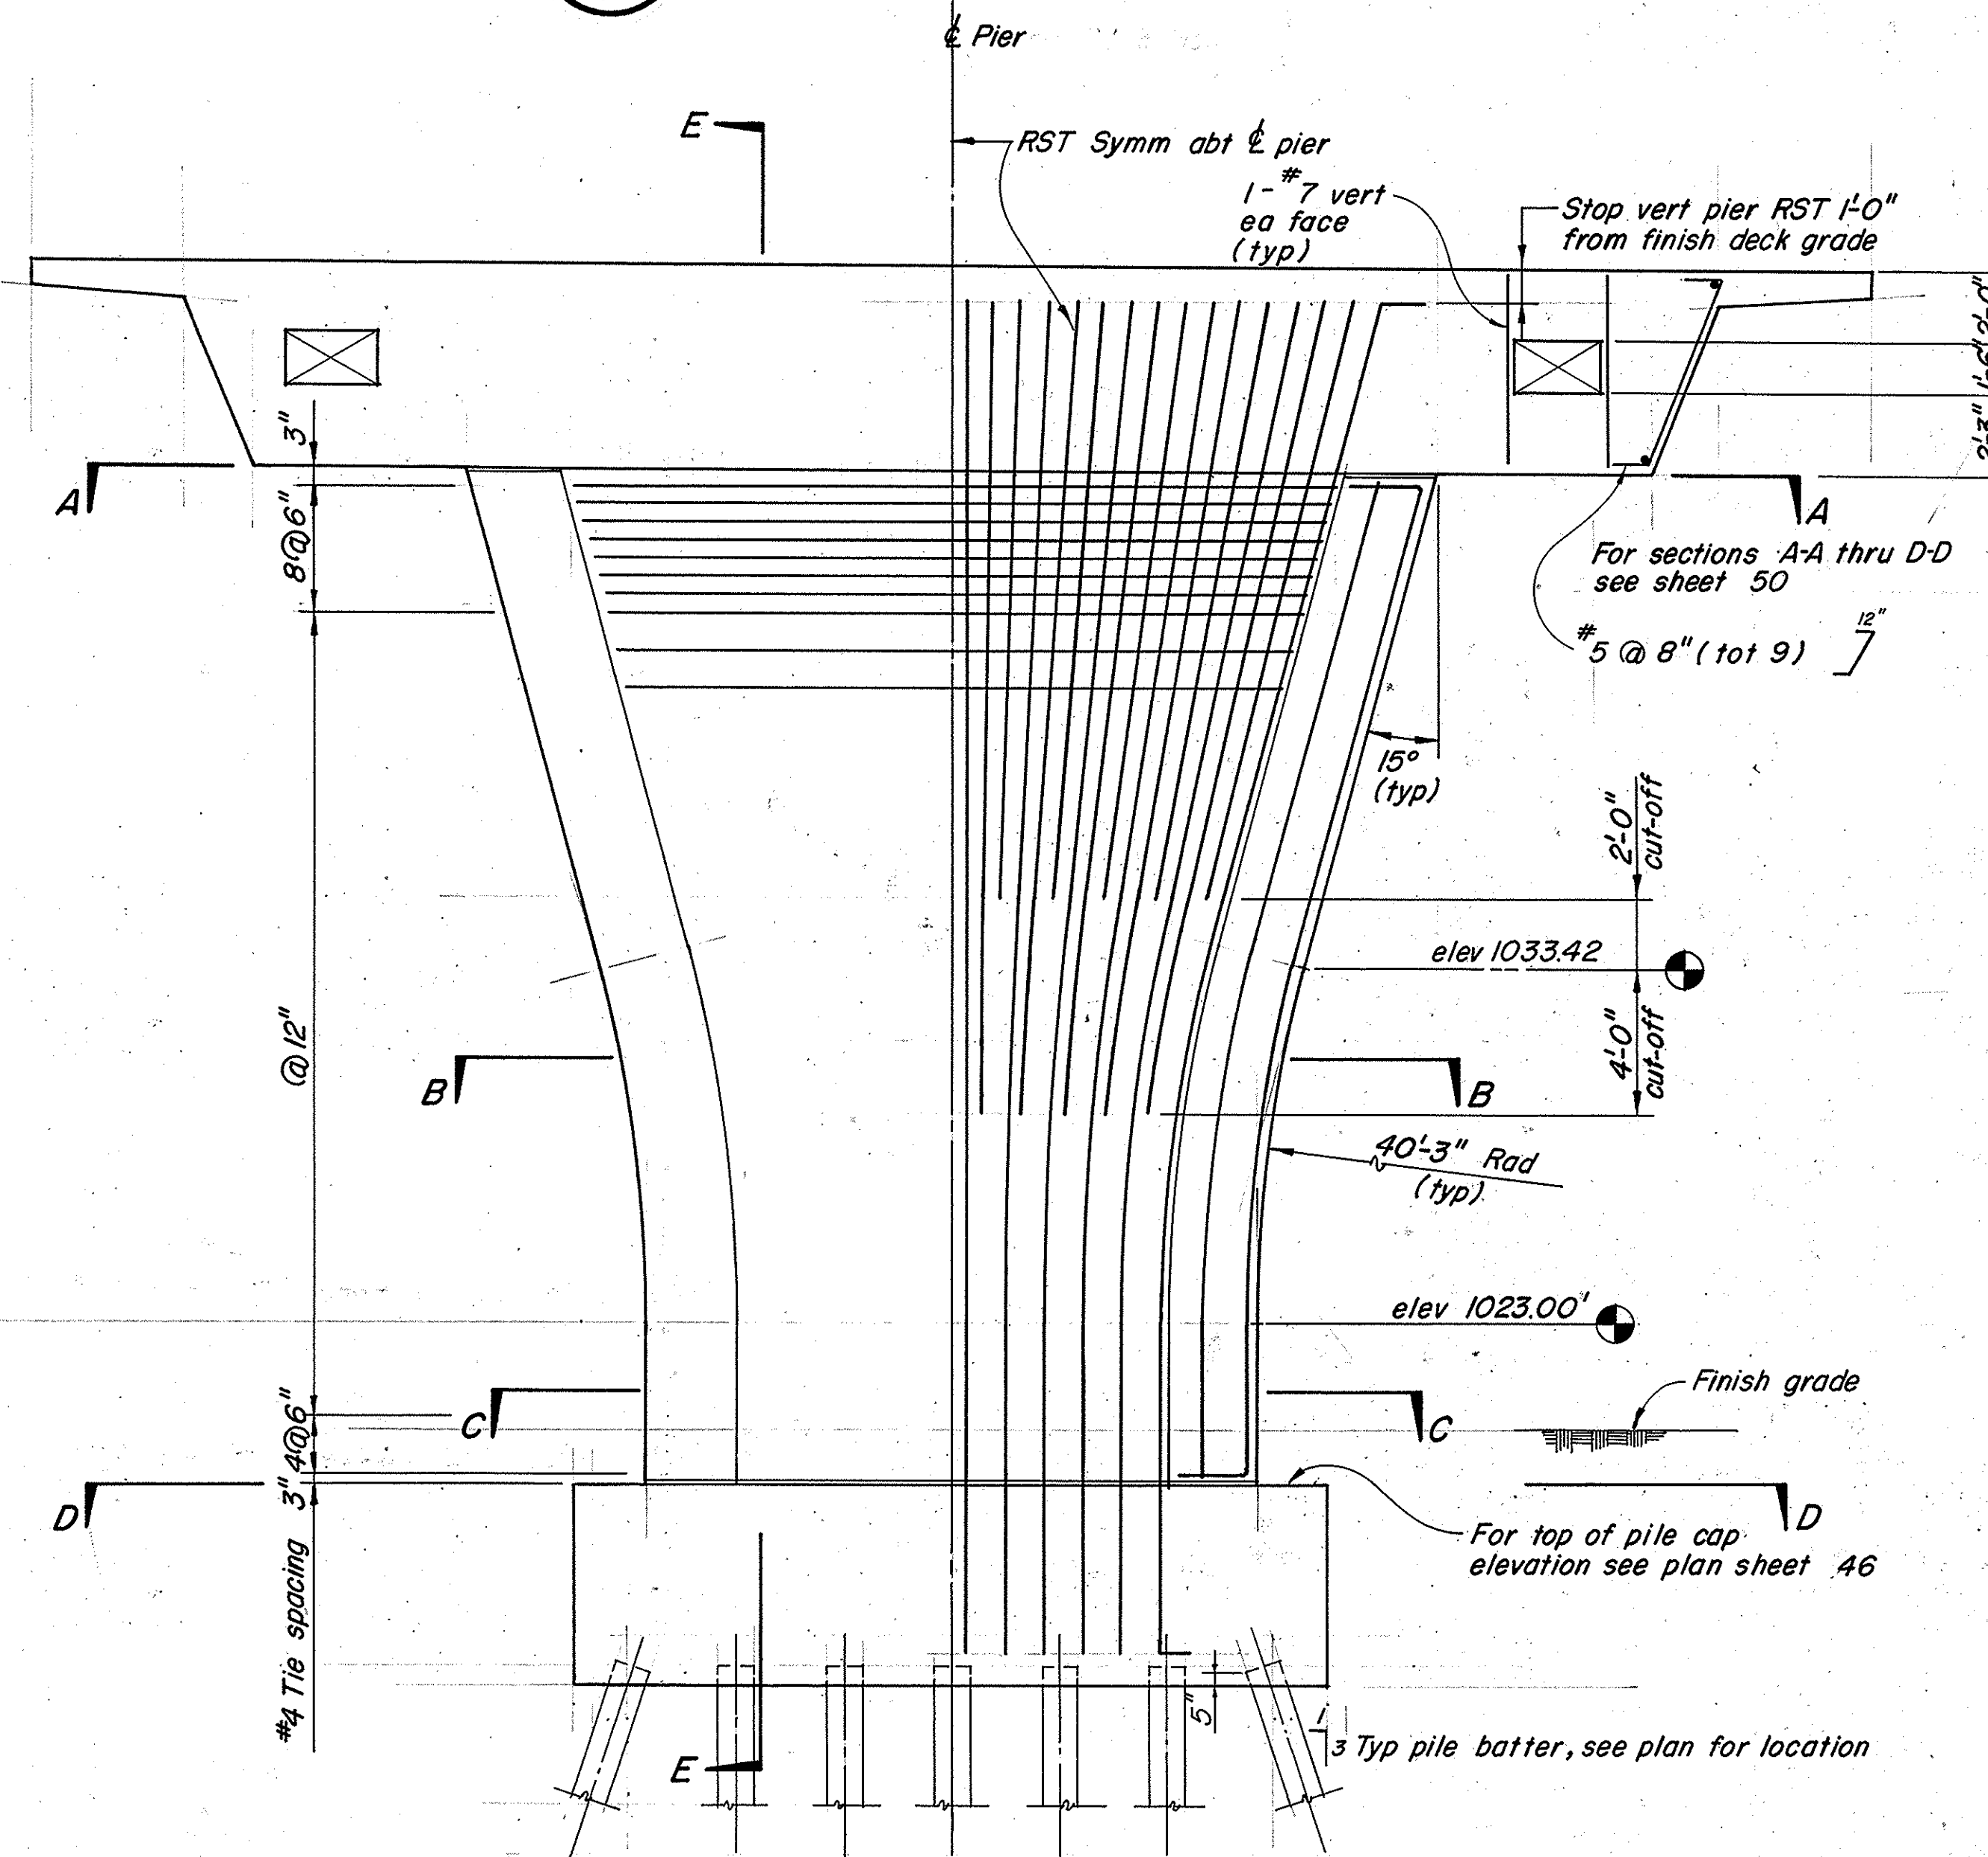
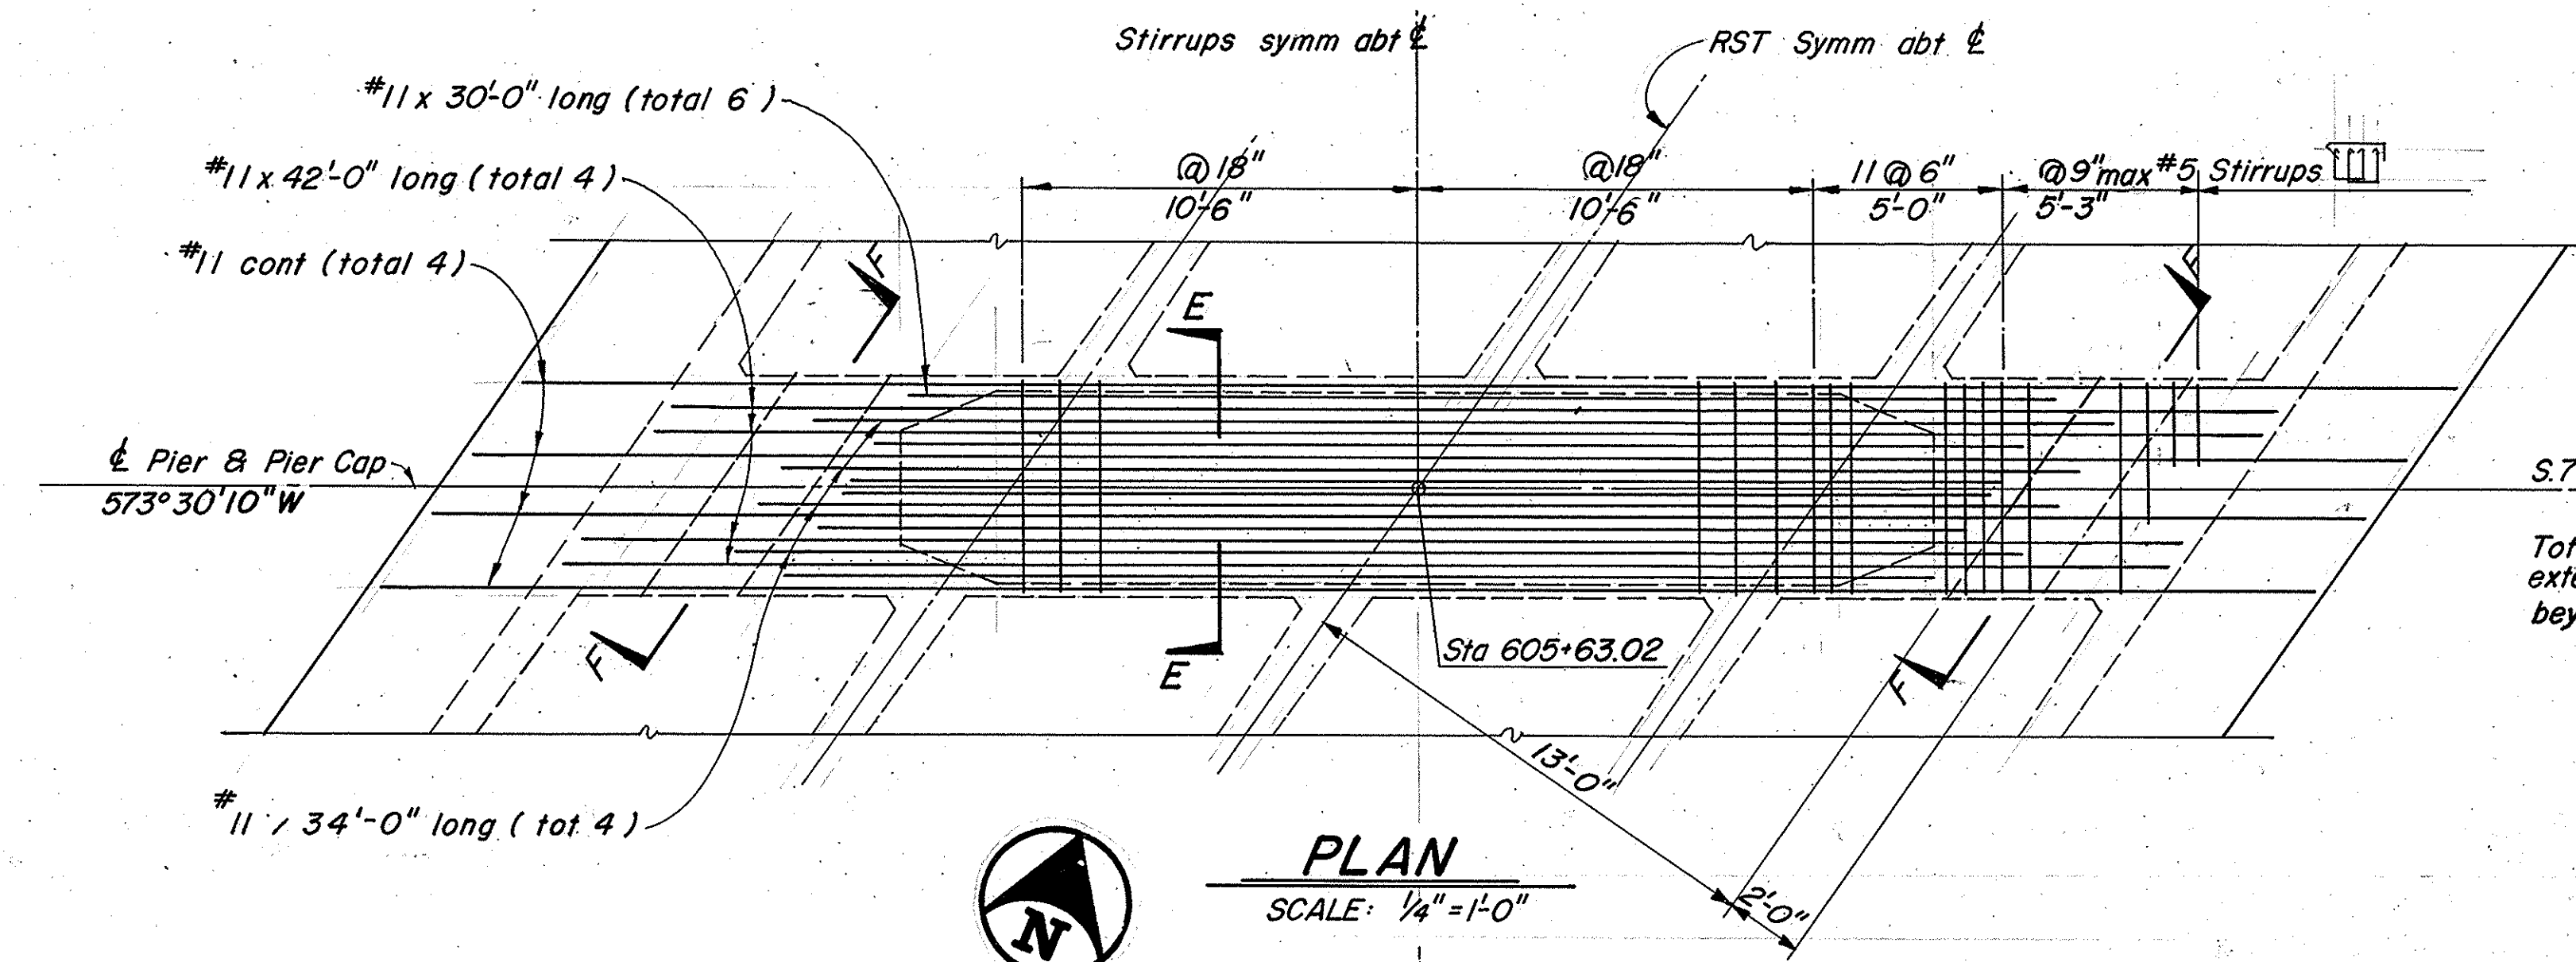
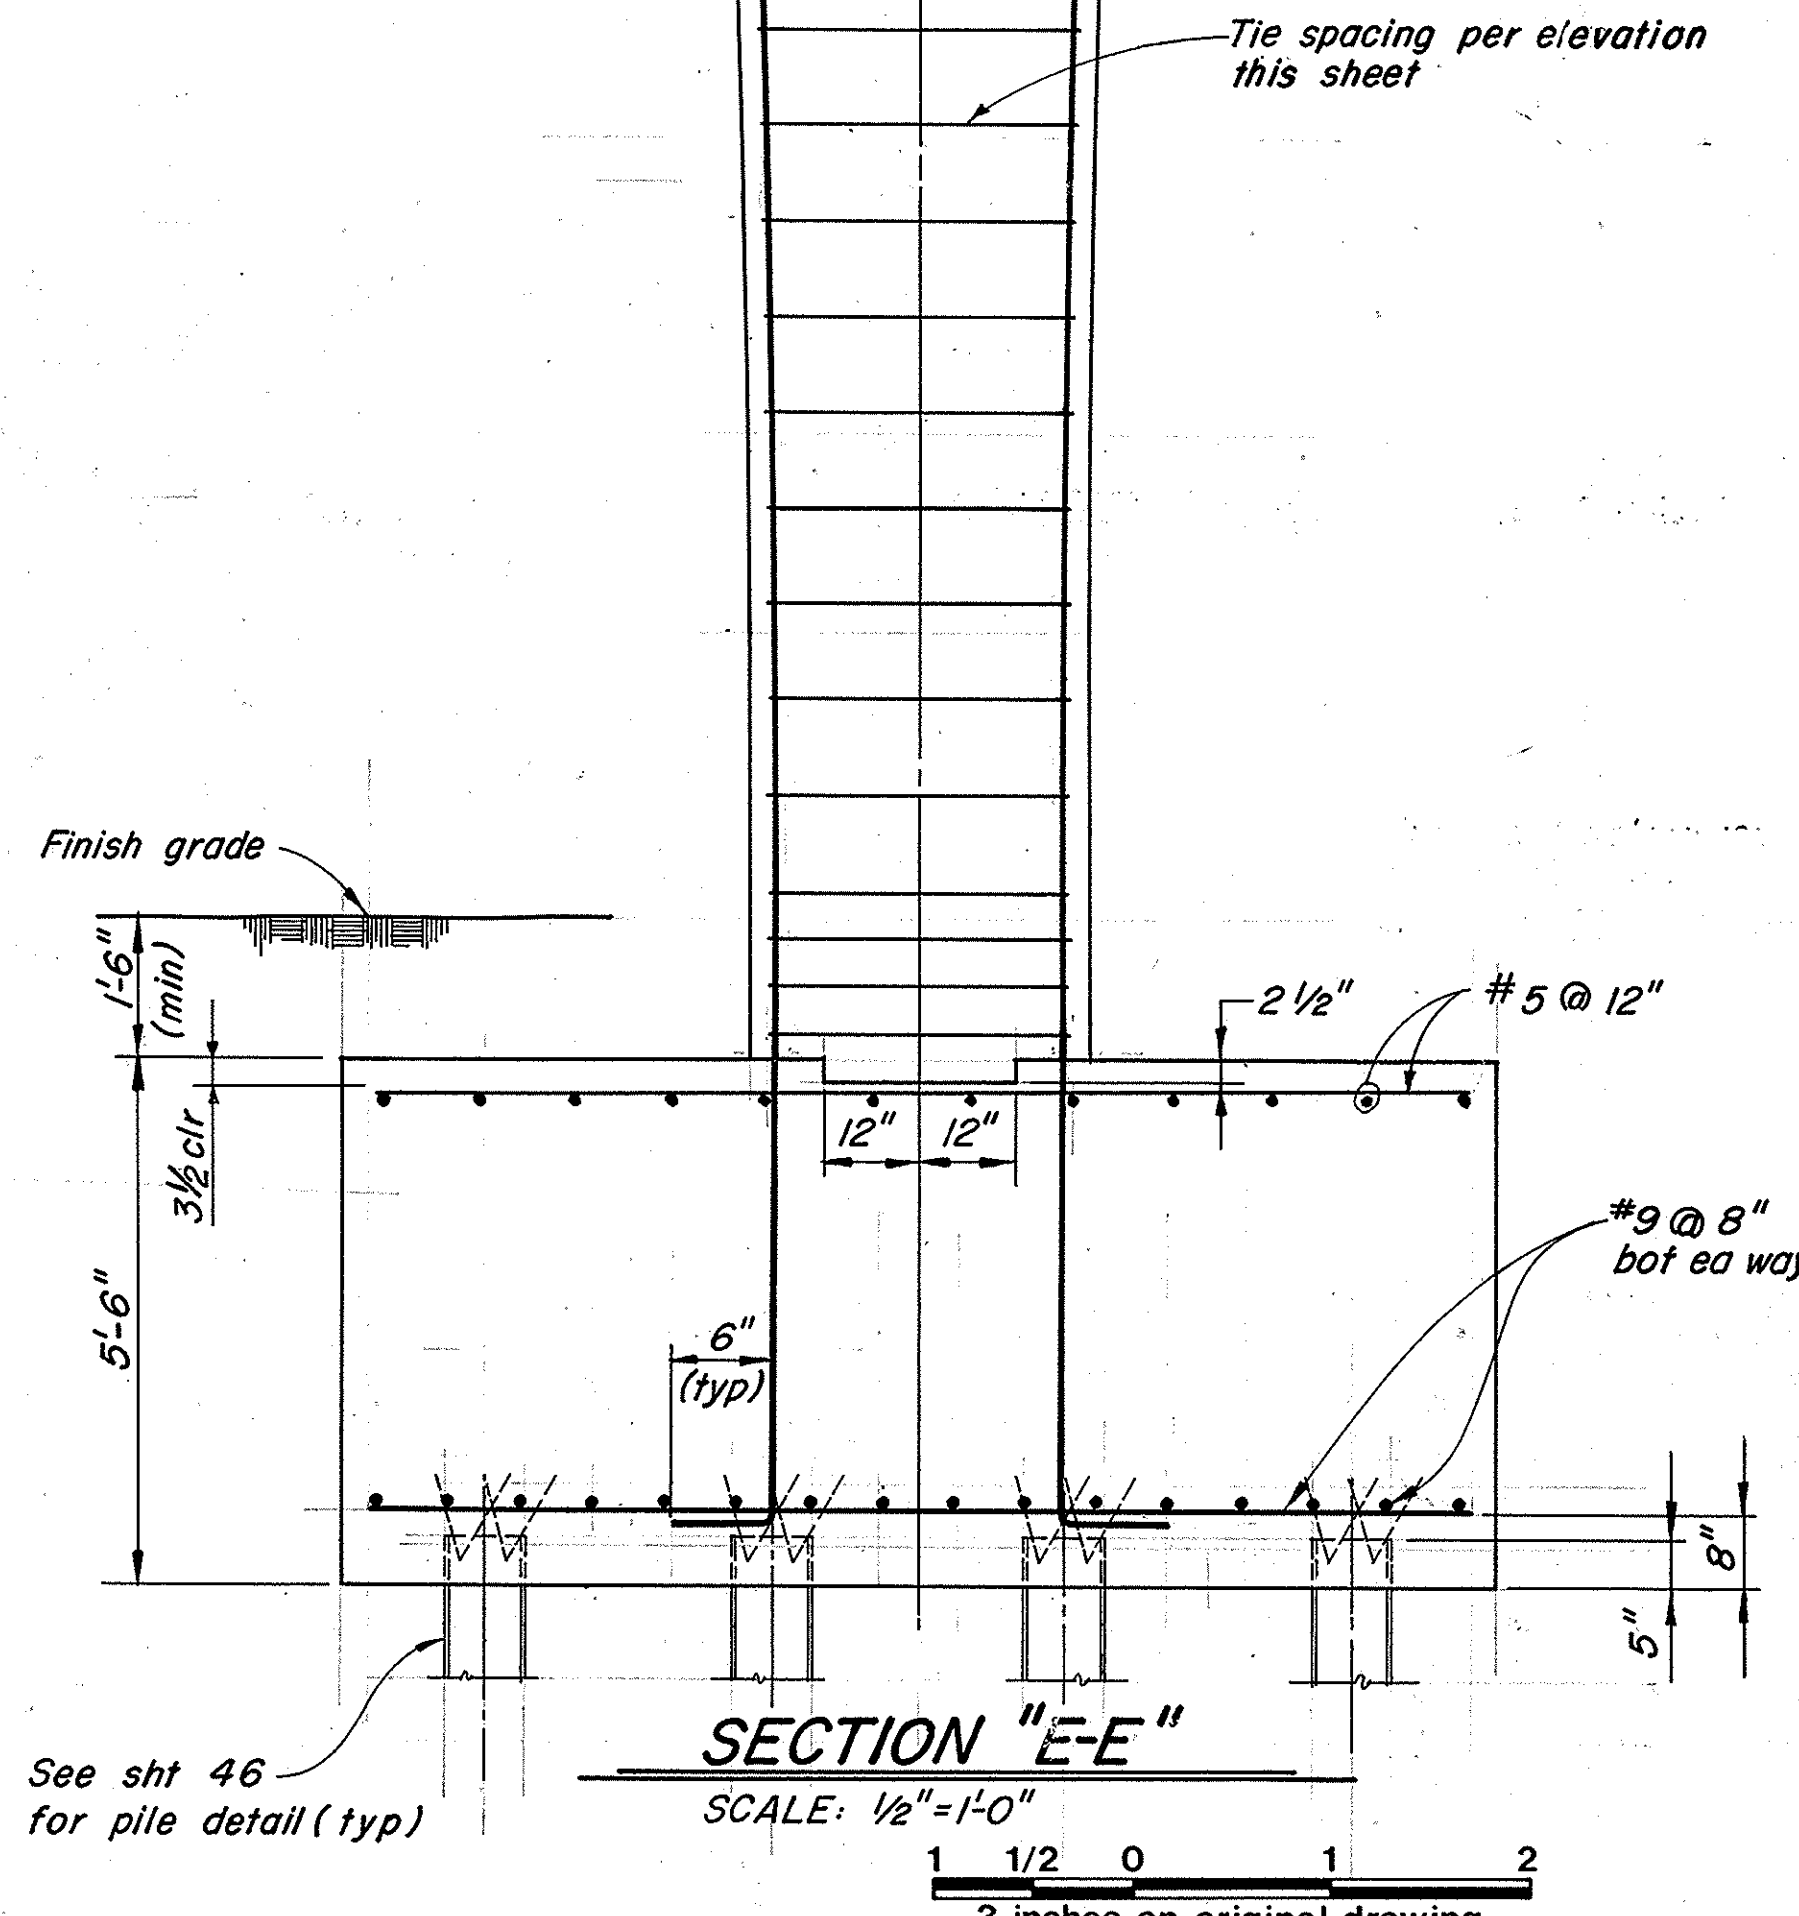
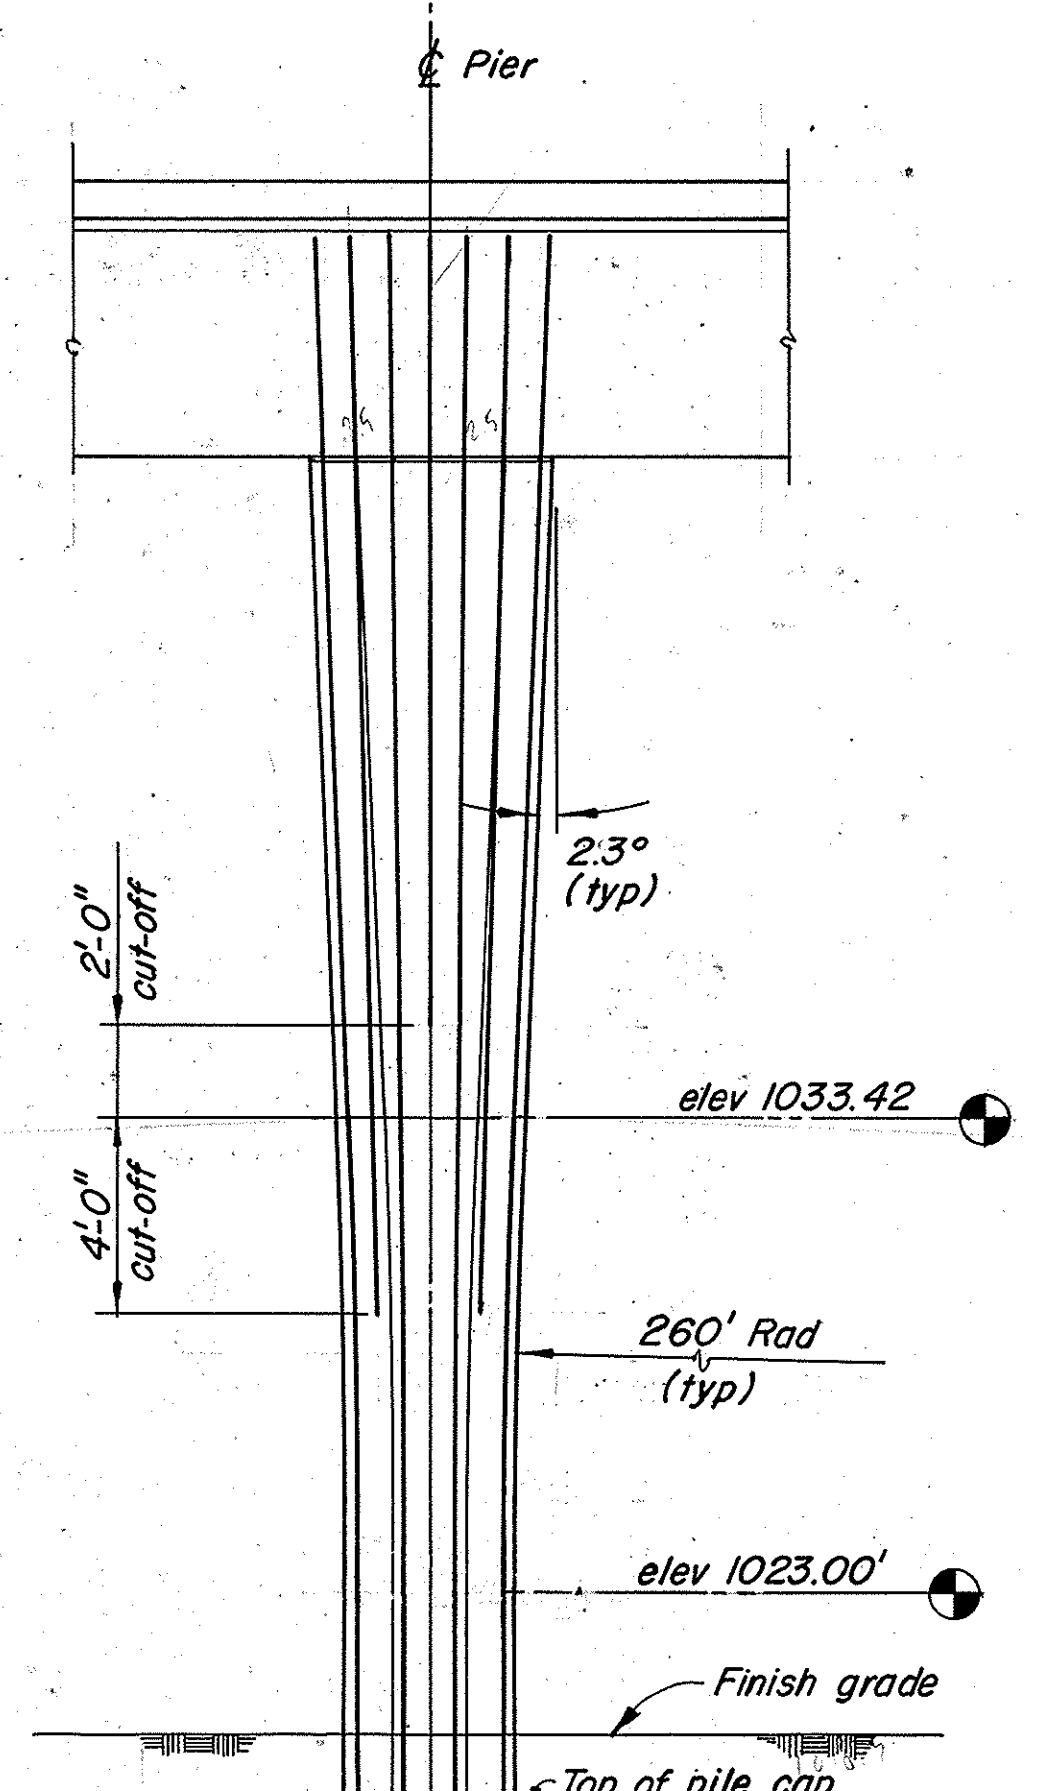


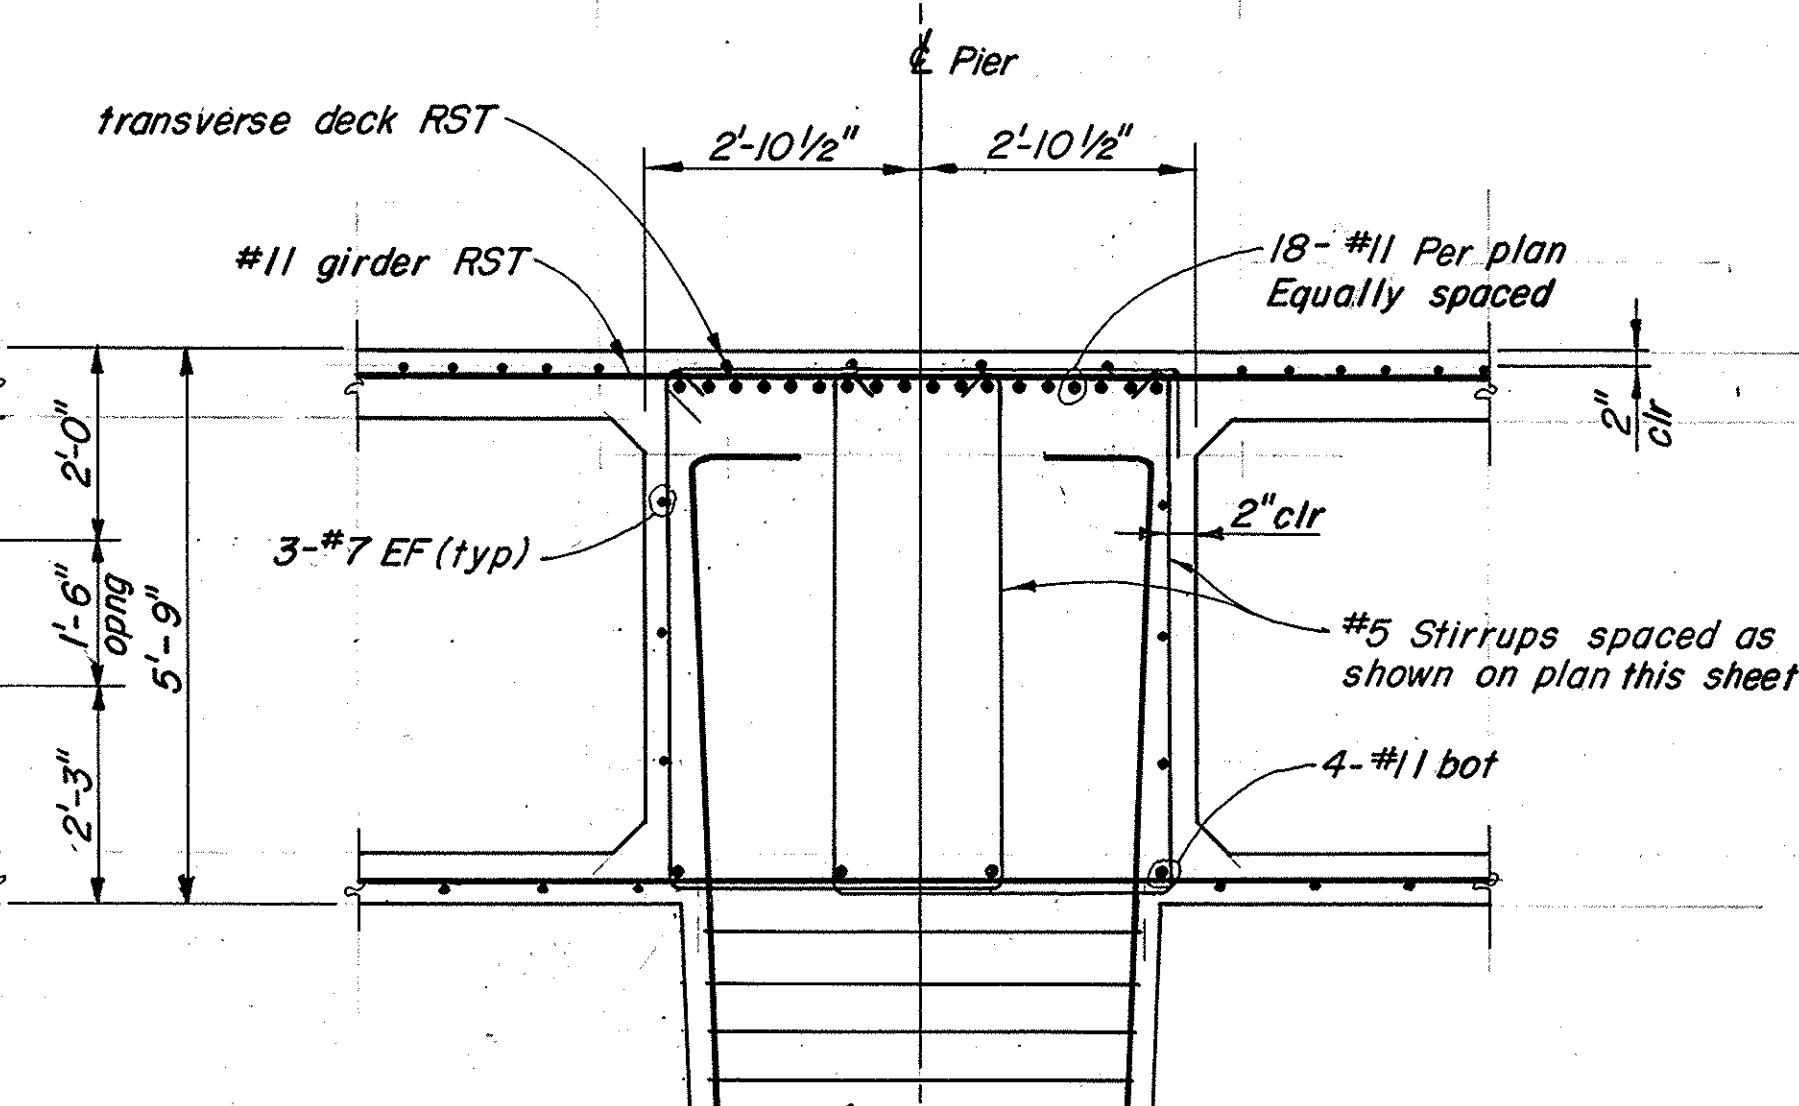

NOTE:
Reinf etc not shown or noted
see section EE and plan
this sheet

S.73°30'10"W.
Total 8-#7
extend 2'-0"
beyond opening

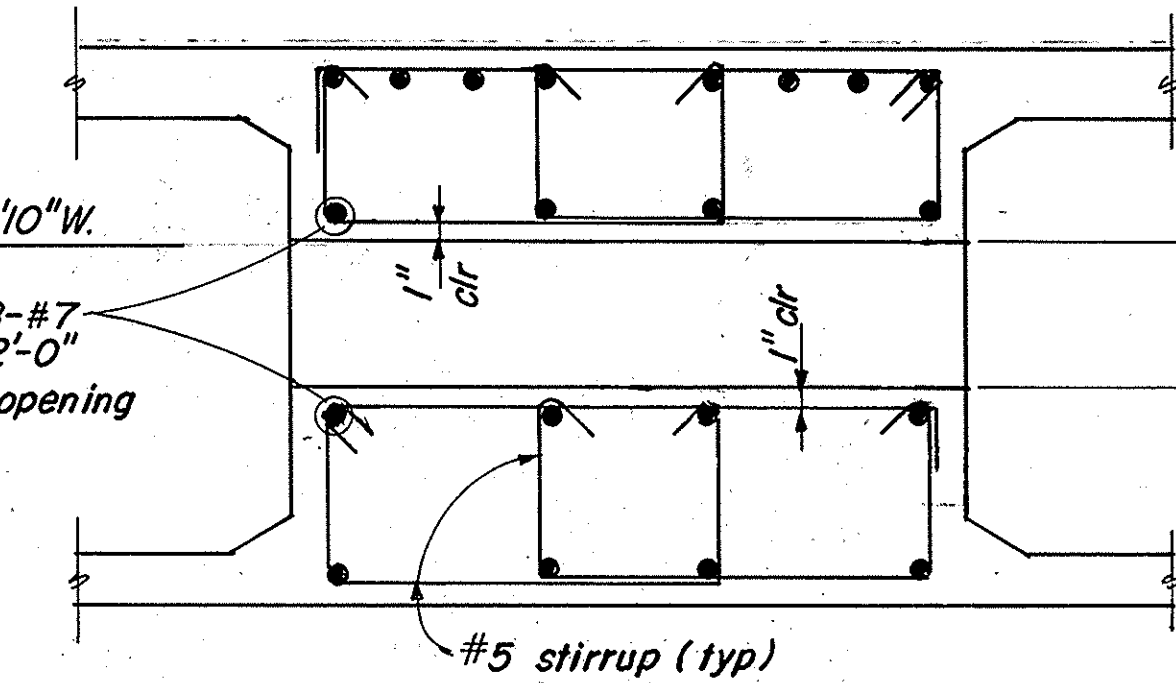

ORANGE COUNTY ENVIRONMENTAL MANAGEMENT AGENCY			
EL TORO ROAD BRIDGE NO. AL 0.5 AT ALISO CREEK			
PIER & PIER CAP			
MARK	DATE	DESCRIPTION	PREPARED UNDER SUPERVISION OF
DESIGNED	DATE	SCALE	DATE
DRAWN	CHECKED	AS SHOWN	DWG. NO.
SHEET			49