

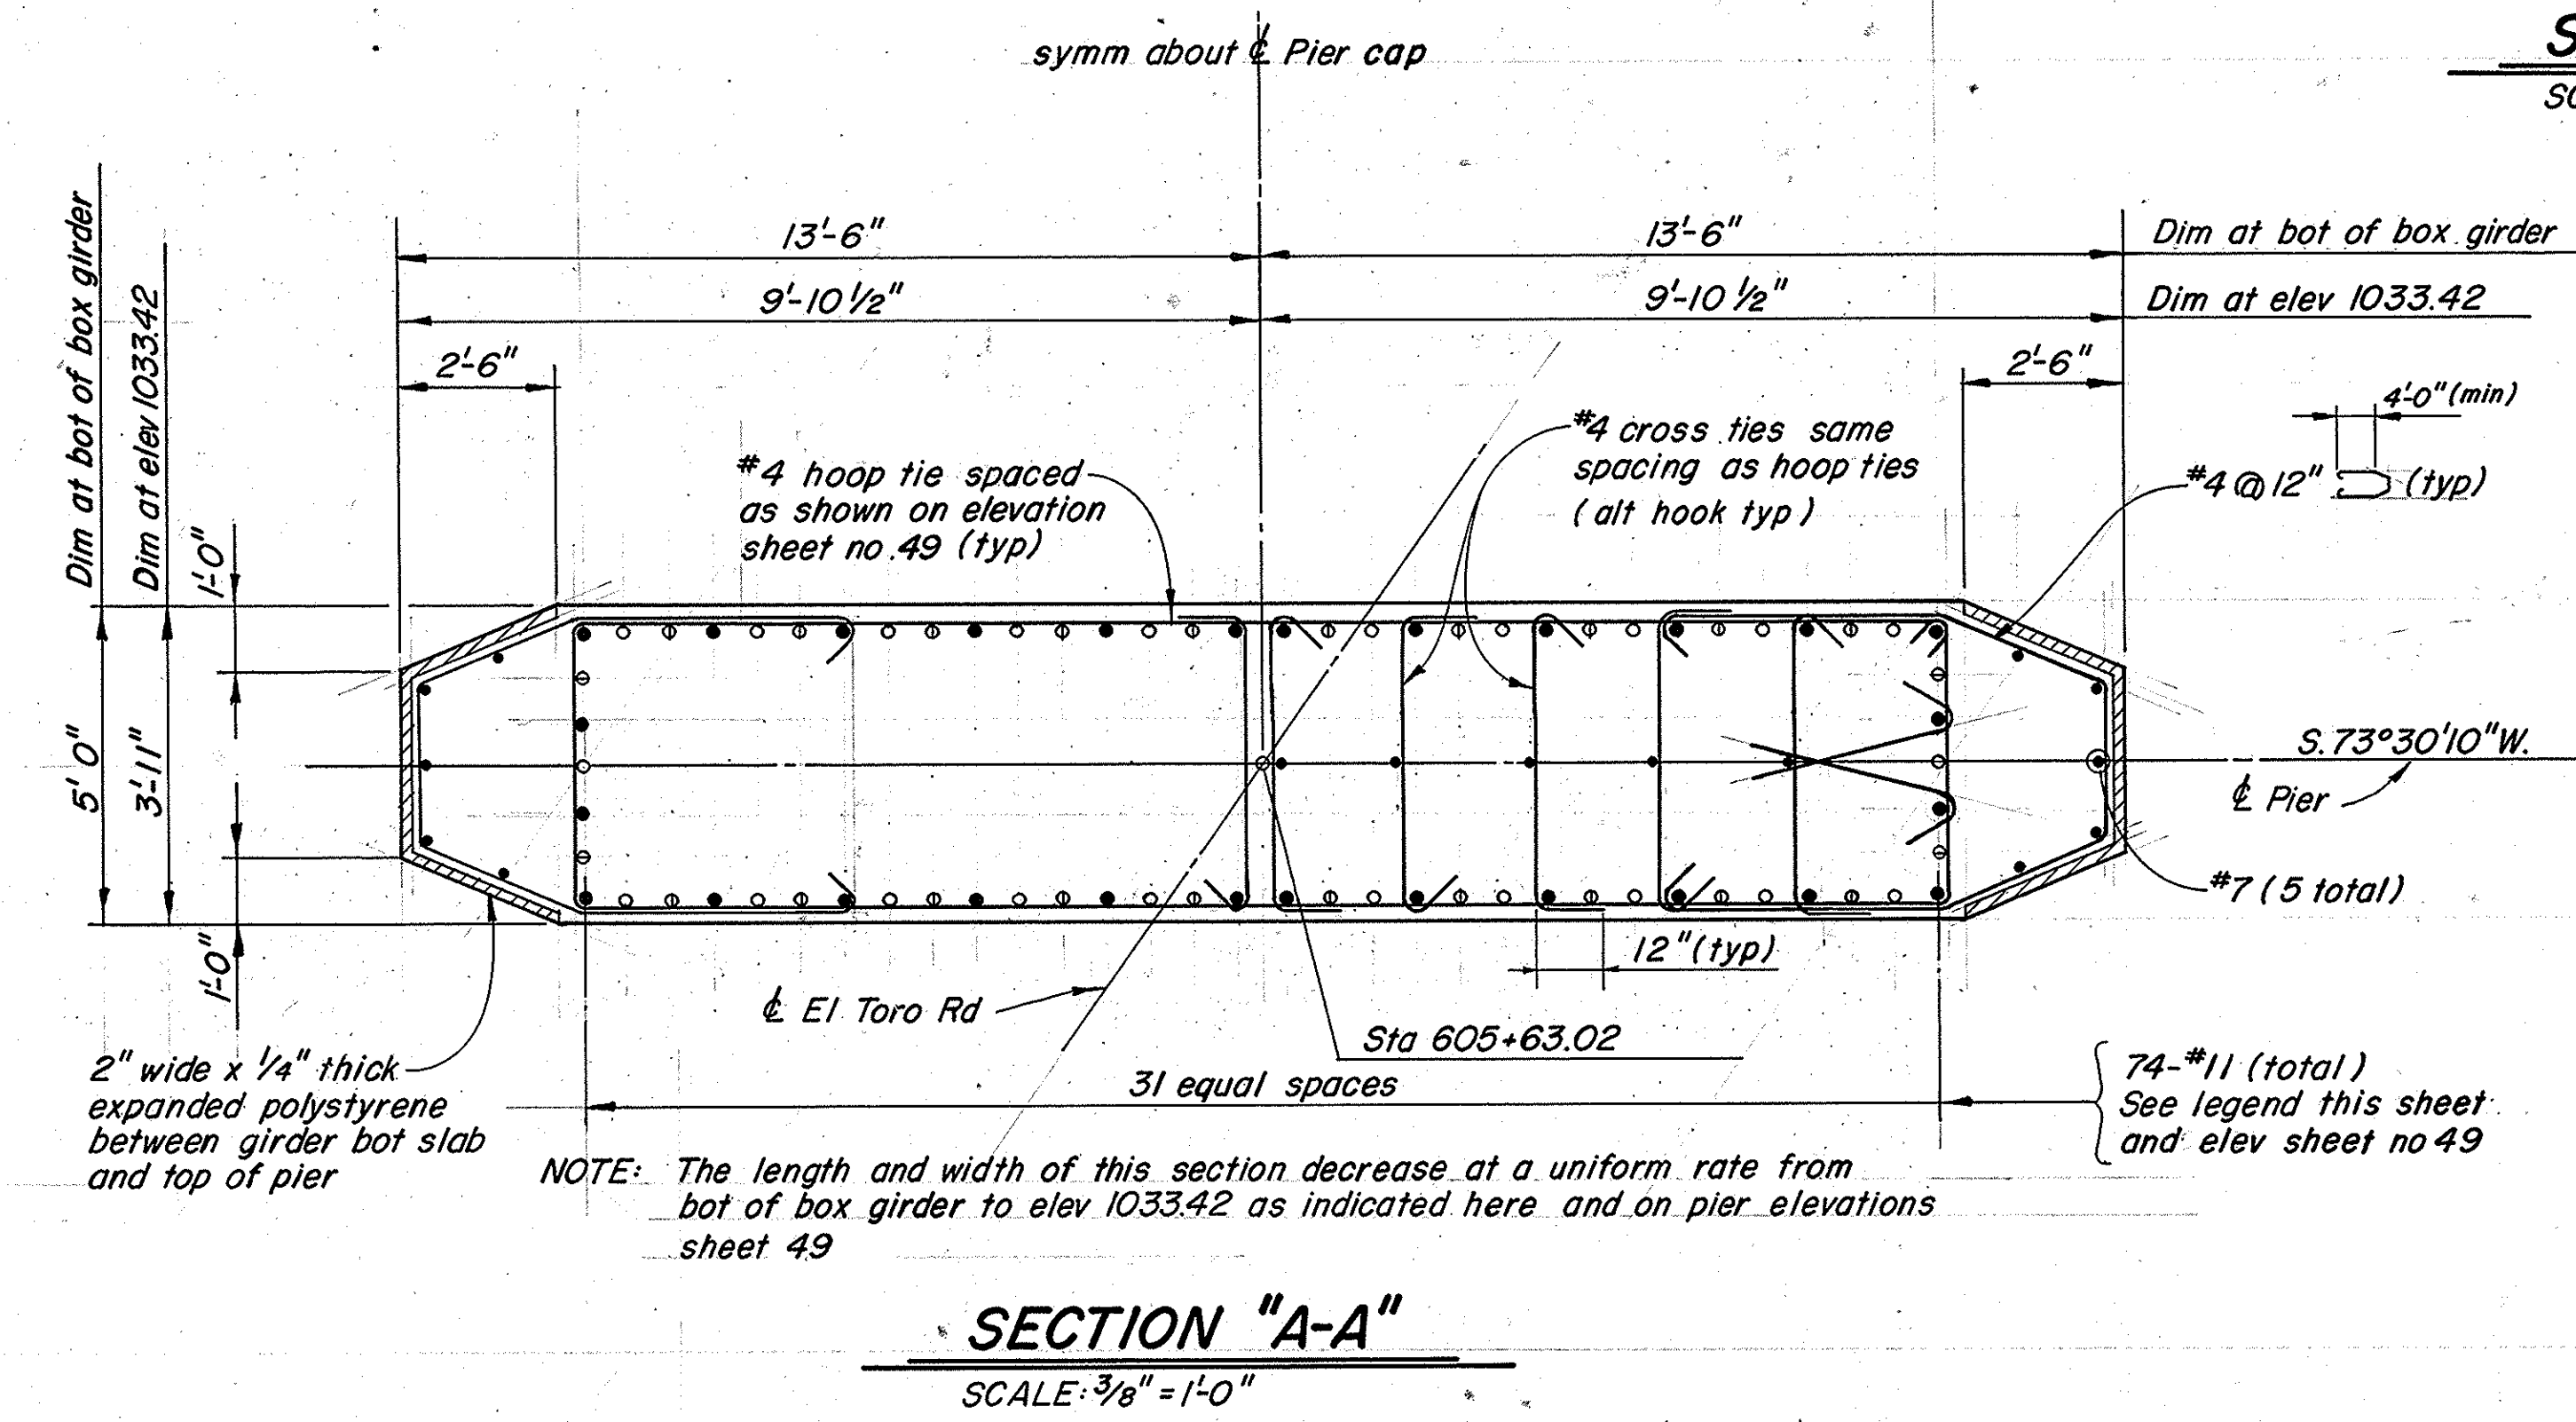
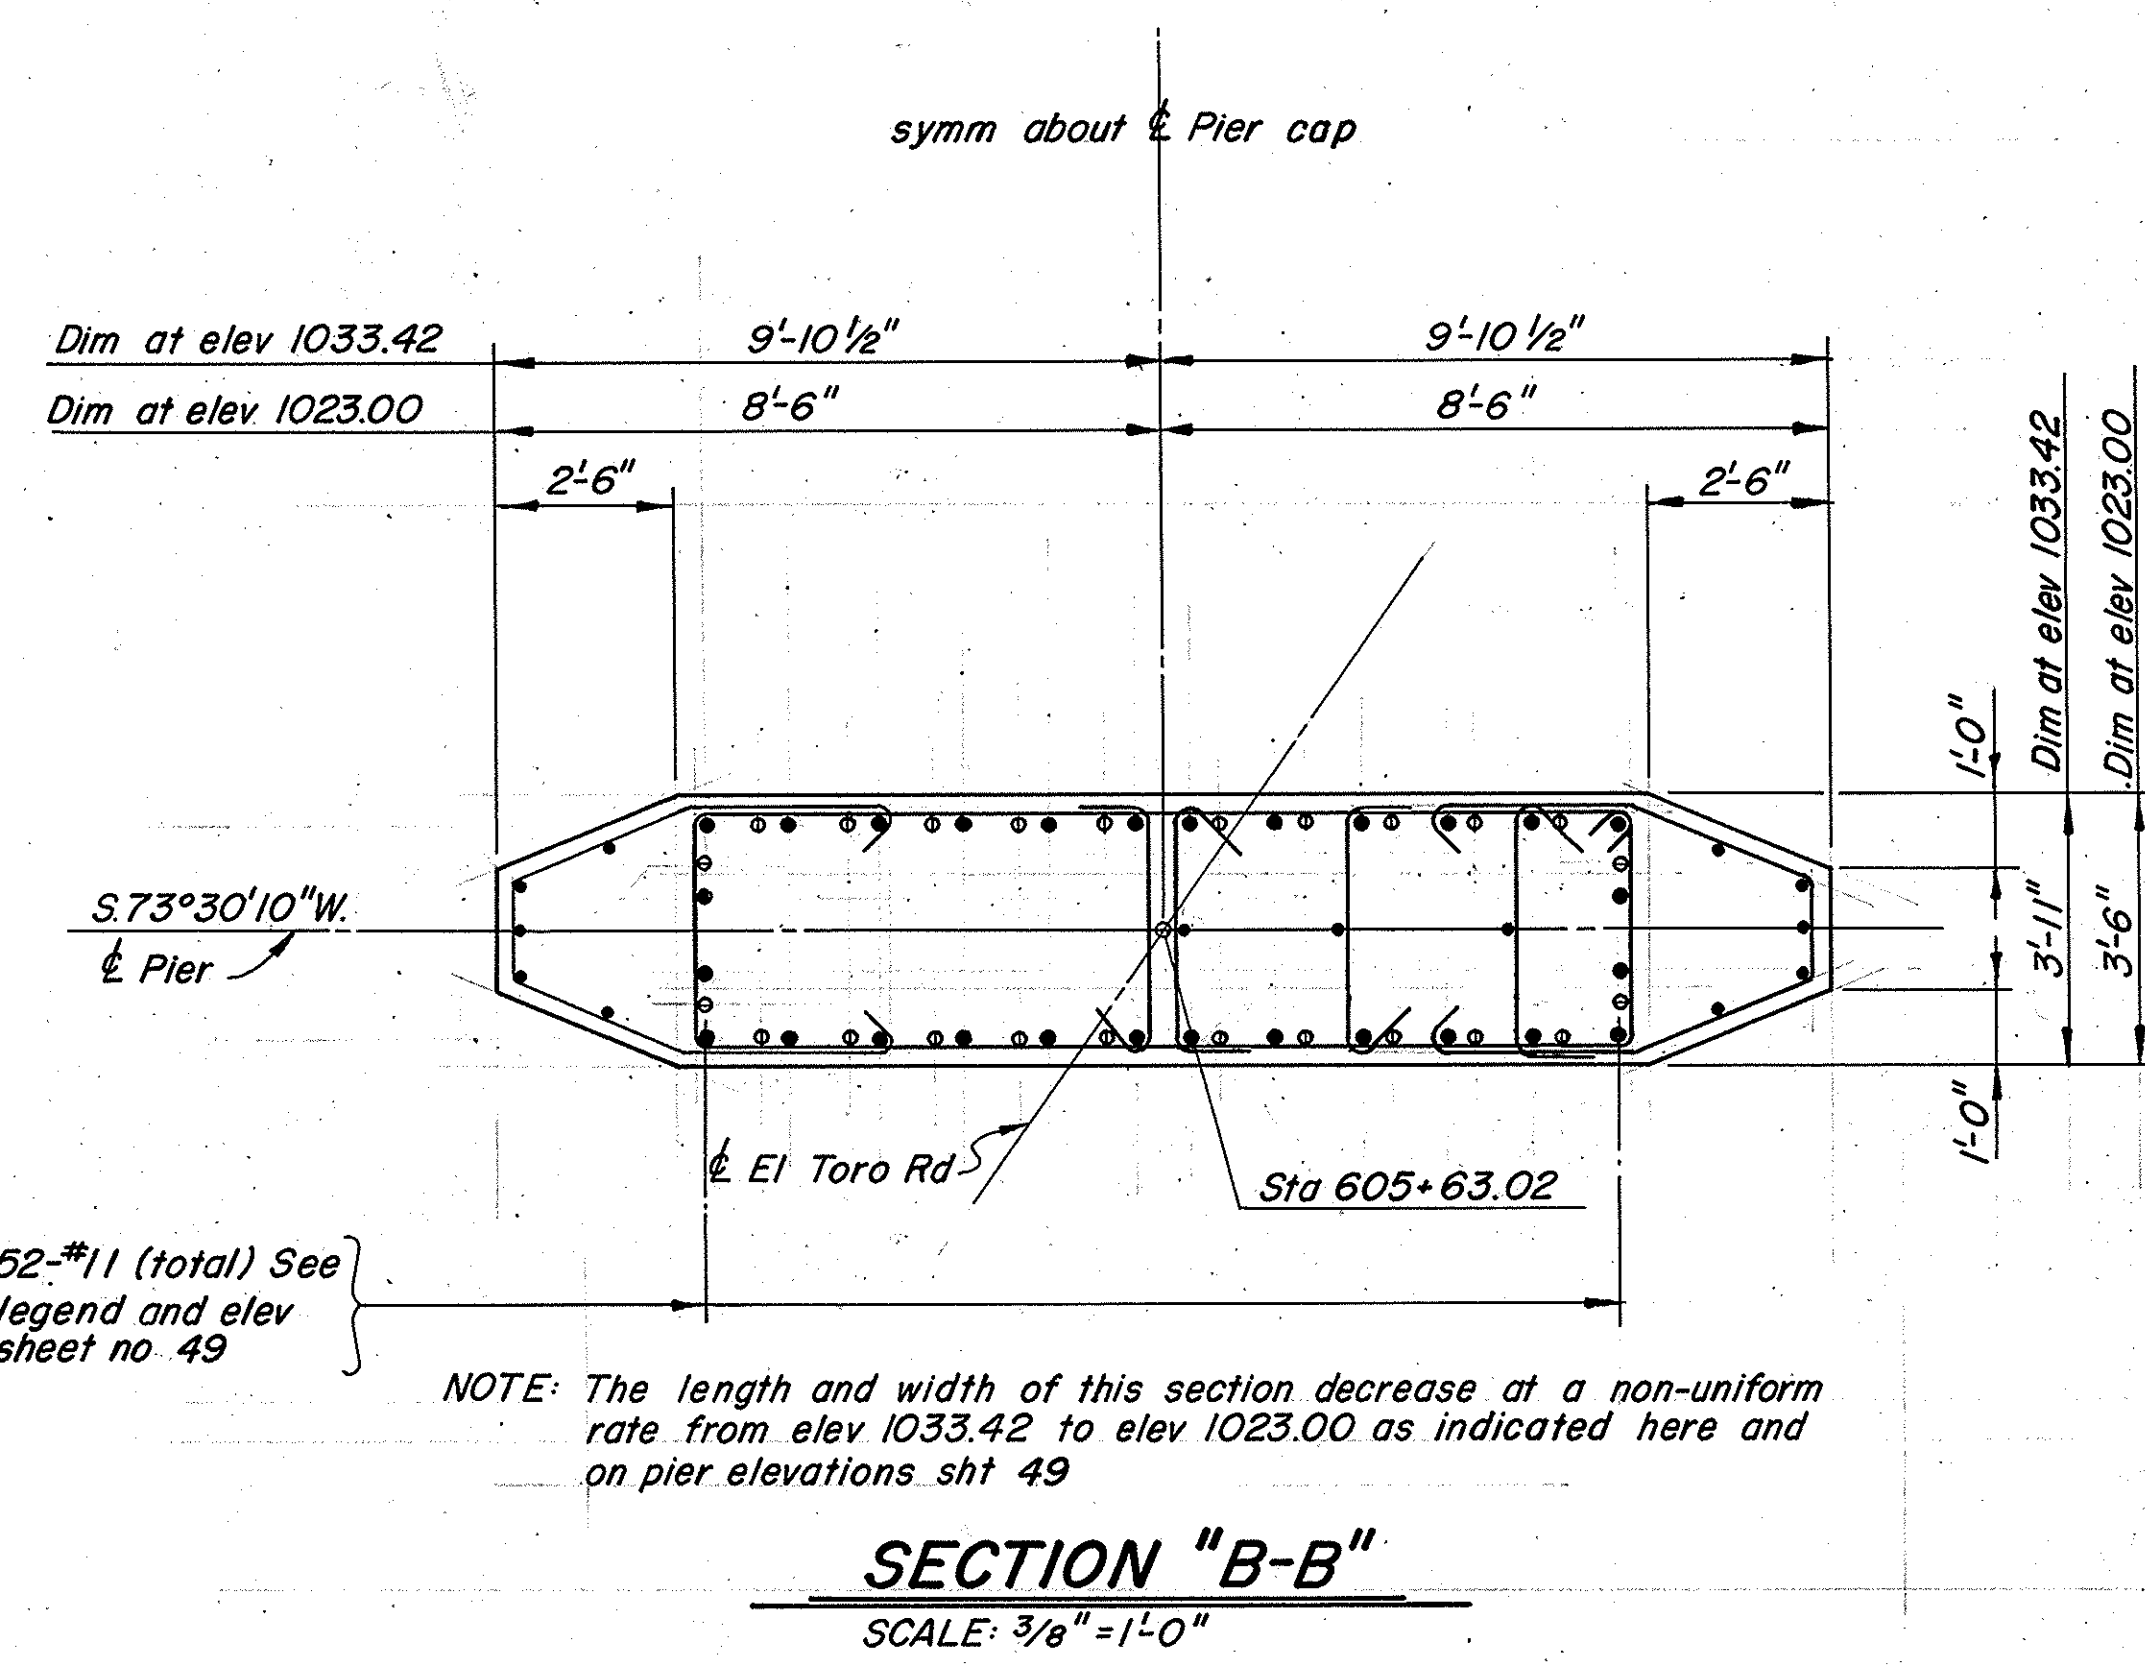
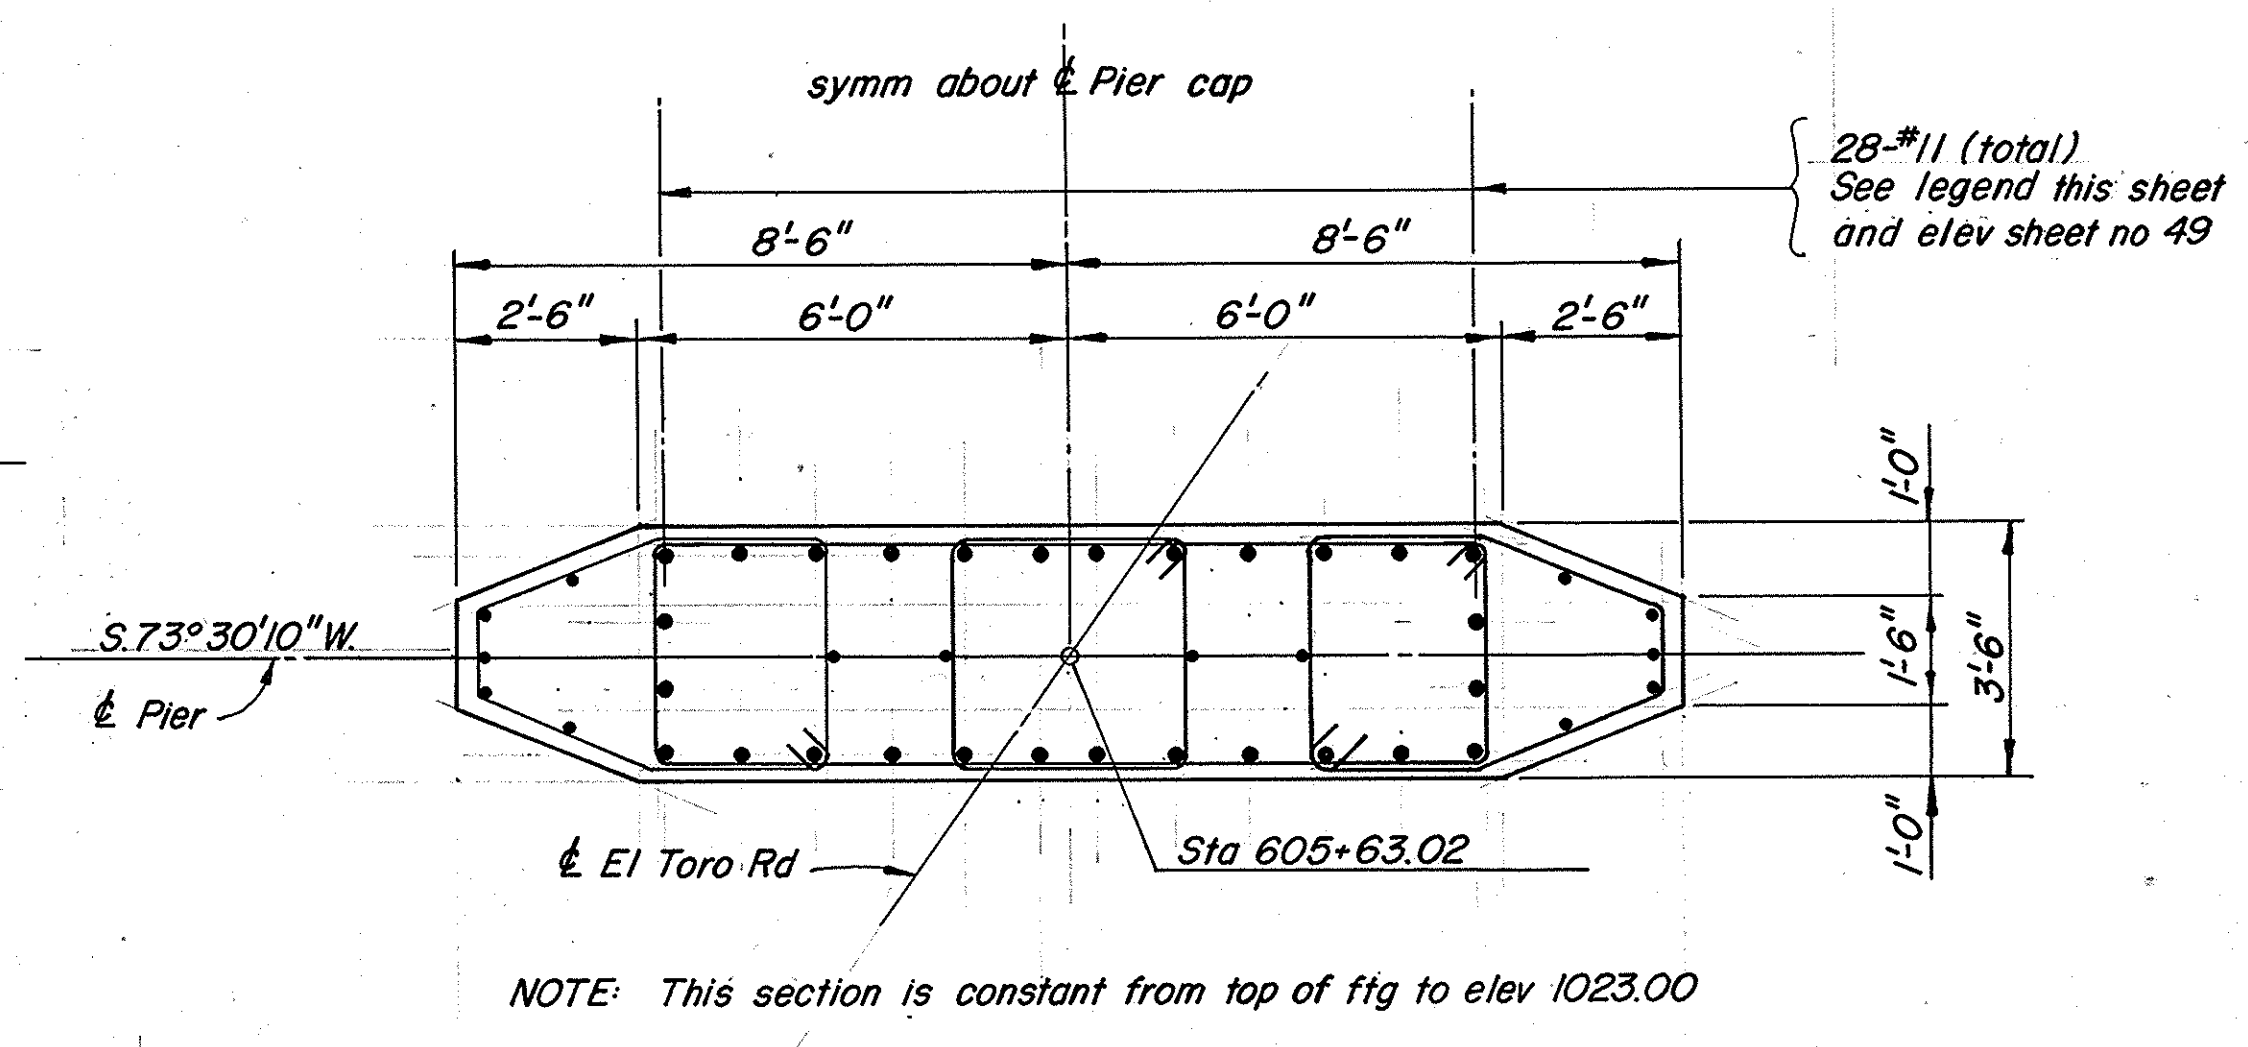


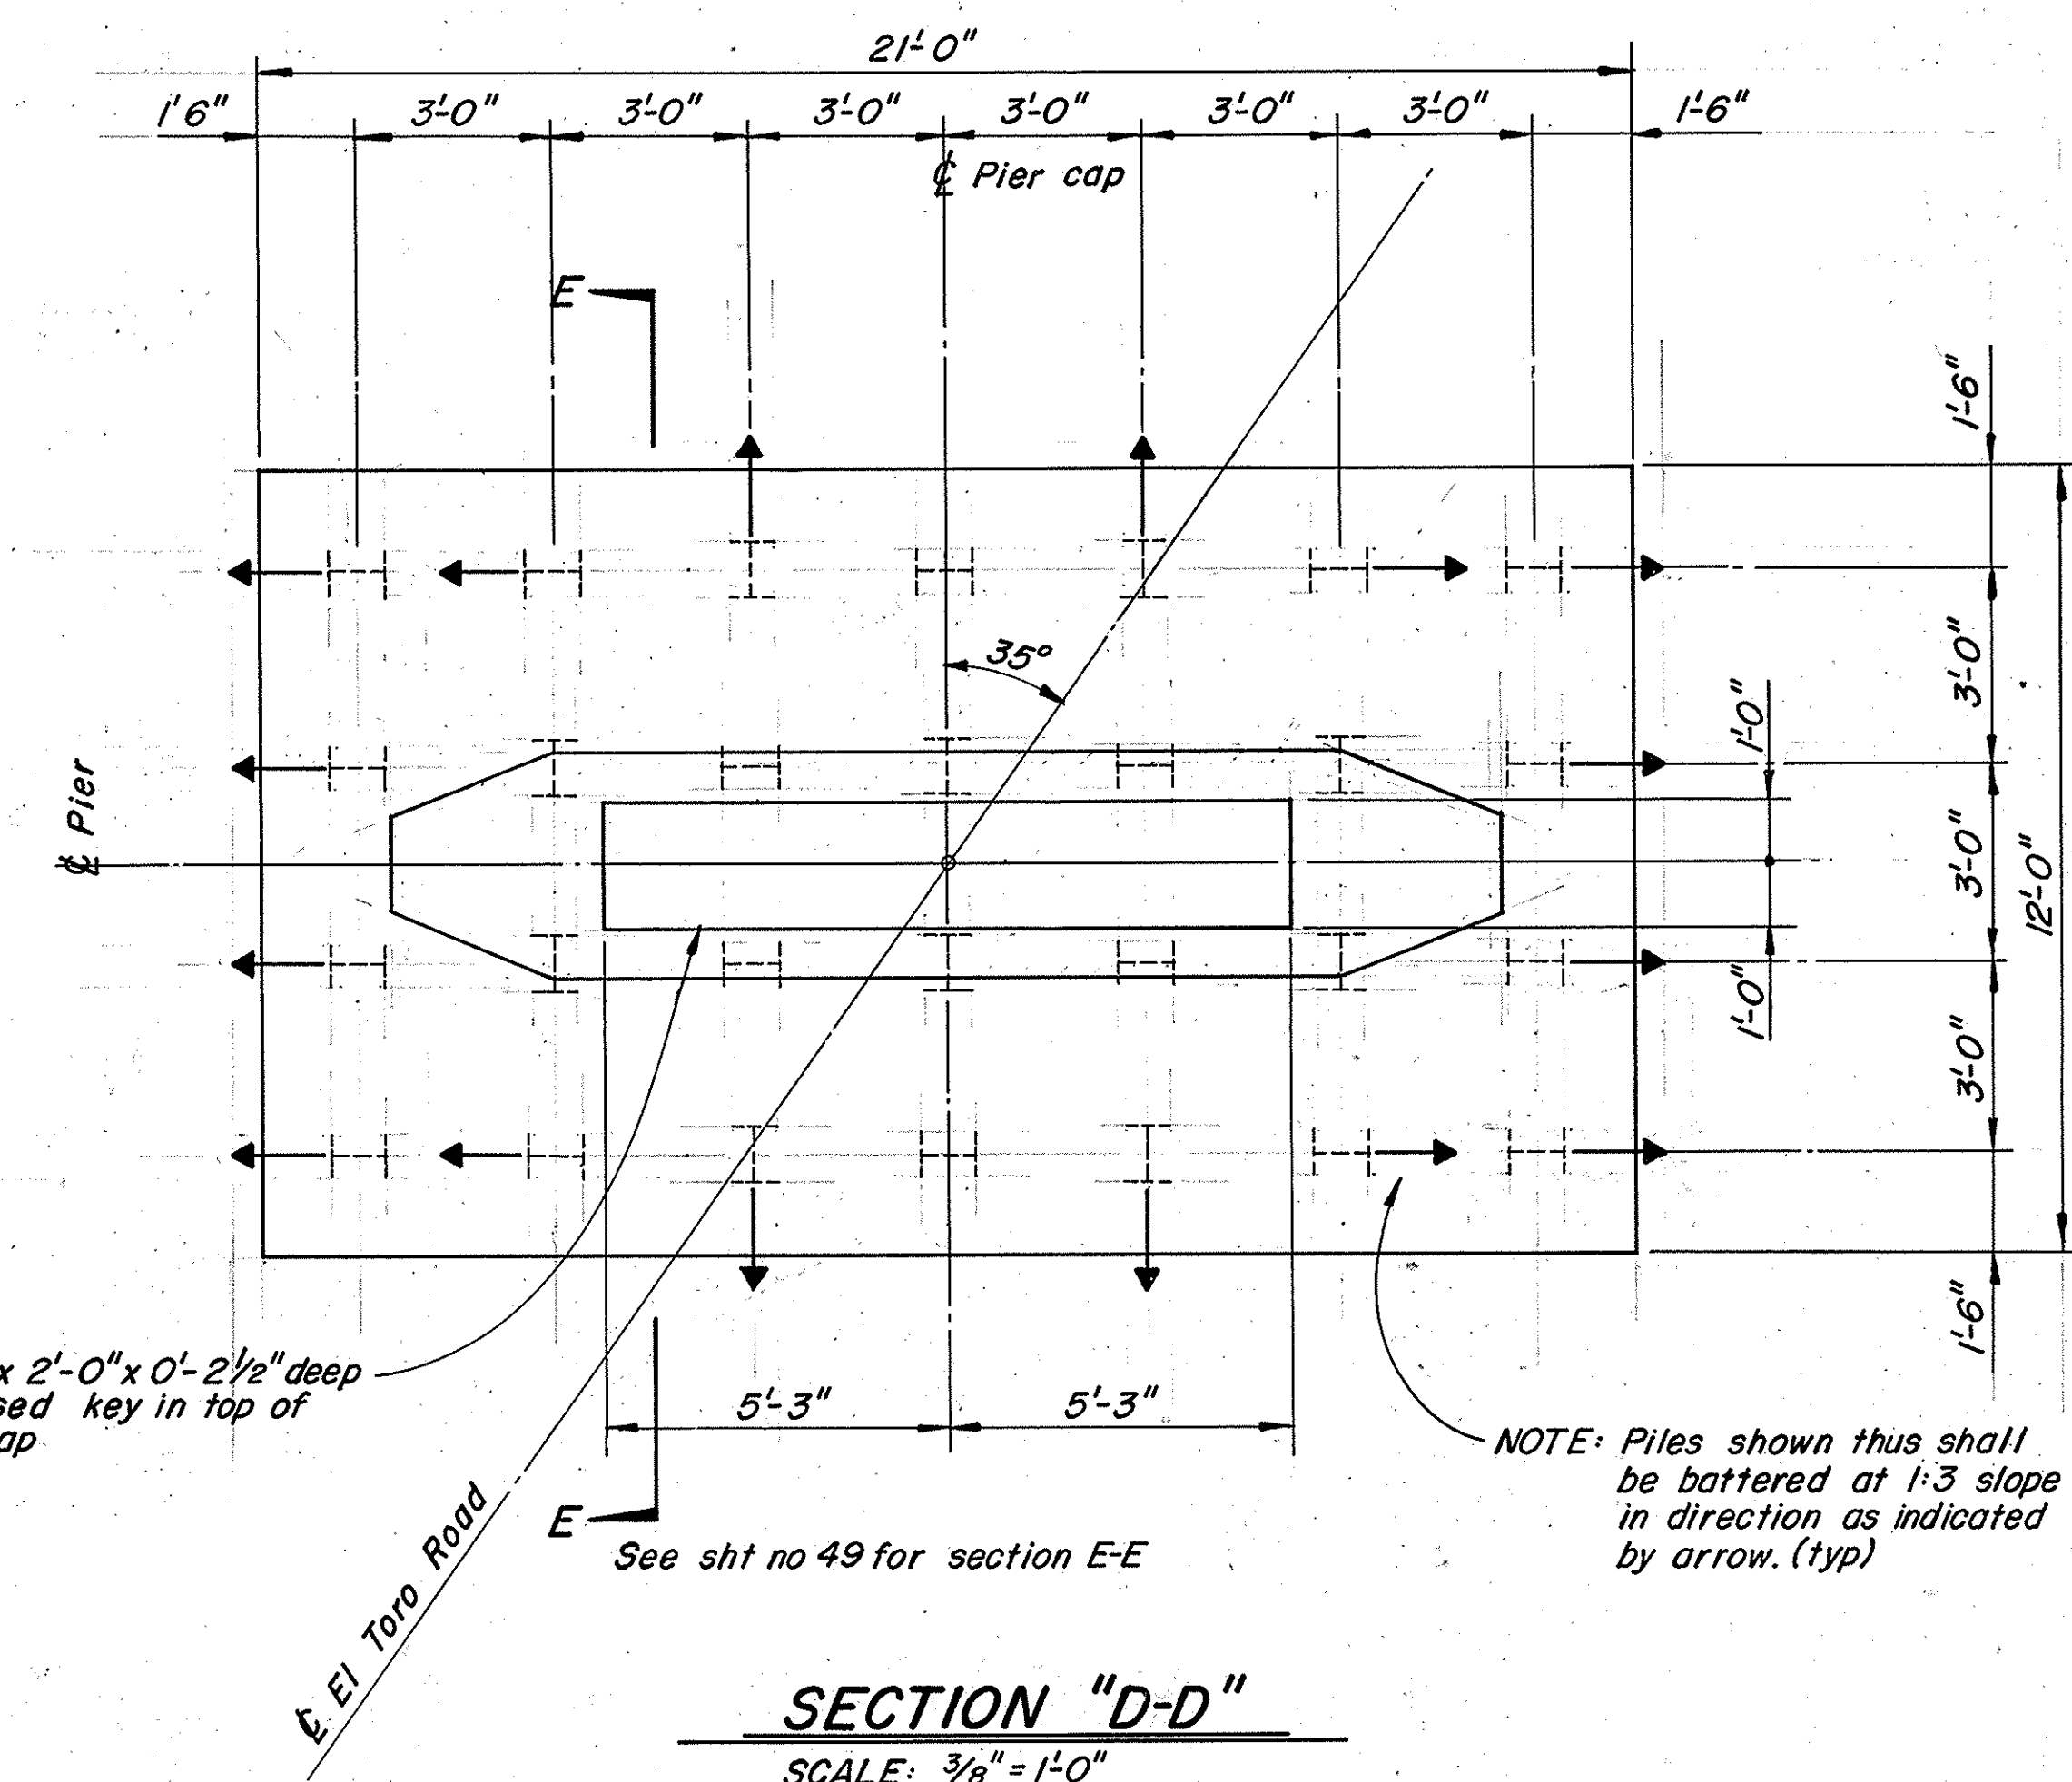

- LEGEND**
- Indicates pier vertical reinforcing continuous from footing to pier cap as shown on elevation sheet no 49
 - Indicates pier vertical reinforcing continuous from pier cap to cut-off point 4'-0" below elev 1033.42 as shown on elevation sheet no 49
 - Indicates pier vertical reinforcing continuous from pier cap to cut-off point 2'-0" above elev 1033.42 as shown on elevation sheet no 49

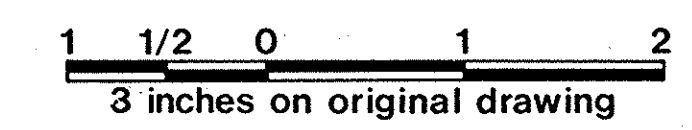

ORANGE COUNTY ENVIRONMENTAL MANAGEMENT AGENCY			
EL TORO ROAD BRIDGE NO. AL 0.5 AT ALISO CREEK			
PIER SECTIONS			
MARK	DATE	DESCRIPTION	PREPARED UNDER SUPERVISION OF
DESIGNED	DATE	SCALE	DATE
DRAWN	CHECKED	AS SHOWN	DWG. NO.
			SHEET