


- H. Torque rail to post nuts to 175 ft. lbs. Exception (2x2 tube is wrench tight.)
- I. Tubing shall be continuous over not less than two posts except a short length is permitted near deck joints, electroliers or other railing discontinuities.
- J. Galvanize rail assembly after fabrication.

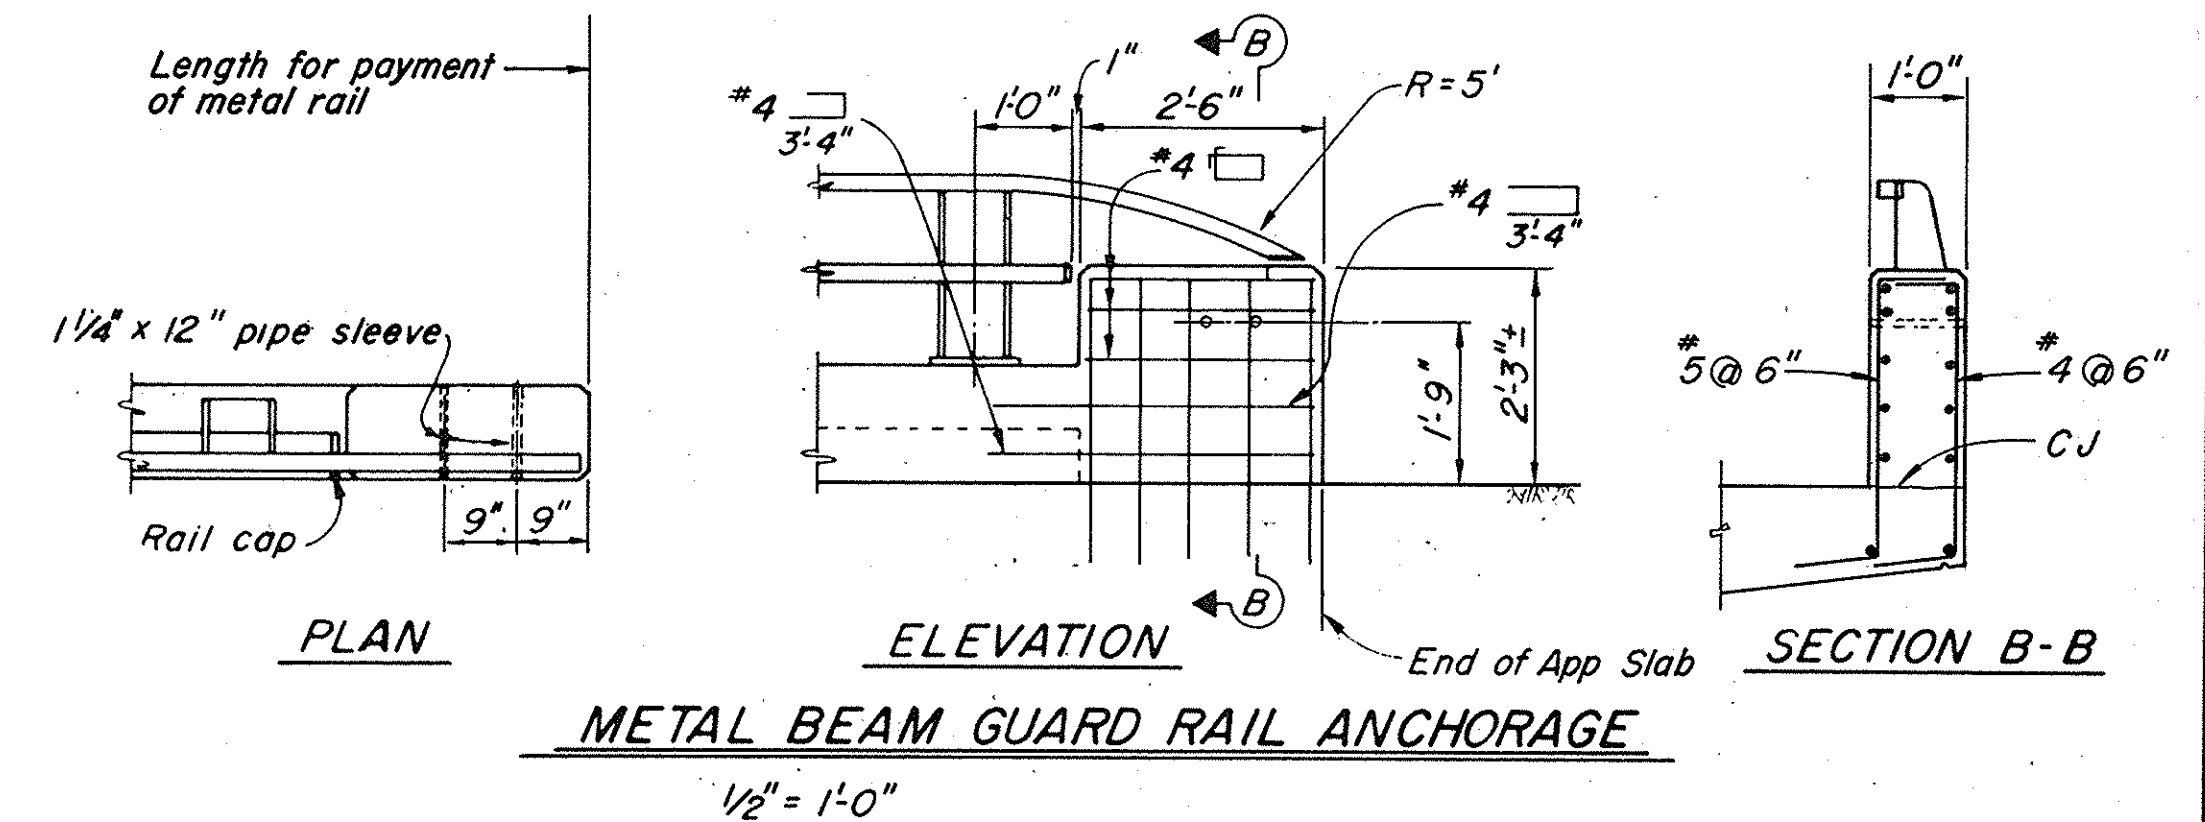

				ORANGE COUNTY ENVIRONMENTAL MANAGEMENT AGENCY	
				EL TORO ROAD BRIDGE ACROSS ALISO CREEK	
				BARRIER RAILING TYPE 9-11	
MARK	DATE	DESCRIPTION	PREPARED UNDER SUPERVISION OF	<i>Danny T. Diaz</i> <i>R.C.E. 21594</i>	SHEET 21/5780
REVISIONS			SCALE	DATE	DWG. NO. 55
DESIGNED	<i>DTL</i>		AS SHOWN		
DRAWN	<i>J.M.</i>	CHECKED			