



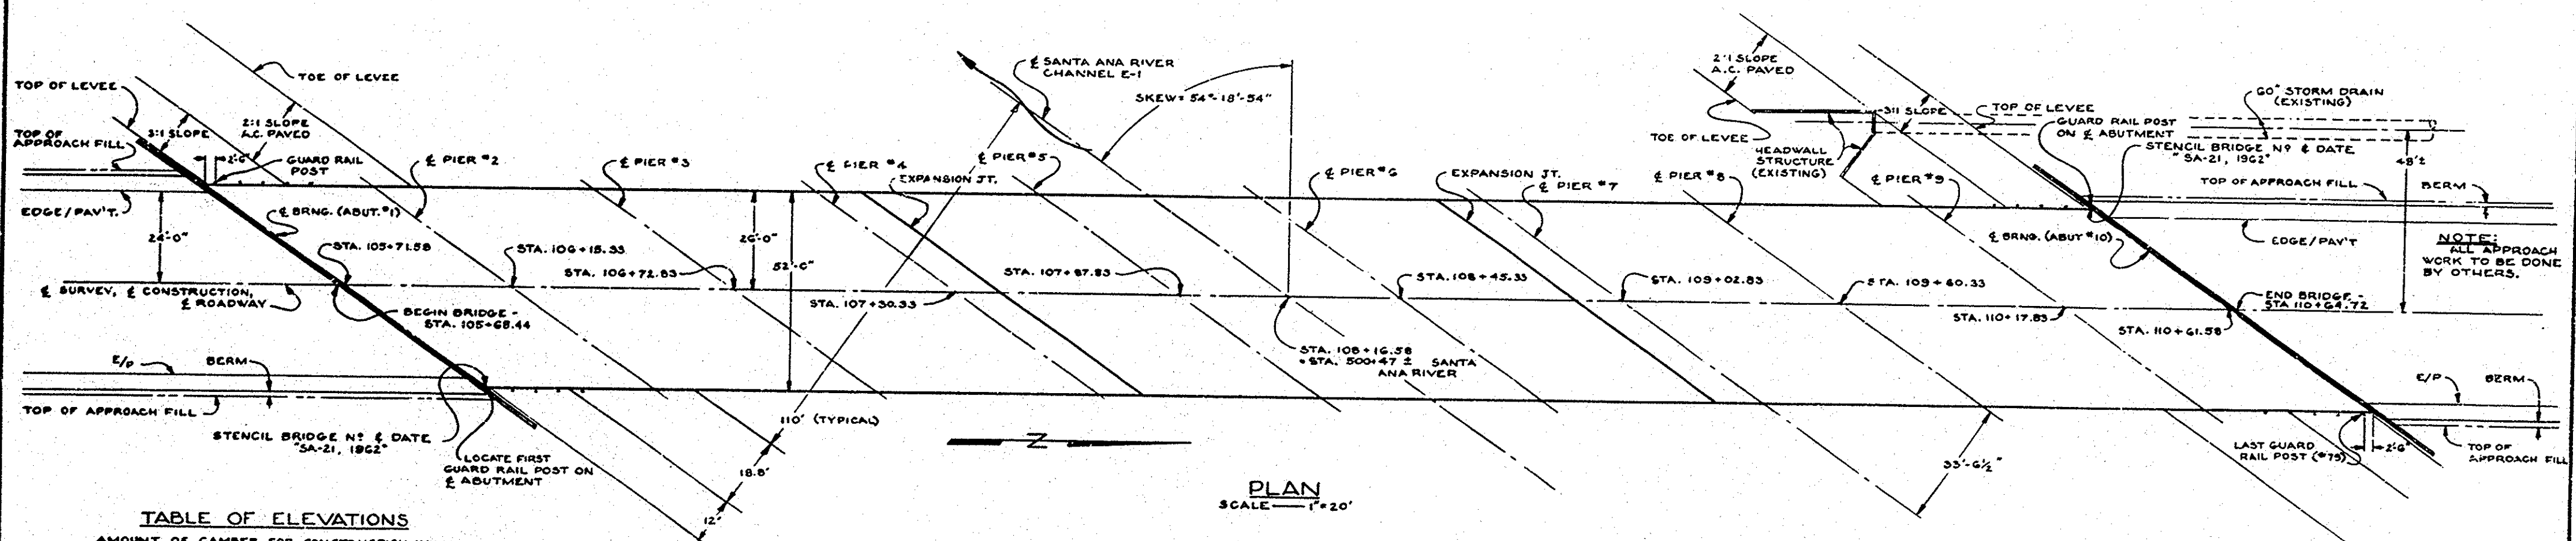


TABLE OF ELEVATIONS
AMOUNT OF CAMBER FOR CONSTRUCTION WILL BE DETERMINED BY THE ENGINEER IN FIELD.

	ELEV. 1	2	3	4	5	6	7
ABUT. 1	100.32	100.83	100.44	96.55	96.78	96.75	96.48
ENDSPAN	100.37	100.86	100.47				
PIER 2	100.40	100.89	100.50	96.44	96.65	96.84	96.54
M-5 2	100.44	100.93	100.54				
PIER 3	100.48	100.97	100.58	96.53	96.83	96.84	96.62
M-5 3	100.52	101.01	100.62				
PIER 4	100.56	101.05	100.66	96.61	97.01	97.02	96.70
M-5 4	100.60	101.09	100.70				
PIER 5	100.64	101.13	100.74	96.69	97.09	97.10	96.78
M-5 5	100.68	101.17	100.78				
PIER 6	100.72	101.21	100.82	96.77	97.17	97.18	96.86
M-5 6	100.76	101.25	100.86				
PIER 7	100.80	101.29	100.90	96.85	97.25	97.26	96.94
M-5 7	100.84	101.33	100.94				
PIER 8	100.88	101.37	100.98	96.93	97.33	97.34	97.02
M-5 8	100.92	101.41	101.02				
PIER 9	100.96	101.45	101.07	97.01	97.41	97.42	97.10
M-5 9	100.99	101.48	101.09				
ABUT. 10	101.03	101.51	100.58	97.07	97.47	97.46	97.01

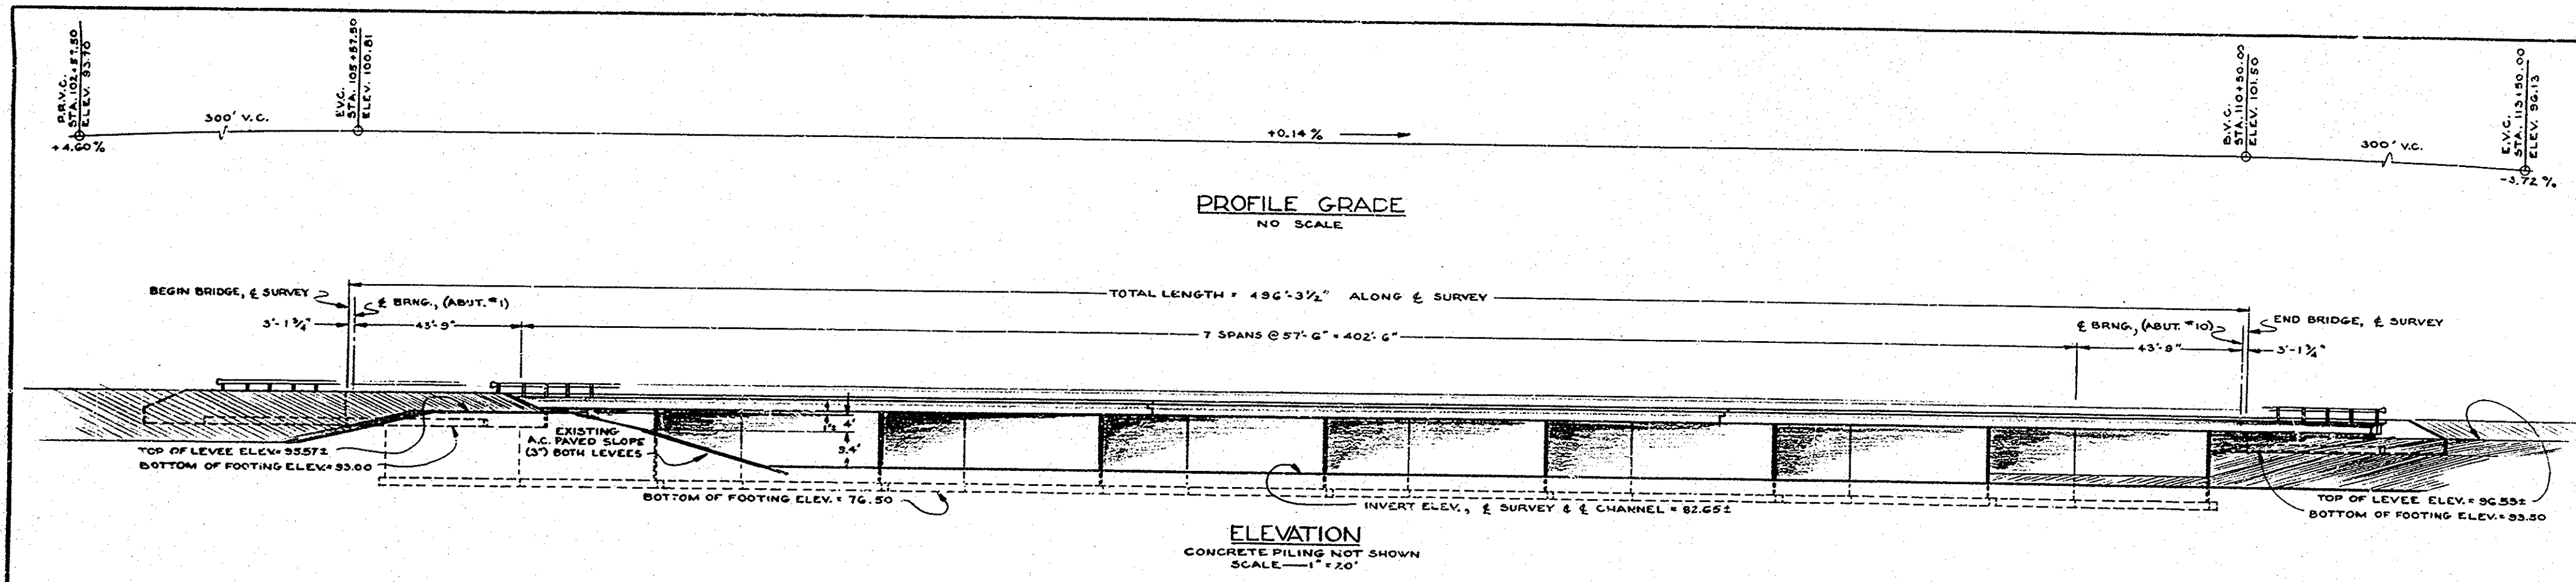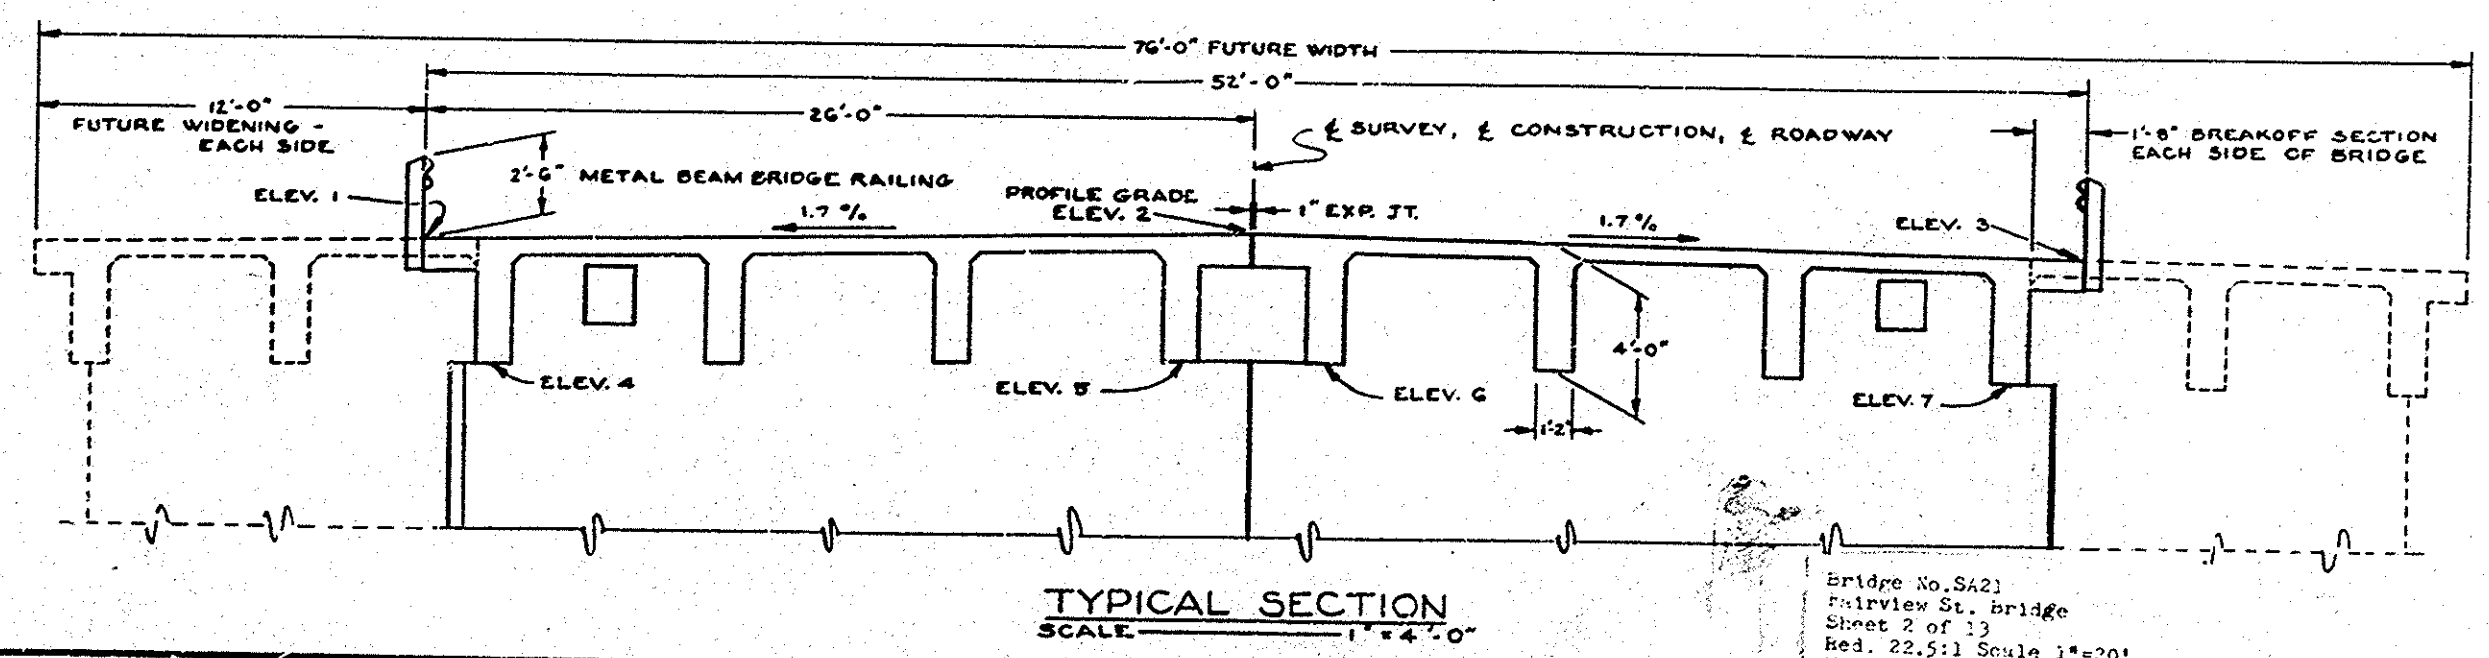

BENCH MARK:
O.C.D. TAG @ WEST END OF NORTH WALK OF SANTA ANA RIVER BRIDGE @ 17TH STREET.
IC-2-57 ELEV. 104.16 ('58 ADJ.)

ORANGE COUNTY HIGHWAY DEPARTMENT

FAIRVIEW STREET BRIDGE
ACROSS
SANTA ANA RIVER
GENERAL PLAN

MICROFILMED
DEC 26 1961

AS SHOWN

SHEET 2 OF 13

Bridge No. SA21
Fairview St. Bridge
Sheet 2 of 13
Bed. 22.5:1 Scale 1"=20'
Vellum Pencil Sketch

SA-21