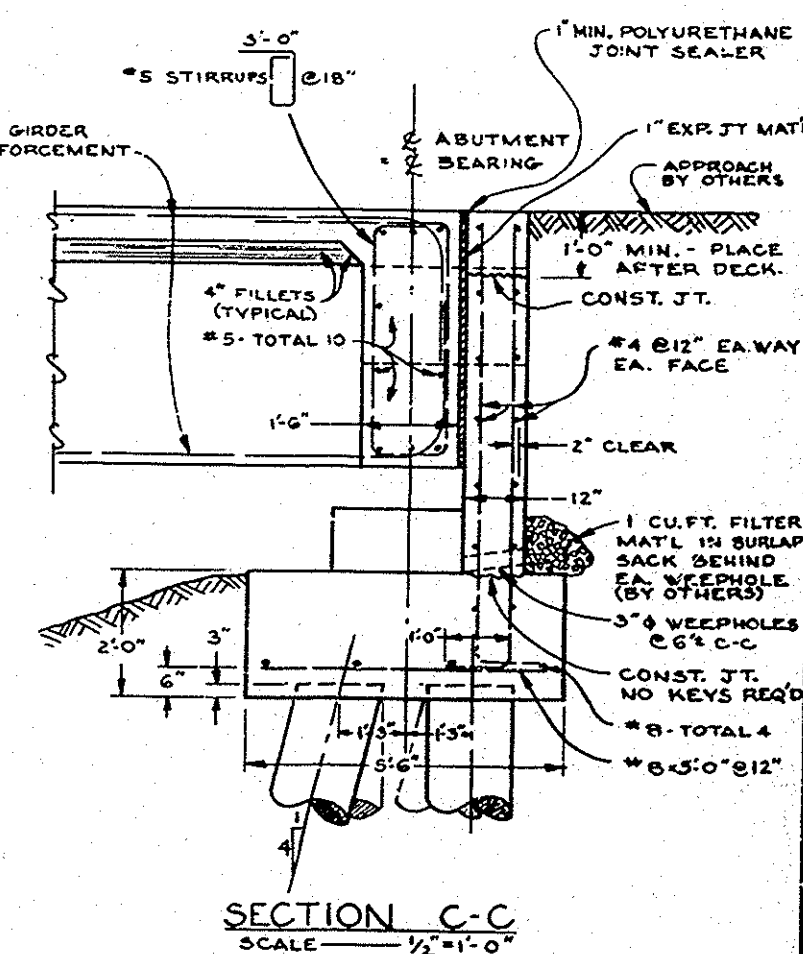
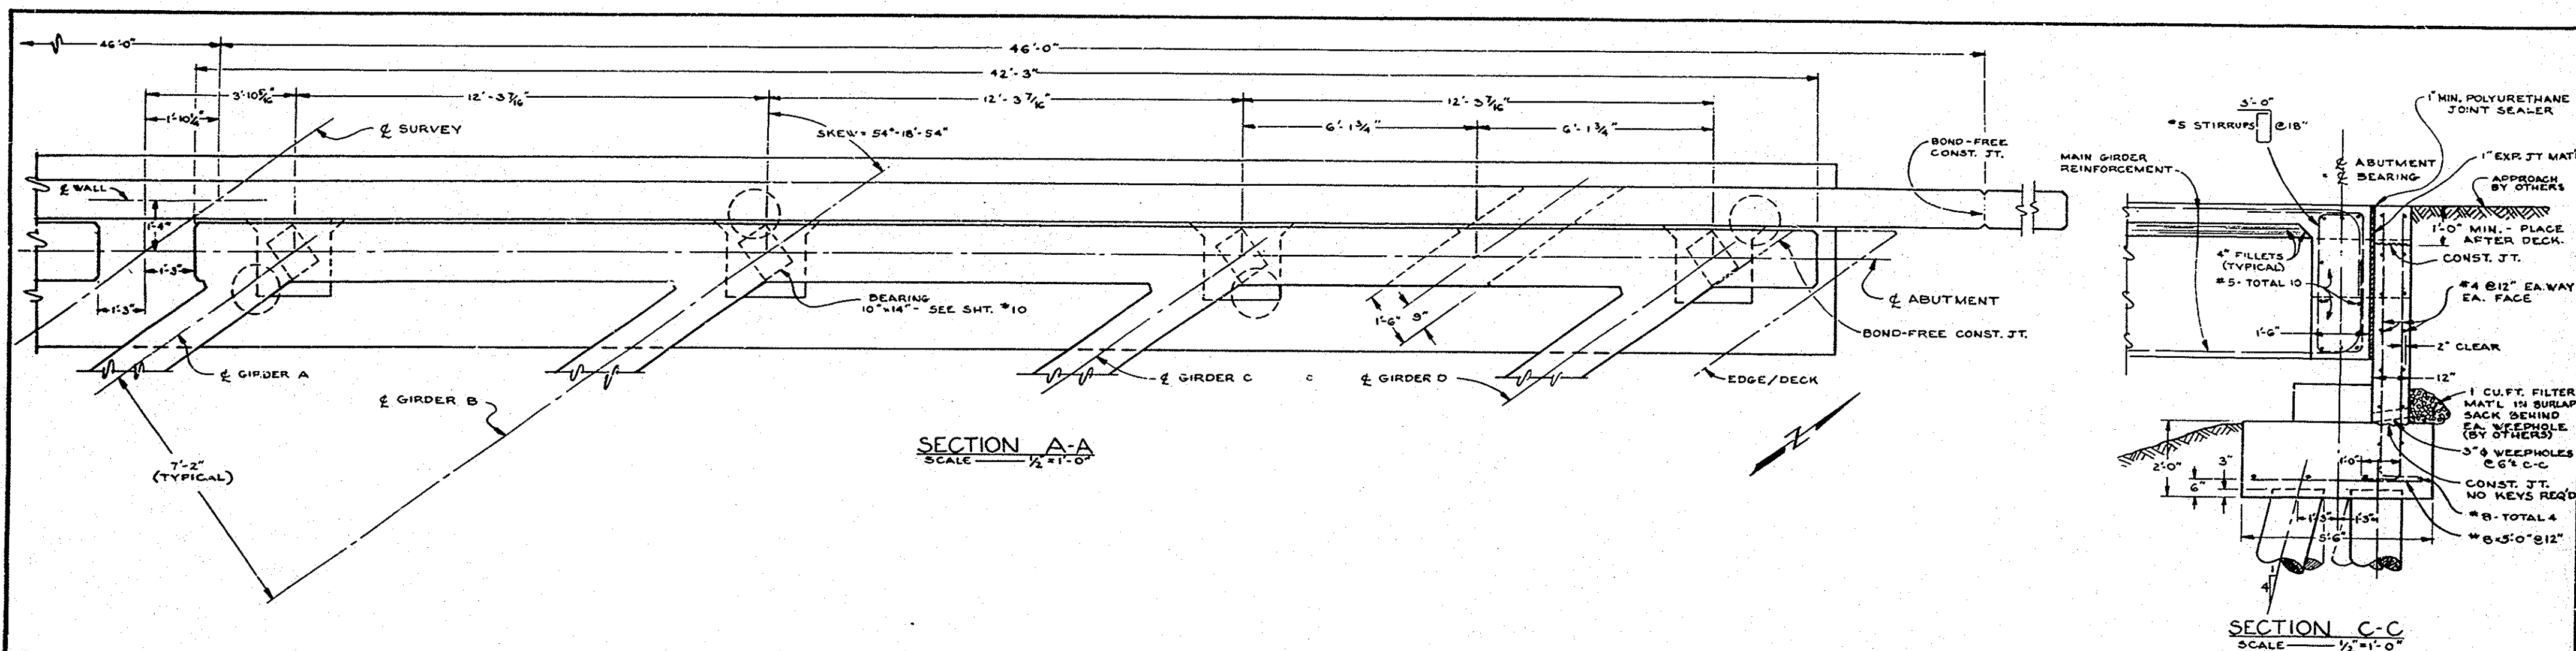


TOP OF PEDESTAL ELEVATIONS

	WEST BRIDGE				EAST BRIDGE			
	GIRDER D	C	B	A	A	B	C	D
ABUT. #1	95.68	95.84	95.98	96.11	96.12	96.02	95.91	95.81
ABUT. #10	96.40	96.53	96.67	96.80	96.73	96.67	96.52	96.35

ORANGE COUNTY HIGHWAY DEPARTMENT

FAIRVIEW STREET BRIDGE
ACROSS
SANTA ANA RIVER

ABUTMENT DETAIL

NOTED

SHEET 4 OF 13