




SECTION A-A
SCALE $\frac{1}{2}'' = 1'-0''$

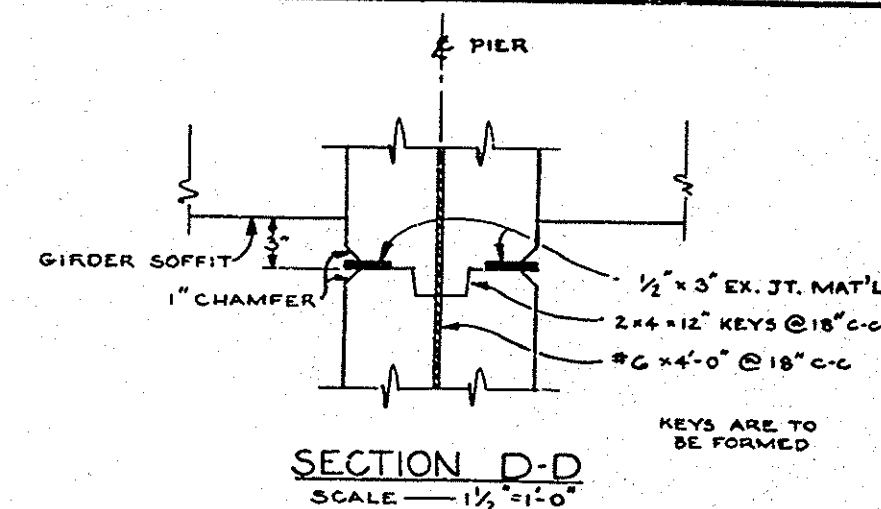


SECTION D-D
SCALE $\frac{1}{2}'' = 1'-0''$

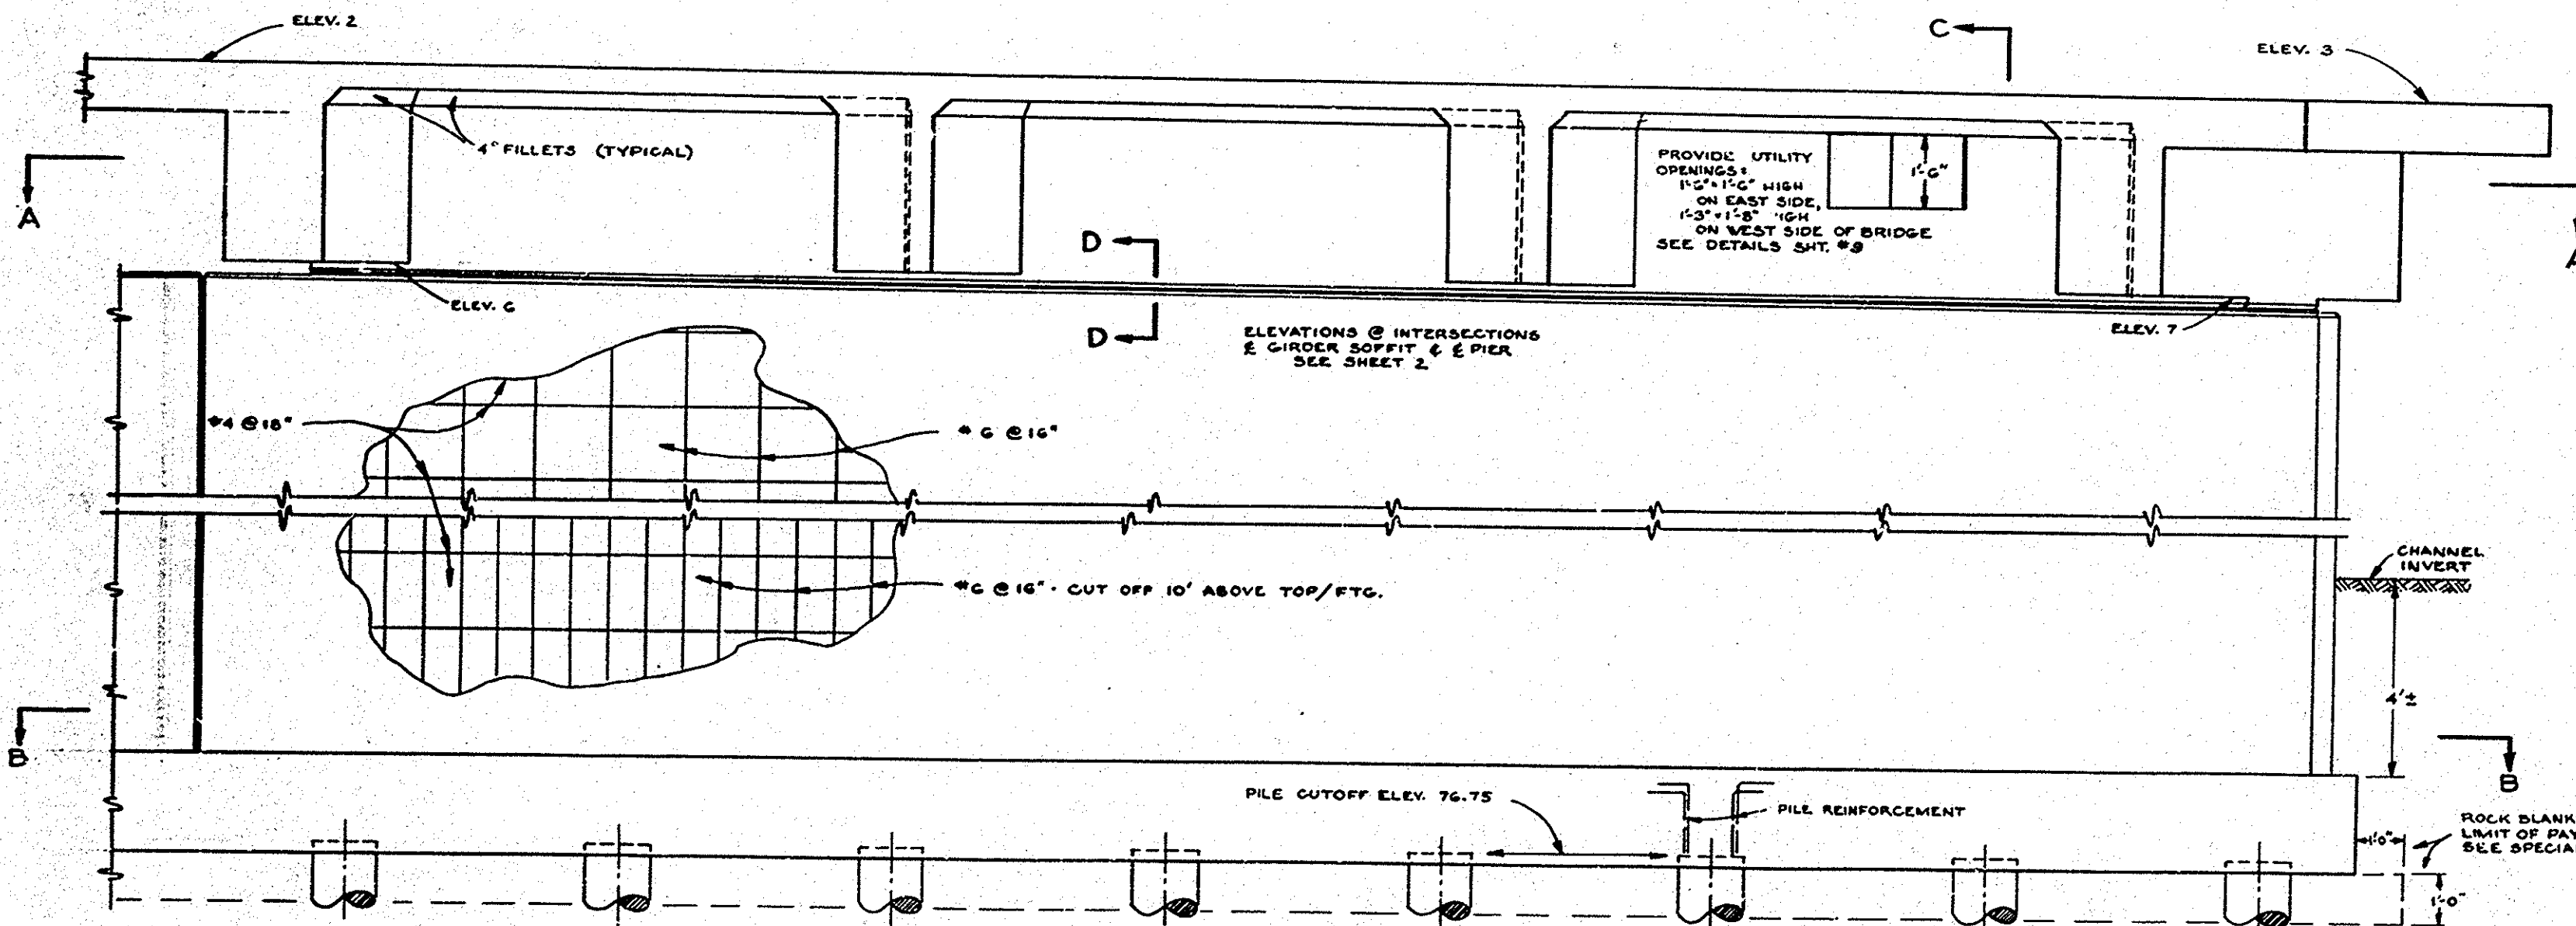

TYPICAL PIER DETAIL
PIER SYMMETRICAL ABOUT SURVEY EXCEPT AS NOTED
SCALE $\frac{1}{2}'' = 1'-0''$

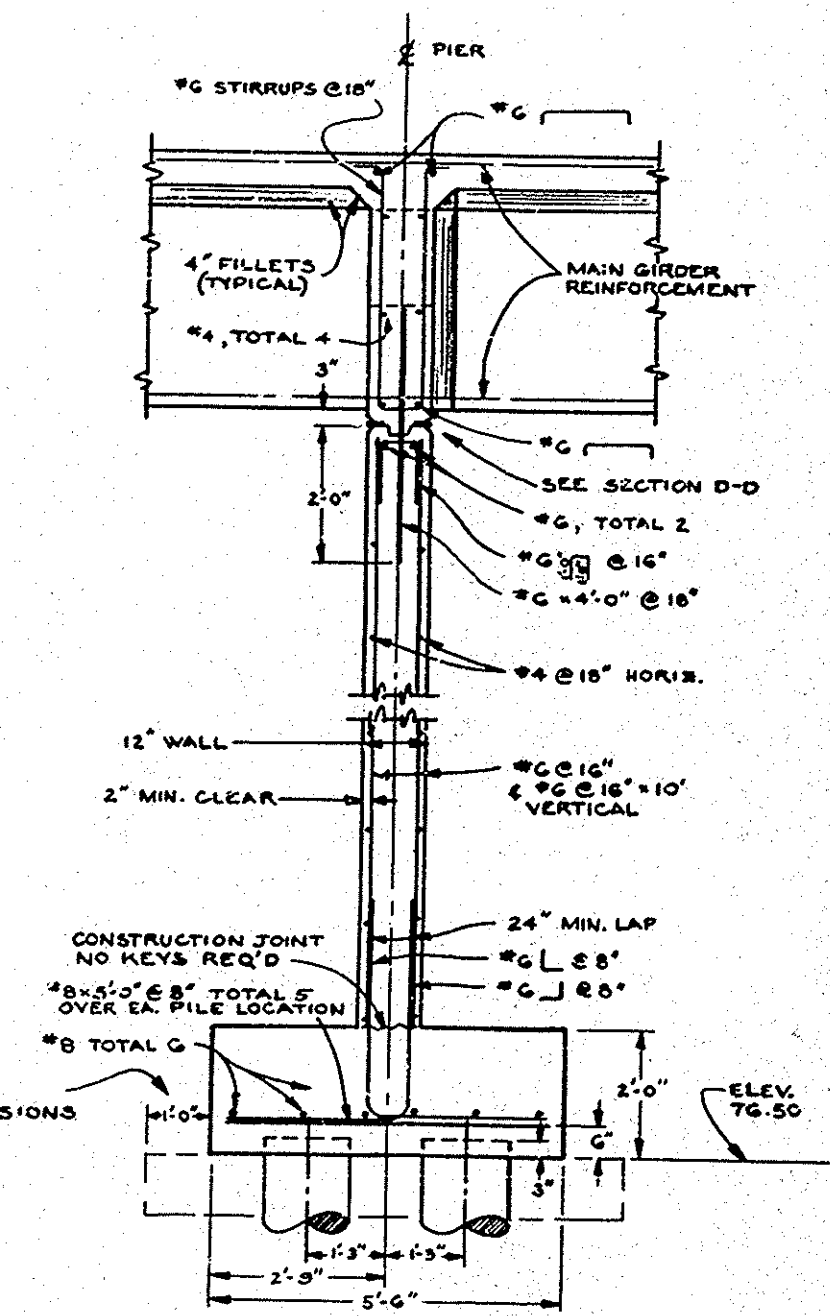

SECTION C-C
SCALE $\frac{1}{2}'' = 1'-0''$

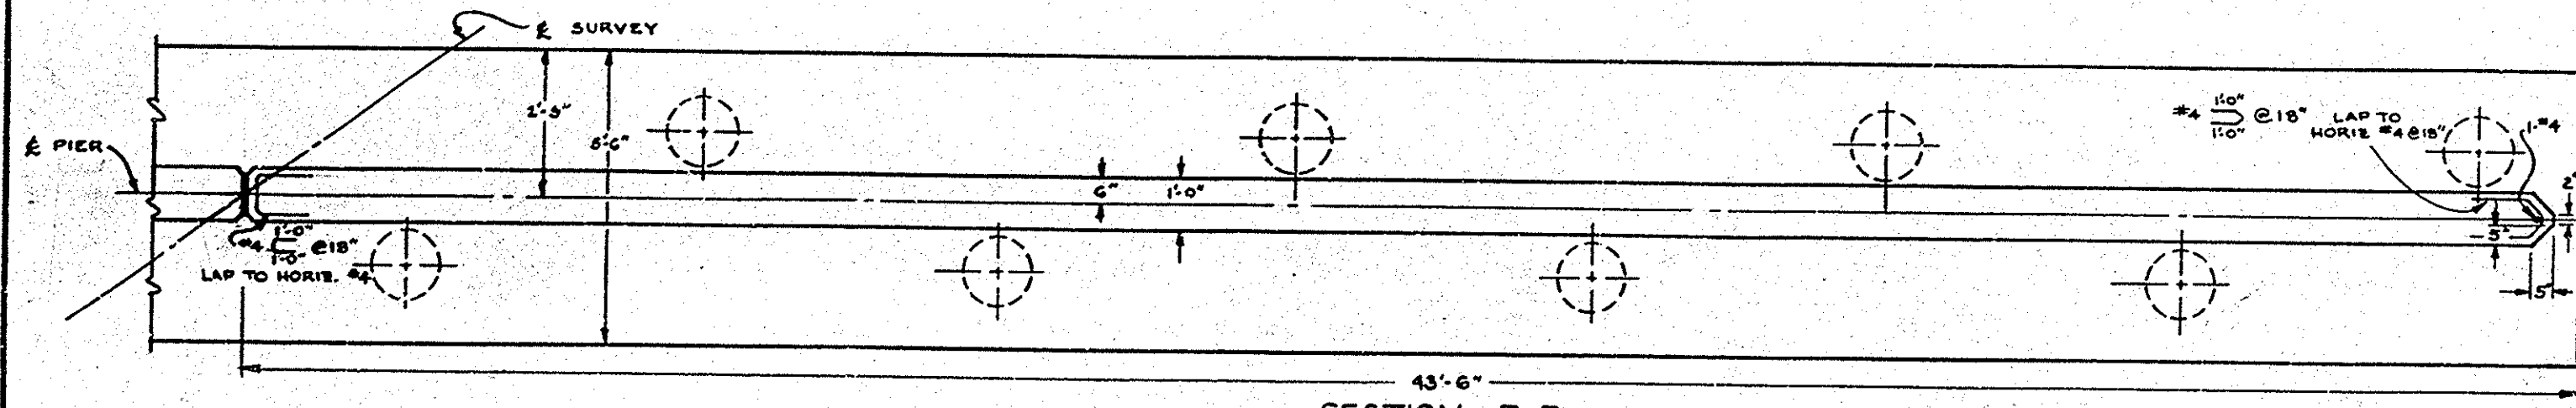

SECTION B-B
SCALE $\frac{1}{2}'' = 1'-0''$

Bridge No SA 21
Fairview St. Bridge
Sheet 5 of 13
Red. 22.5:1 Scale $\frac{1}{2}'' = 1'-0''$
Vellum Pencil Sketch

MICROFILMED
DEC 2 R 1954

ORANGE COUNTY HIGHWAY DEPARTMENT	
FAIRVIEW STREET BRIDGE	
ACROSS	
SANTA ANA RIVER	
PIER DETAIL	
SCALE NOTED	SHEET 5 of 13