


Bridge No. SA 21
Fairview St. Bridge
Sheet 6 of 13
Elev. 22.5:1 Scale 1/8"=1'-0"
Vellum Pencil Sketch

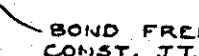

DEC 28 1966

SALE AS SHOWN

SHEET 6 OF 1