


14 15 16 17 18 19 20 21 22 23 24 25 26 27 28 29 30 31 32 33 34 35 36 37 38 39 40 41 42 43 44 45 46 47 48 49 50

5TH. ST. BRIDGE
ACROSS SANTA ANA RIVER

As BUILT
No CHANGE

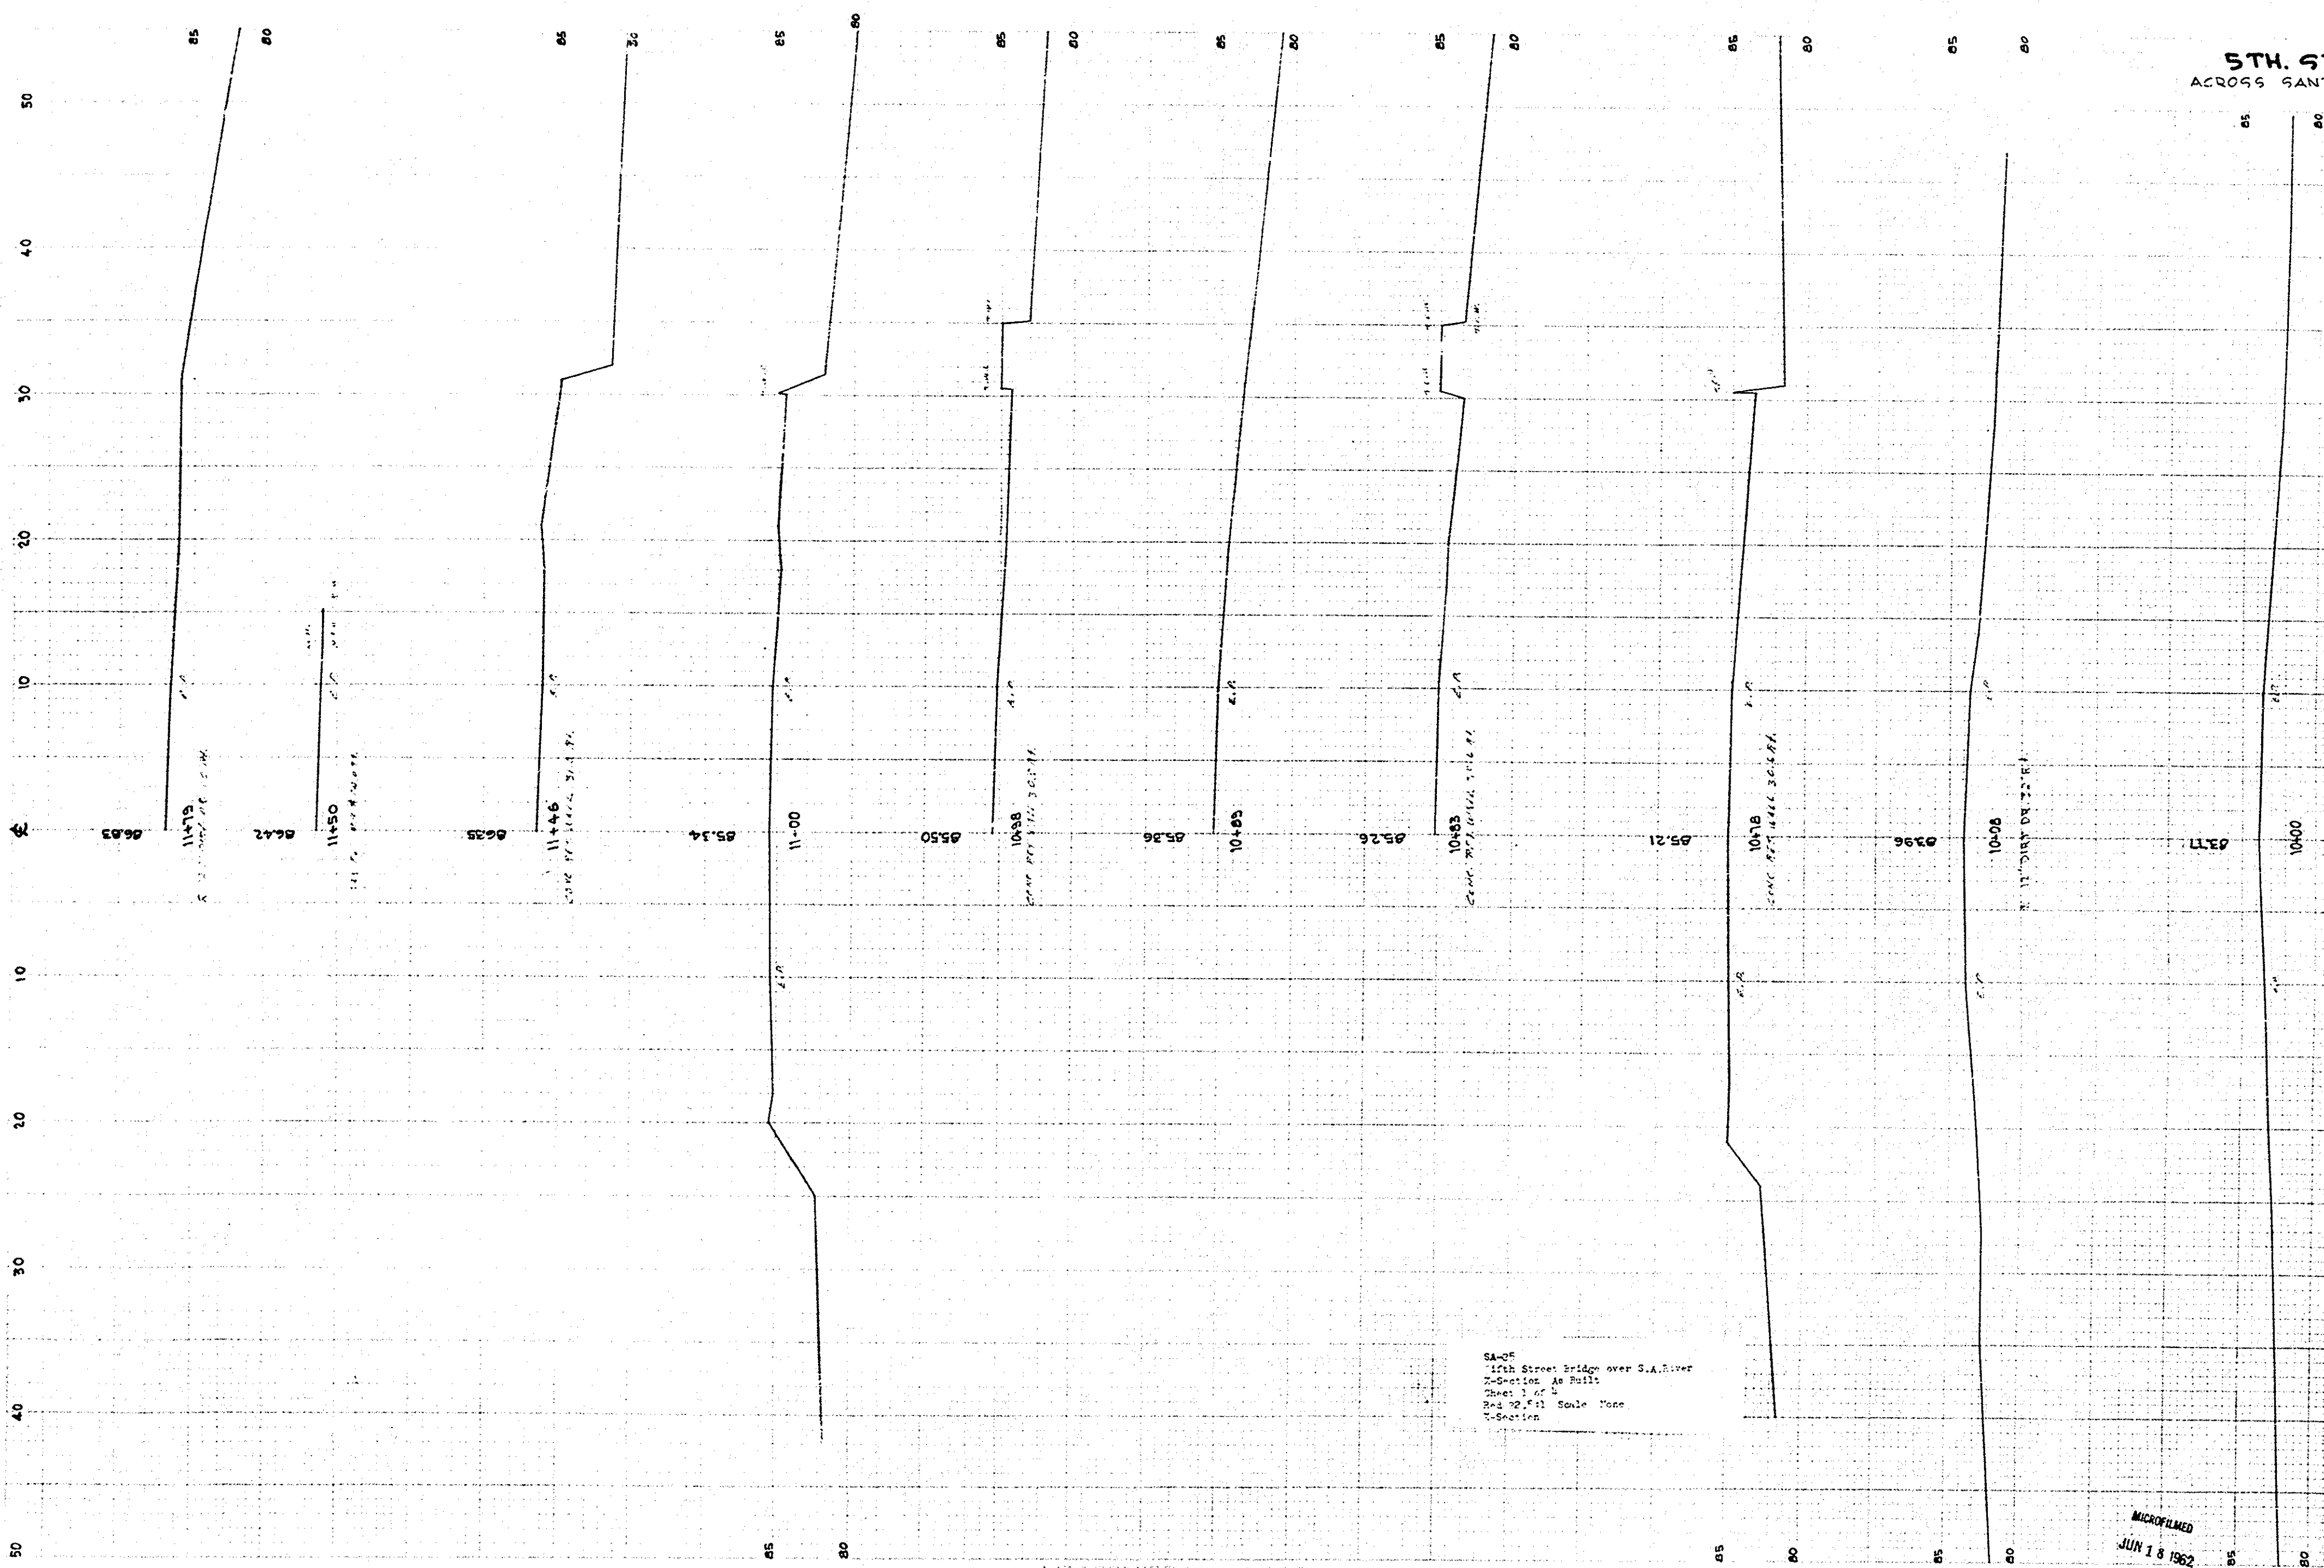

SA-05
5th Street Bridge over S.A. River
X-Section As Built
Sheet 1 of 1
Red 22.5 ft Scale None
T-Section

MICROFILMED
JUN 18 1962

X-Sections - - - Fifth St. Bridge

SA-25

#14687
Fifth St. BR. SA-25
CROSS-SECTIONS 53C-0372
SHEET 1 OF 1 SHEETS
1960