


4 15 16 17 18 19 20 21 22 23 24 25 26 27 28 29 30 31 32 33 34 35 36 37 38 39 40 41 42 43 44 45 46 47 48 49

5TH. ST. BRIDGE
ACROSS SANTA ANA RIVER

As BUILT. No CHANGE

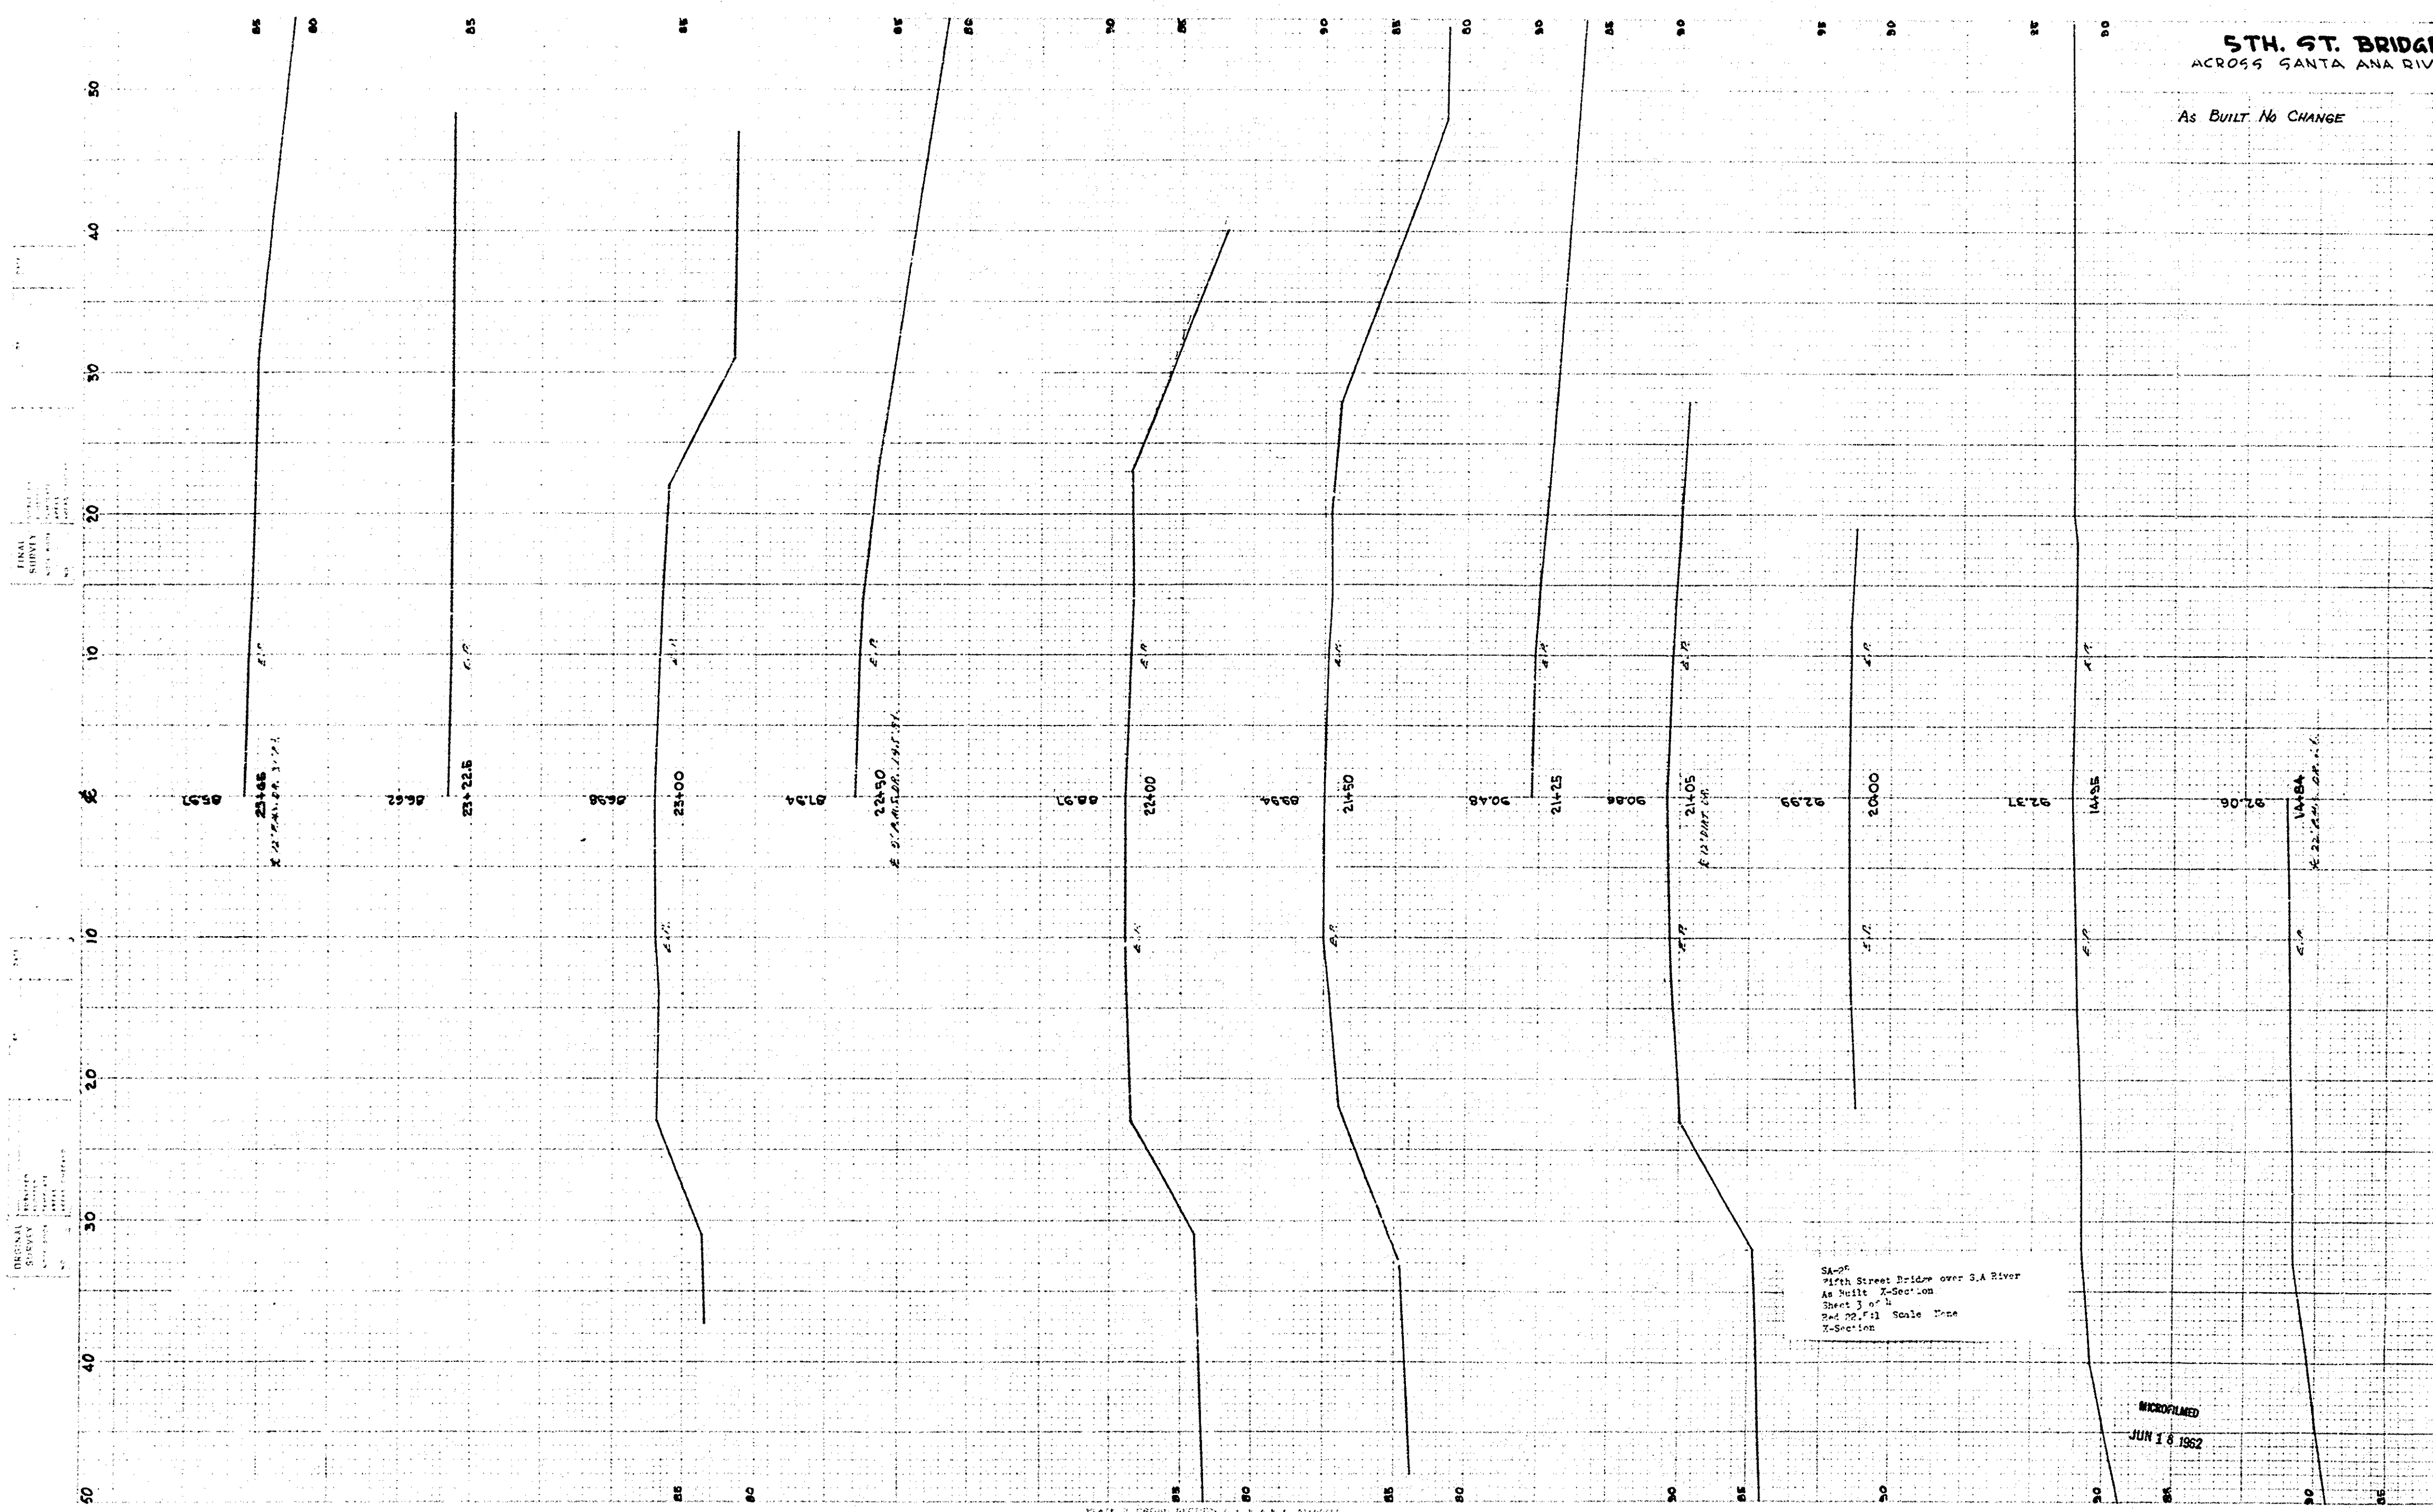

SA-25
Fifth Street Bridge over S.A. River
As Built X-Section
Sheet 3 of 4
Scale 1" = 10'-0"

MICROFILMED
JUN 18 1962