
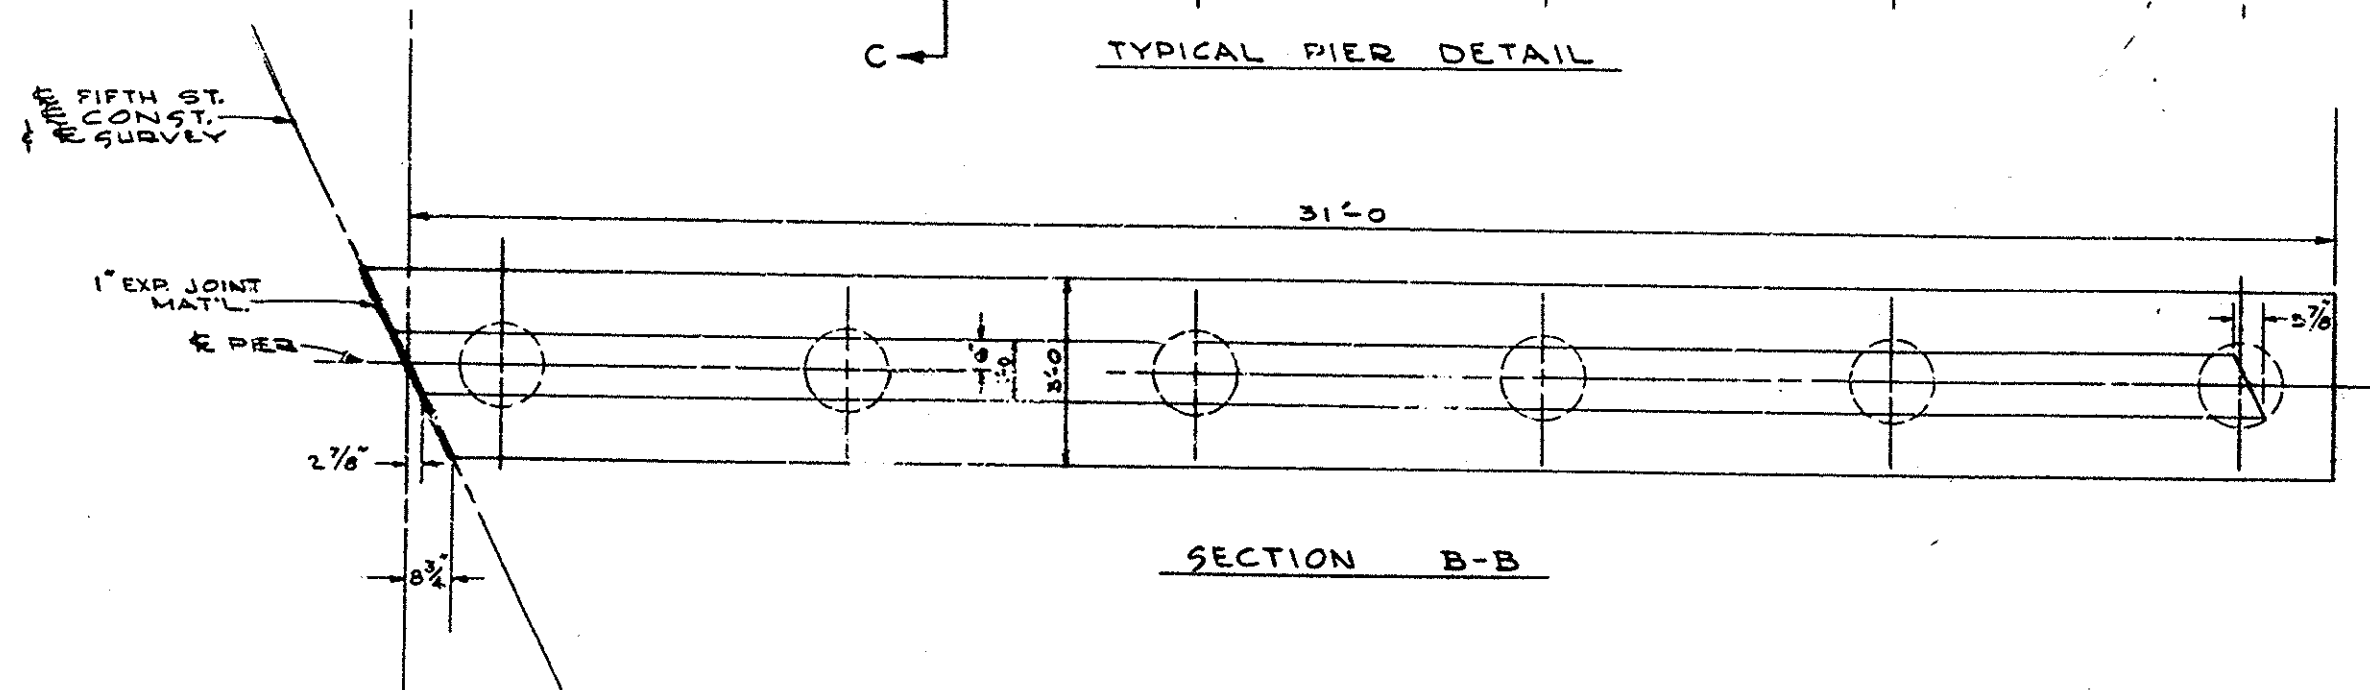
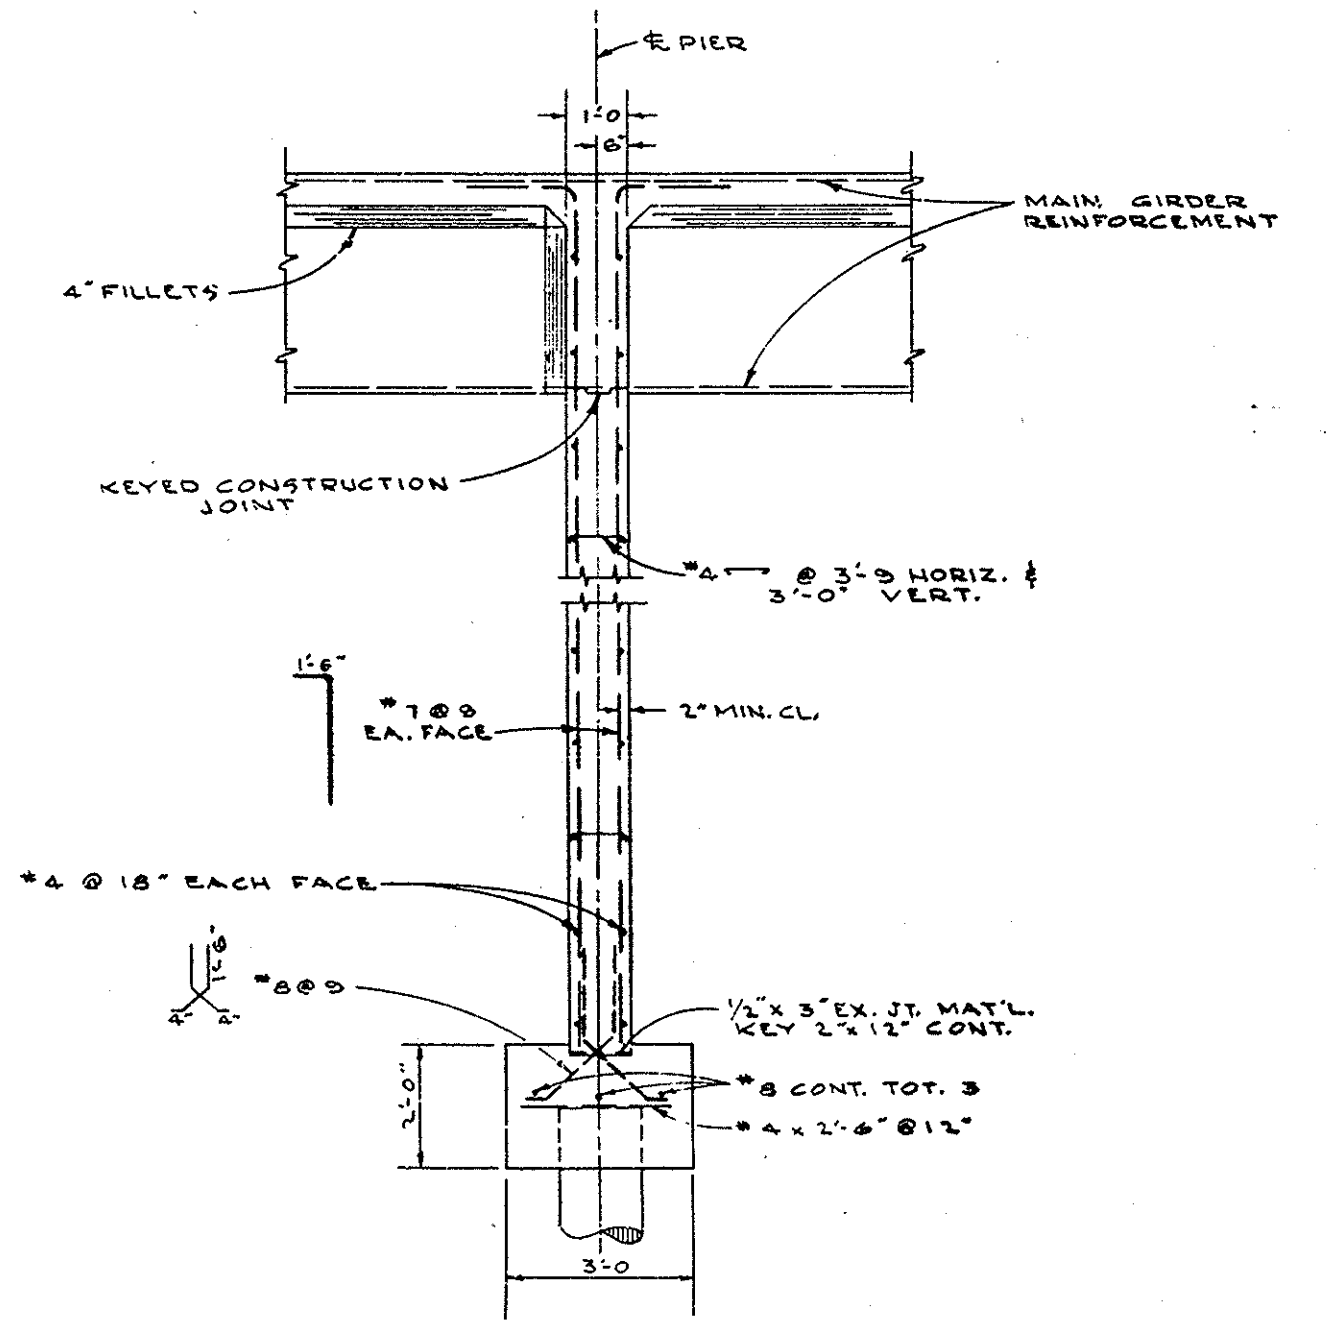
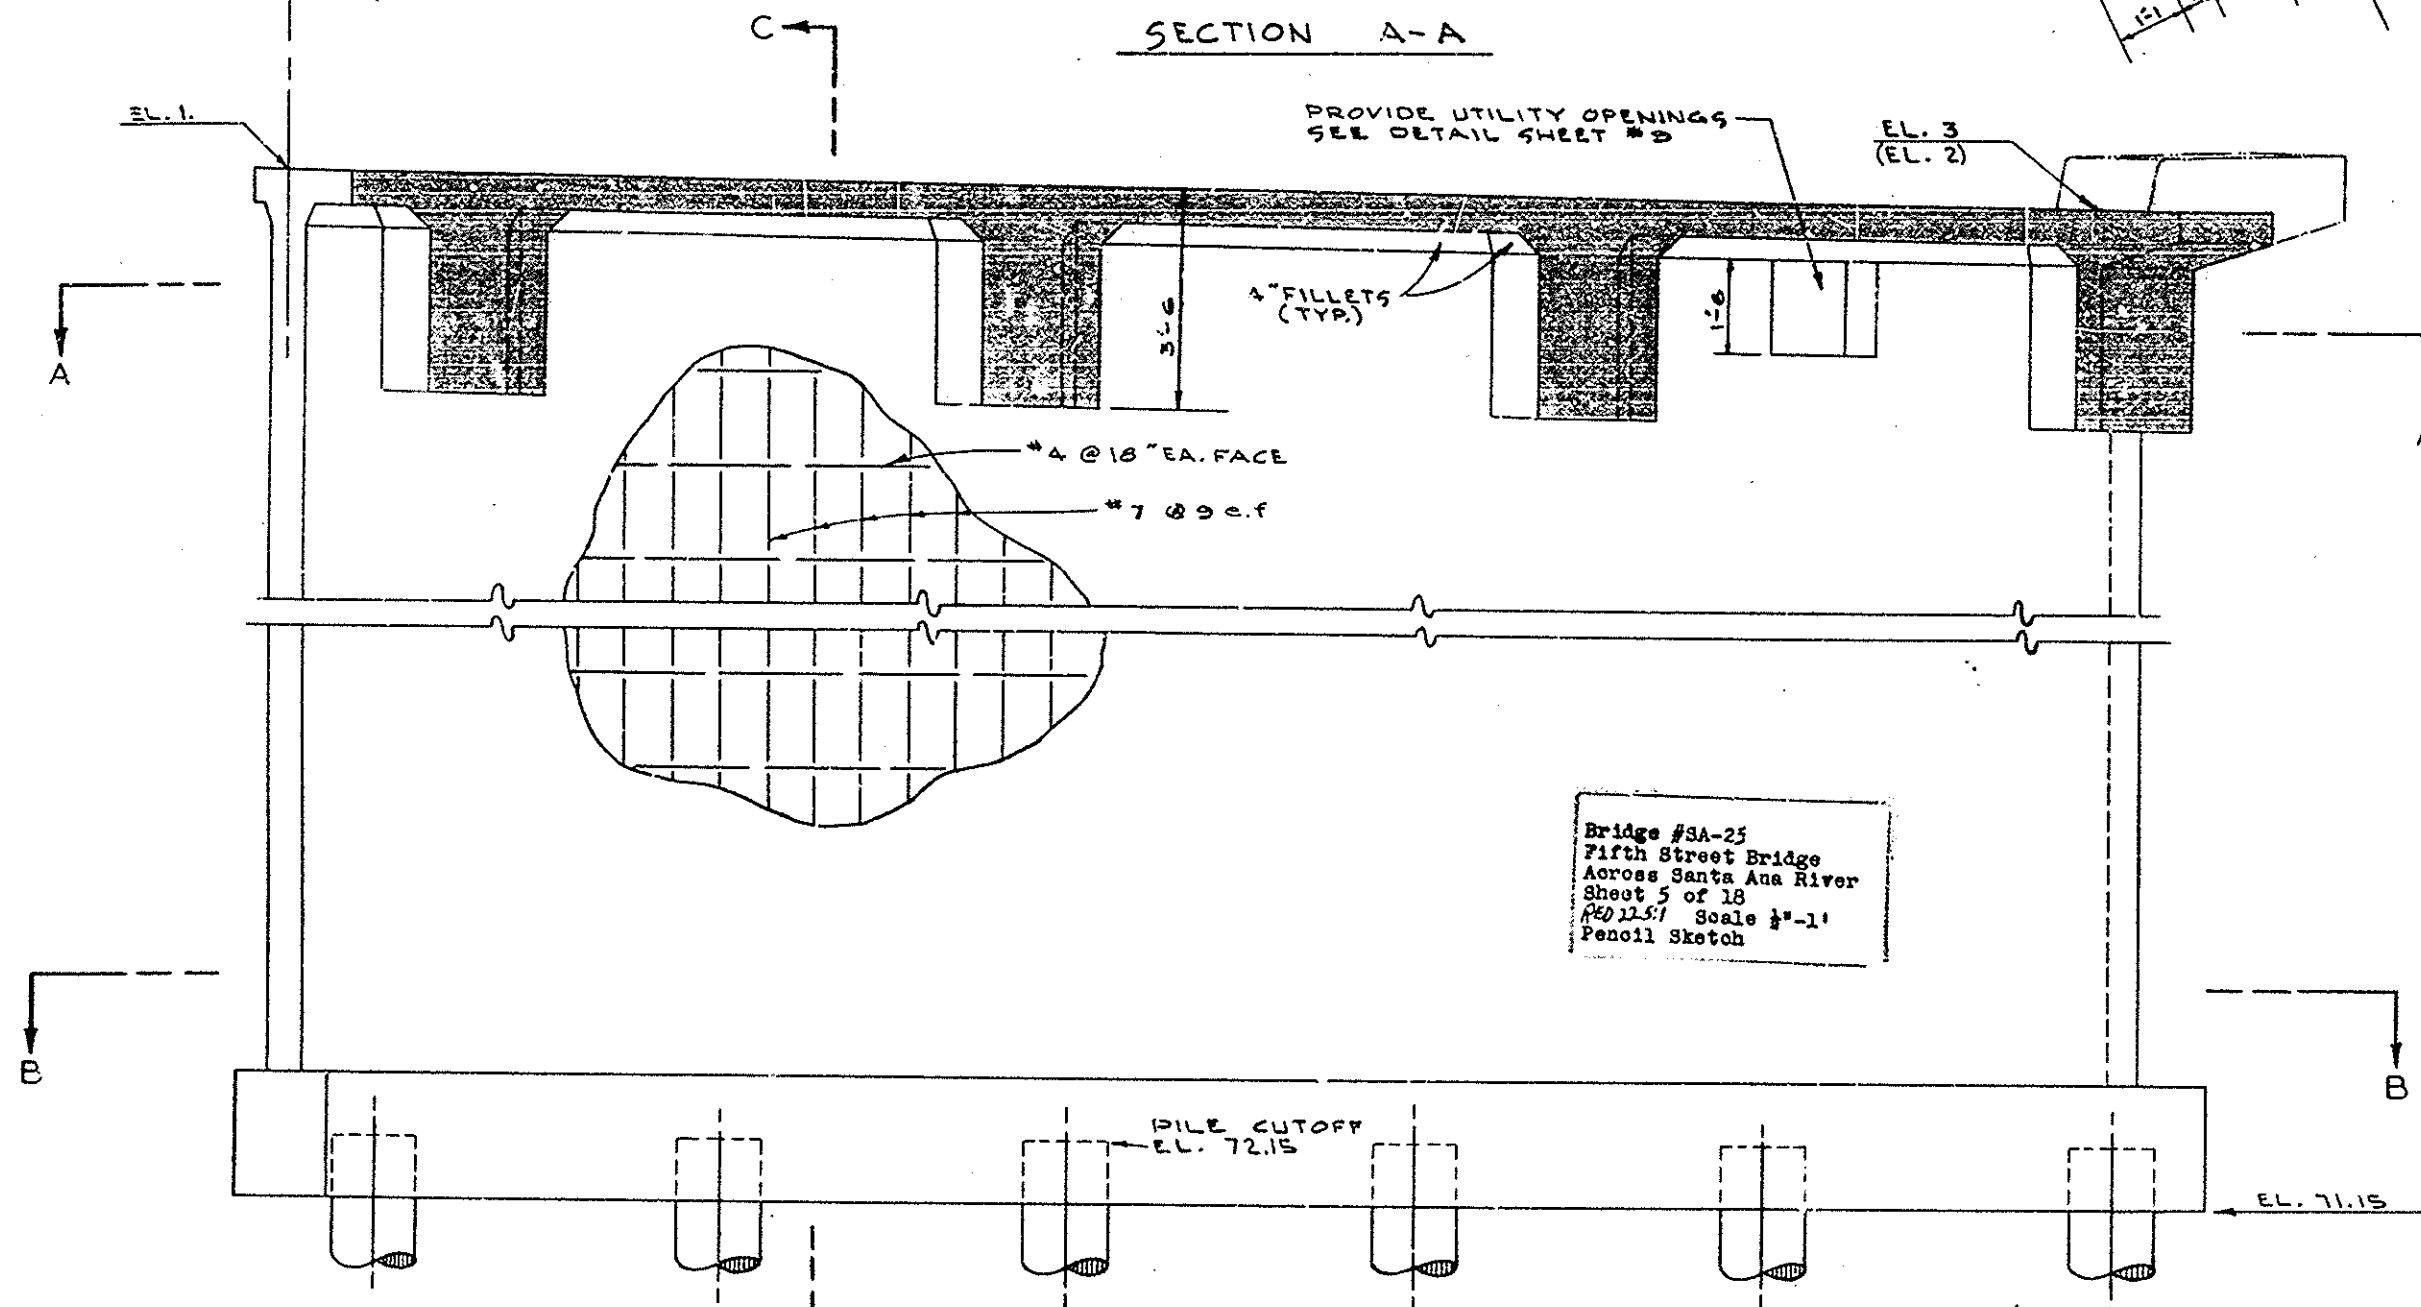


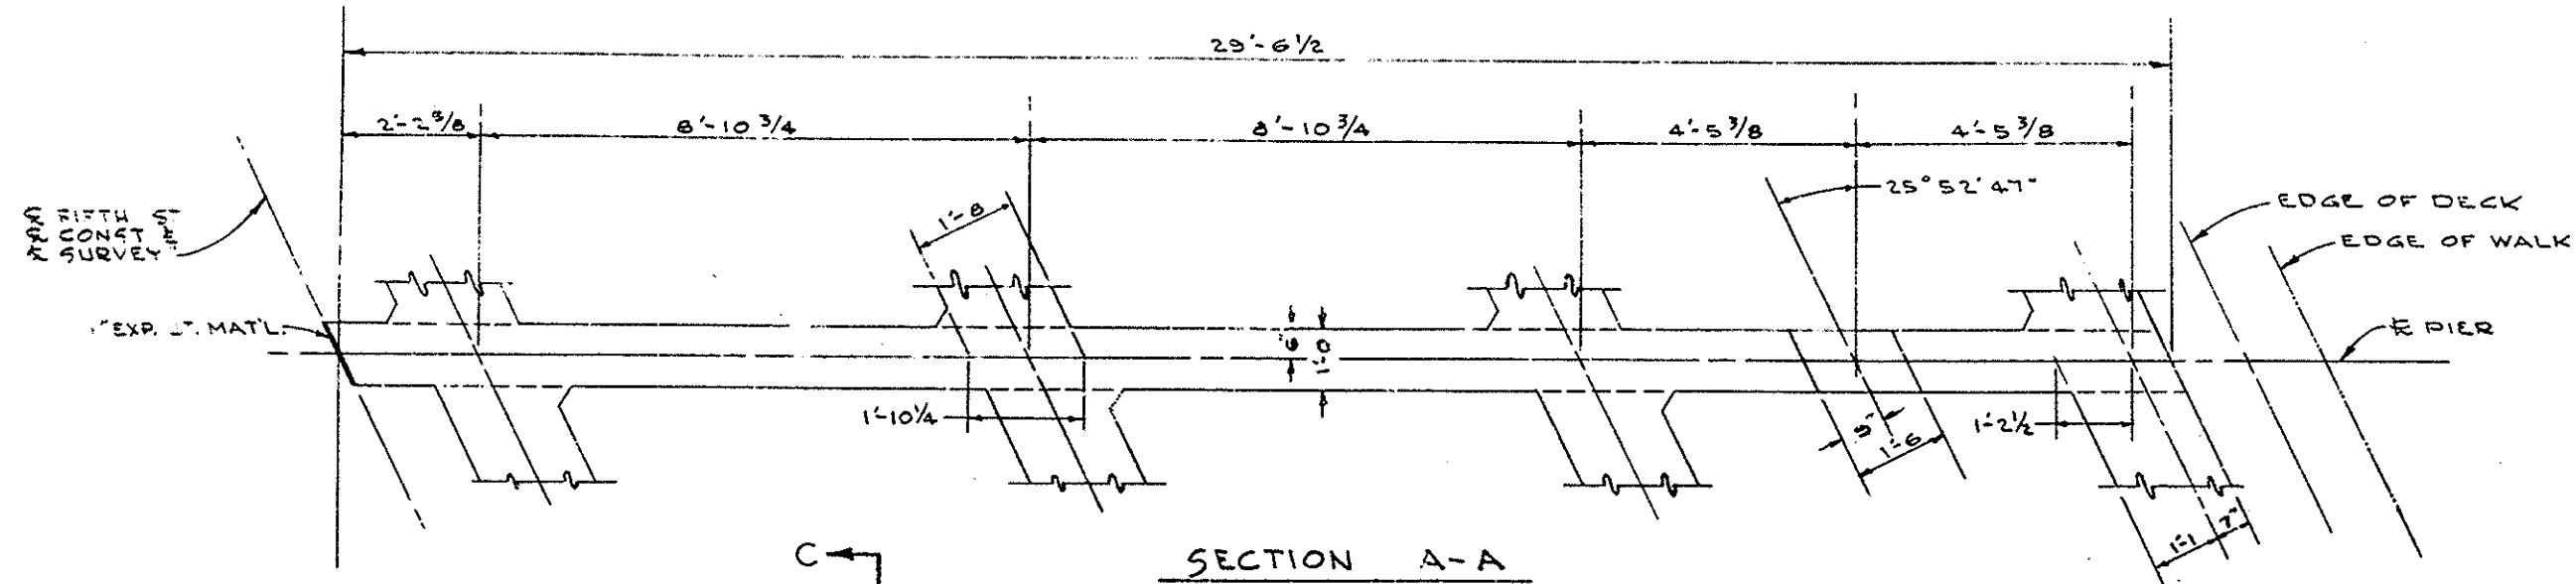

As BUILT
 Δ 0'-8 1/2" from bot of slab to top of utility opening.
 Δ Util. opening height changed to 1'-8"

ORANGE COUNTY HIGHWAY DEPARTMENT	
5TH. STREET BRIDGE ACROSS SANTA ANA RIVER	
PIER DETAIL	
DESIGNED BY W. A. M. C. L. 1-50 CHECKED BY J. W. M. 1-50 APPROVED J. W. M. 1-50	SCALE: 1/2" = 1'-0" SHEET 5 OF 18