


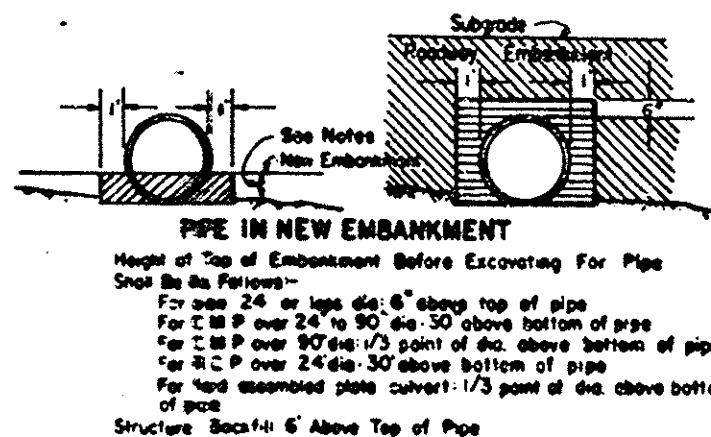
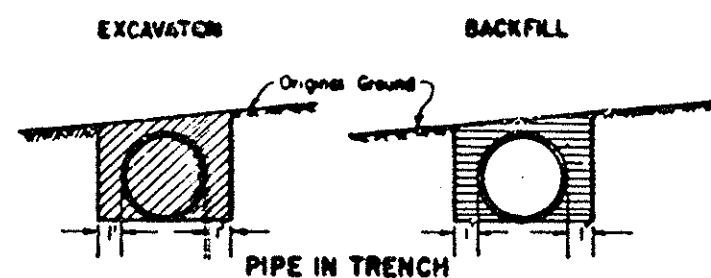
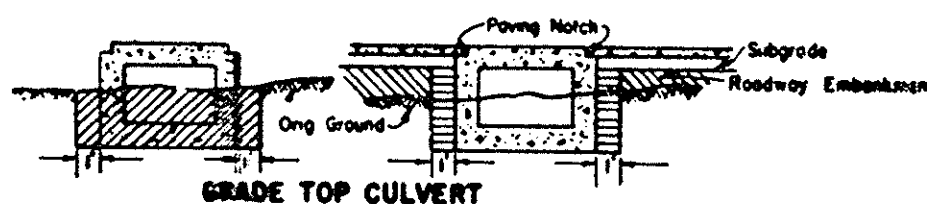
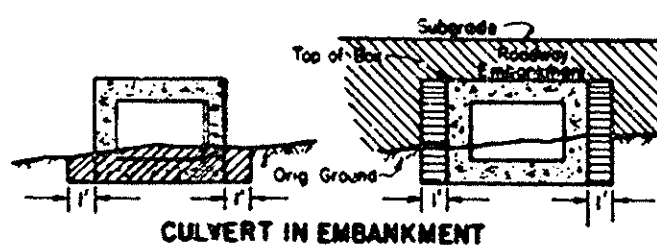
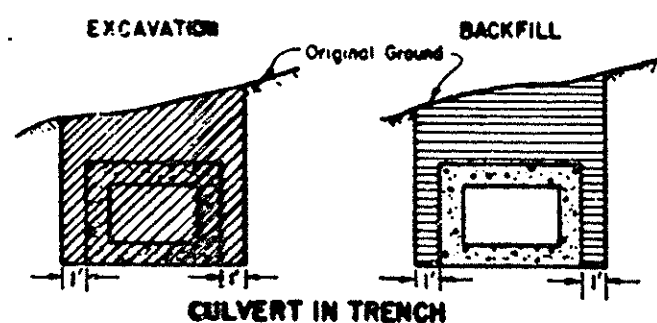
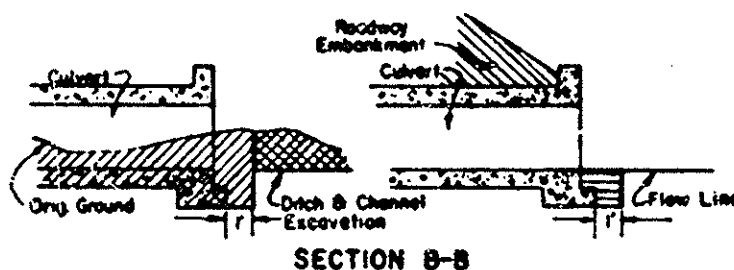
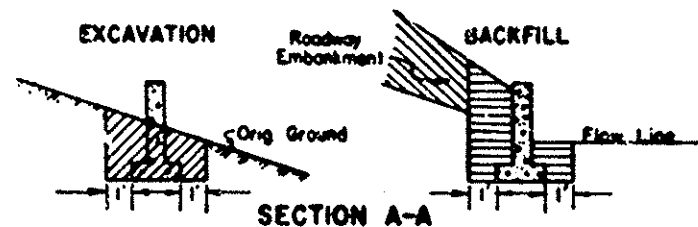


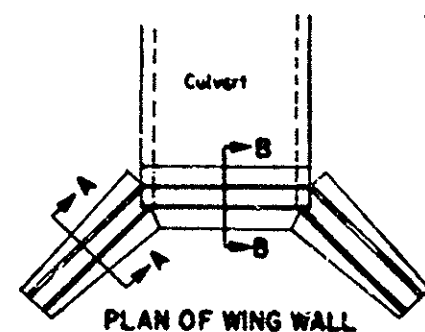


PIPES, RODS & DEADMEN Except Underdrains & Downdrains

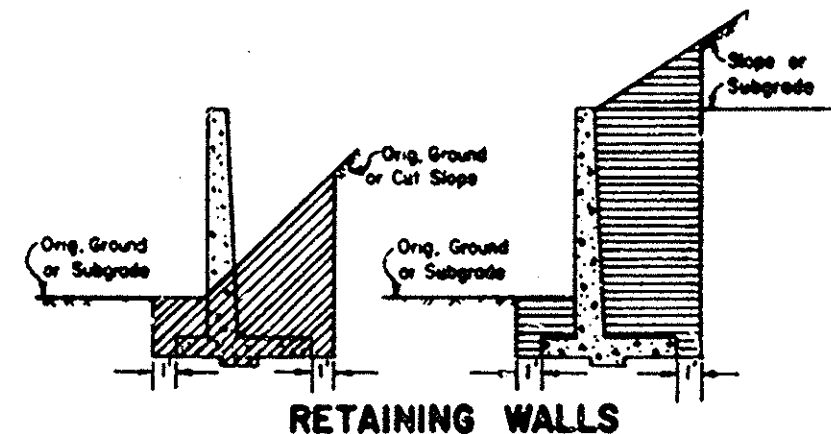


BOX CULVERTS

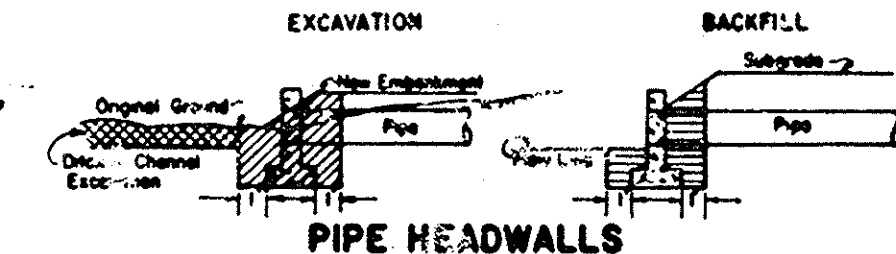




WING WALLS

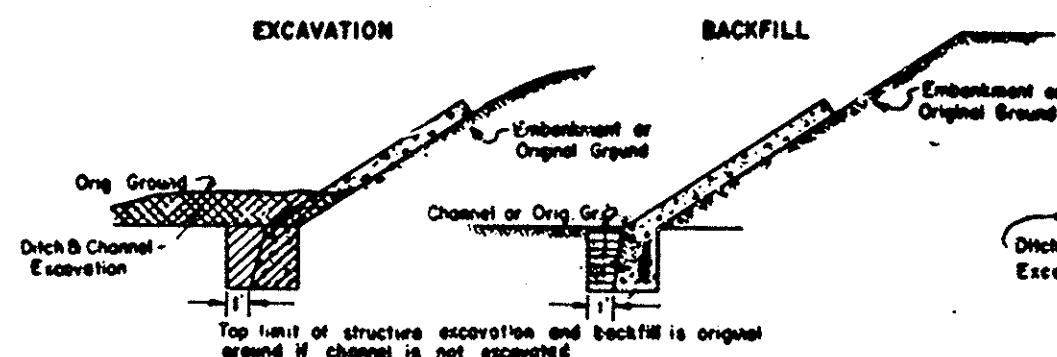



MONOLITHIC CONCRETE SLOPE PAVING; RIPRAP

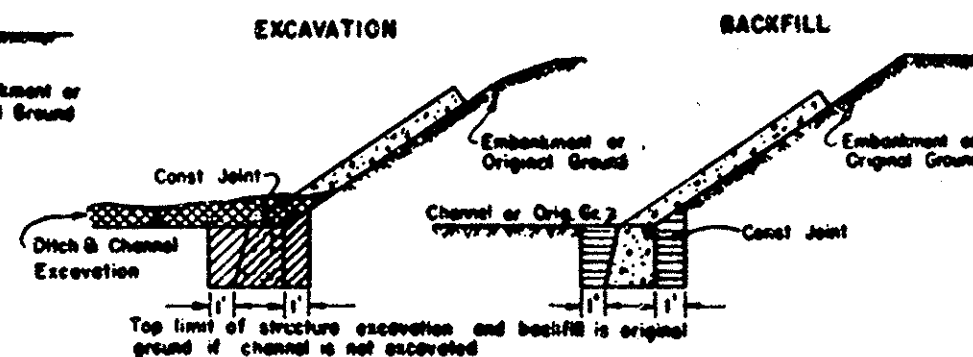

CONCRETE SLOPE PAVING

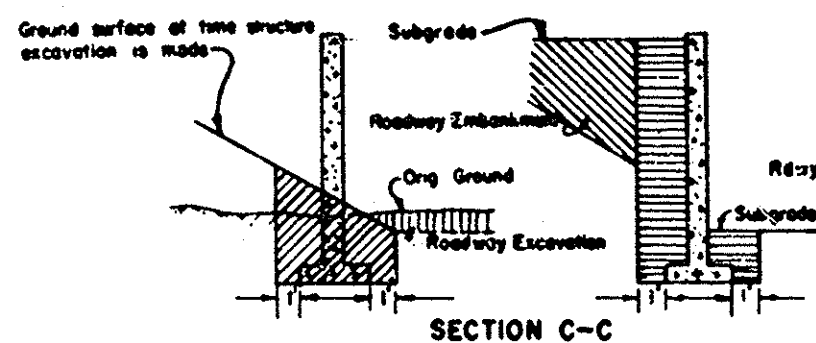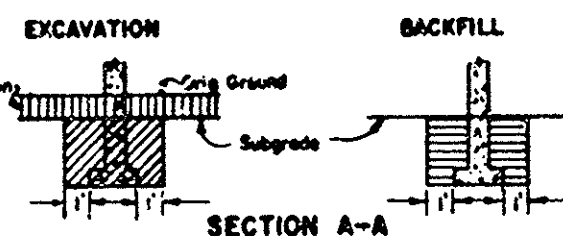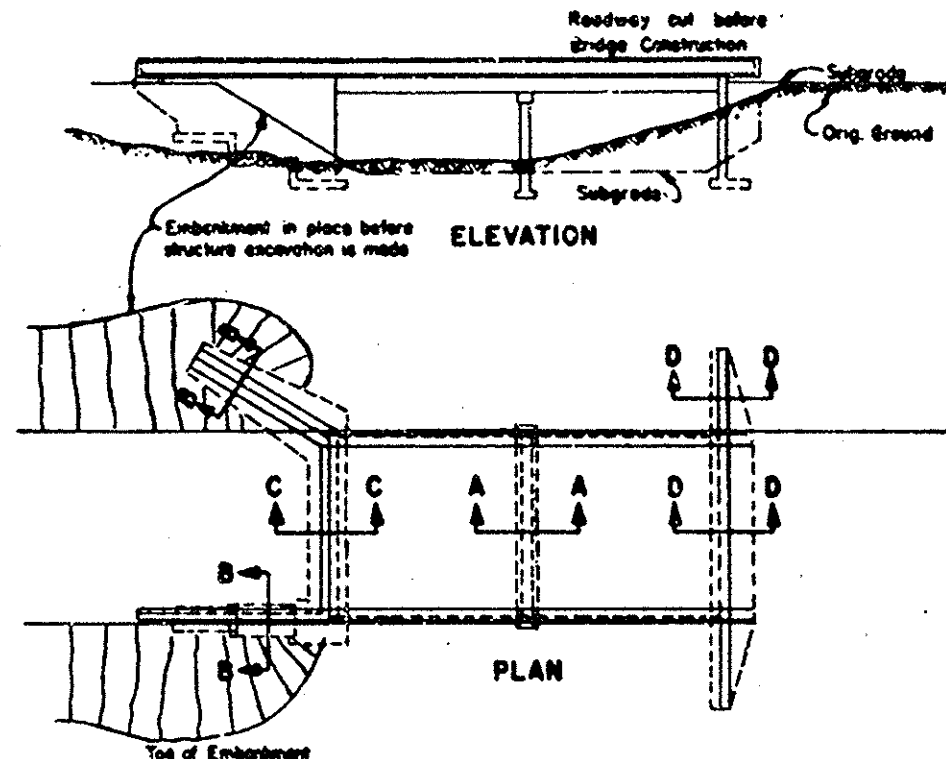

BRIDGE ABUTMENTS & ADJOINING WING WALLS

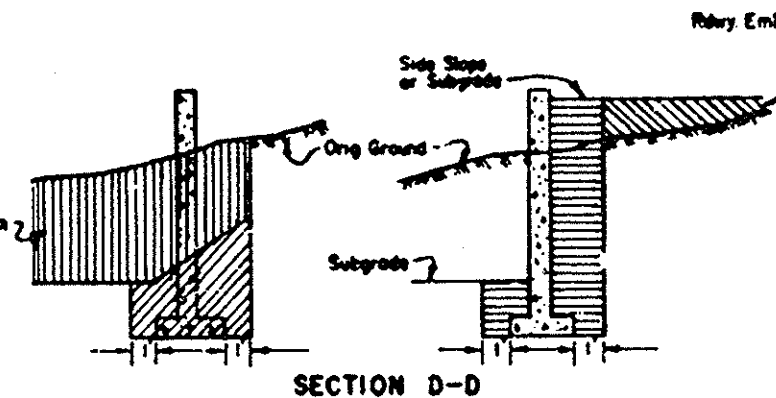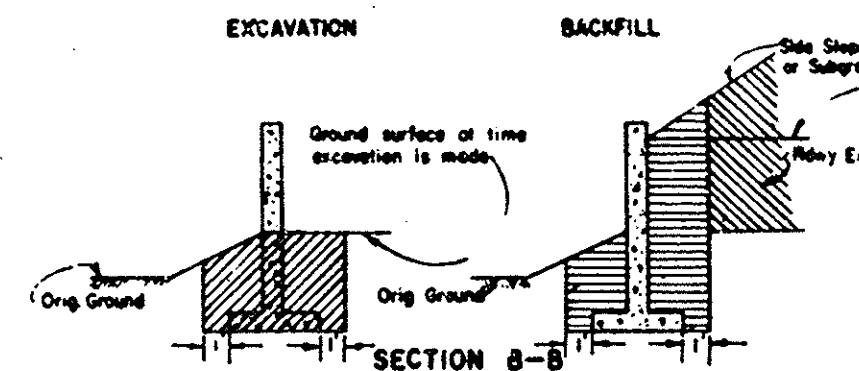

LEGEND

- Structure Excavation
- Structure Backfill
- Ditch & Channel Excavation
- Roadway Embankment
- Roadway Excavation

Note: Subgrade shall be lowest subgrade as defined in the Standard Specifications

As BUILT No CHANGE

NOTE: THESE PLANS ADOPTED FROM THE
STANDARD PLANS, STATE OF CALIFORNIA,
DEPARTMENT OF PUBLIC WORKS,
DIVISION OF HIGHWAYS

MICROFILMED
JUN 18 1962

ORANGE COUNTY HIGHWAY DEPARTMENT	
5TH. STREET BRIDGE ACROSS SANTA ANA RIVER	
STRUCTURE EXCAVATION & BACKFILL	
SCALE: AS NOTED	SHEET 13 OF 18

Fifth STREET Bridge

JA-20