

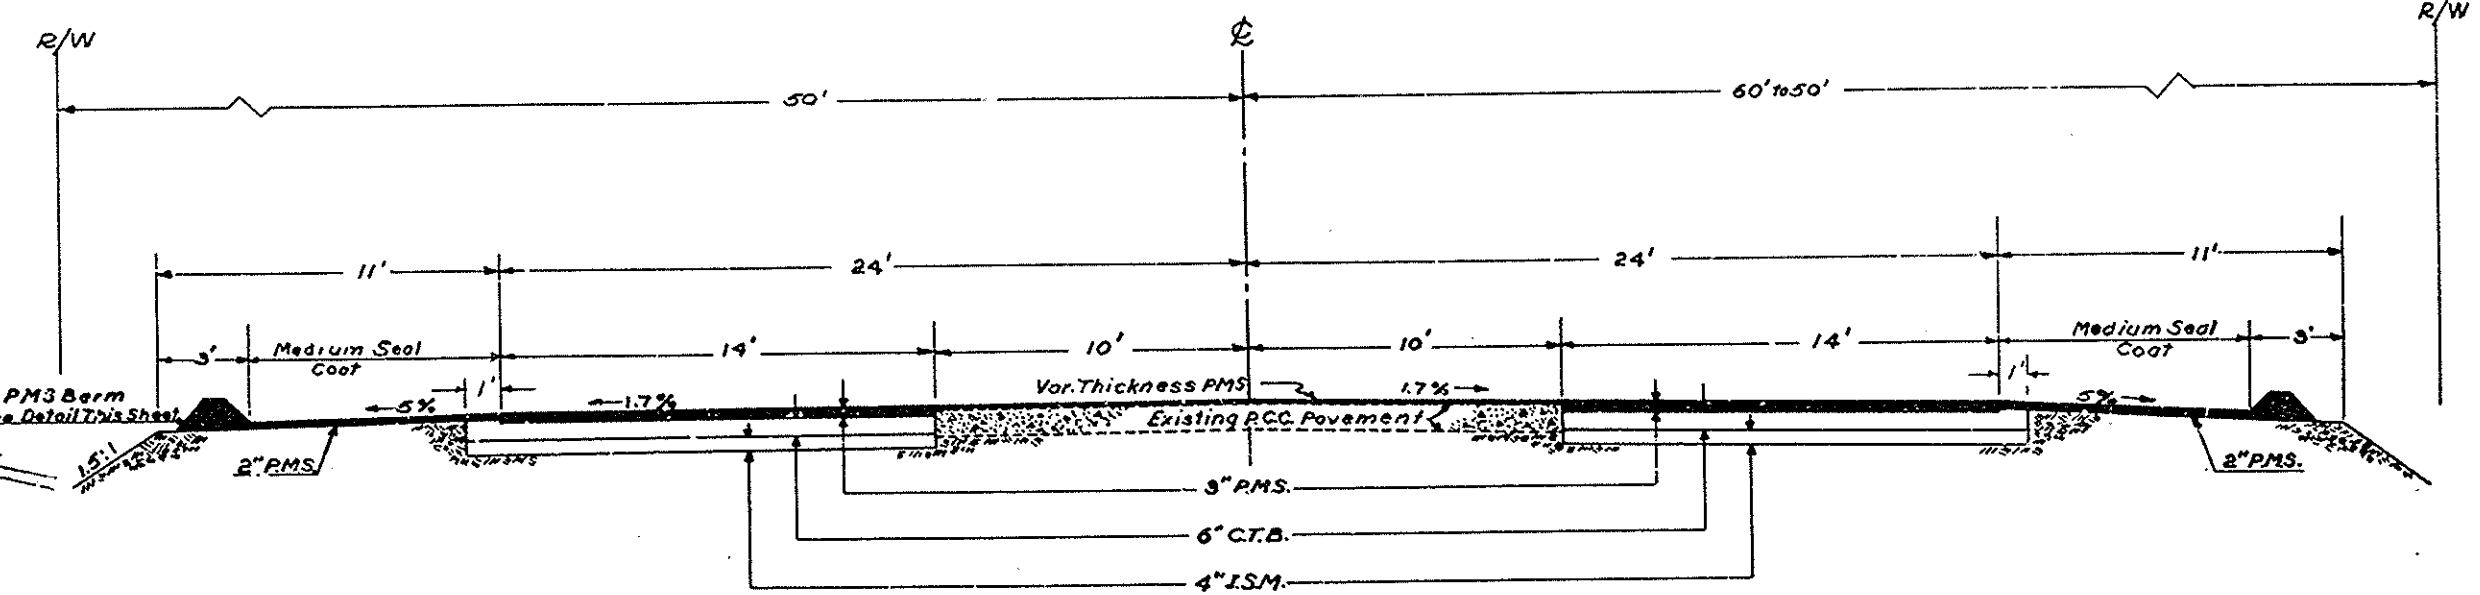


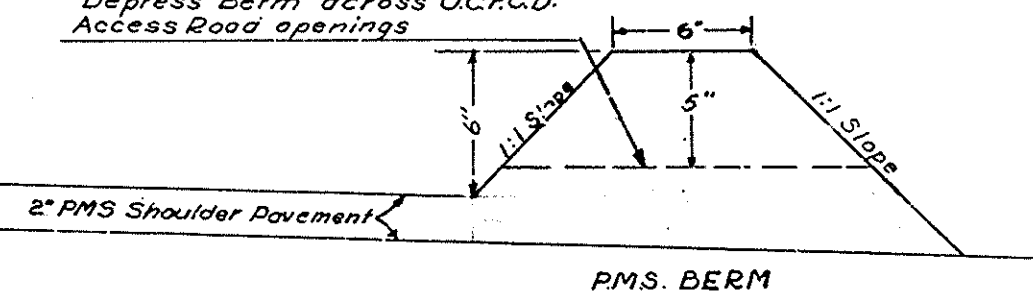


NOTE:  
Depress Berm across O.C.F.C.D.  
Access Road openings

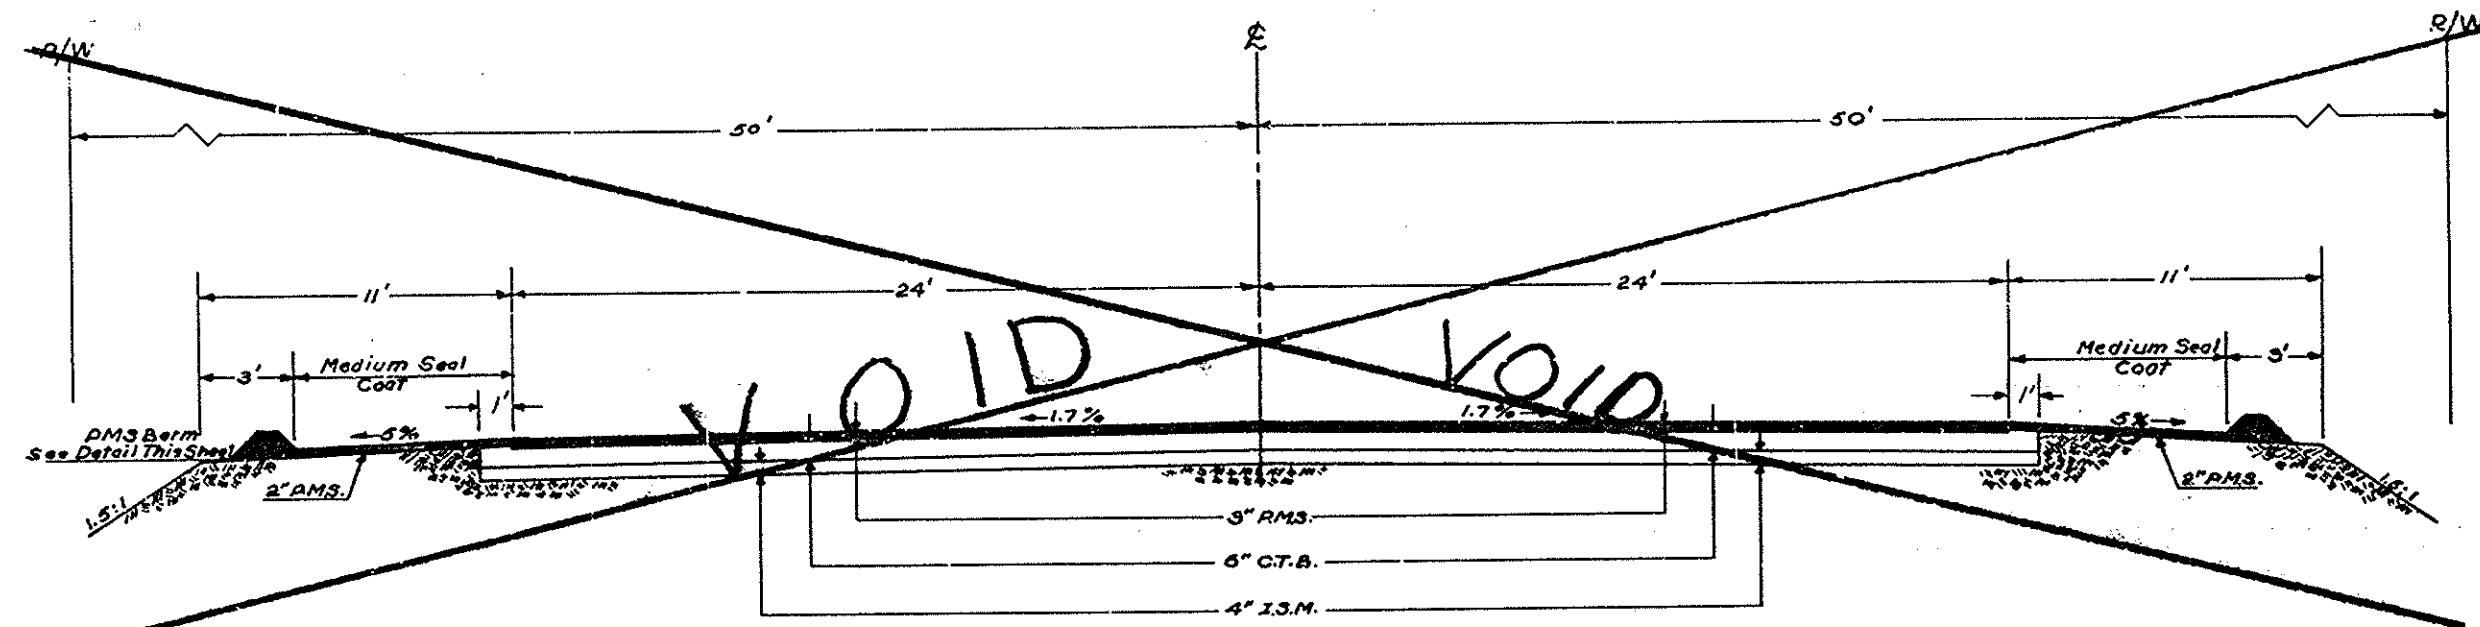

STATION 19+24 TO 23+00

~~STATION 22+00 TO 23+00~~

Bridge #SA-25  
Fifth Street Bridge  
Across Santa Ana River  
Sheet 16 of 18  
FEB 22 57 Scale as shown  
Blackline Print

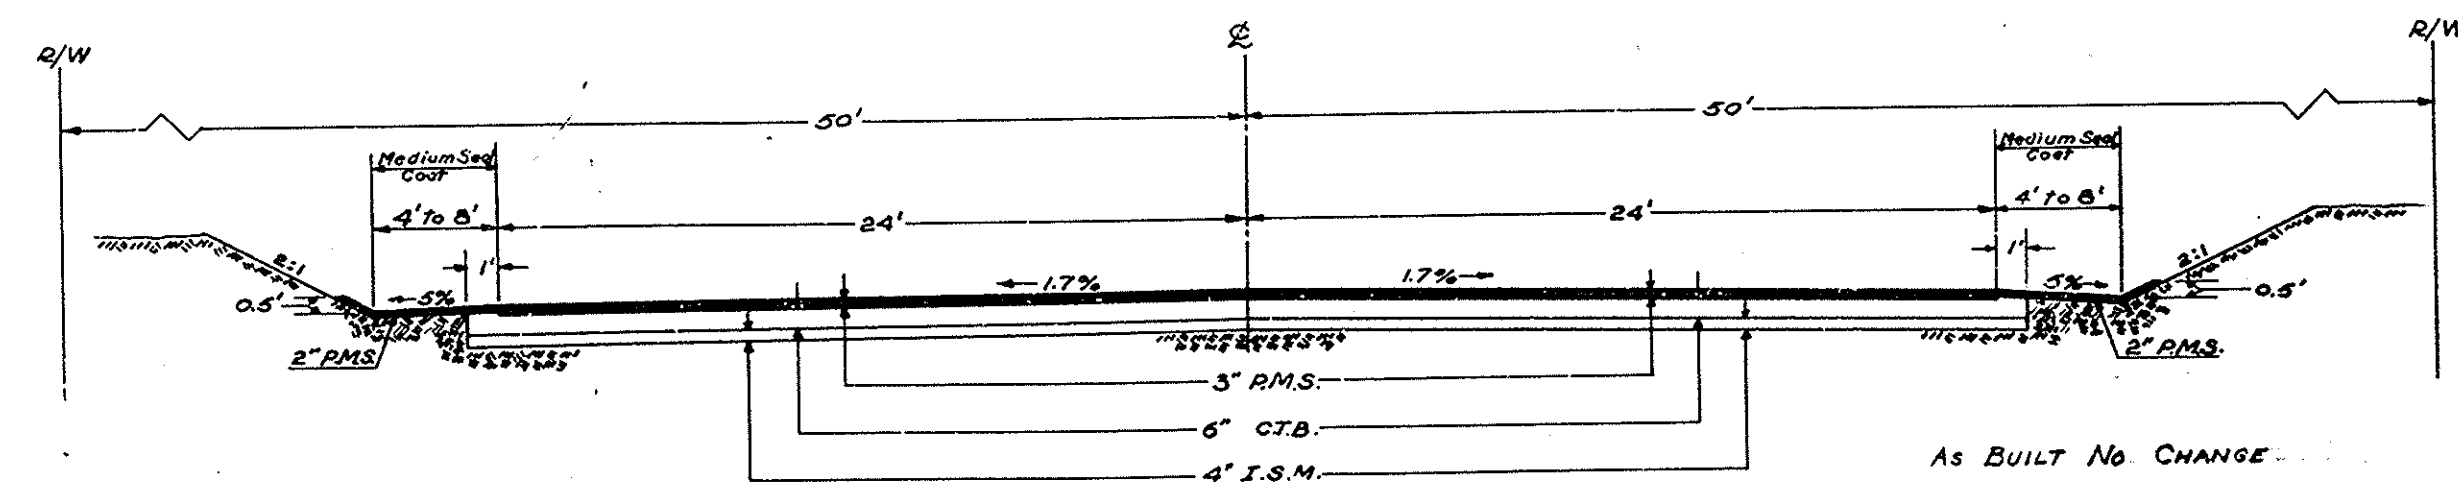

AS BUILT NO CHANGE

STATION 23+00 TO 23+90  
(CUT SECTIONS)  
TYPICAL SECTIONS

NO CHANGE AS BUILT

MICROFILMED  
JUN 18 1962

ORANGE COUNTY HIGHWAY DEPARTMENT

5TH ST. BRIDGE  
APPROACH

## TYPICAL SECTIONS & MISC. DETAILS

SCALE: NONE SHEET 63